

1239277
 L0076-045H7

Date Received for Clearance Process (MM/YY/DD) 03/01/01

INFORMATION CLEARANCE FORM

A. Information Category

Abstract Journal Article
 Summary Internet
 Visual Aid Software
 Full Paper Report
 Other _____

B. Document Number: HW-55176 PART 1 - 7

C. Title
 Index of CPD (Chemical Processing Department) Crib Building Numbers Design of CPD Radioactive Liquid Waste Disposal Sites

D. Internet Address

E. Required Information

1. Is document potentially Classified? No Yes (MANDATORY)
Chris Willingham
 Manager's Signature Required

If Yes _____ No Yes Classified
 ADC Signature Required

2. References in the information are Applied Technology No Yes
 Export Controlled Information No Yes

3. Does information contain the following: (MANDATORY)

a. New or Novel (Patentable) Subject Matter? No Yes
 If "Yes", Disclosure No.: _____

b. Information Received in Confidence, Such as Proprietary and/or Inventions?
 No Yes If "Yes", Affix Appropriate Legends/Notices.

c. Copyrights? No Yes If "Yes", Attach Permission.

d. Trademarks? No Yes If "Yes", Identify in Document.

4. Is information requiring submission to OSTI? No Yes

5. Release Level? Public Limited

F. Complete for a Journal Article

1. Title of Journal _____

G. Complete for a Presentation

1. Title for Conference or Meeting _____

2. Group Sponsoring _____

3. Date of Conference _____

4. City/State _____

5. Will information be published in proceedings? No Yes

6. Will material be handed out? No Yes

H. Author/Requestor *Chris Willingham*
 C. Willingham (Print and Sign)

Responsible Manager *Chris Willingham for Bms*
 B. M. Sullivan (Print and Sign)


1. Reviewers	Yes	Print	Signature	Public Y/N (If N, complete J)
General Counsel	<input type="checkbox"/>	_____	_____	Y / N
Office of External Affairs	<input type="checkbox"/>	_____	_____	Y / N
DOE-RL	<input type="checkbox"/>	_____	_____	Y / N
Other	<input checked="" type="checkbox"/>	Chris Willingham	<i>Chris Willingham</i>	<input checked="" type="checkbox"/> Y / N
Other	<input type="checkbox"/>	_____	_____	Y / N

J. If information includes sensitive information and is not to be released to the public indicate category below.

Applied Technology Protected CRADA
 Personal/Private Export Controlled
 Proprietary Procurement-Sensitive
 Business-Sensitive Patentable
 Predecisional Other (Specify) _____
 UCNI

All 7 part are approved for Public Release
 CW 3-23-01

K. If Additional Comments, Please Attach Separate Sheet

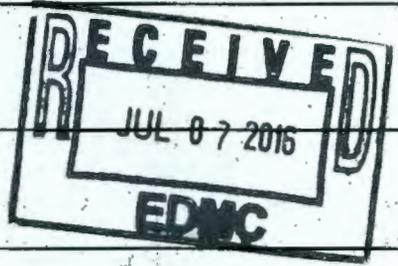

229

RELEASE AUTHORIZATION

**Document
Number:**

HW-55176 Part 1 - 7

Document Title:

Index of CPD (Chemical Processing Department) Crib Building
Numbers Design of CPD Radioactive Liquid Waste Disposal Sites,
Parts 1 through 7.

**This document, reviewed in accordance with DOE Order
241.1, "Scientific and Technical Information Management,"
and DOE G 241.1-1, "Guide to the Management of Scientific
and Technical Information," does not contain classified or
sensitive unclassified information and is:**

APPROVED FOR PUBLIC RELEASE

Chris Willingham

03/23/2001

C. Willingham

Lockheed Martin Services, Inc.
Document Control/Information Clearance

Reviewed for Applied Technology, Business Sensitive, Classified, Copyrighted, Export Controlled, Patent, Personal/Private, Proprietary, Protected CRADA, Trademark, Unclassified Controlled Nuclear Information.

LEGAL DISCLAIMER. This report was prepared as an account of work sponsored by an agency of the United States Government. Neither the United States Government nor any agency thereof, nor any of their employees, nor any of their contractors, subcontractors or their employees, makes any warranty, express or implied, or assumes any legal liability or responsibility for the accuracy, completeness, or any third party's use or the results of such use of any information, apparatus, product, or process disclosed, or represents that its use would not infringe privately owned rights. Reference herein to any specific commercial product, process, or service by trade name, trademark, manufacturer, or otherwise, does not necessarily constitute or imply its endorsement, recommendation, or favoring by the United States Government or any agency thereof or its contractors or subcontractors. The views and opinions of authors expressed herein do not necessarily state or reflect those of the United States Government or any agency thereof.

This report has been reproduced from the best available copy.

Printed in the United States of America.

[0076045H]

UNCLASSIFIED
(CLASSIFICATION)

GENERAL ELECTRIC

HANFORD ATOMIC PRODUCTS OPERATION - RICHLAND, WASHINGTON

DOCUMENT NO.

HW-55176 - ~~PT. 1~~

COPY NO.

201

DATE

March 10, 1958

ISSUING FILE

TITLE

INDEX OF CPD CRIB BUILDING NUMBERS
DESIGNS OF CPD RADIOACTIVE LIQUID WASTE
DISPOSAL SITES

REFERENCE COPY

AUTHOR

V. W. Wood

NOT FOR CIRCULATION

RETAINED FOR RECORD PURPOSES ONLY

REFERENCE COPY
NOT FOR CIRCULATION
NOV 2 1966
RECEIVED - INVENTORY INC.
CUSTODY
271-U Bldg., 200 West

ROUTE TO	PAYROLL NO.	LOCATION	FILES ROUTE DATE	SIGNATURE AND DATE
W. H. ...		225		W. H. ... 3/12/58
H. L. Candell	60556	271-T	SEP 20 1968	
E. J. Current	60217	222-T	OCT 21 1968	
ACC R. Env. Safety + Tech Serv. Div (Pg. Phases)			SEP 14 1973	
C. J. Foster	60139	222	MAR 14 1974	
D. J. Powell	63587	222-T	OCT 11 1974	
D. H. Taylor	60262	27094	MAY 20 1978	

RECEIVED
JUL 07 2016
EDMC

UNCLASSIFIED
(CLASSIFICATION)

PUREX

RECEIVED
JUL 10 1950
EDAC

1330553

UNCLASSIFIED

HW-55176, Pt. 1
Page 1

INDEX OF CPD CRIB BUILDING NUMBERS
DESIGNS OF CPD RADIOACTIVE LIQUID WASTE
DISPOSAL SITES

Part I of VII Parts
Process Technology - Study Report

by

V. W. Wood
Radiological Design and Development
Facilities Engineering Operation
CHEMICAL PROCESSING DEPARTMENT

March 10, 1958

D I S T R I B U T I O N

CR Bergdahl	TG LaFollette
RM Bernard	CE Linderoth
WG Browne	HE Parker
E Doud	HF Peterson
J Durbin	DW Pearce
GE Carpenter	OH Pilkey
JR Cartmell	EL Reed
JB Fecht	RA Roberts
DR Gustavson	OC Schroeder
WA Haney	HP Shaw
JF Honstead	VW Wood
IM Jacques	Records Center
EB Jackson	300 Files
CE Kent	Extras

UNCLASSIFIED

UNCLASSIFIED

HW-55176, Pt. 1
Page 2

INDEX OF CPD CRIB BUILDING NUMBERS
DESIGNS OF CPD RADIOACTIVE LIQUID WASTE
DISPOSAL SITES

Part I of VII Parts
Process Technology - Study Report

INTRODUCTION

During the fourteen years or more which the separations areas have operated, many sites have been used for the disposal of radioactive liquid wastes. Various methods have been used in assigning building numbers to these sites and, in a number of cases, changes have been made which have brought about some confusion. One of the reasons being some currently used building numbers do not agree with the numbers existing on design prints for the facilities. Reference (2) was an effort to establish a listing of the liquid waste disposal sites. It required considerable time and research to locate information concerning these sites.

Many varied designs have been used for the disposal of radioactive liquid wastes. Reverse wells, trenches, cribs or caverns, etc, have been used. Specific information on these facilities is often difficult to obtain for in some instances they were constructed on work orders with no records being retained on the design. In general, the design on each facility has been different. This has made it extremely difficult for people to have a good working knowledge of the various waste disposal sites.

PURPOSE

The purpose of this report (Part I) is to provide a ready reference to the Purex liquid waste disposal sites as well as a compilation of sketches showing the basic information on the design of each facility.

Another objective is to establish a simplified and uniform numbering system. Still another objective is to provide an up-to-date tabulation. Subsequent parts of this report will provide information on cribs for such plants as Redox and "Z" plant.

SUMMARY AND CONCLUSIONS

All radioactive liquid waste disposal sites should have the 216 Building number designation. These should be further grouped by giving all such sites for Purex a prefix of 216-A. Other major series would be 216-S for Redox; 216-T for "T" Plant; 216-B for "B" Plant; 216-U for "U" Plant and 216-Z for "Z" Plant.

UNCLASSIFIED

The numbering list in "Official Hanford Works Building List - Specification HW-5000" by Engineering Files - Construction Engineering Operation should be revised to more closely follow the above numbering system.

RECOMMENDATIONS

It is recommended that the following action be taken:

1. All groups and services referring to the Purex cribs or report data concerning them should use the index numbering system as presented in this report. In the case of Purex this means practically no changes.
2. That all drawings concerning these disposal sites, including maps, be revised to show the proper locations and numbers for these cribs.
3. Any suggestions for improving the usefulness of this report should be referred to the author.

DISCUSSION

When all parts of the report are completed, and the work outlined in the report is completed, much confusion will be eliminated and more people will be better informed on the design of each waste disposal facility. The report will provide a firm basis for future building number assignments.

While some sincere effort has been made to try and keep a methodical system for recording waste disposal sites, a number of problems have developed. For example, HW-5000, Sheet 29 of 50 lists only two cribs in the 216-Z series. They are 216-Z-8 and 216-Z-9. Although no coordinates are given, it is doubtful if these refer to the same cribs with the same number as given in Reference "2".

As indicated earlier, the use of the crib index, as presented in this report should be very easy. In addition, information is presented which is very difficult to locate in the records and in some cases it is not available in the records.

REFERENCES

1. HW-5000, "Official Hanford Works Building List - Specification HW-5000" by Engineering Files - Construction Engineering Operation.
2. HW-43121, "Tabulation of Radioactive Liquid Waste Disposal Facilities" by HV Clukey dated May 10, 1956.
3. HW-33305, "Tabulation of Radioactive Liquid Waste Disposal Facilities," by HV Clukey dated October 8, 1954.

Cross Reference for Purex Radioactive Liquid Waste Disposal Sites

<u>Suggested Crib No.</u>	<u>Number Listed in HW-5000</u>	<u>Number Listed in HW-43121</u>	<u>Original or Number Used on Drawings</u>	<u>Remarks</u>
216-A-1	216-A-1	216-A-1	216-A-1	
216-A-2	216-A-2	216-A-2	216-A-2	
216-A-3	216-A-3	216-A-3	216-A-3	
216-A-4	216-A-4	216-A-4	216-A-4	
216-A-5	216-A-5	216-A-5	216-A-5	
216-A-6	216-A-6	216-A-6	216-A-6	
216-A-7	216-A-7	216-A-7	216-A-7	
216-A-8	216-A-8	216-A-8	216-A-8	
216-A-9	216-A-9	216-A-9	216-A-9	
216-A-10	216-A-10	216-A-10	216-A-10	
216-A-11	216-A-11	216-A-11		
216-A-12	216-A-12	216-A-12		
216-A-13	216-A-13	216-A-13		
216-A-14	216-A-14	216-A-14		
216-A-15	216-A-15	216-A-15		
216-A-16	216-A-16	216-A-16	216-A-17 Overflow	
216-A-17	216-A-17	216-A-17		
216-A-18	216-A-18	216-A-18		
216-A-19	216-A-19	216-A-19		
216-A-20	216-A-20	216-A-20		
216-A-21	216-A-21	216-A-21		
216-A-22	216-A-22	216-A-22	216-A-22	
* 216-A-23 A&B	None	None	None	216-A-23 was originally another crib which was not built.
216-A-24	216-A-24	None	216-A-24	Alternate 216-A-8
216-A-25	Gable mtn. Swamp			

* 216-A and B were built on a Work Order in fall of 1957 and no numbers assigned.

UNCLASSIFIED

HW-55176, PT1
Page 5

APPENDIX

A. Explanation of Parts to the Report

Part I will cover the Purex Radioactive Liquid Waste Disposal Sites.

Part II will cover the "Z" Plant Radioactive Liquid Waste Disposal Sites.

Part III will cover the Redox Plant Radioactive Liquid Waste Disposal Sites.

Part IV will cover the "U" Plant Radioactive Liquid Waste Disposal Sites.

Part V will cover the "T" Plant Radioactive Liquid Waste Disposal Sites.

Part VI will cover the "B" Plant Radioactive Liquid Waste Disposal Sites.

Part VII will cover the "C" Plant, Hot Semi-works, the 200 North Areas and miscellaneous.

B. Index for Purex Radioactive Liquid Waste Disposal Sites.

C. Sketches of Purex Waste Disposal Facilities.

D. Map of Purex Crib Sites (SK-2-17798)

UNCLASSIFIED

UNCLASSIFIED

HW-55176 PTL
Appendix B-1
Revised 1/17/61

CRIB INDEX
PUREX

<u>Number</u>	<u>Description Appendix Sheet</u>	<u>Service</u>	<u>Use Dates</u>		<u>Status</u>
			<u>From</u>	<u>To</u>	
216-A-1	C-1	Start-up Wastes	11/55	12/55	Abandoned
216-A-2	C-2	Organic Wastes	5/56	-	Active
216-A-3	C-3	203-A Silica Gel Wastes	3/56	-	Active
216-A-4	C-4	Laboratory & Stack Dia.	12/55	12/58	Replaced by A-21
216-A-5	C-5	Process Condensate	11/55	-	Active
216-A-6	C-6	Steam Condensate	11/55	1/61	Replaced by A-30
216-A-7	C-7	241-A-152 Box Drain	11/55	7/59	Replaced by Catch Tank
216-A-8	C-8	Tank Farm Condenser Effl.	11/55	5/58	Replaced by A-24
216-A-9	C-9	Fractionator Cond. Effl.	3/56	2/58	Effluent to Swamp
216-A-10	C-10	Process Condensate	Not Used	-	Replacement for A-5
216-A-11	C-11	Trap Pit #1 Drain	11/55	-	Active
216-A-12	C-11	Trap Pit #3 Drain	11/55	-	Active
216-A-13	C-12	Air Sample Seal Drain	11/55	-	Active
216-A-14	C-11	Vacuum Clean Pit Drain	11/55	-	Active
216-A-15	C-13	Prop. Sampler Pit Drain	11/55	-	Active
216-A-16	C-14	241-A Deentrainment Floor Drain	1/56	-	Active
216-A-17	C-14	Overflow from A-16	1/56	-	Active
216-A-18	C-15	Start-up Wastes	11/55	12/55	Abandoned
216-A-19	C-16	Start-up Wastes	11/55	12/55	Abandoned
216-A-20	C-17	Start-up Wastes	11/55	12/55	Abandoned
216-A-21	C-18 & 19	NH ₃ Scrubber & Stack Drain Caustic Scrubber Wastes	12/58 10/57	- 6/58	Active
216-A-22	C-20	203-A Cond. & Floor Drain	11/55	-	Active
216-A-23A	C-21	241-A Fan House Drain	1957	-	Active
216-A-23B	C-21	Overflow from A-23A	1957	-	Active
216-A-24	C-22 & 23	Tank Farm Cond. Effl.	5/58	-	Active
216-A-25	C-24	Cooling Water	12/57	-	Active
216-A-26A	C-25 & 26	Fan Control Room Drain	3/59	-	Active
216-A-26B	C-25 & 26	291 Fan House Drain	3/59	-	Active

UNCLASSIFIED



UNCLASSIFIED

HW-55176 P11
Appendix B-2
Revised 1/17/61

CRIB INDEX
PUREX

<u>Number</u>	<u>Description Appendix Sheet</u>	<u>Service</u>	<u>Use Dates</u>		<u>Status</u>
			<u>From</u>	<u>To</u>	
216-A-27	C-27	Lab, Scrubber & Stack Drain	Not Used		Replace. for A-21
216-A-28	C-28	203-A Floor Drain	12/58		Active
216-A-29	None	Cooling Water & Chem. Waste	11/55	-	Active
216-A-30	C-29	Steam Condensate	1/61	-	Active
216-A-31	C-30	Organic Waste	Not Used		Replace. for A-2

UNCLASSIFIED

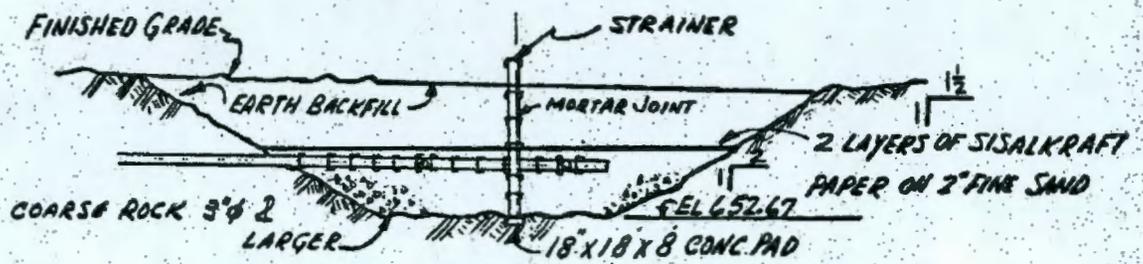
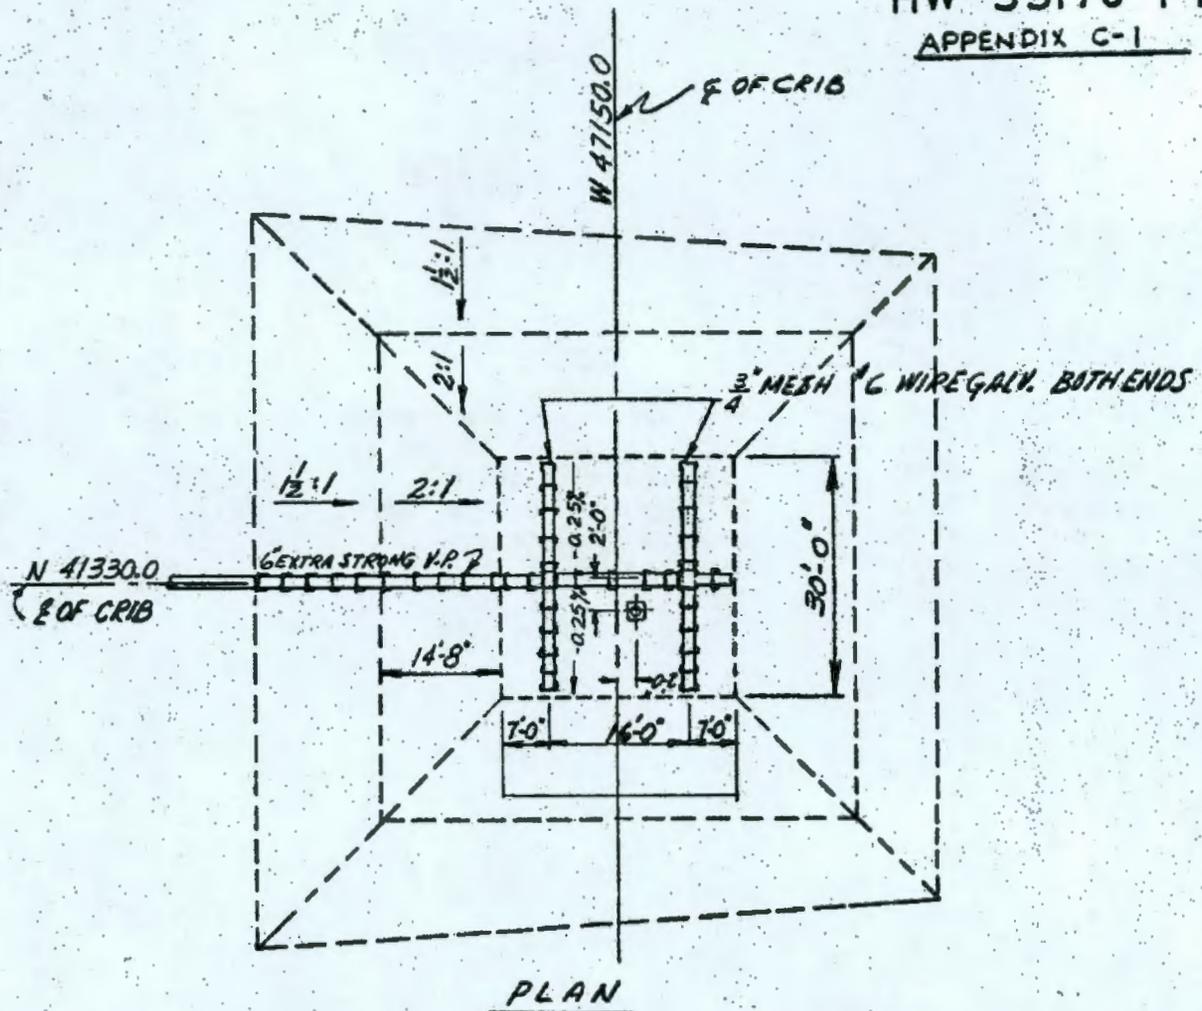


SECTION

CRIB WAS EXCAVATED, ROCKFILL WAS MADE
DISTRIBUTION SYSTEM WAS BUILT AND CRIB
WAS ABANDONED.


TAKEN FROM H-2-56016

216-A-1

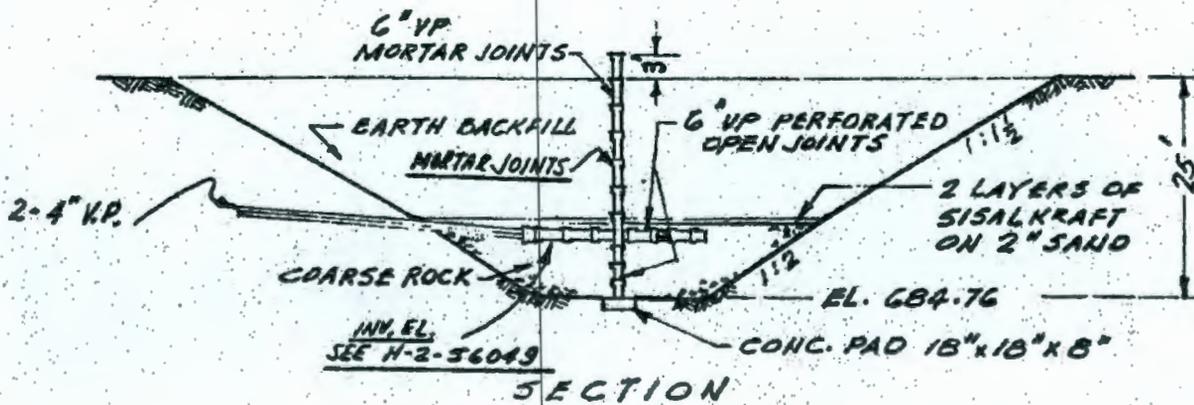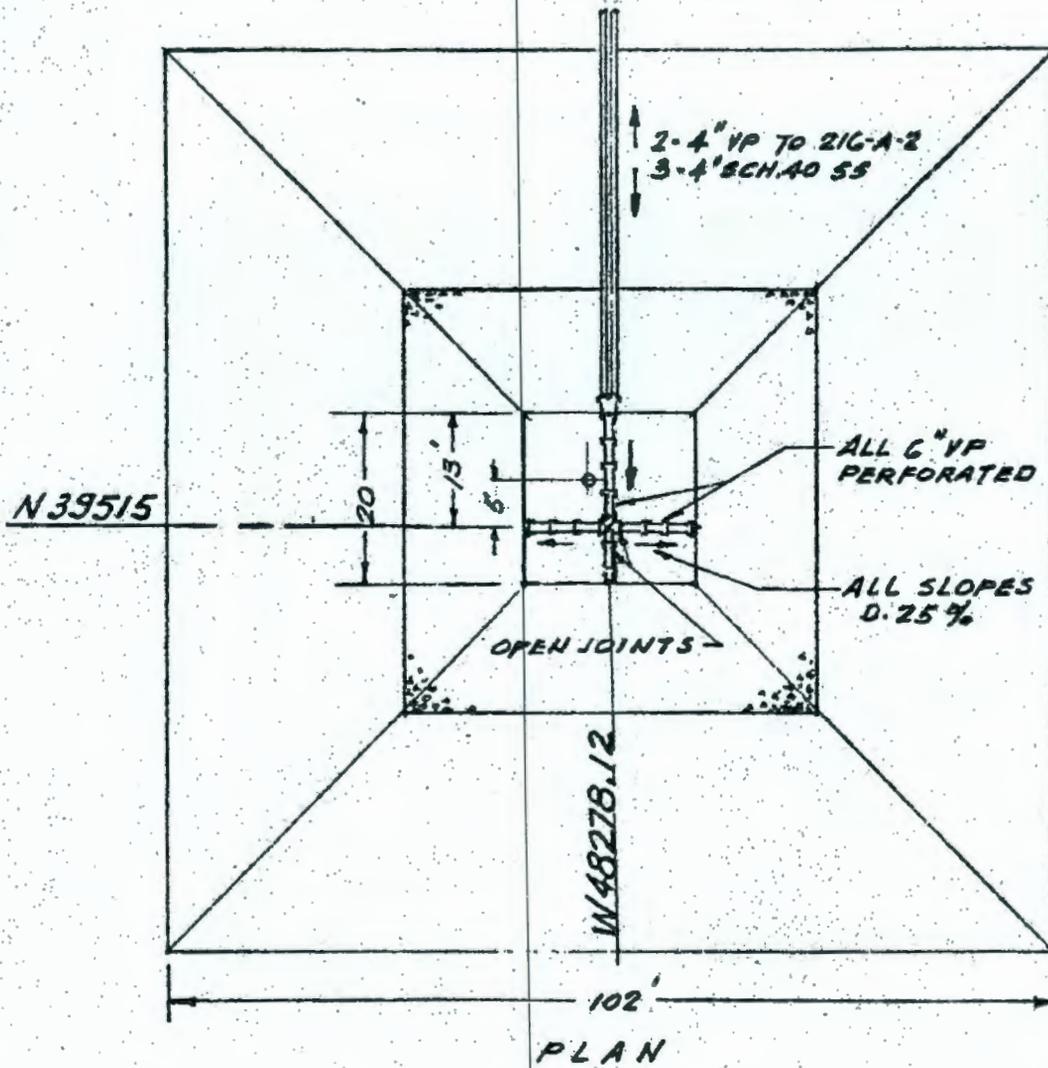


TAKEN FROM
H-2-56050

PUREX UNDERGROUND ROCK CRIB — 216-A-2

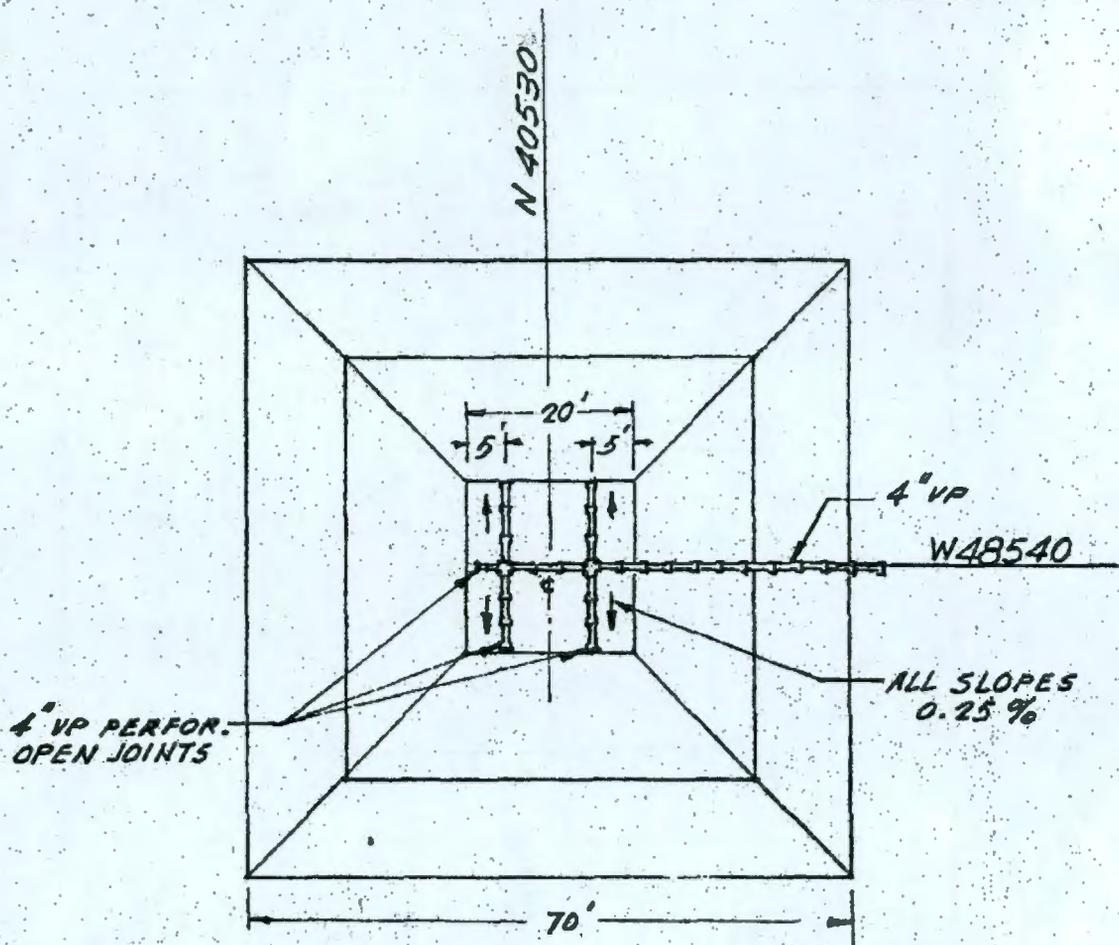


PLAN

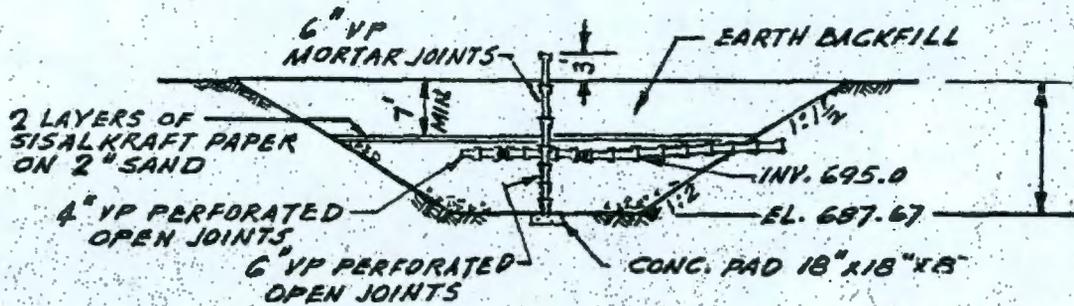


SECTION

TAKEN FROM
H-2-56050

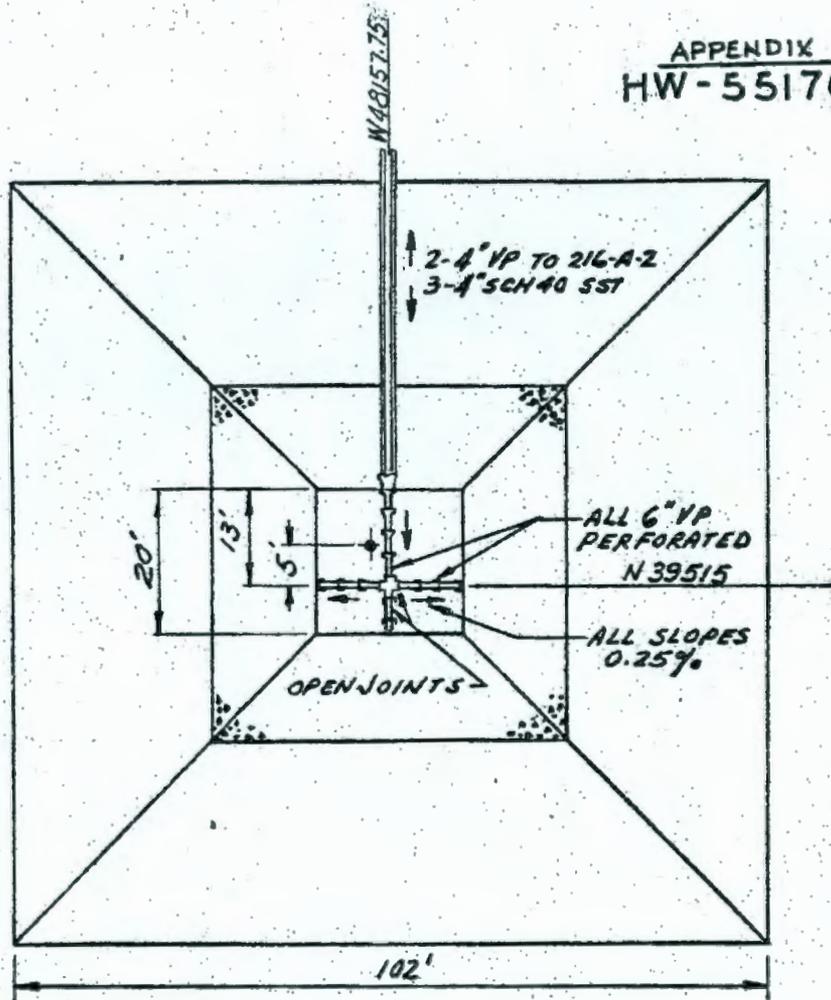



PLAN

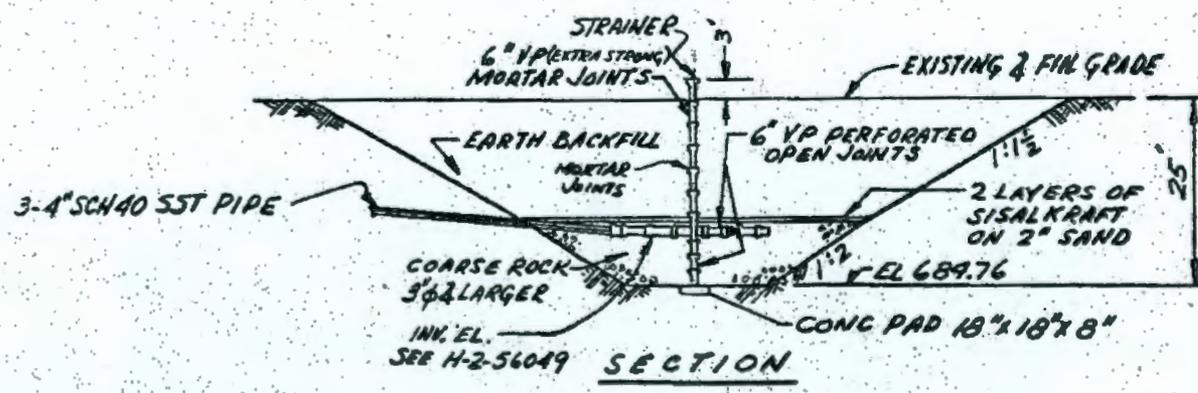

SECTION

TAKEN FROM H-2-56050



PUREX UNDERGROUND ROCK CRIB - 216-A-4

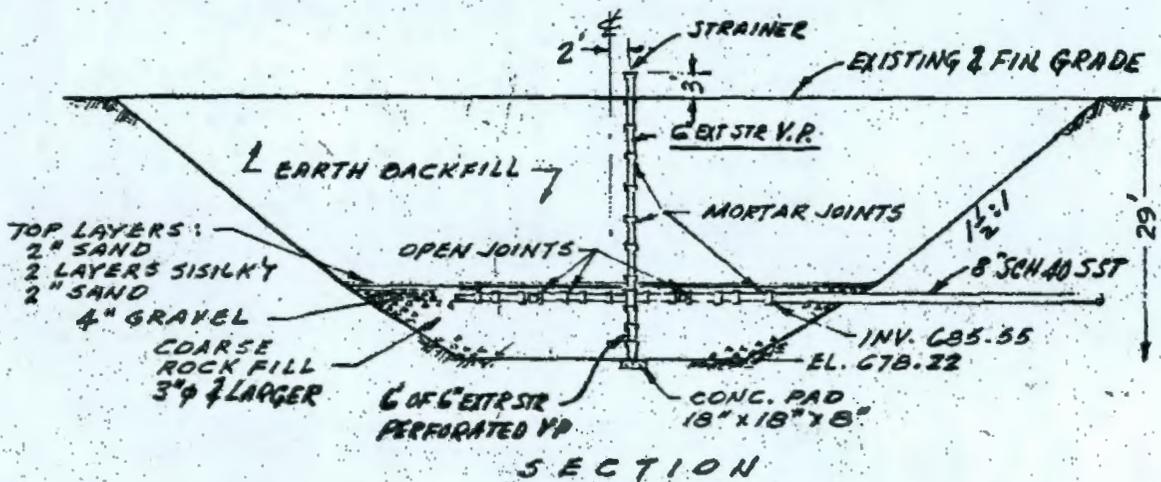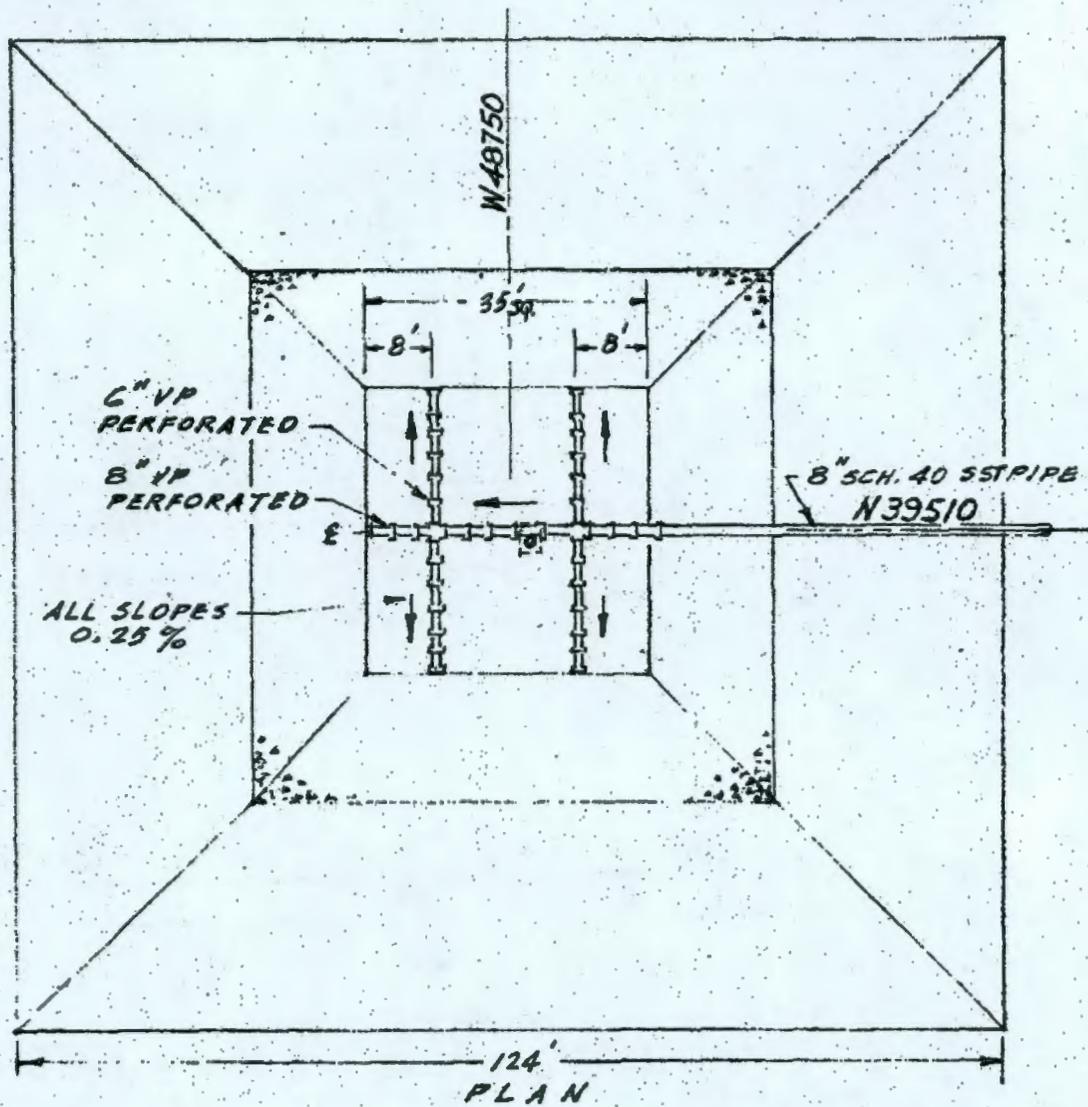

TAKEN FROM
H-2-56050


HW-55176-PTI

APPENDIX C-7

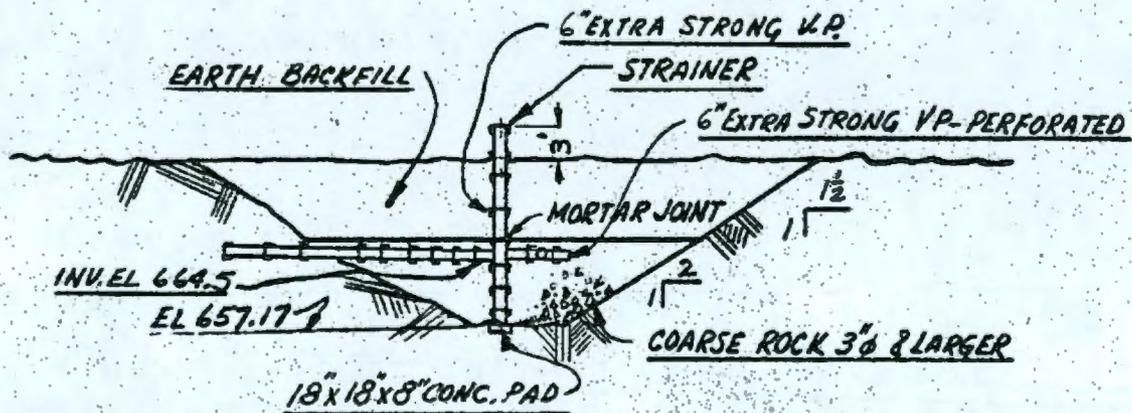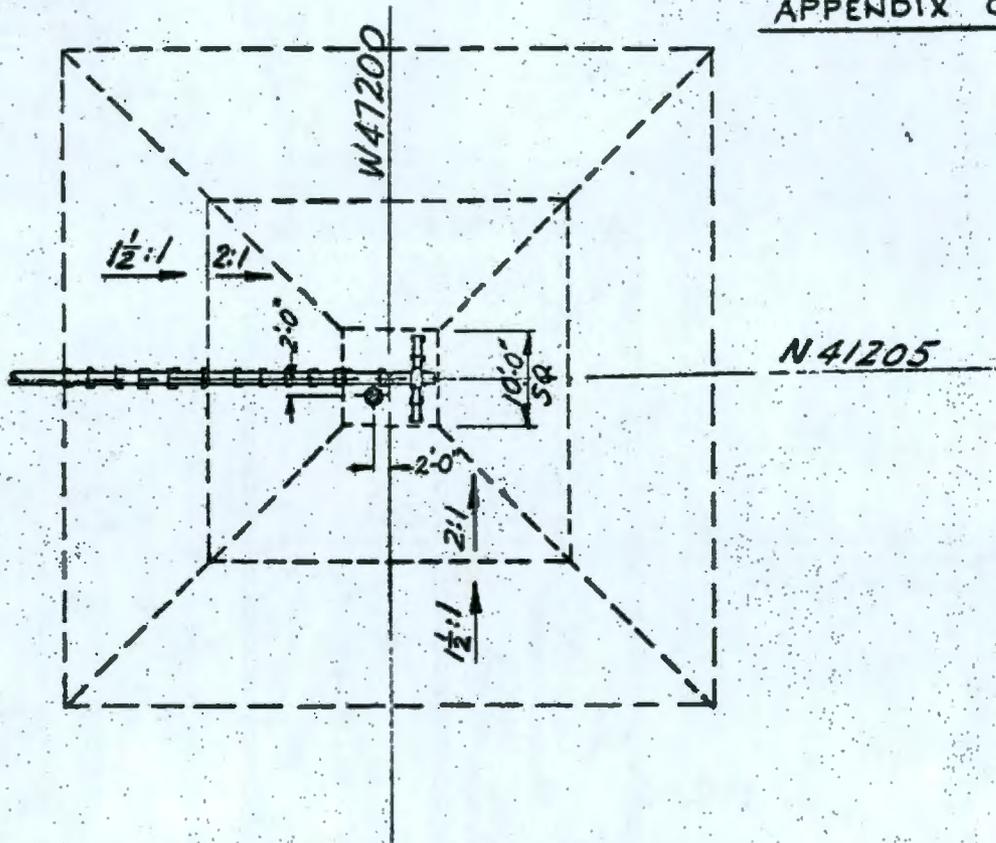


CRIB 216-A-7

FROM H-2-56016

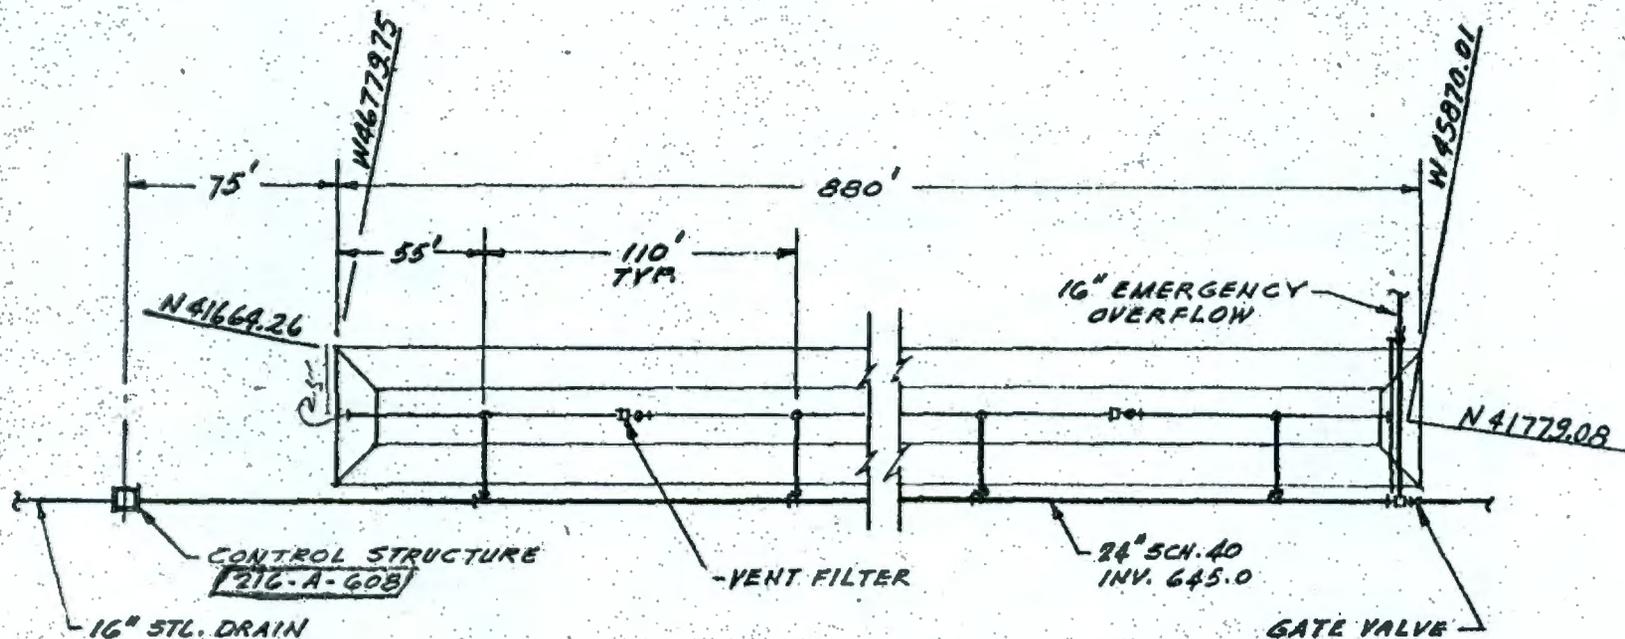

PLOT PLAN

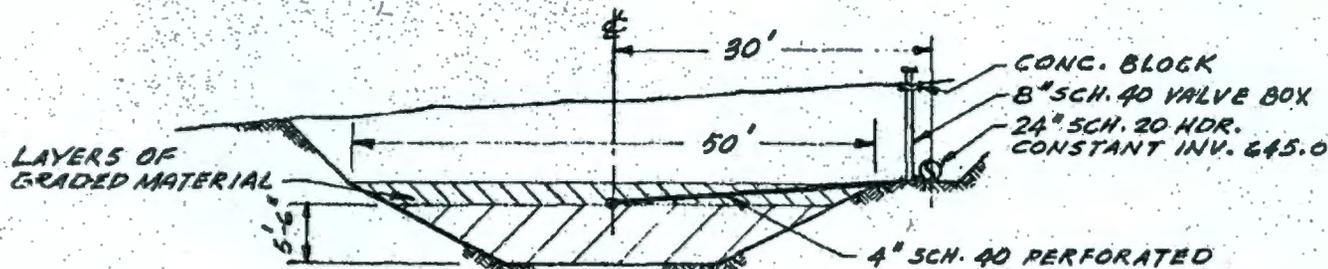



SECTION

PUREX CONDENSATE & COOLING WATER
CRIB 216-A-B

TAKEN FROM
H-2-56158
H-2-56157

HW-55176-PT1
APPENDIX C-8

HW 55176-PART I
 APPENDIX C-10
 DRAWN JLS/MEK 12/18/55

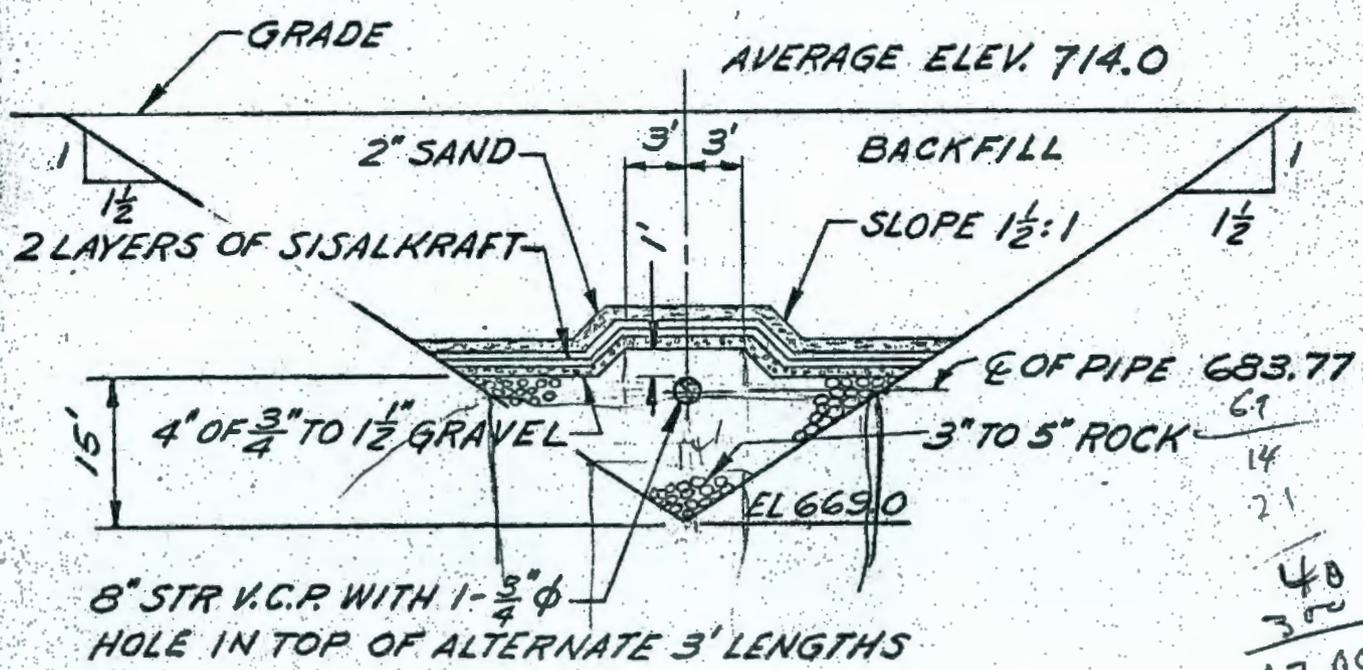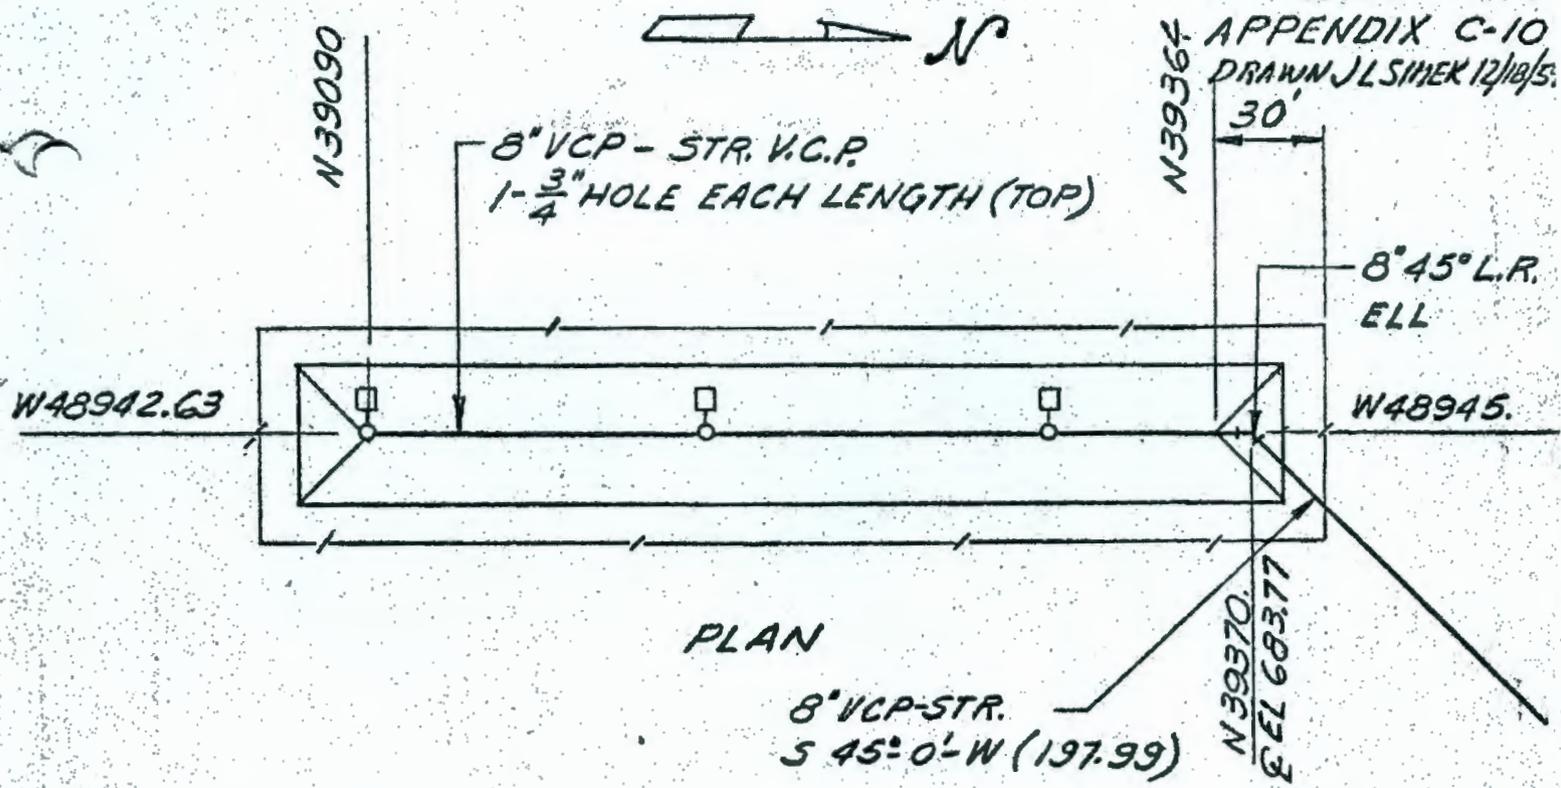

216-A-10
 H-2-55576


683
 400

 283
 10 C.V.

40
 300



 12,000
 1283

 3.4 x 10⁶ ft³
 7.5
 25 x 10⁶ gal

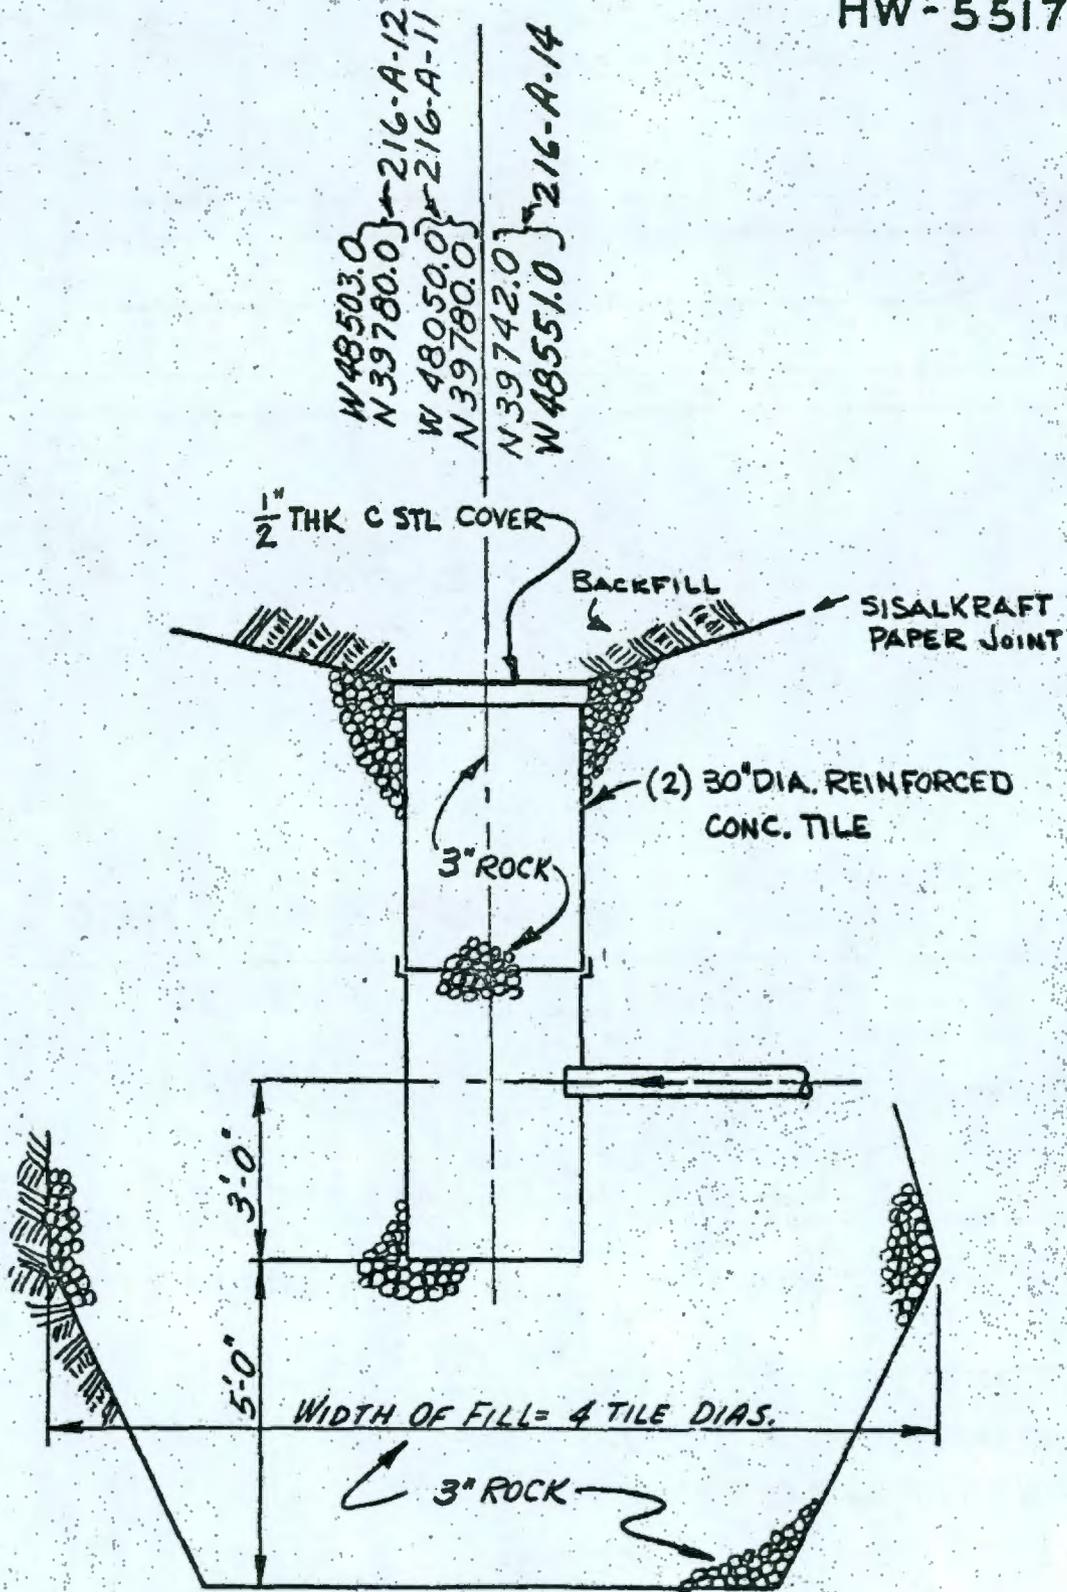


216-A-11
216-A-12
216-A-14

TAKEN FROM H-2-55090M

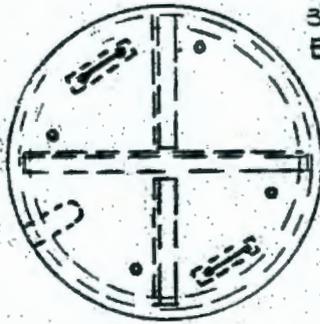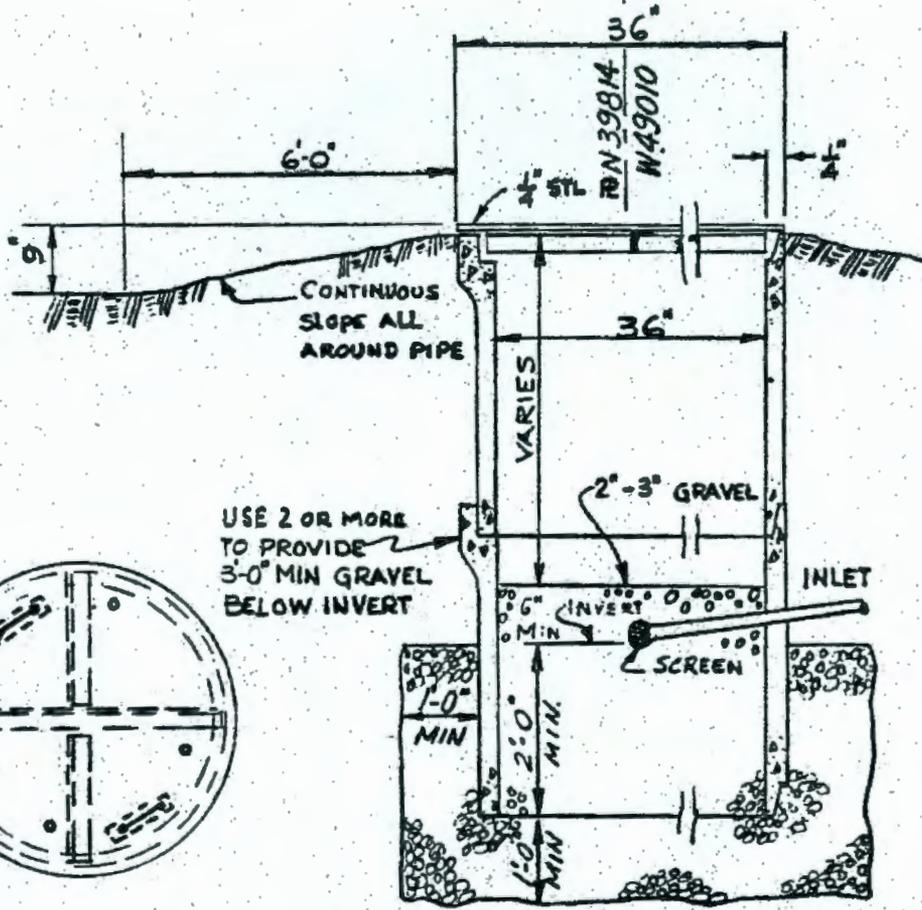

COVER PLAN



SECTION

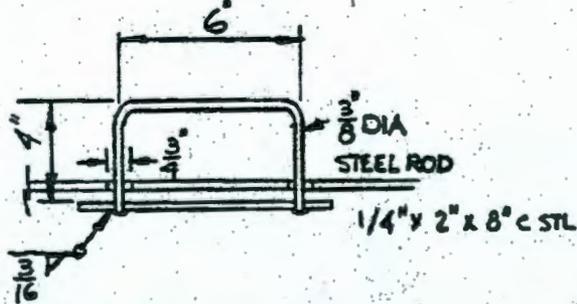



LIFTING HANDLE

TAKEN FROM SK-2-256B

216-A-13

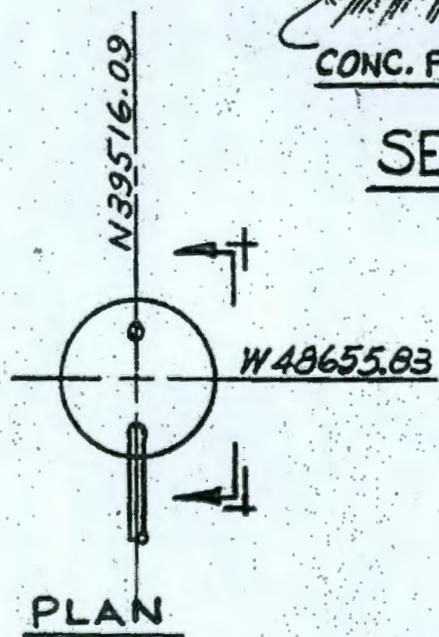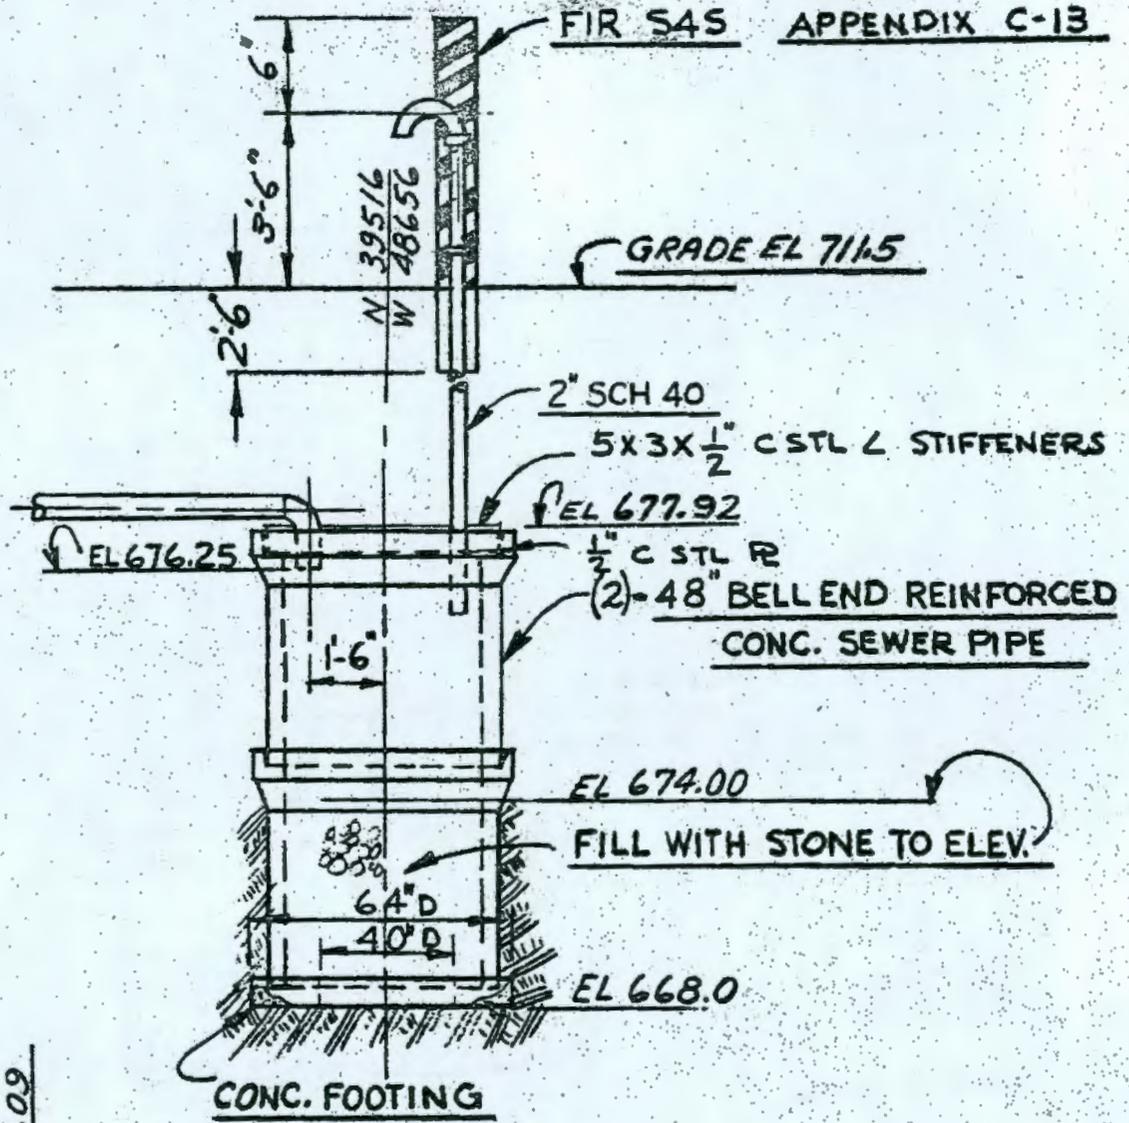


TAKEN FROM H-2-56045

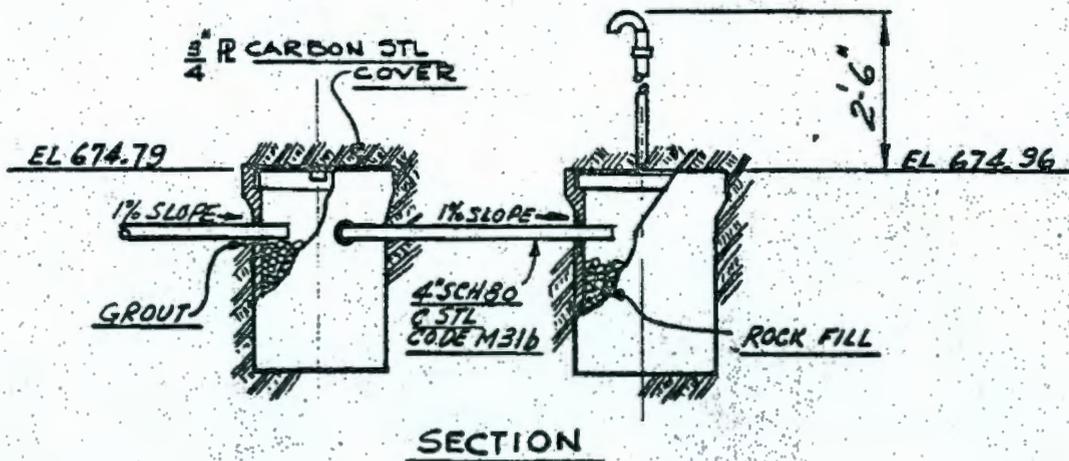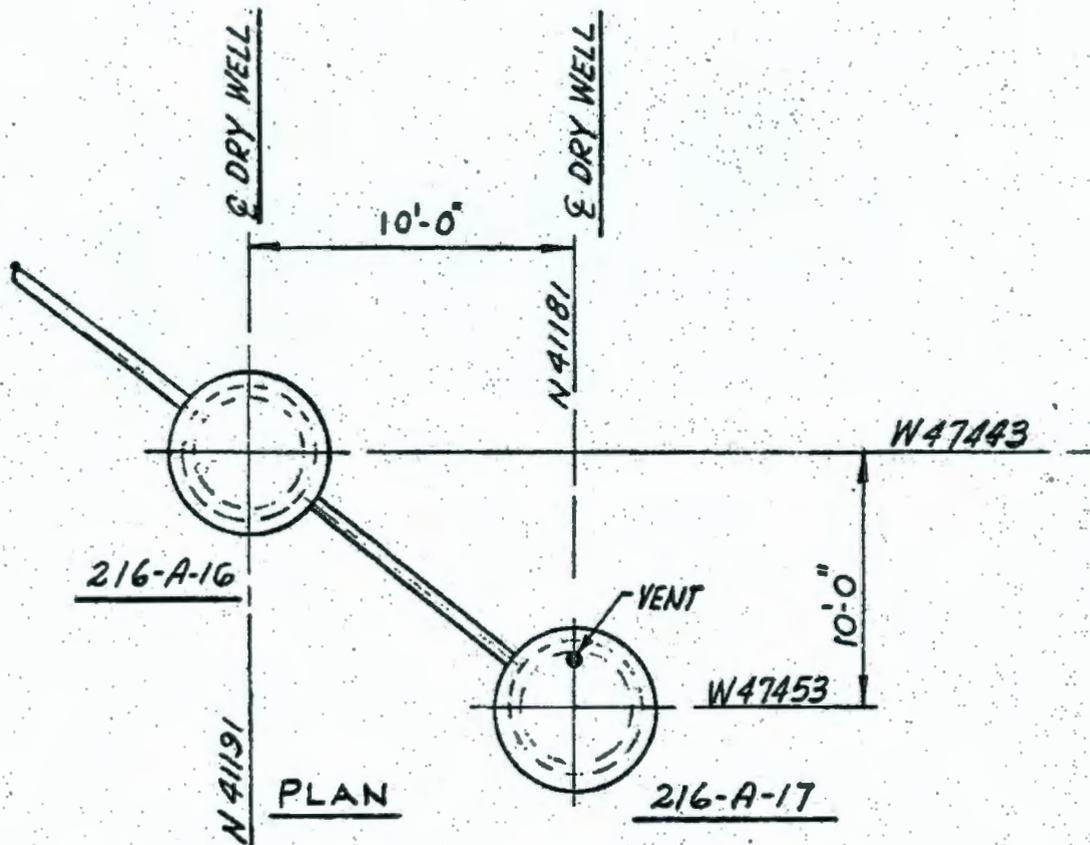

216-A-16

216-A-17


TAKEN FROM H-2-55943

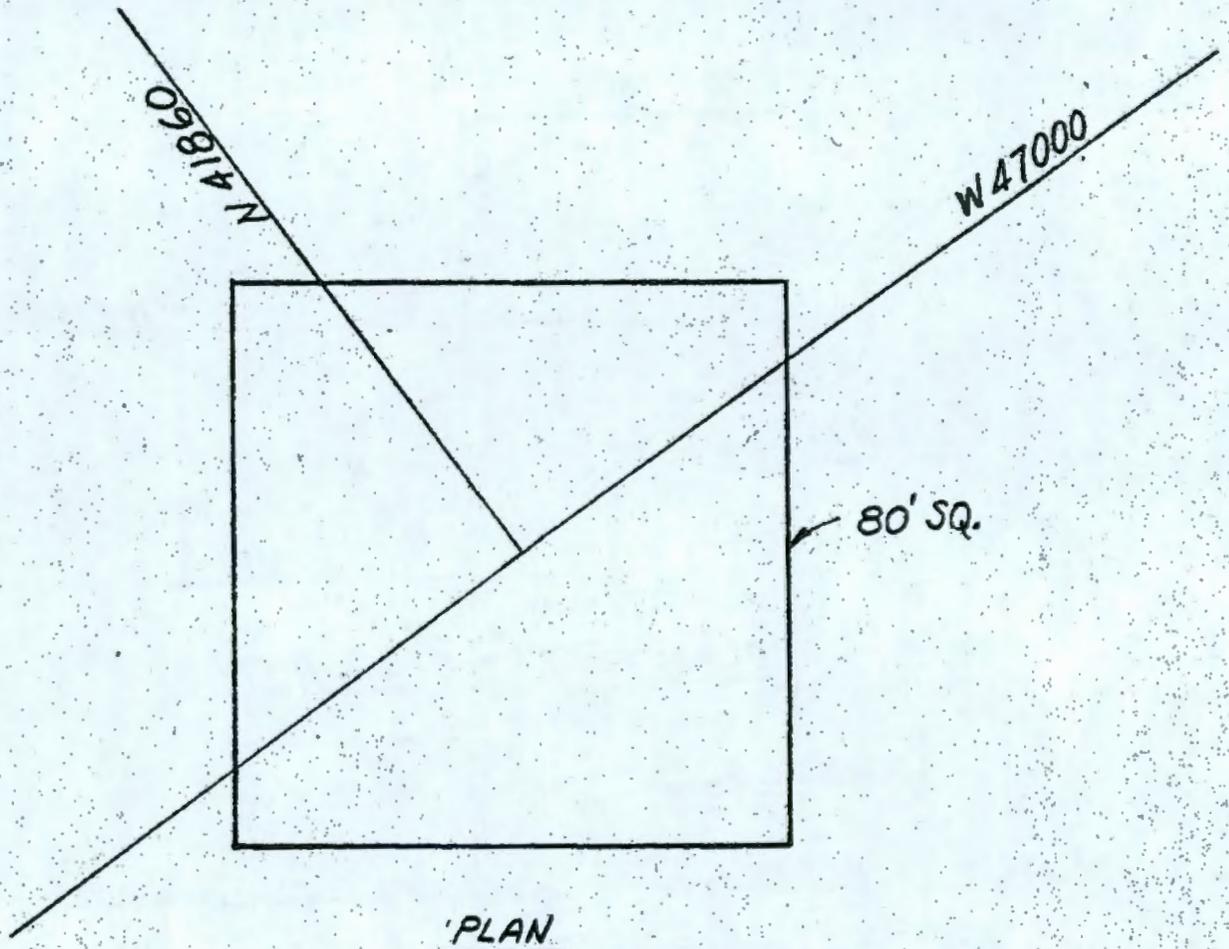

EXCAVATION FILLED - CRIB NEVER BUILT
START-UP WASTES DISPOSED IN EXCAVATION


216-A-18

TAKEN FROM H-2-55900

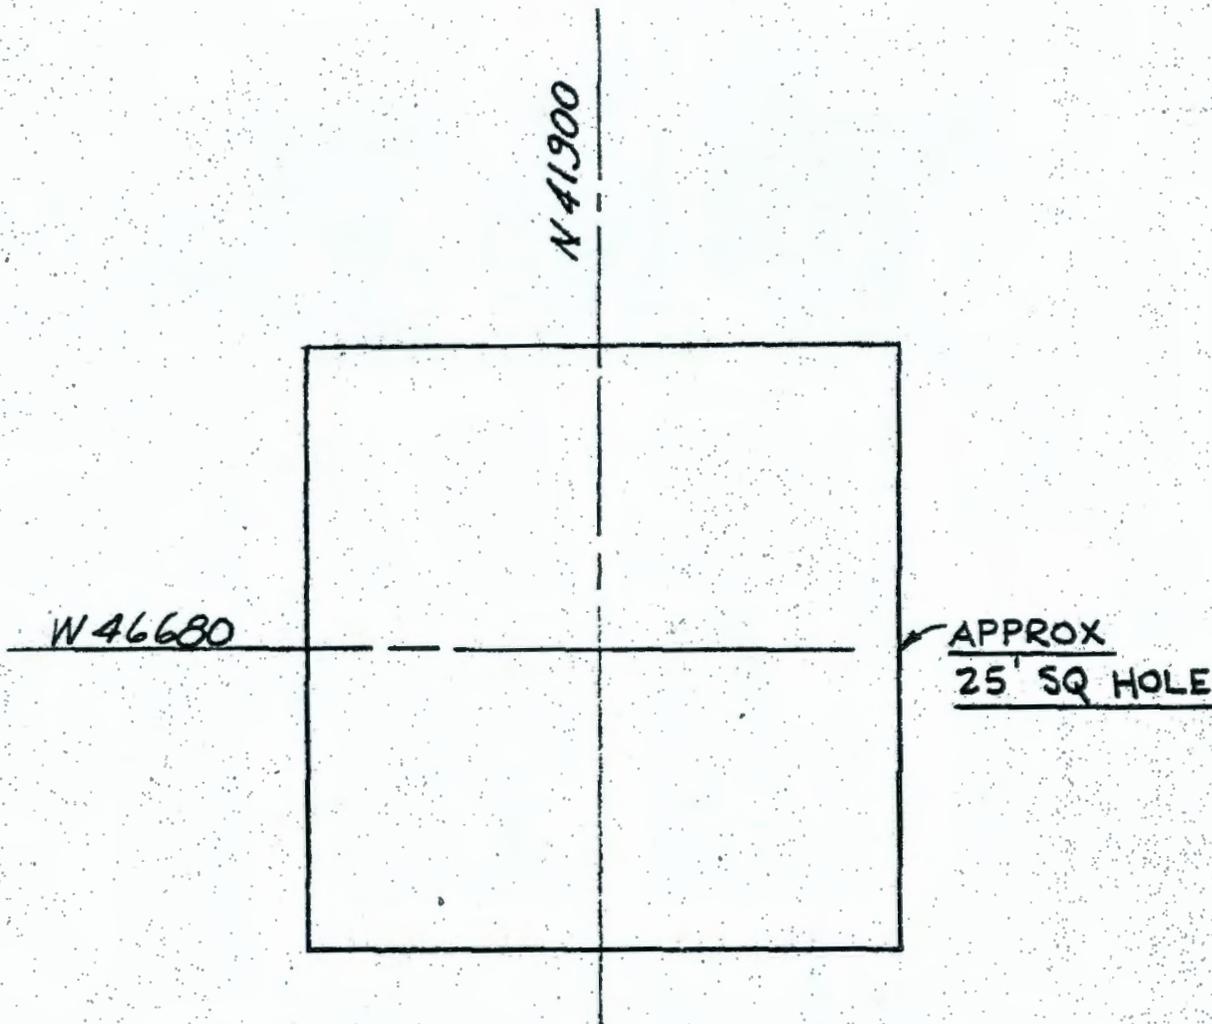

TEST HOLE EXCAVATED BY DRAGLINE
START-UP WASTES DISPOSED IN HOLE
BEFORE BACK-FILLING.


216-A-19

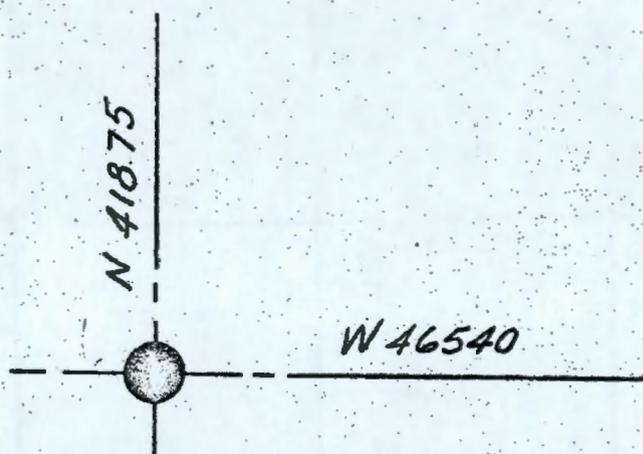


PLAN
TEST HOLE

TEST HOLE EXCAVATED BY DRAGLINE
START-UP WASTES DISPOSED IN HOLE
BEFORE BACK-FILLING.


216-A-20

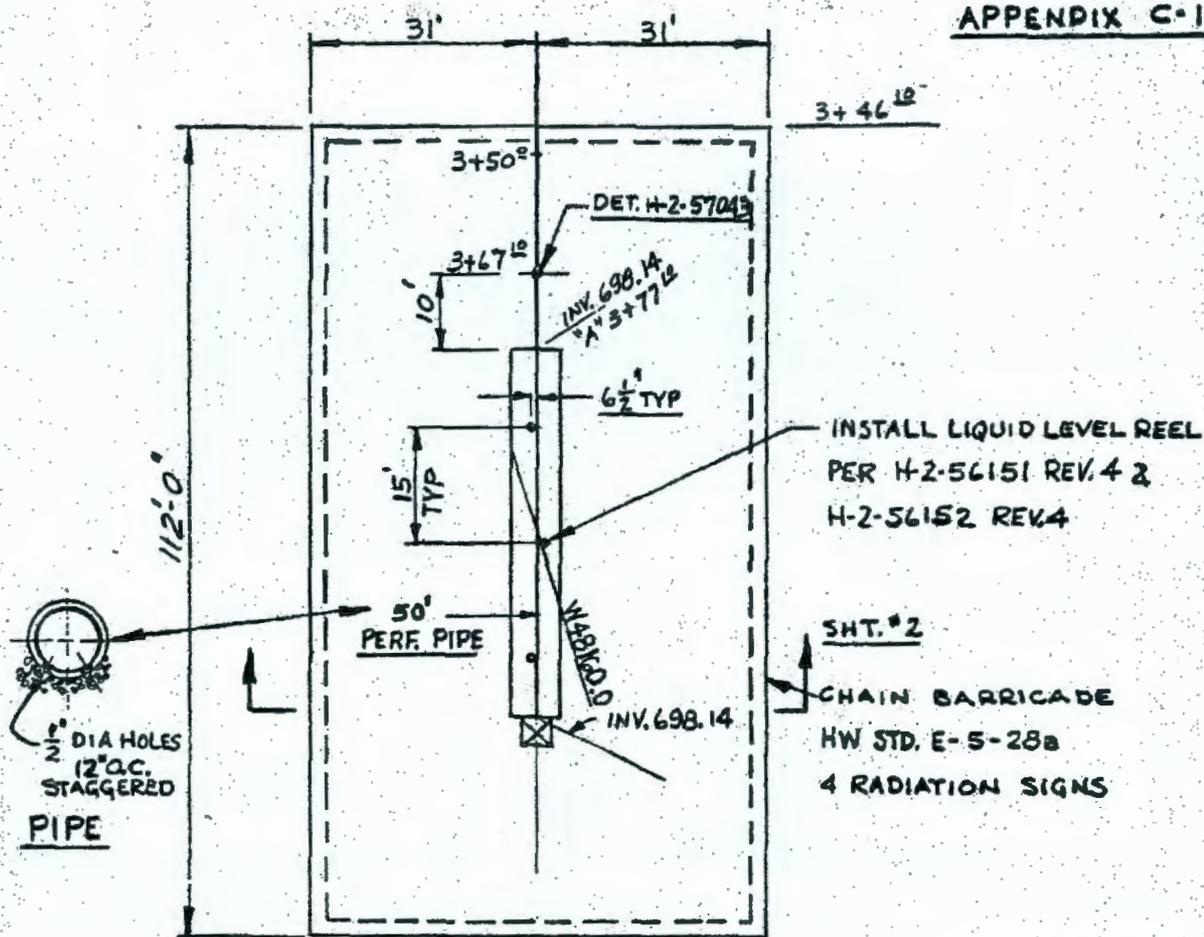

PLAN

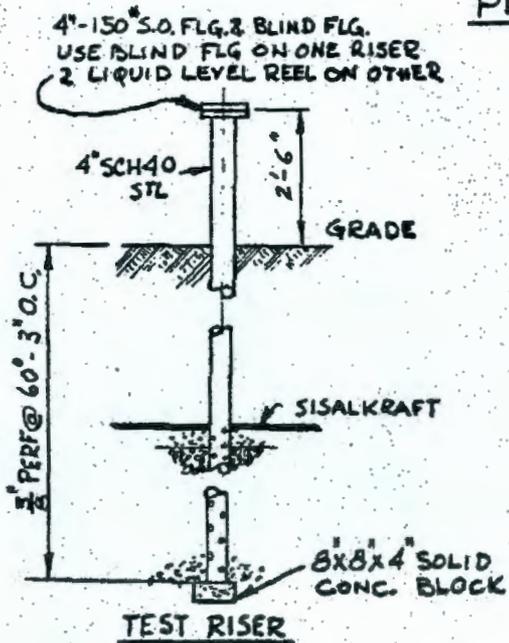


TEST RISER

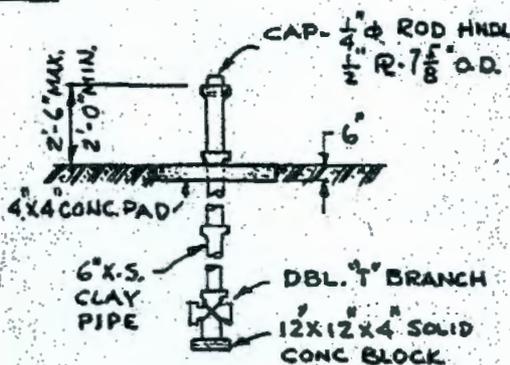


SAMPLER

216-A-21-SHT. 1

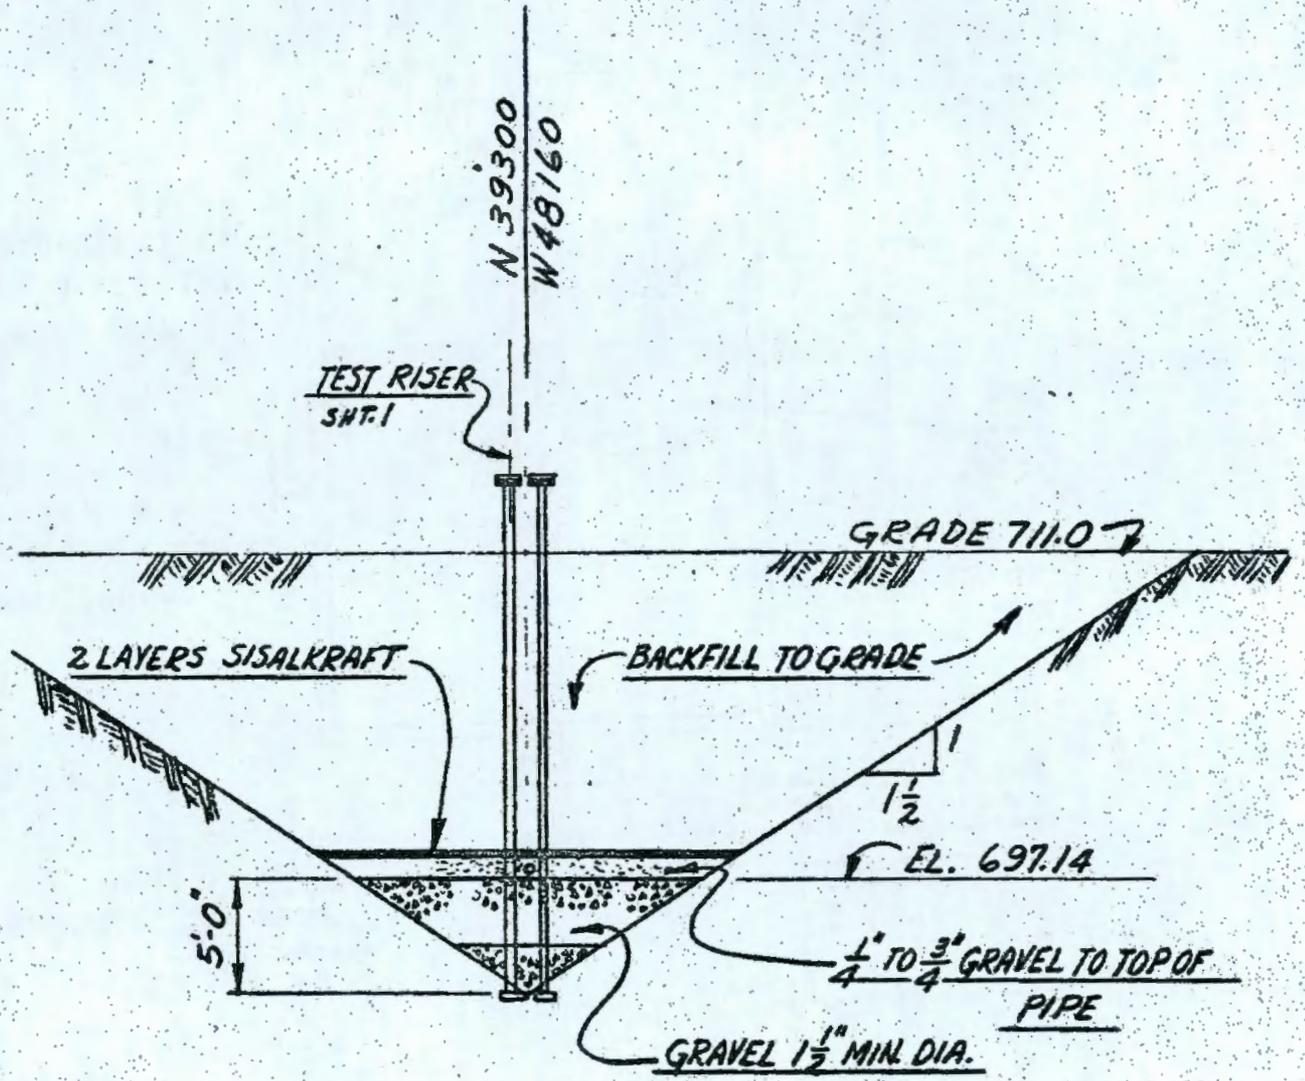


SECTION
CRIB-216-A-21-SHT.2

TAKEN FROM H-2-57043

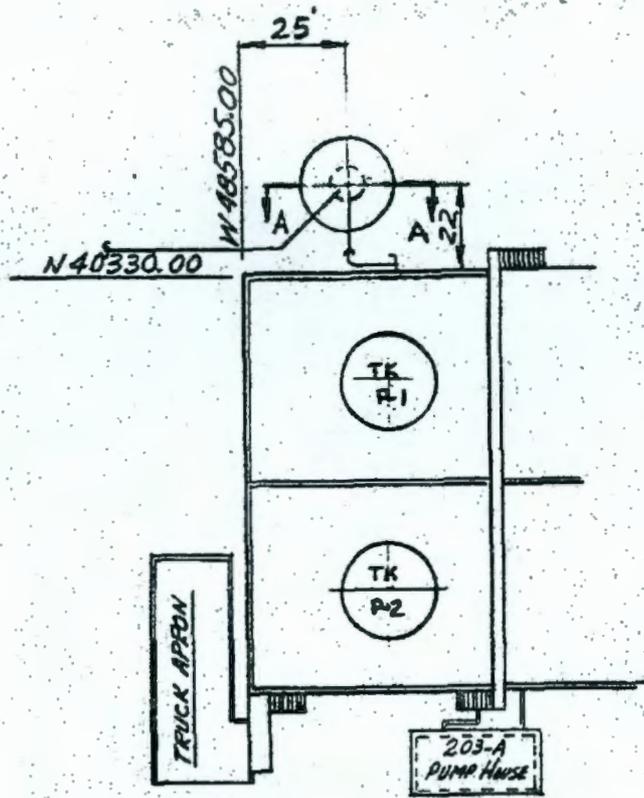


PLAN

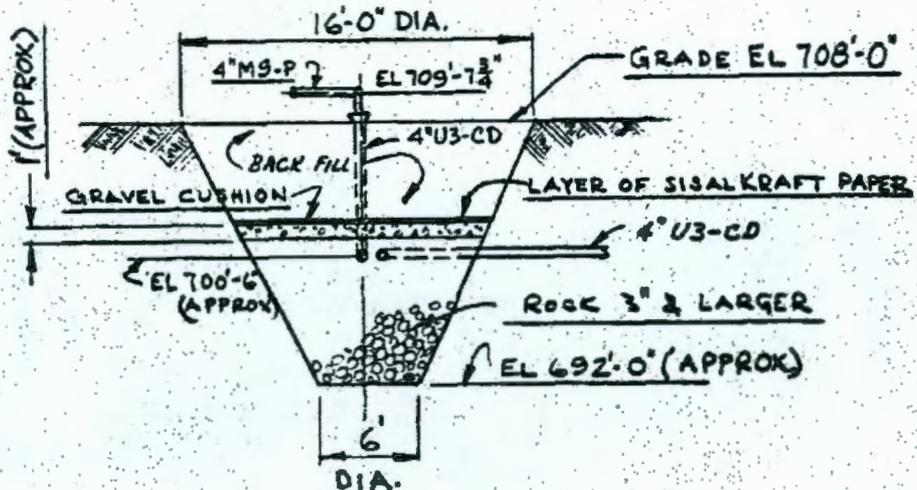

SECTION A-A
FRENCH DRAIN

216-A-22

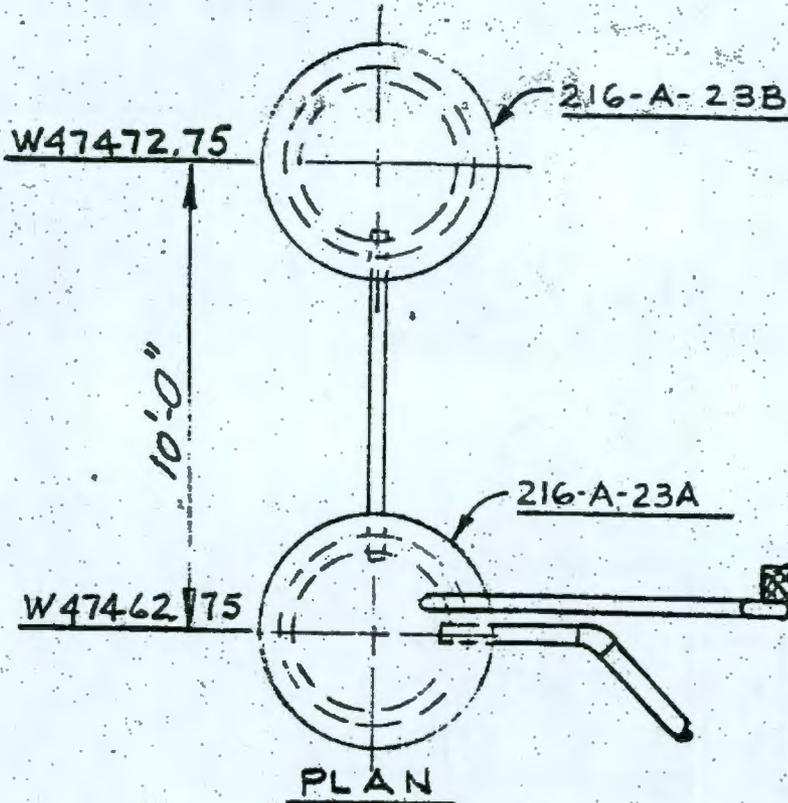

4x4 STRIPED POST

BACKFILL EL 686'-0"

FAN HOUSE
BLDG #241

$\frac{3}{4}$ " CSTL R
ELEV 679'-6"

N41171.67

2" SCH40 CSTL VENT

1° SLOPE

42" NOM X 6'-0" LONG
STD WT CONC PIPE
OR EQ.


GROUT
ROCK FILL

ELEV

TAKEN FROM H-2-56999

216A-23A & 23B


HW-55176-PTI
APPENDIX C-22

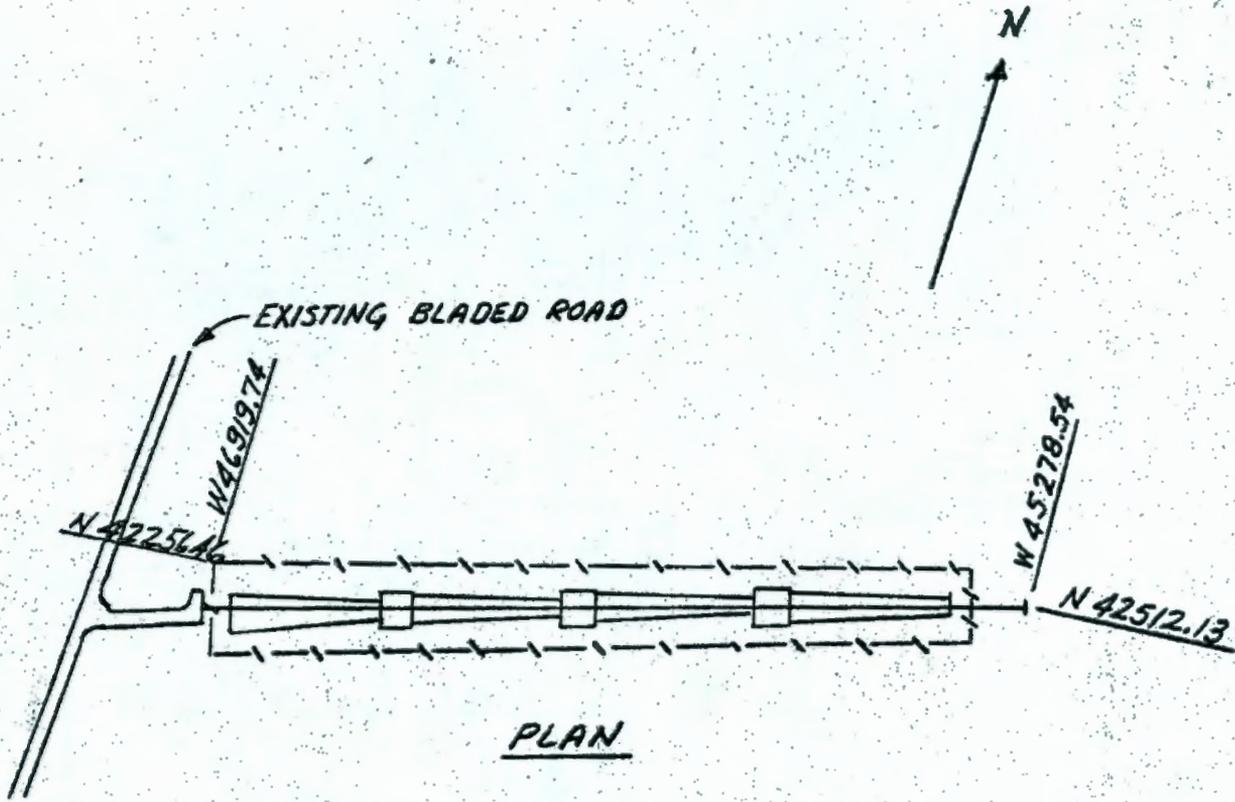


TAKEN FROM H-2-56977

216-A-24
SHT NO. 1

APPENDIX C-23
 HW-55176-PTI

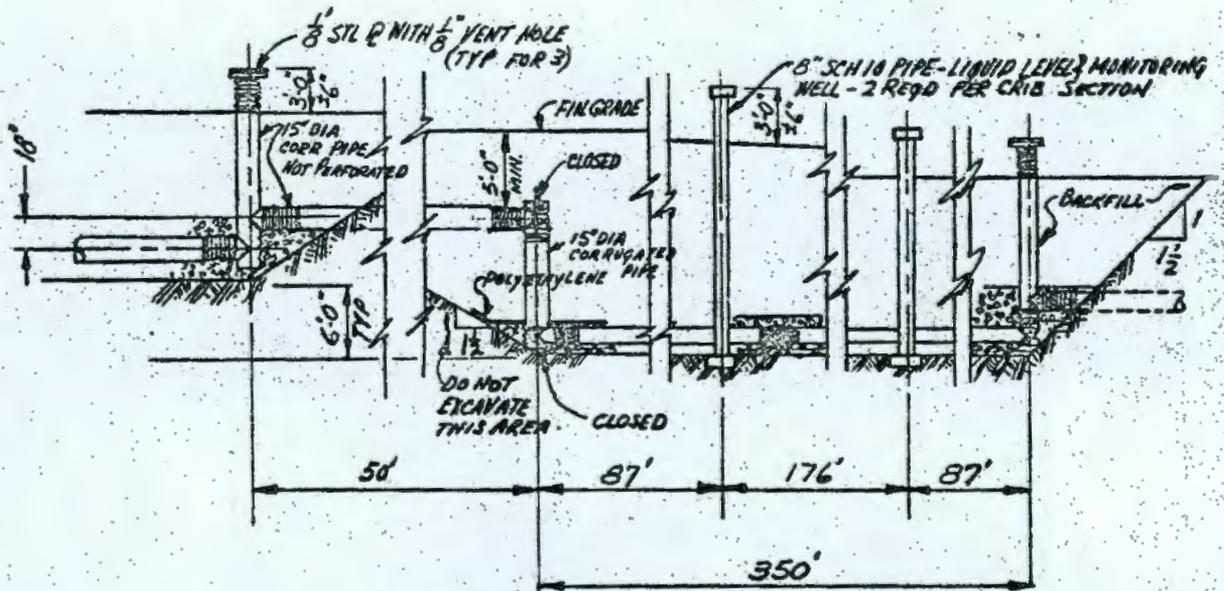


LONGITUDINAL SECTION

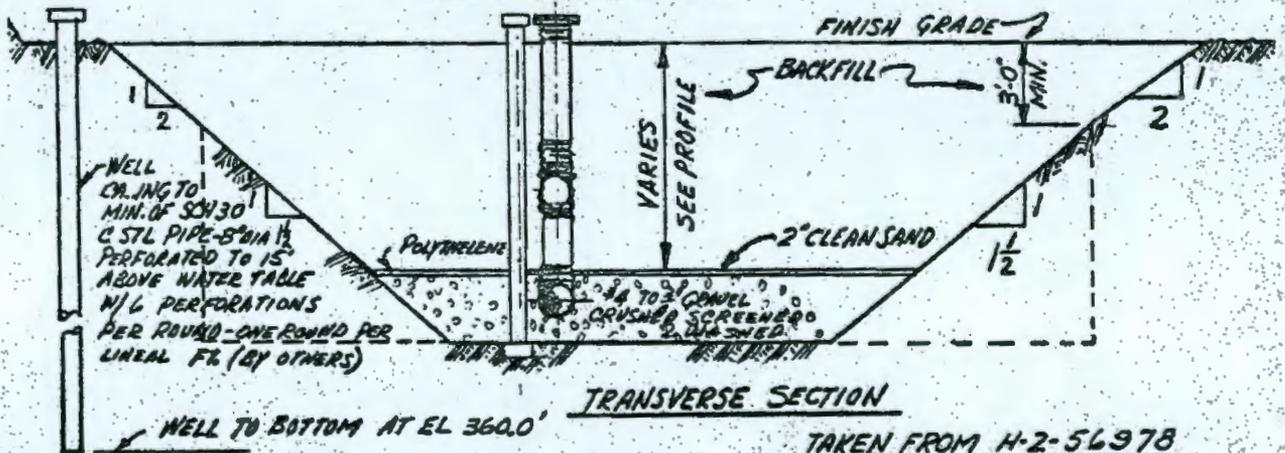


TRANSVERSE SECTION

CRIB 216-A-24
 SHT NO. 2

TAKEN FROM H-2-56978
 H-2-56977

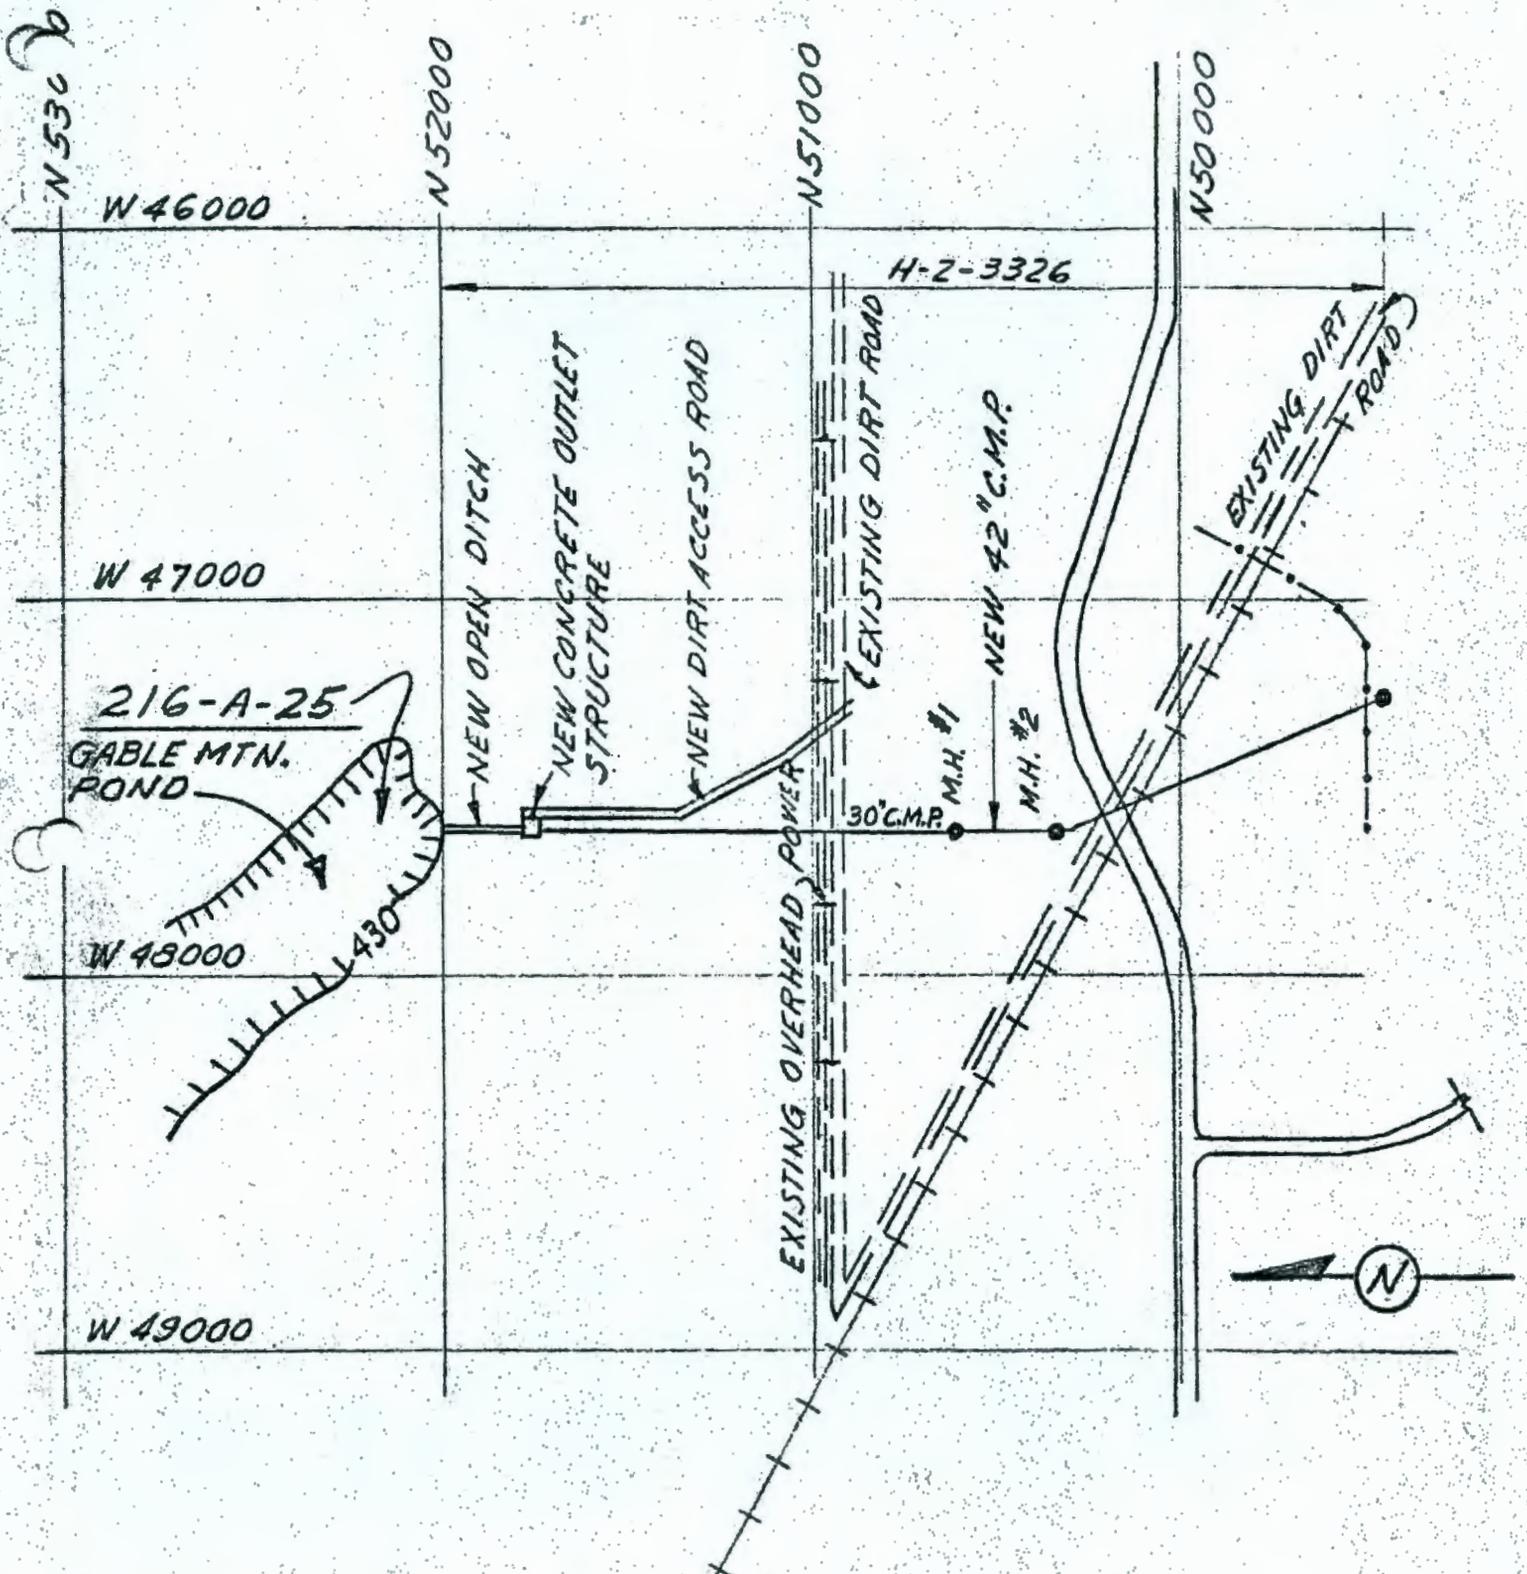


216-A-25
H-2-3325

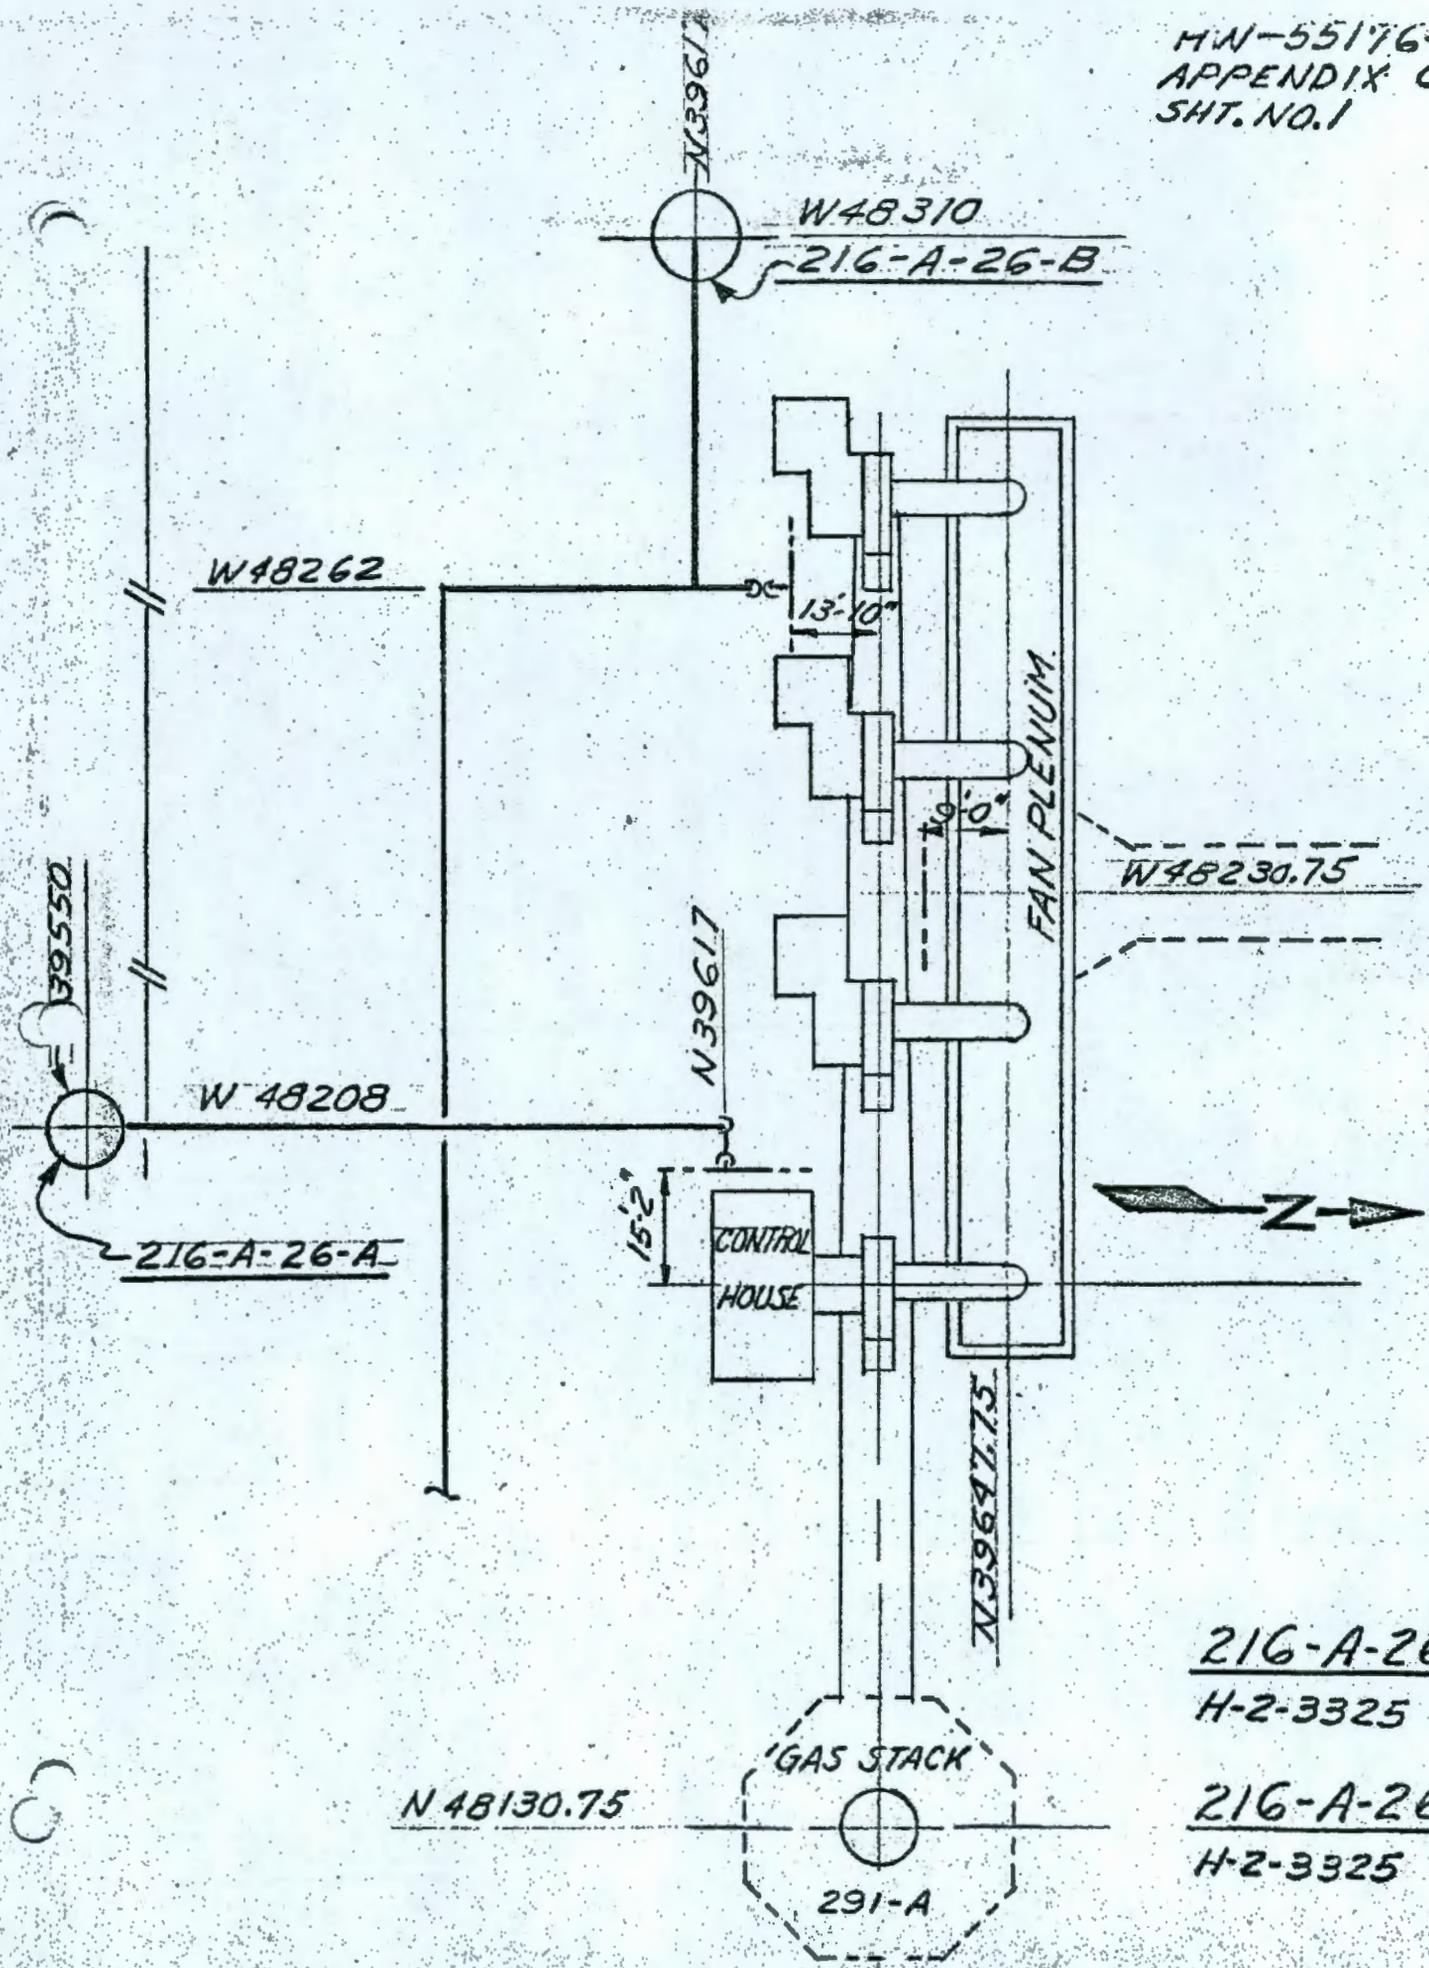


216-A-26A
H-2-3325

216-A-26B
H-2-3325

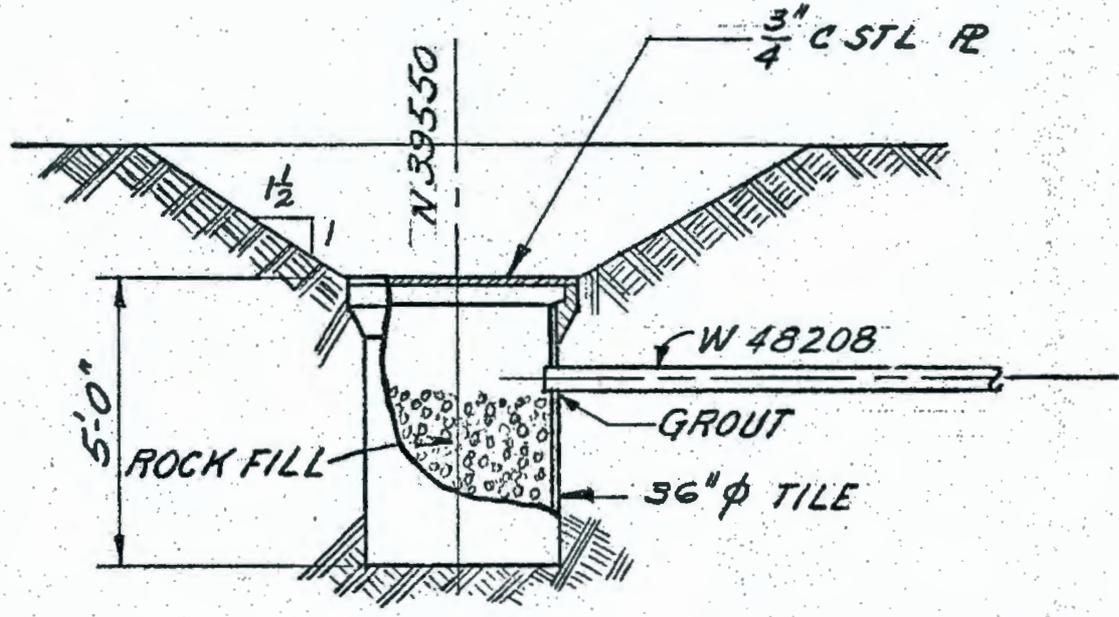


216-A-26A

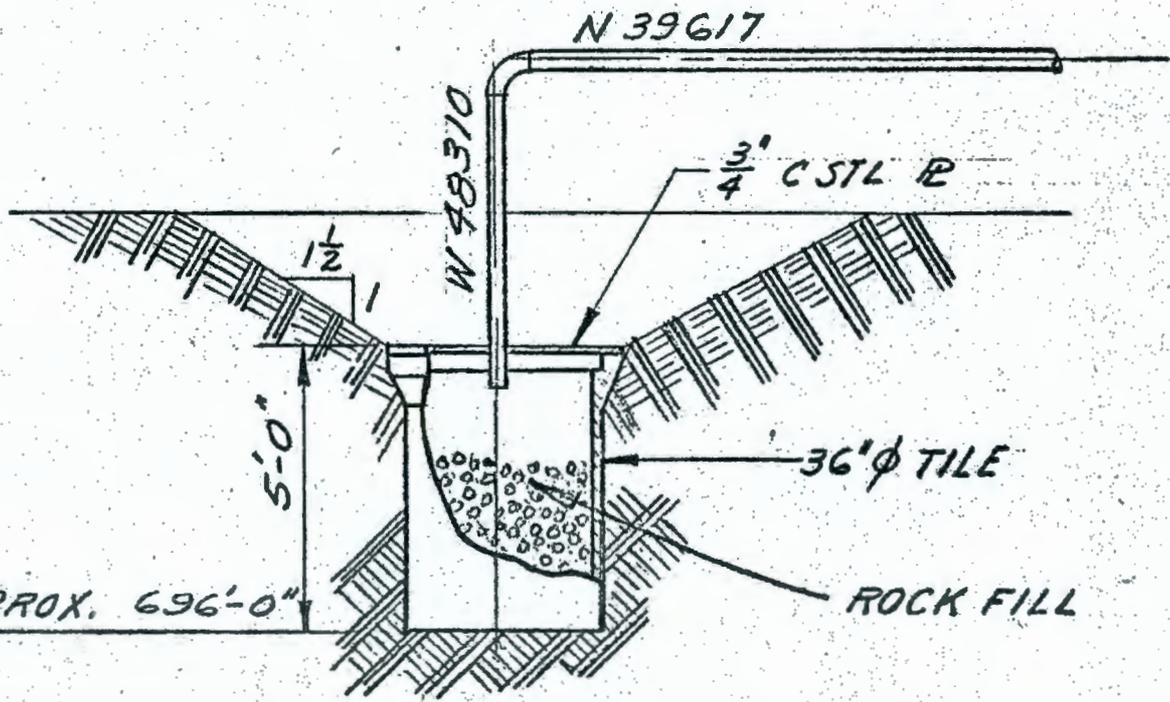


216-A-26B


HW 55176-PART 1
 APPENDIX C-27
 DRAWN JLSIMEK 12/18/59

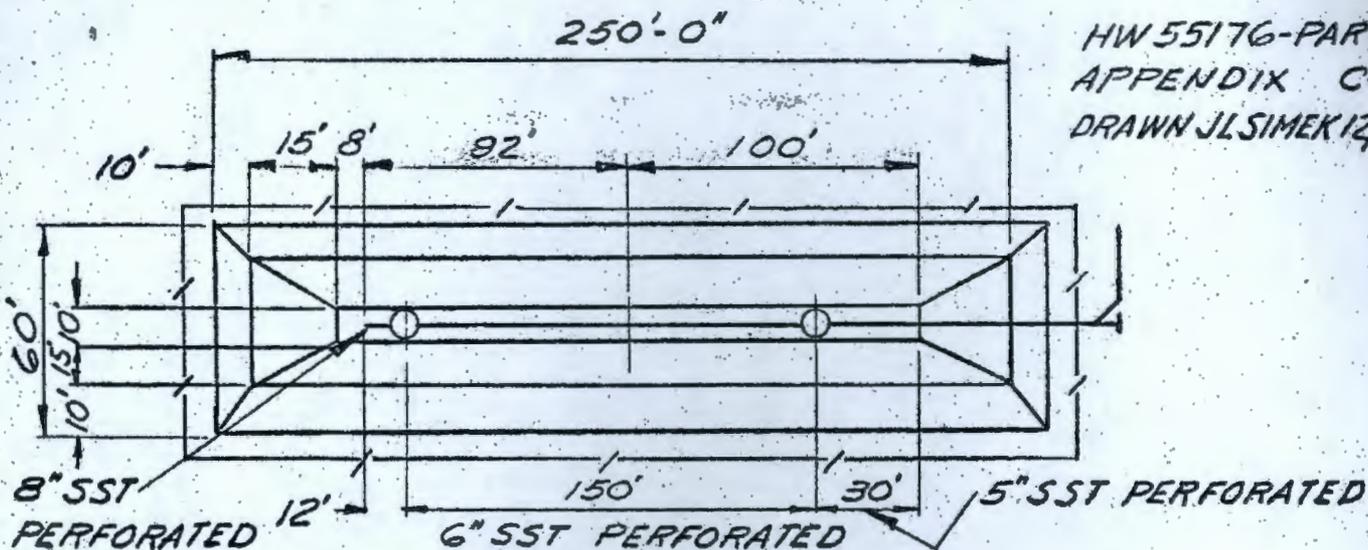



PLAN

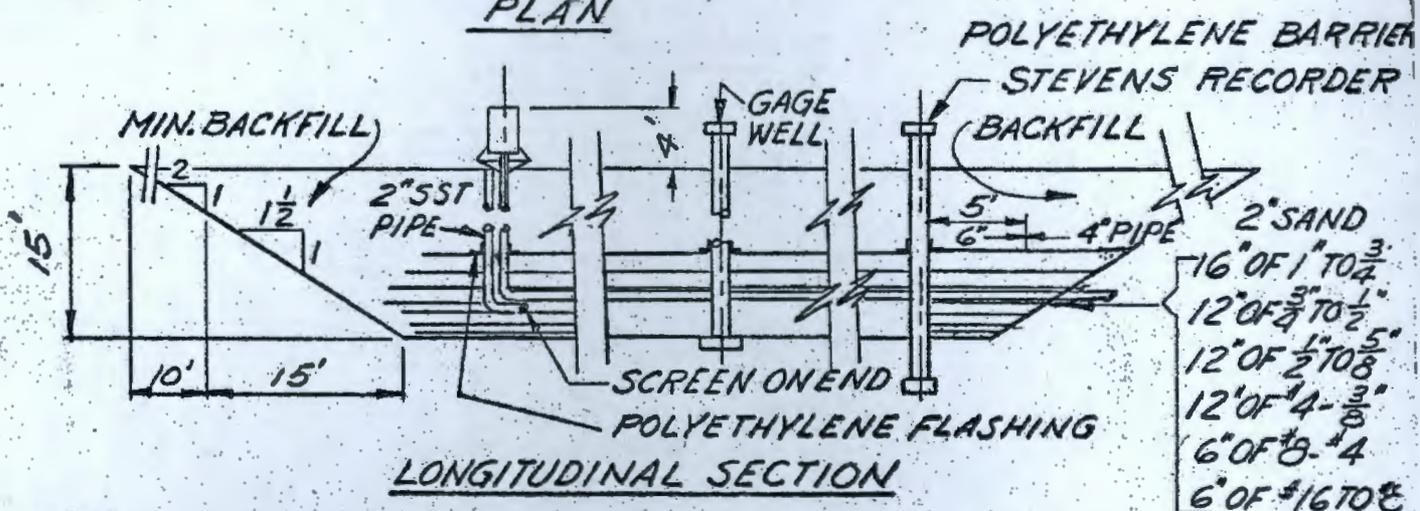


LONGITUDINAL SECTION

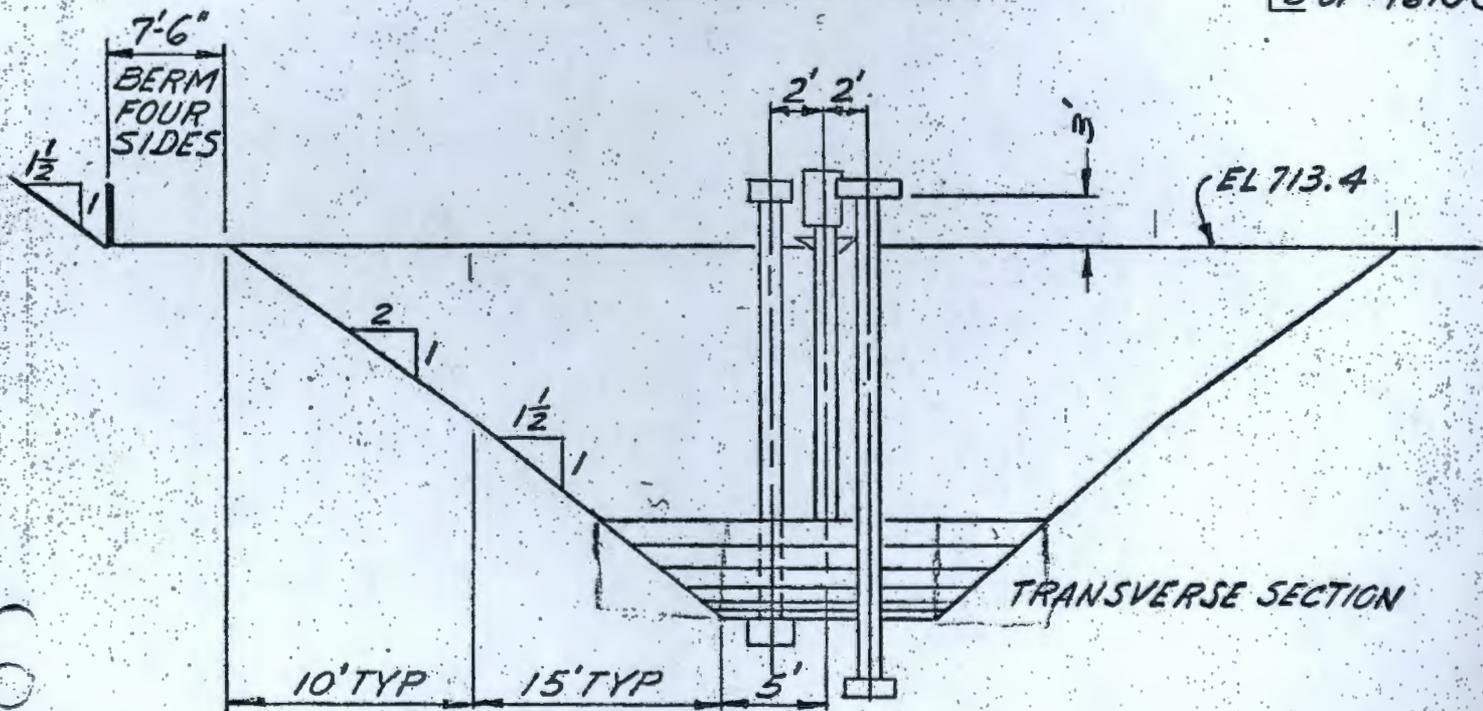


216-A-27
 H-2-57509

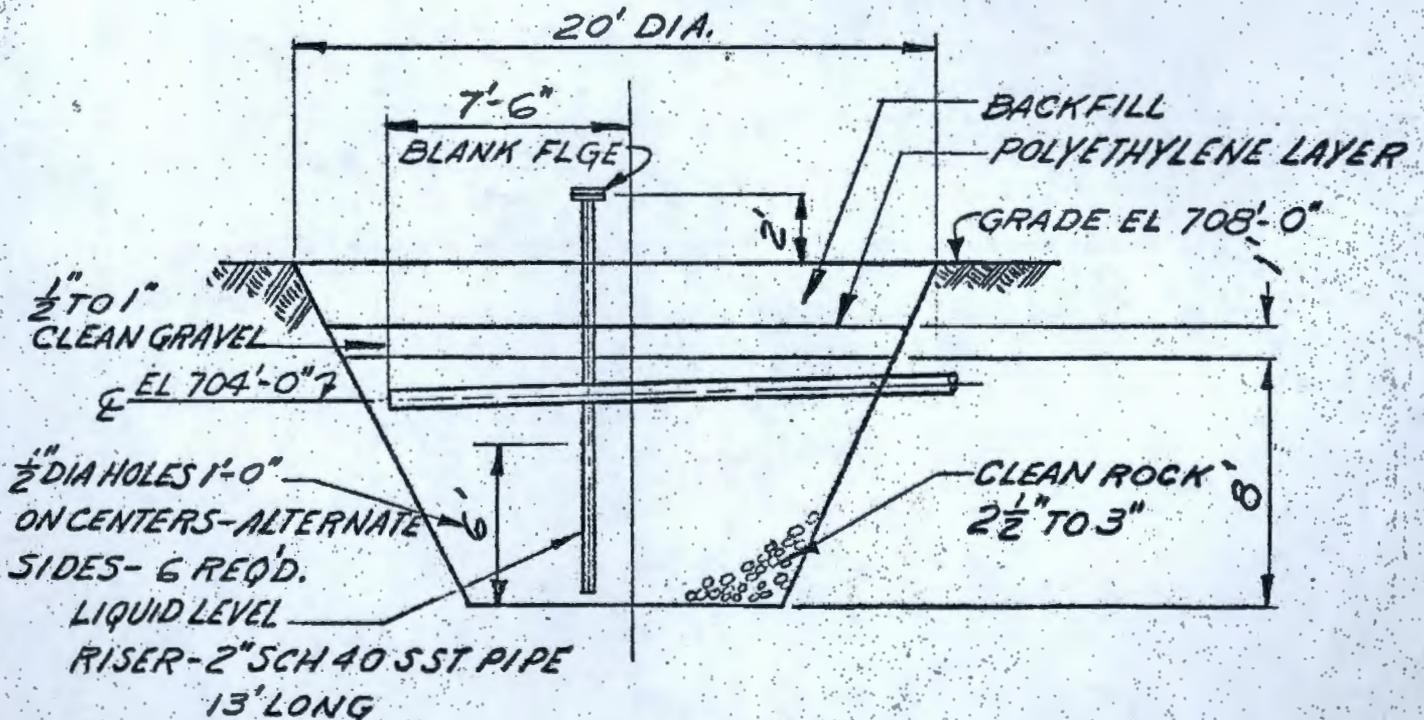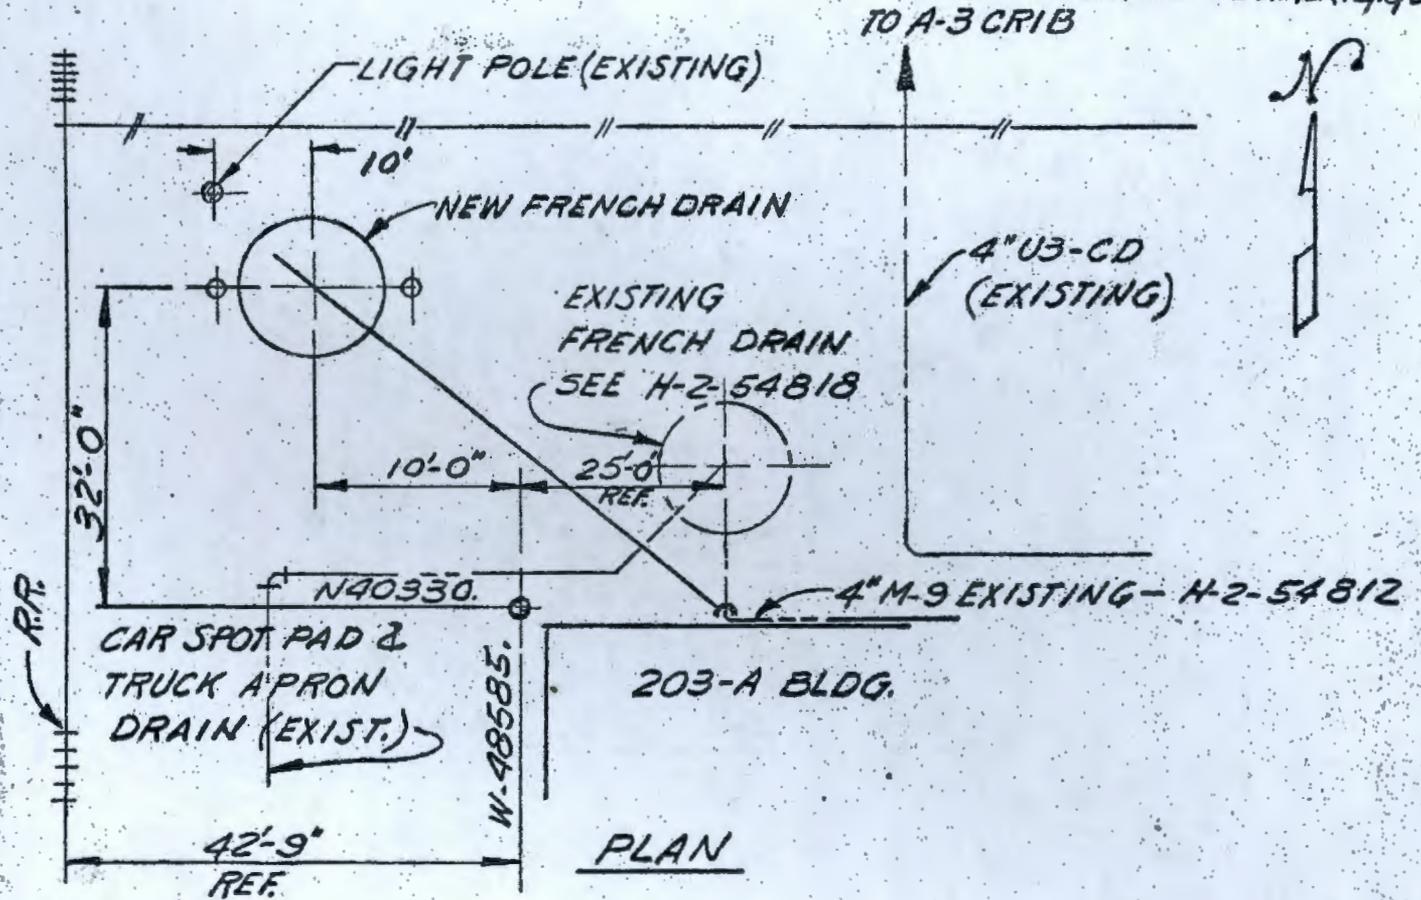

216-A-28
 H-2-57617

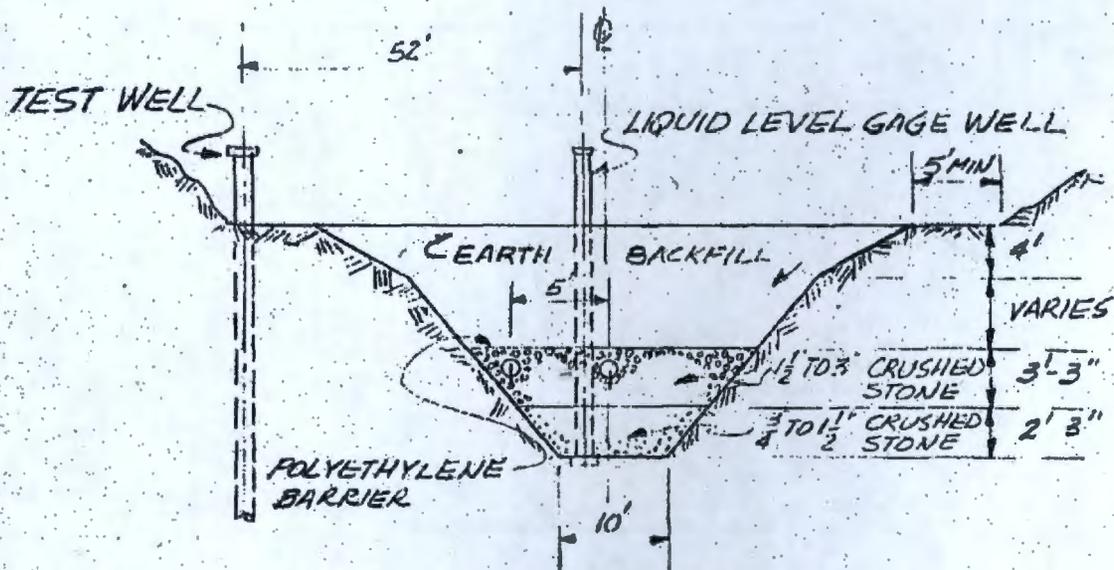


TYPICAL CRIB CROSS SECTION

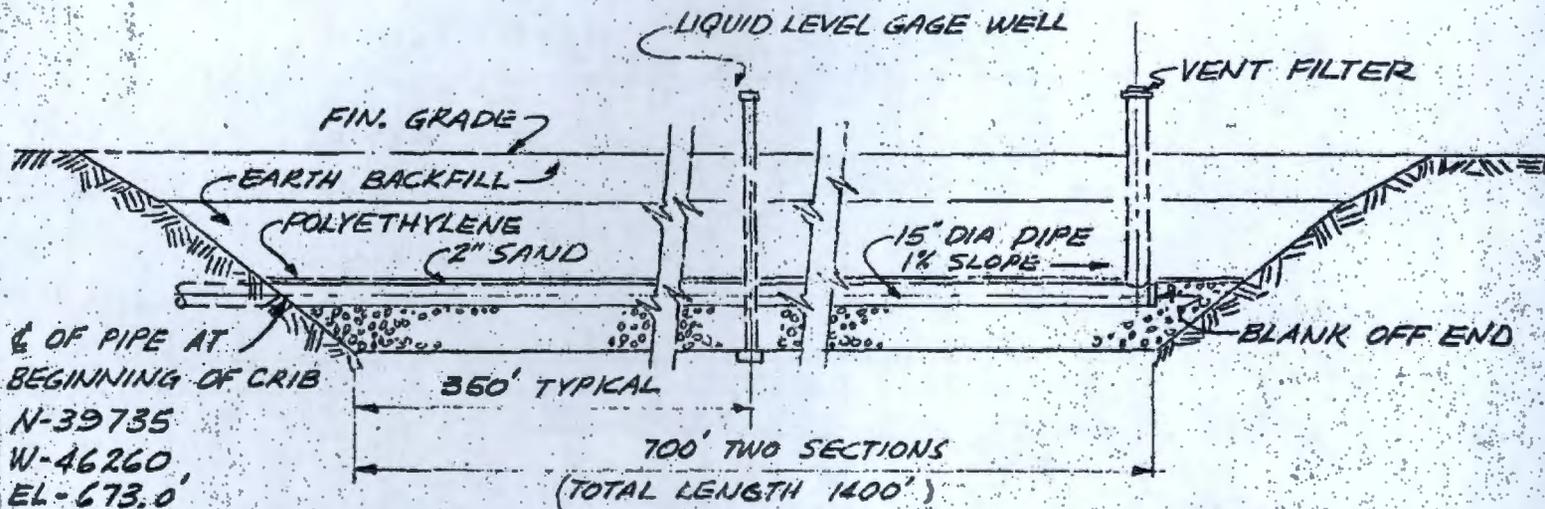


TYPICAL CRIB LONG SECTION

216-A-30

REF. - H-2-57720 & H-2-57719

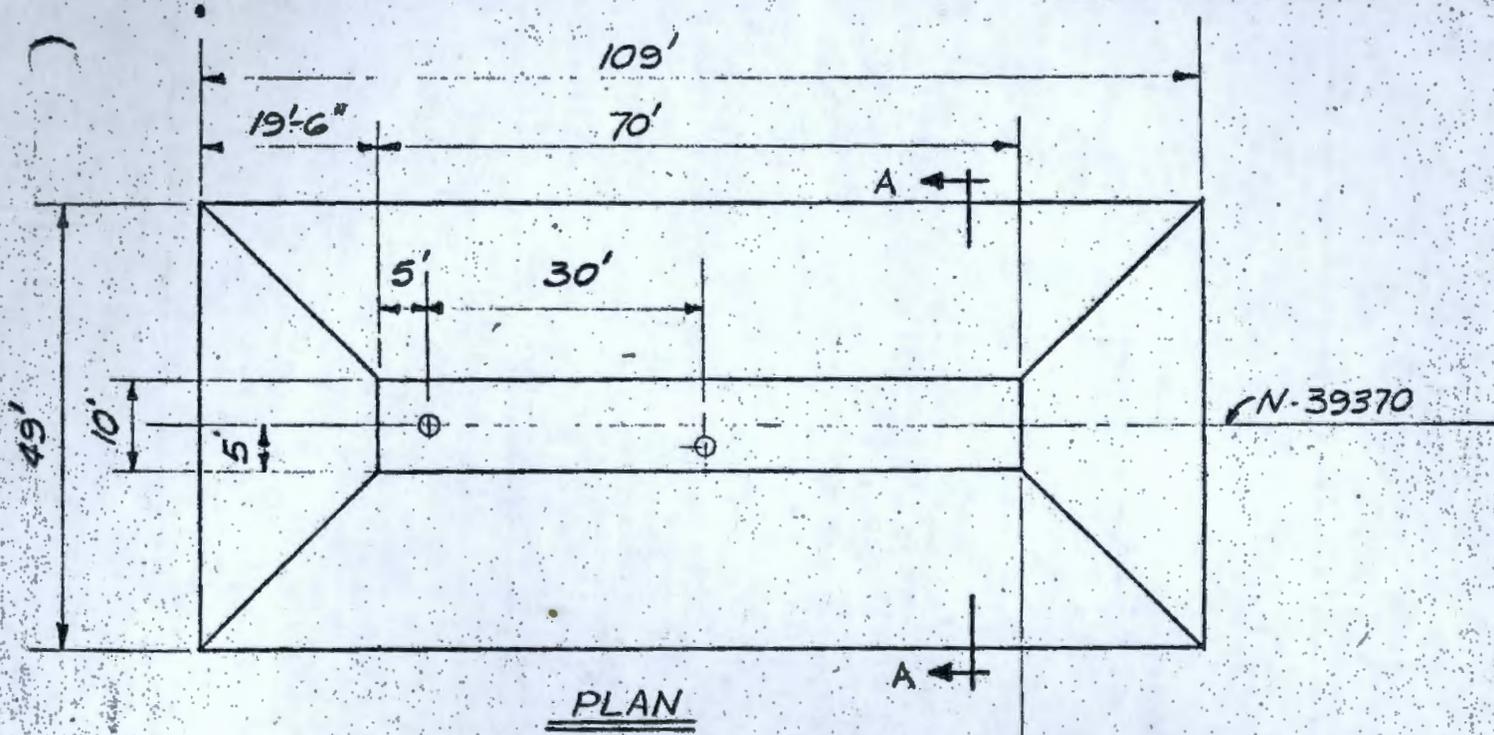


W-48290

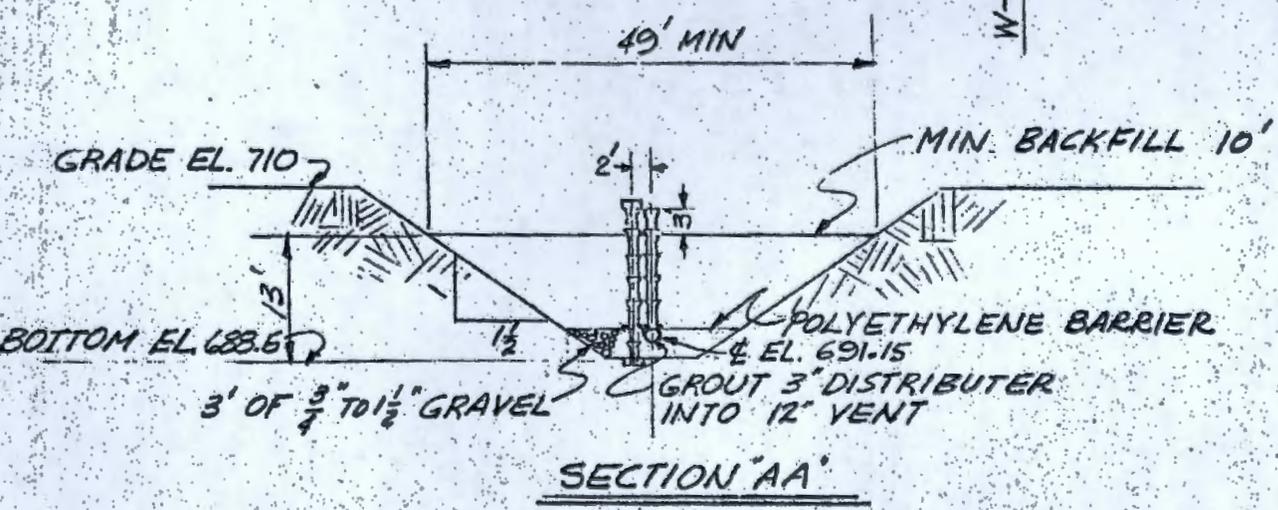

216-A-31
 TAKEN FROM SK-2-18602

EW-55176 P11
Appendix D

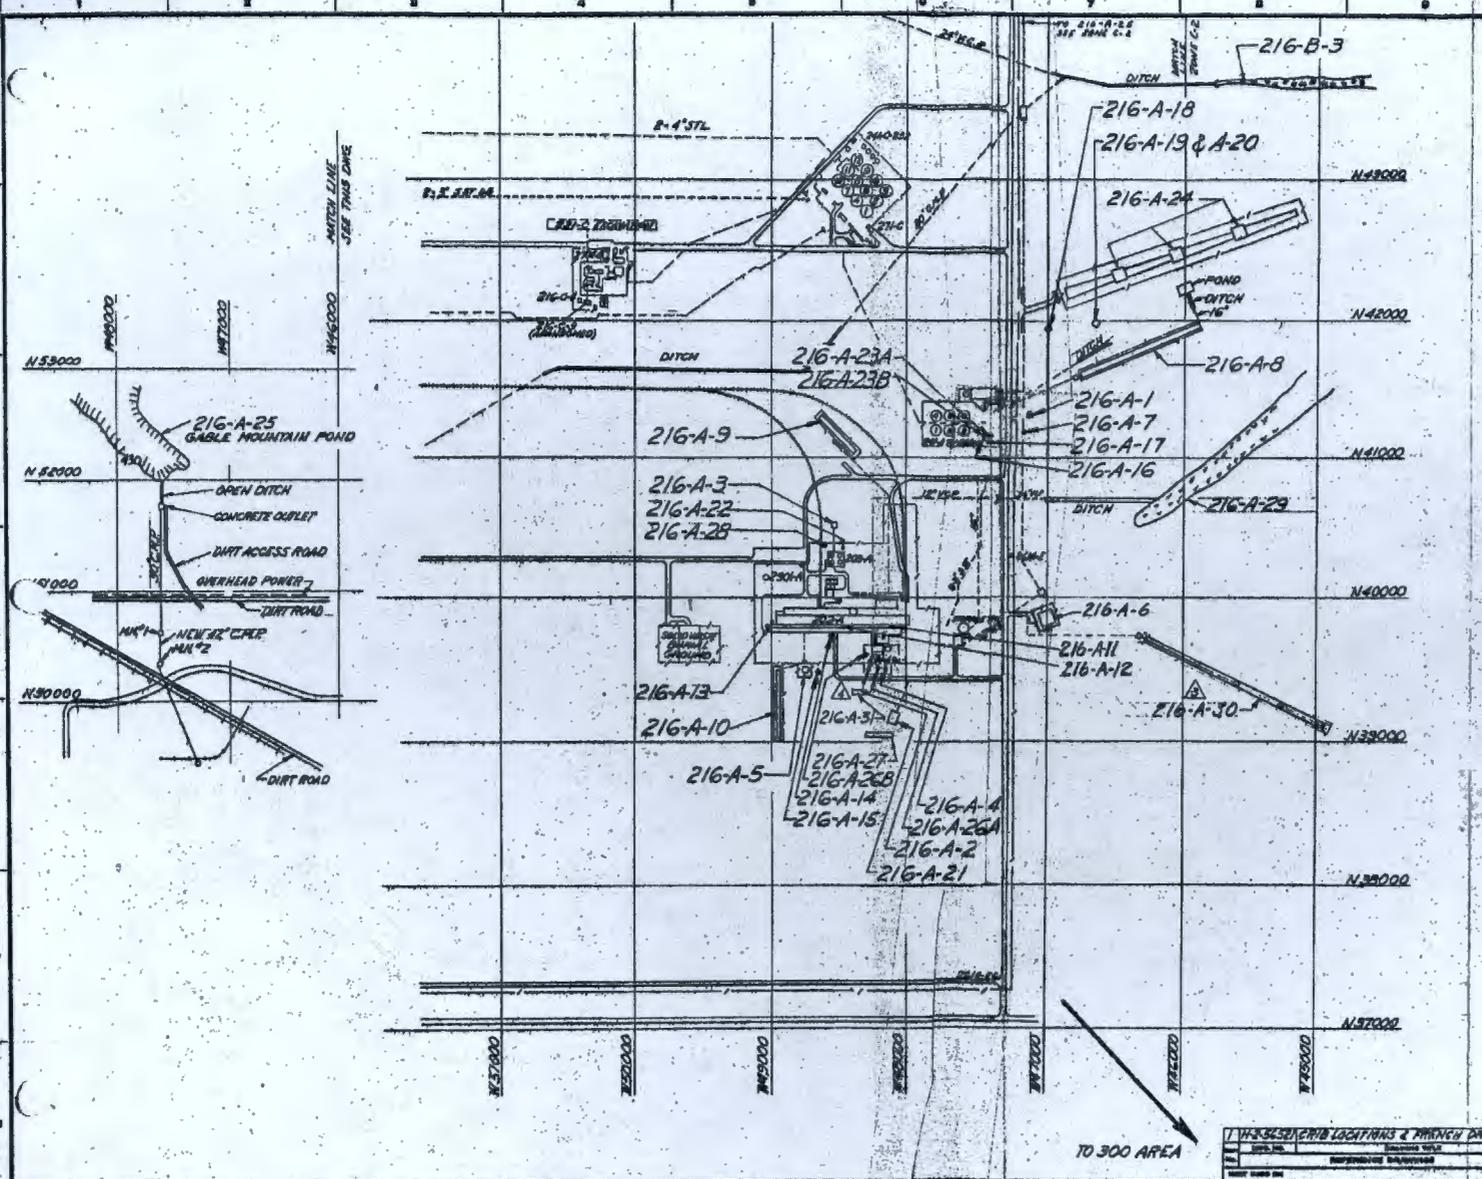

APPROVED
FOR DESIGN
NOT FOR CONSTRUCTION
2/24/55

1	APPROVED FOR DESIGN (REVISED 2-24-55)	DATE	BY	CHK'D	APP'D
2	ADDED 216-A-30 ZONE D-1	DATE	BY	CHK'D	APP'D
3	CONDITION OF ORIGINAL	DATE	BY	CHK'D	APP'D
4	REVISION DUE TO	DATE	BY	CHK'D	APP'D
<p>REVISIONS</p> <p>DATE</p> <p>BY</p> <p>CHK'D</p> <p>APP'D</p>					
<p>NONE</p> <p>DATE: 2-24-55</p>					
<p>NO. SK-2-17798</p> <p>SCALE: 1" = 400'</p>					
<p>U. S. ATOMIC ENERGY COMMISSION HANFORD ATOMIC PRODUCTS OPERATION GENERAL ELECTRIC</p>					
<p>PUREX LIQUID WASTE DISPOSAL SITES 216-A-SERIES</p>					
<p>THIS DESIGN SHOWS LOCATIONS & FINISHED DIMENSIONS</p> <p>DATE: 2-24-55</p> <p>BY: [Signature]</p> <p>CHK'D: [Signature]</p> <p>APP'D: [Signature]</p>					
<p>NO. 216-A DRAWING NO. 0400</p> <p>NO. SK-2-17798</p>					

Z PLANT

UNCLASSIFIED

HW-55176, Pt. II
Page 1

INDEX OF CPD CRIB BUILDING NUMBERS
DESIGNS OF CPD RADIOACTIVE LIQUID WASTE
DISPOSAL SITES

Part II of VII Parts
Process Technology - Study Report

by

V. W. Wood
Radiological Design and Development
Facilities Engineering Operation
CHEMICAL PROCESSING DEPARTMENT

March 20, 1958

D I S T R I B U T I O N

CR Bergdahl	TG LaFollette
VM Bernard	CE Linderoth
A Bradway	WN Mobley
WG Browne	HE Parker
E Doud	HF Peterson
J Durbin	DW Pearce
JB Fecht	OH Pilkey
DR Gustavson	EL Reed
WA Haney	RA Roberts
JF Honstead	HP Shaw
IM Jacques	W Tressler
EB Jackson	VW Wood
CE Kent	300 Files

UNCLASSIFIED

UNCLASSIFIED

HW-55176, Pt. II
Page 2

INDEX OF CPD CRIB BUILDING NUMBERS
DESIGNS OF CPD RADIOACTIVE LIQUID WASTE
DISPOSAL SITES

Part II of VII Parts
Process Technology - Study Report

INTRODUCTION

During the fourteen years or more which the separations areas have operated, many sites have been used for the disposal of radioactive liquid wastes. Various methods have been used in assigning building numbers to these sites and, in a number of cases, changes have been made which have brought about some confusion. One of the reasons being some currently used building numbers do not agree with the numbers existing on design prints for the facilities. Reference (2) was an effort to establish a listing of the liquid waste disposal sites. It required considerable time and research to locate information concerning these sites.

Many varied designs have been used for the disposal of radioactive liquid wastes. Reverse wells, trenches, cribs or caverns, etc, have been used. Specific information on these facilities is often difficult to obtain for in some instances they were constructed on work orders with no recorders being retained on the design. In general, the design on each facility has been different. This has made it extremely difficult for people to have a good working knowledge of the various waste disposal sites.

PURPOSE

The purpose of this report (Part II) is to provide a ready reference to the "Z" Plant liquid waste disposal sites as well as a compilation of sketches showing the basic information on the design of each facility.

Another objective is to establish a simplified and uniform numbering system. Still another objective is to provide an up-to-date tabulation. Subsequent parts of this report will provide information on cribs for such plants as Redox and "T" Plant.

SUMMARY AND CONCLUSIONS

All radioactive liquid waste disposal sites should have the 216 Building number designation. These should be further grouped by giving all such sites for Purex a prefix of 216-A. Other major series would be 216-S for Redox; 216-T for "T" Plant; 216-B for "B" Plant; 216-U for "U" Plant and 216-Z for "Z" Plant.

UNCLASSIFIED

The numbering list in "Official Hanford Works Building List - Specification HW-5000" by Engineering Files - Construction Engineering Operation should be revised to more closely follow the above numbering system.

RECOMMENDATIONS

It is recommended that the following action be taken:

1. All groups and services referring to the "Z" Plant cribs or report data concerning them should use the index numbering system as presented in this report. In the case of "Z" Plant this means a few changes. See cross reference, page 4.
2. That all drawings concerning these disposal sites, including maps, be revised to show the proper locations and numbers for these cribs.
3. Any suggestions for improving the usefulness of this report should be referred to the author.

DISCUSSION

When all seven parts of the report are completed, and the work outlined in the report is completed, much confusion will be eliminated and more people will be better informed on the design of each waste disposal facility. The report will provide a firm basis for future building number assignments.

While some sincere efforts have been made to try and keep a methodical system for recording waste disposal sites, a number of problems have developed - for example, HW-5000, Sheet 29 of 50 lists, only two cribs in the 216-Z series. They are 216-Z-8 and 216-Z-9. Although no coordinates are given, it is doubtful if these refer to the same cribs with the same number as given in Reference "2".

As indicated earlier, the use of the crib index, as presented in this report should be very easy. In addition, information is presented which is very difficult to locate in the records and in some cases it is not available in the records.

REFERENCES

1. HW-5000, "Official Hanford Works Building List - Specification HW-5000" by Engineering Files - Construction Engineering Operation.
2. HW-43121, "Tabulation of Radioactive Liquid Waste Disposal Facilities" by HV Clukey dated May 10, 1956.
3. HW-33305, "Tabulation of Radioactive Liquid Waste Disposal Facilities," by HV Clukey dated October 8, 1954.

UNCLASSIFIED

HW-55176, Pt. II
Page 4

CROSS REFERENCE

"Z" PLANT RADIOACTIVE LIQUID WASTE
DISPOSAL SITES

<u>Suggested Crib No.</u>	<u>Number Listed in HW-5000</u>	<u>Number Listed in HW-43121</u>	<u>Number Used On Drawings or Original Number</u>	<u>Remarks</u>
216-Z-1	234-5-1	216-Z-7	234-5-1	
216-Z-2	234-5-2	216-Z-7	234-5-2	
216-Z-3	234-5-3 & 4	216-Z-8	234-5-3 & 4	
216-Z-4	231-1	216-Z-3	216-Z-3	231-W-3
216-Z-5 A,B	231-2	216-Z-5	231-W-1 & 2	231-W-1 & 2
216-Z-6	None	216-Z-4	216-Z-6	231-W-4
216-Z-7	None	216-Z-6	216-Z-7	231-W Trench
216-Z-8	216-Z-8	216-Z-9	216-Z-8	Recuplex
216-Z-9	216-Z-9	216-Z-10	216-Z-9	Recuplex
216-Z-10	None	216-Z-2	None	231-W-150 Reverse Well
216-Z-11	None	216-Z-1	None	Drainage Ditch to U Swamp
216-Z-12	None	None	216-Z-12	New Crib

UNCLASSIFIED

APPENDIX

A. Explanation of Parts to the Report

Part I will cover the Purex Radioactive Liquid Waste Disposal Sites.

Part II will cover the "Z" Plant Radioactive Liquid Waste Disposal Sites.

Part III will cover the Redox Plant Radioactive Liquid Waste Disposal Sites.

Part IV will cover the "U" Plant Radioactive Liquid Waste Disposal Sites.

Part V will cover the "T" Plant Radioactive Liquid Waste Disposal Sites.

Part VI will cover the "B" Plant Radioactive Liquid Waste Disposal Sites.

Part VII will cover the "C" Plant, Hot Semi-Works, the 200 North Areas and miscellaneous.

B. Index for Z Plant Radioactive Liquid Waste Disposal Sites.


C. Sketches of Z Plant Waste Disposal Facilities.

D. Map of Z Plant Sites. (SK-2-17807).

UNCLASSIFIEDHW-55176, PT II
Appendix B
Revised: 10/19/59CRIB INDEXZ Plant

<u>Number</u>	<u>Description Appendix Sheet-</u>	<u>Service</u>	<u>Use Date</u>		<u>Status</u>
			<u>From</u>	<u>To</u>	
216-Z-1	C-1	D-6 Wastes	6/49	6/52	Replaced by Z-3
216-Z-1A	C-2	Overflow from Z-1, 2 & 3	6/49	3/59	Replaced by Z-12
216-Z-2	C-1	D-6 Wastes	6/49	6/52	Replaced by Z-3
216-Z-3	C-3 & 4	D-6 Wastes	6/52	3/59	Replaced by Z-12
216-Z-4	C-5	231-Z Lab Wastes	6/45		Abandoned
216-Z-5	C-6	231-Z Proc. Wastes	6/45	2/47	Replaced by Z-7
216-Z-6	C-7 & 8	231-Z Proc. Wastes	6/45		Abandoned
216-Z-6A	C-7	231-Z Proc. Wastes	6/45		Abandoned
216-Z-7	C-9 & 10	231-Z Lab Wastes	2/47	-	Active
216-Z-8	C-11 & 12	Silica Tk Overflow	7/55	-	Active
216-Z-9	C-11 & 13	Recuplex CAU Waste	7/55	-	Active
216-Z-10	C-14 & 15	231-Z Wastes	2/45	6/45	Replaced by Z-5
216-Z-11	C-16	Cooling Water	6/49	-	Active
216-Z-12	C-17 & 18	D-6 Wastes	3/59	-	Active
216-Z-13	C-19	234-5 Tunnel Drain	6/49	-	Active
216-Z-14	C-19	Evapor. Cond. Wtr.	6/49	-	Active
216-Z-15	C-19	Evapor. Cond. Wtr.	6/49	-	Active


UNCLASSIFIED

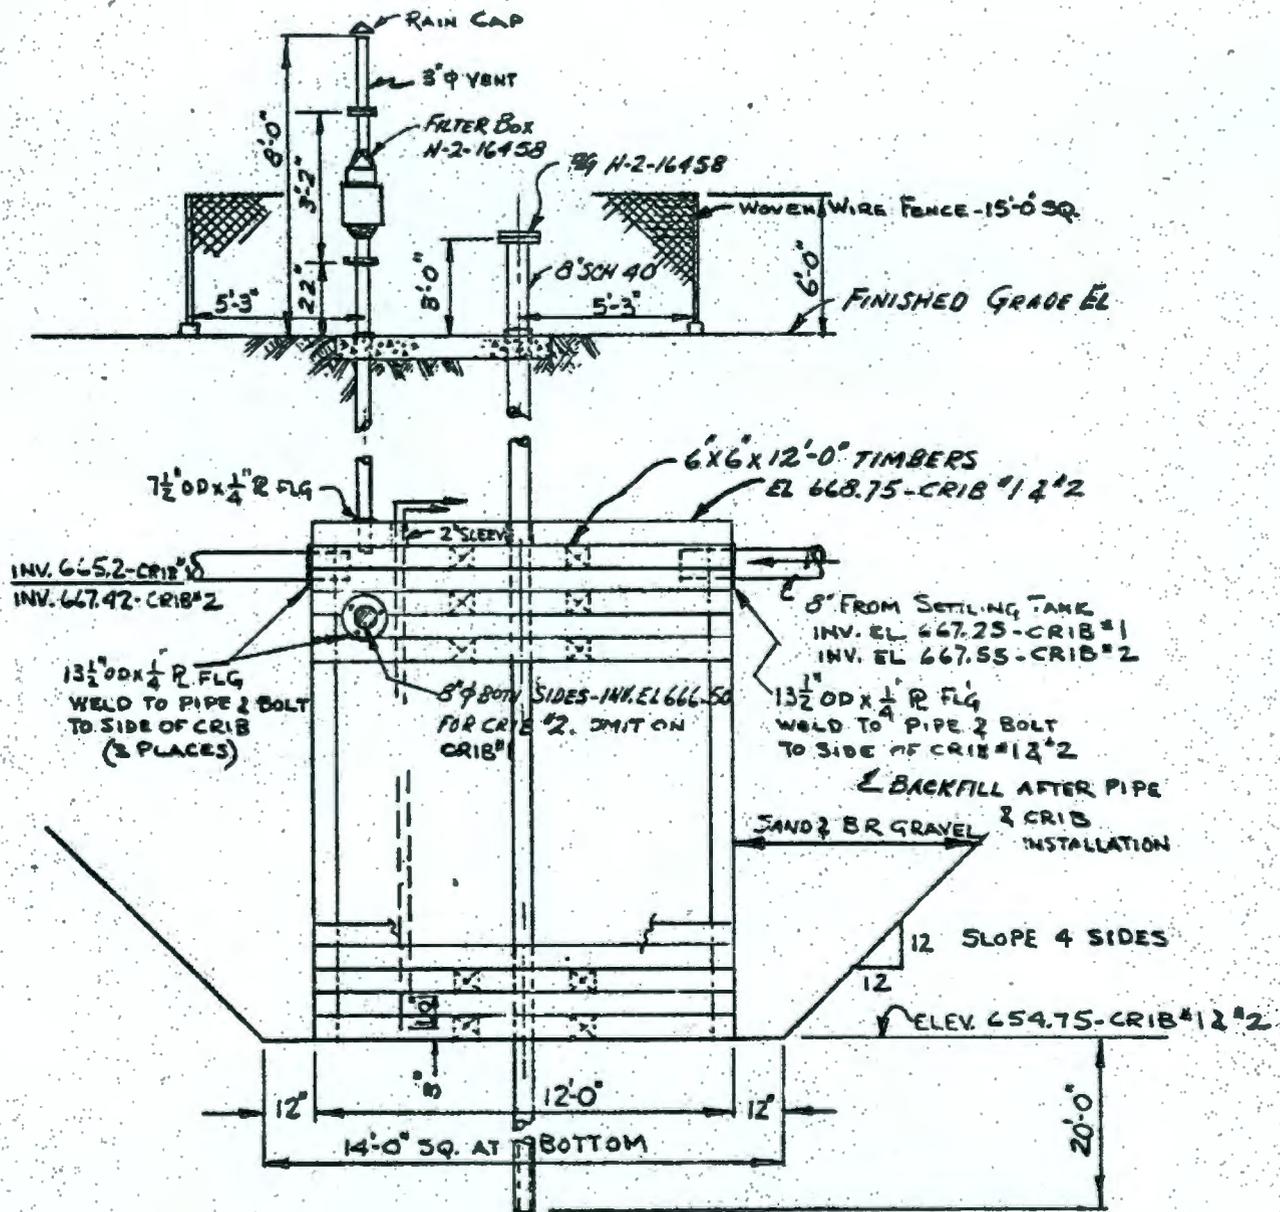


* CRIB #1 - AS SHOWN
CRIB #2 - AS SHOWN & NOTED

TAKEN FROM H-2-16459

216-Z-1*
216-Z-2

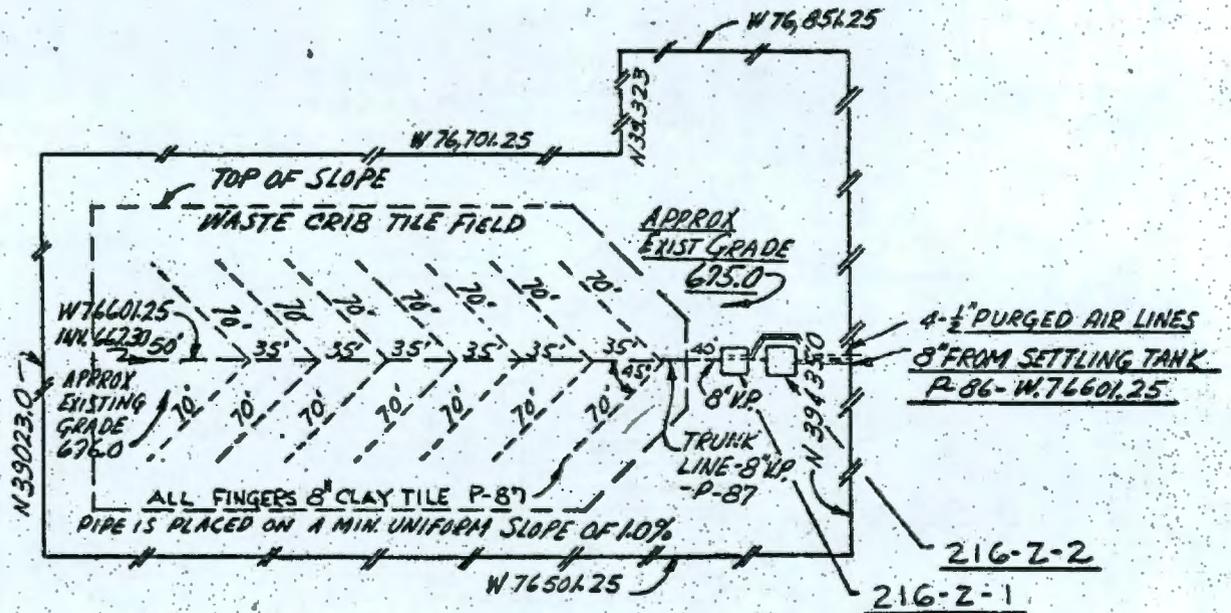


PLAN

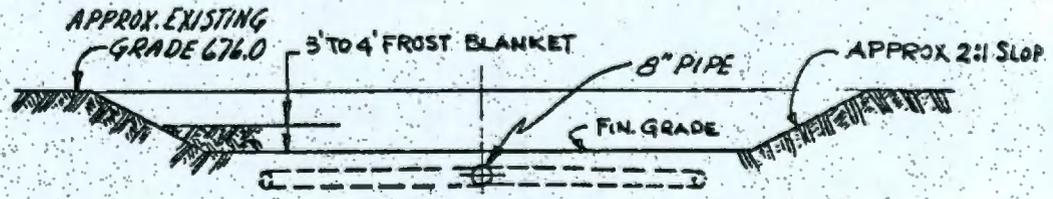

SECTION

216-Z-1A
TILE FIELD


4

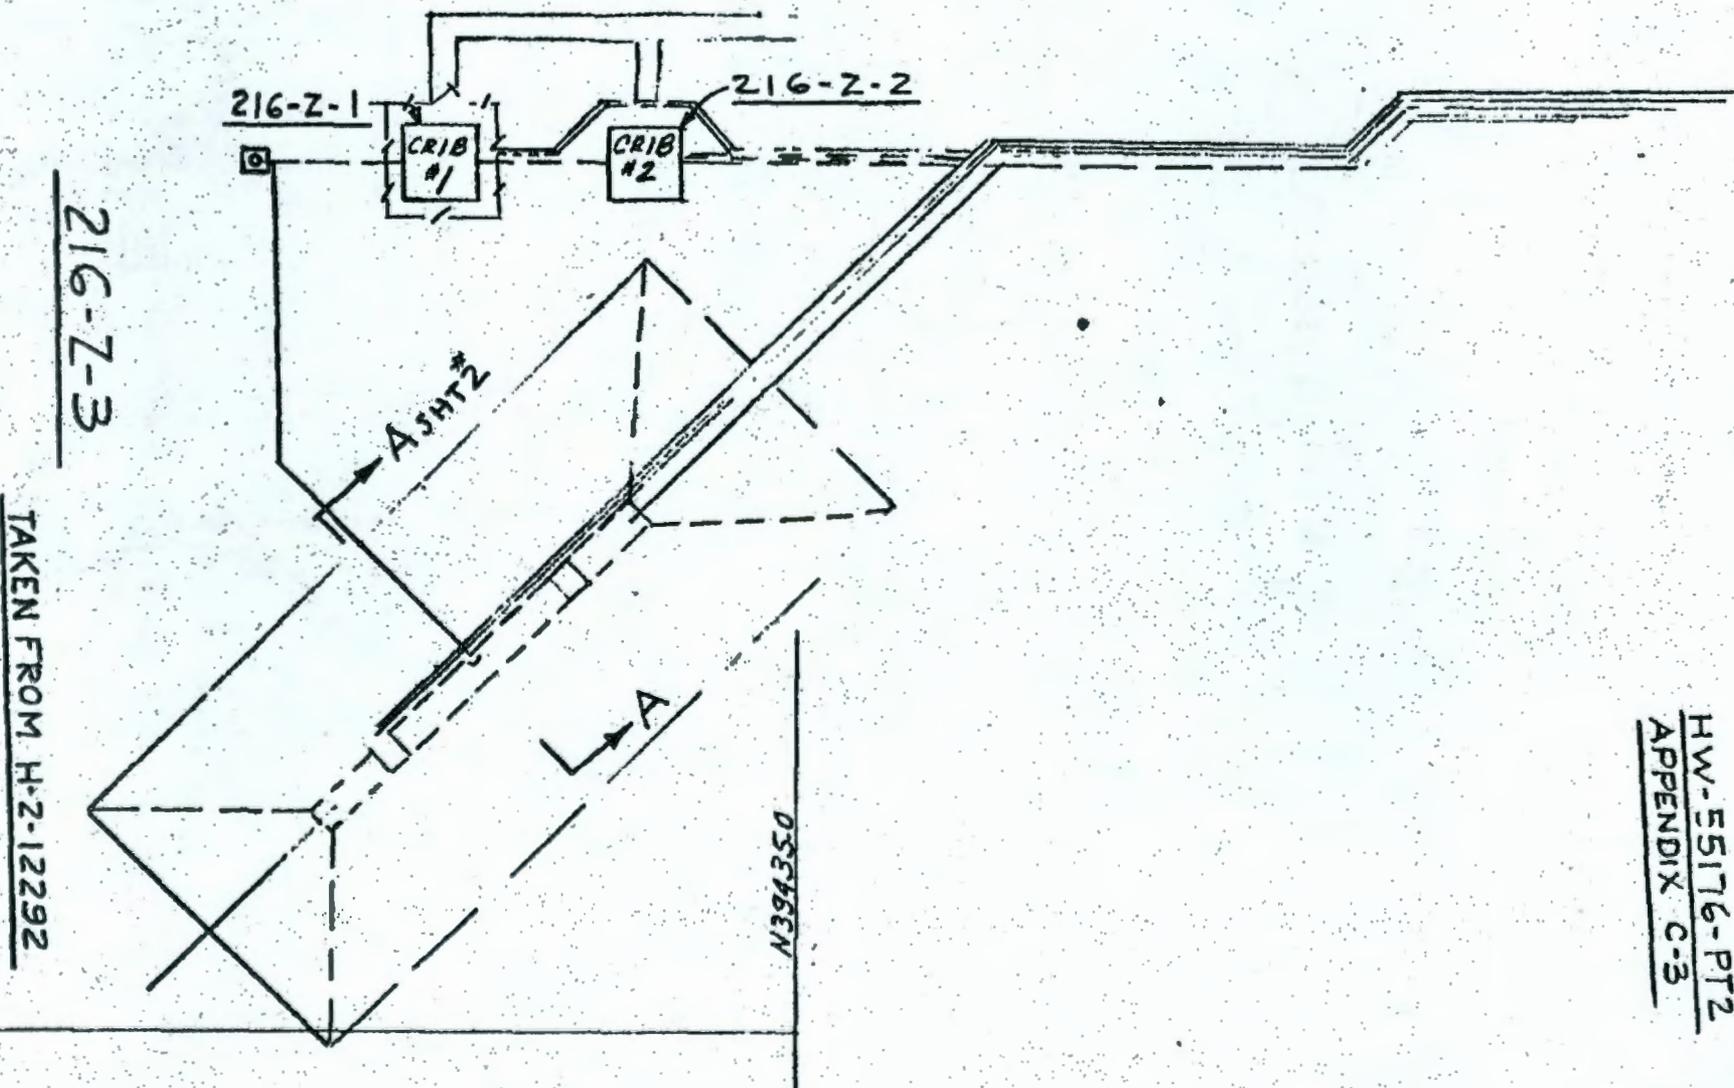

W76461.25

HW-55176-PT2
 APPENDIX C-3

9

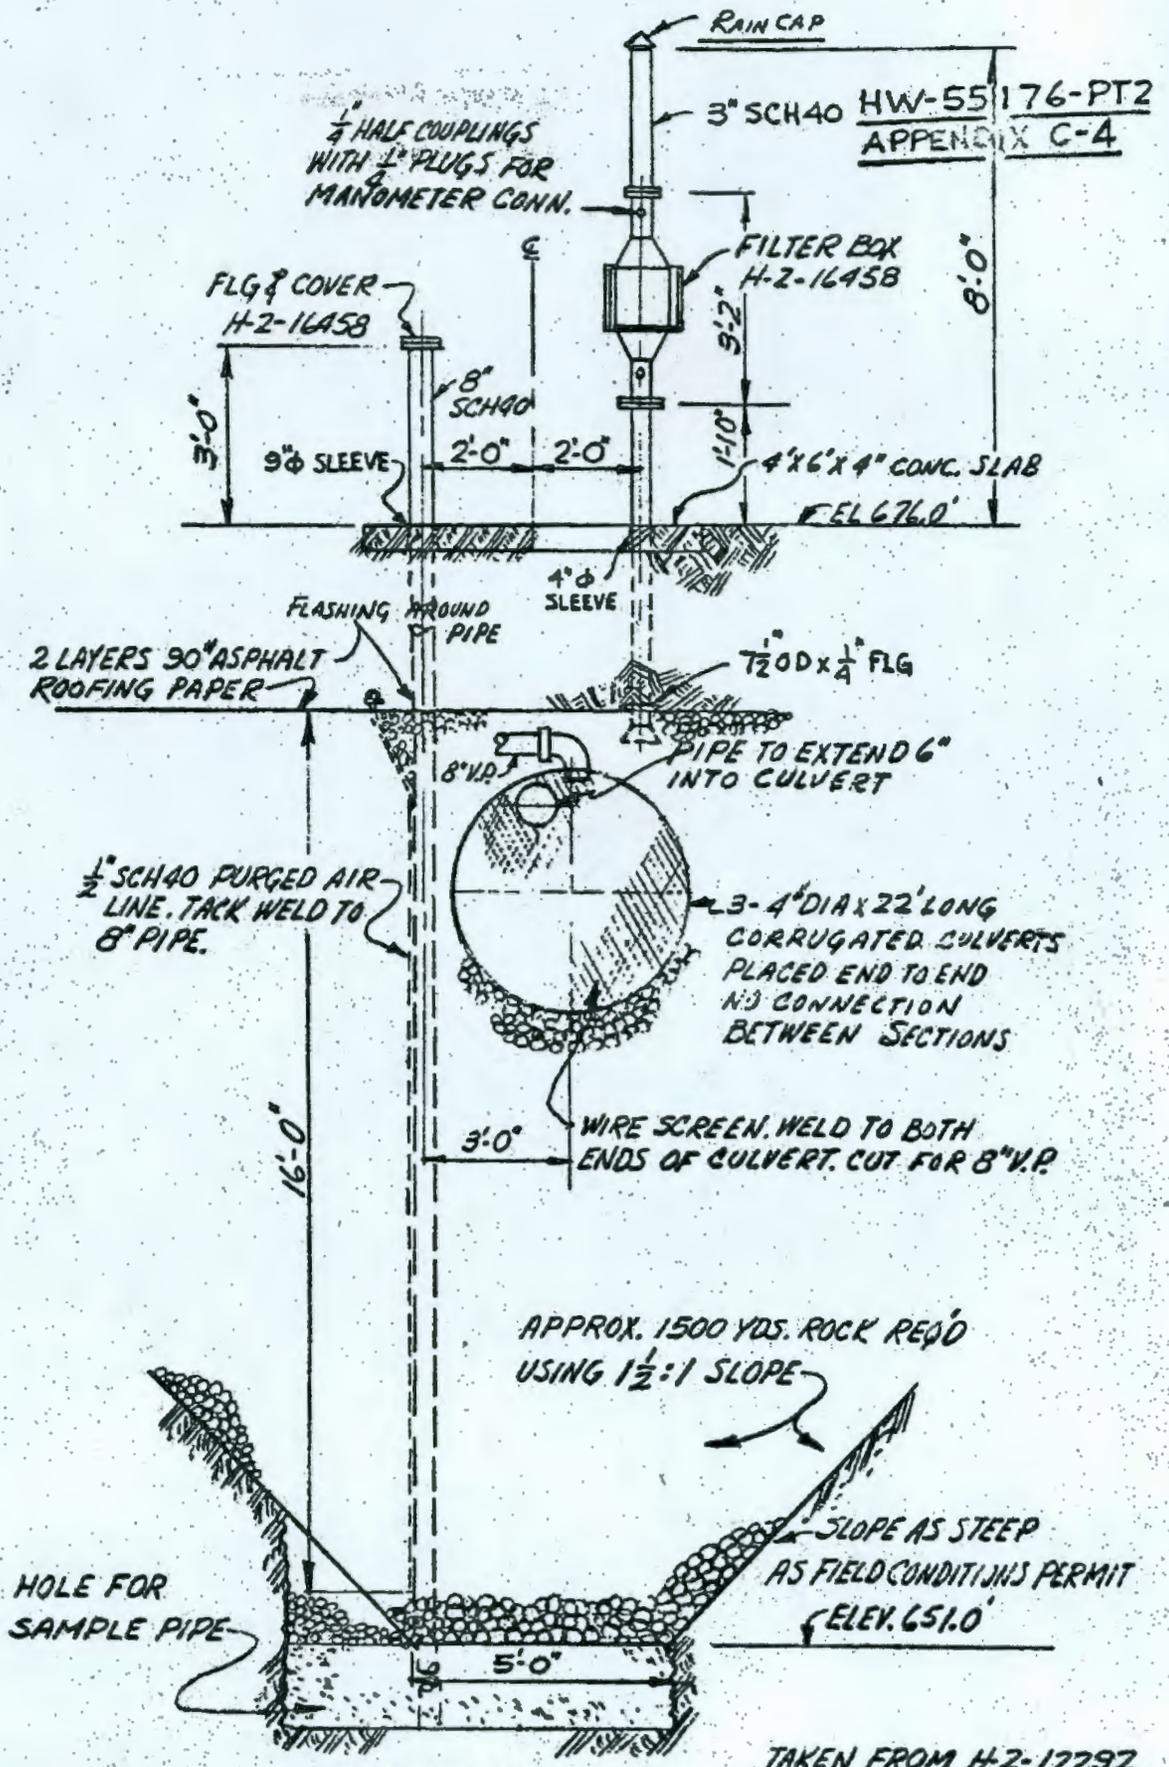


SECTION A-A
216-Z-3

TAKEN FROM H-2-12292

5



231-W BLDG.

HW-55176-PT2
APPENDIX C-5

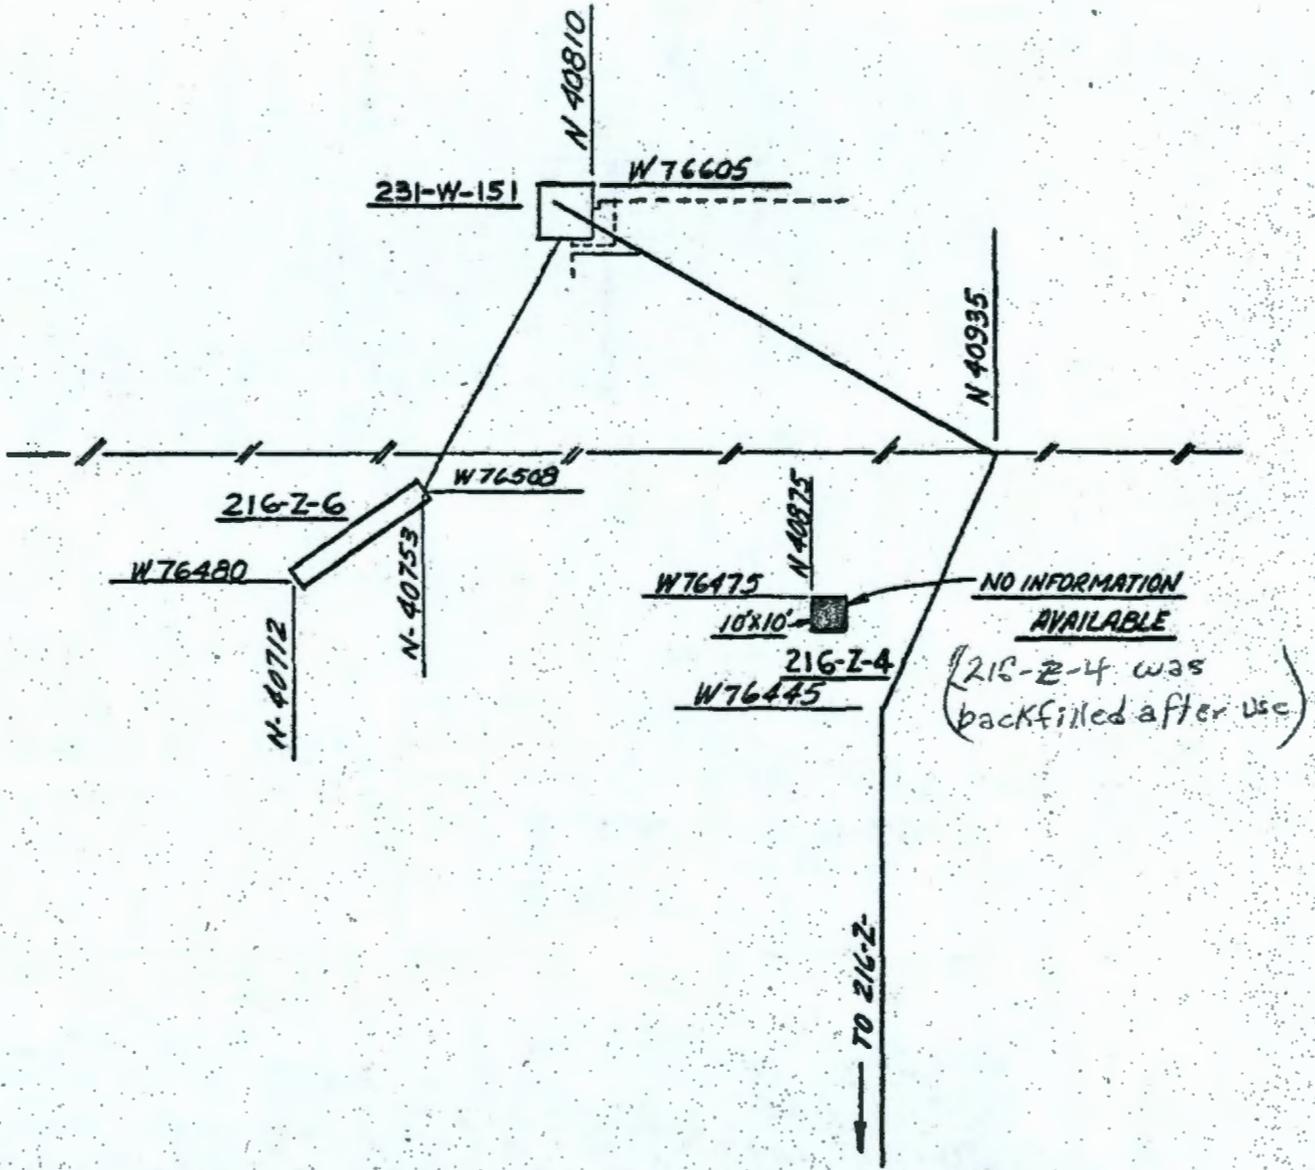


TAKEN FROM H-2-511
DOC #43121


216-Z-4

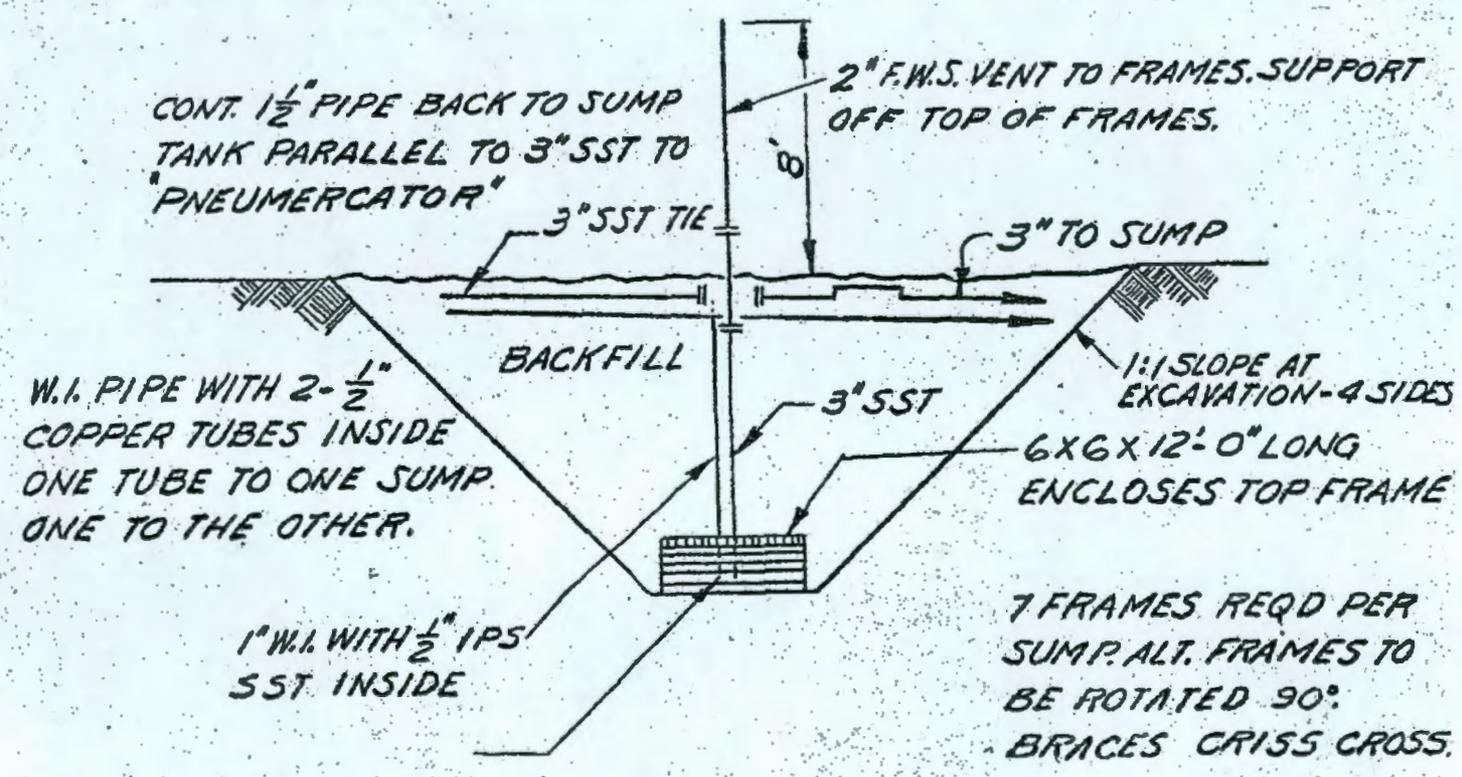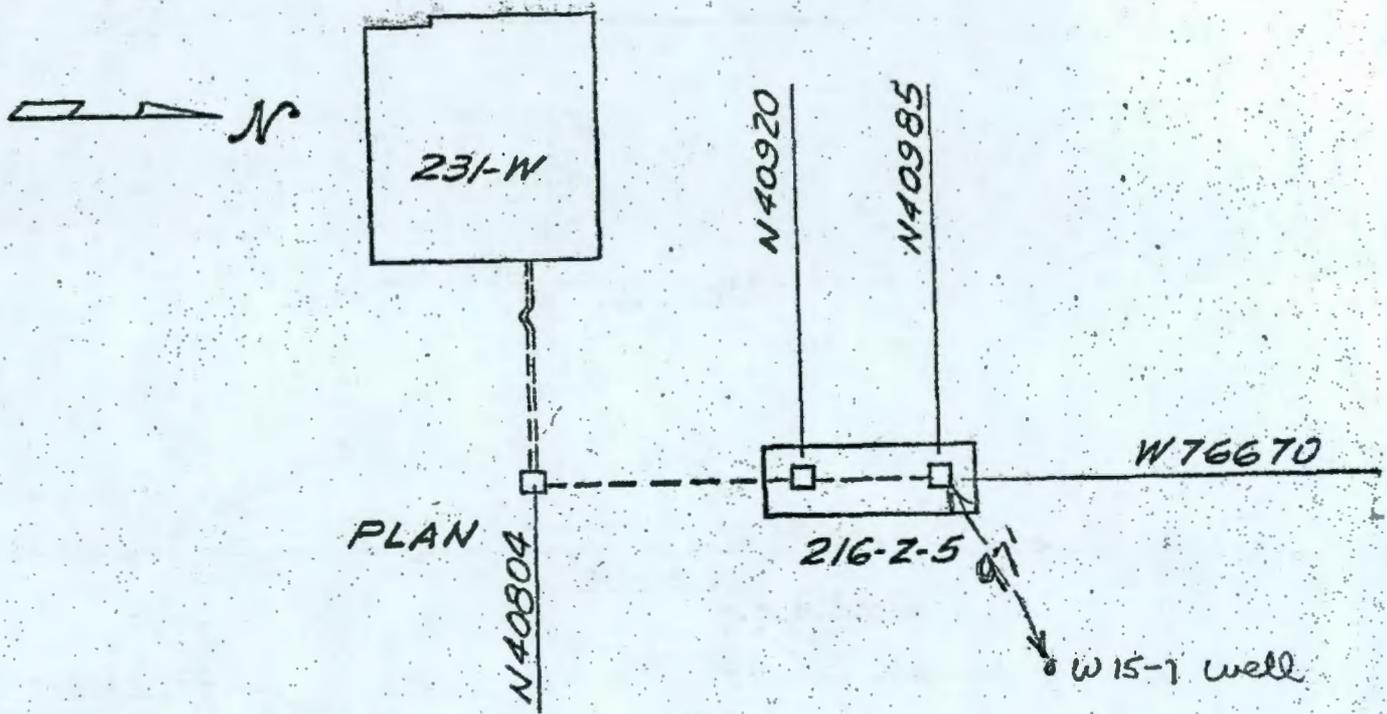




216-2-5

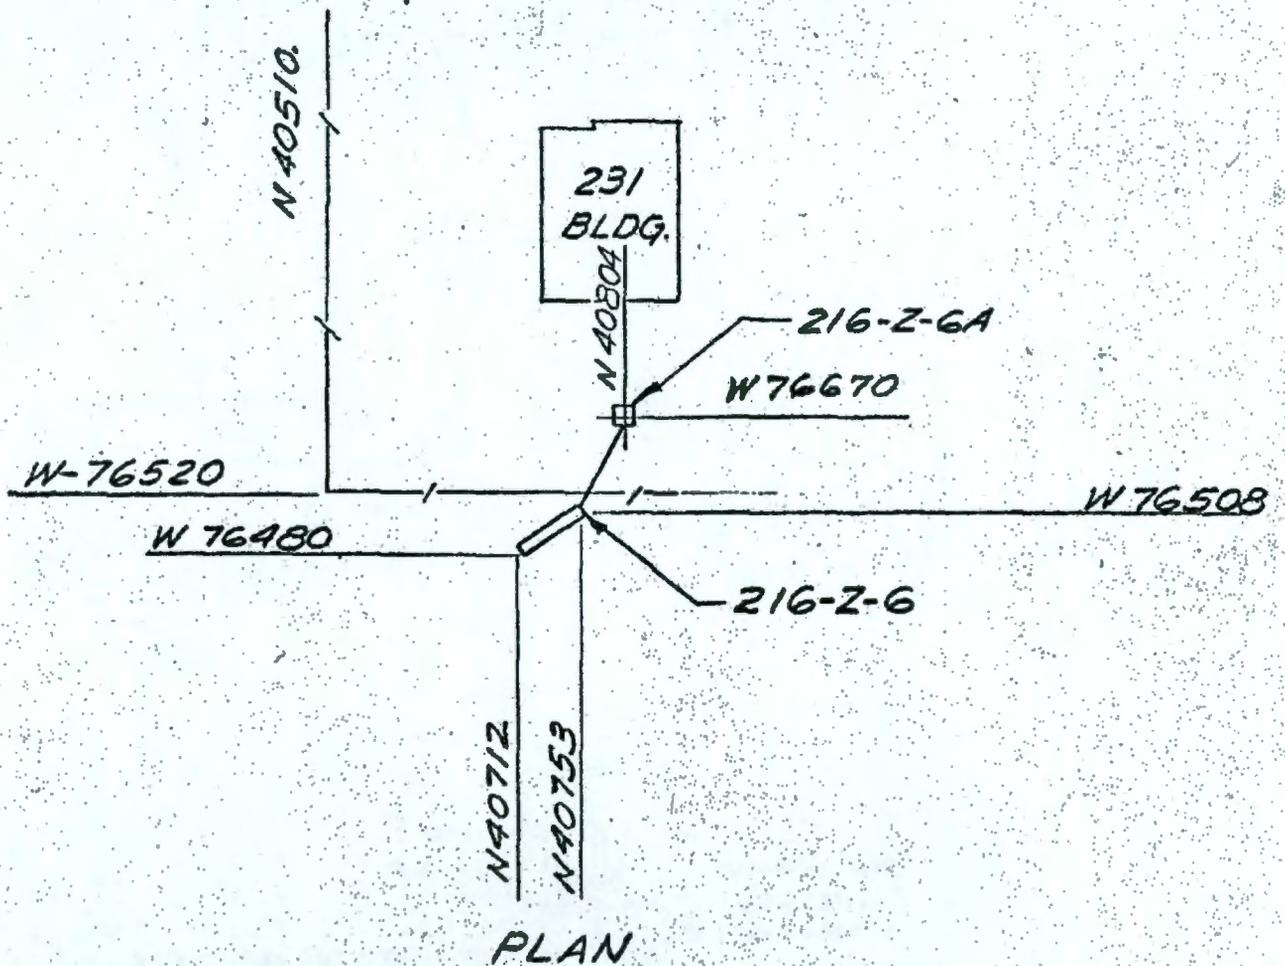

231-Z-6
231-Z-6A
 H-2-508

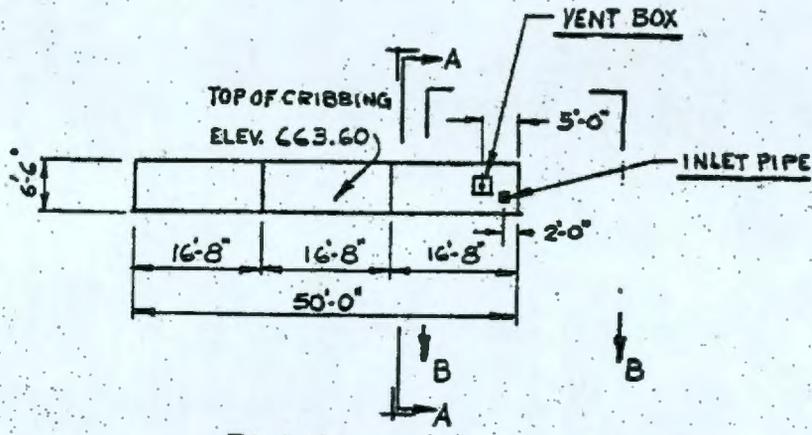


PLAN
TRENCH CRIBBING

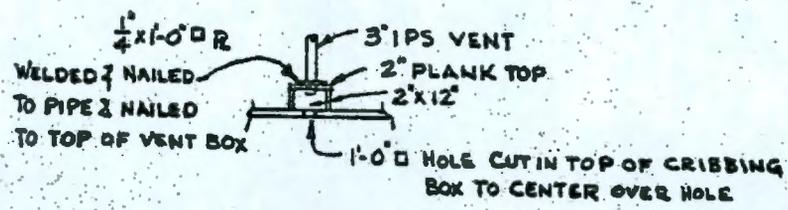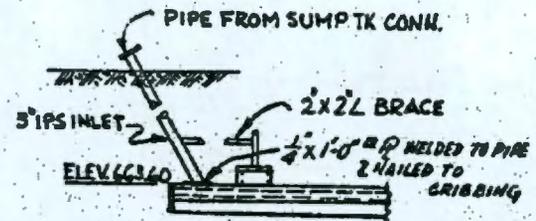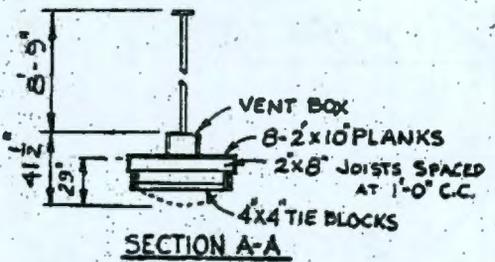

DETAILS


TAKEN FROM H-2-508

216-Z-6

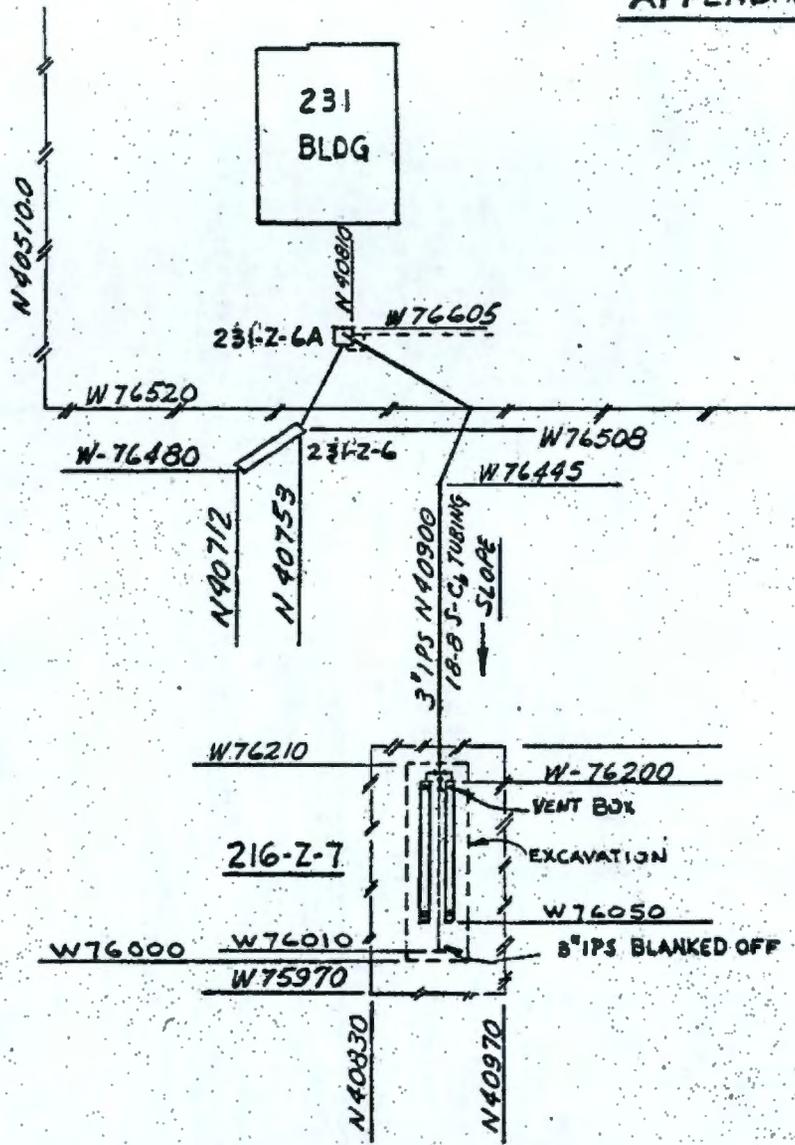


PERMANENT DISPOSAL TRENCH

216-Z-7

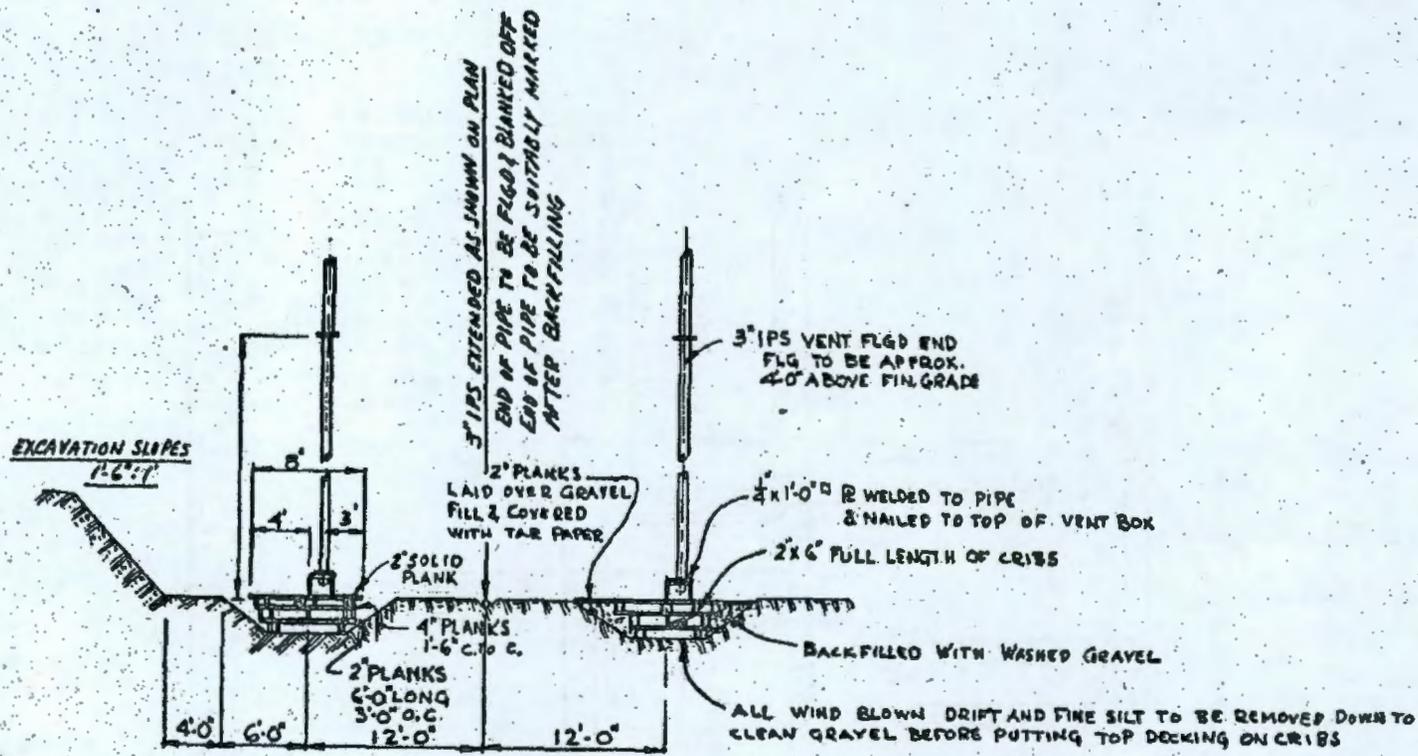

TRENCH CRIBS IDENTICAL
SECTION A-A

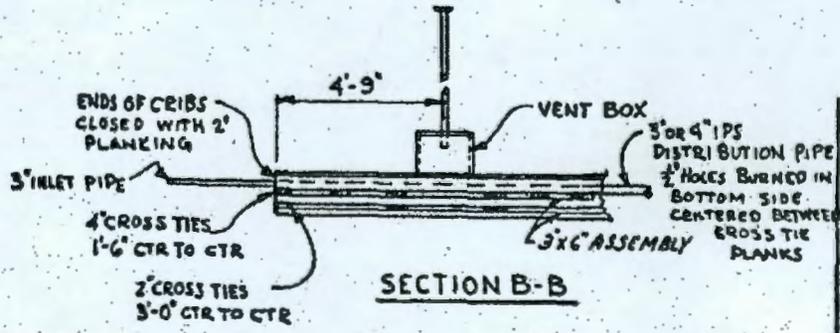

SECTION B-B


TAKEN FROM H-2-511

216-Z-7

HW-55176-PT2
APPENDIX C-10



12" CMP SEWER

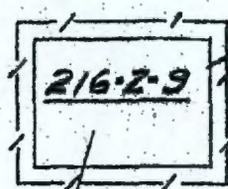

RECUPLEX
WASTE DISPOSAL
FACILITY

18" VCP

N40000

216-Z-8

SILICA STORAGE TANK


W76250

W76327.5

TILE FIELD

234-5
BLDG.

216-Z-8
216-Z-9
H-2-16653

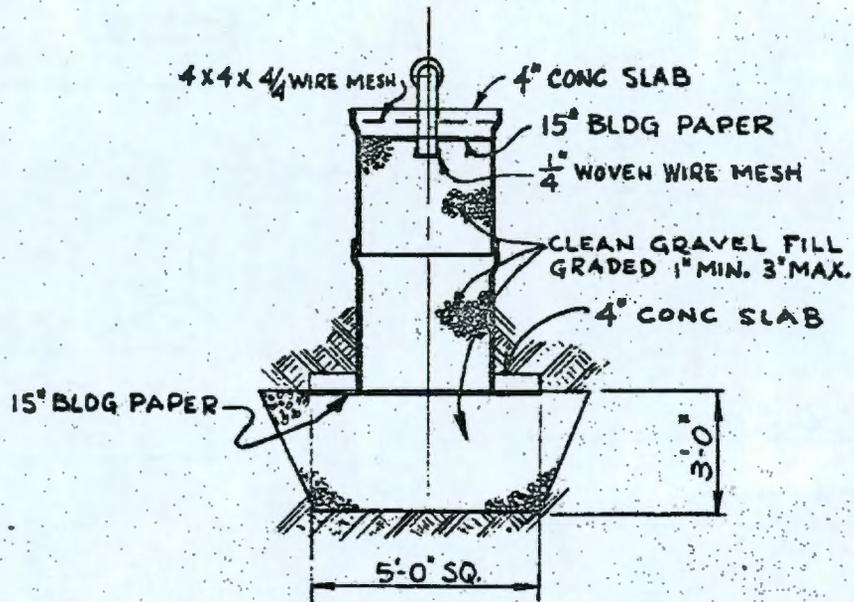


SECTION

TAKEN FROM H-2-16653

216-Z-8


N 39920

HW-55176-PT2
APPENDIX C-13

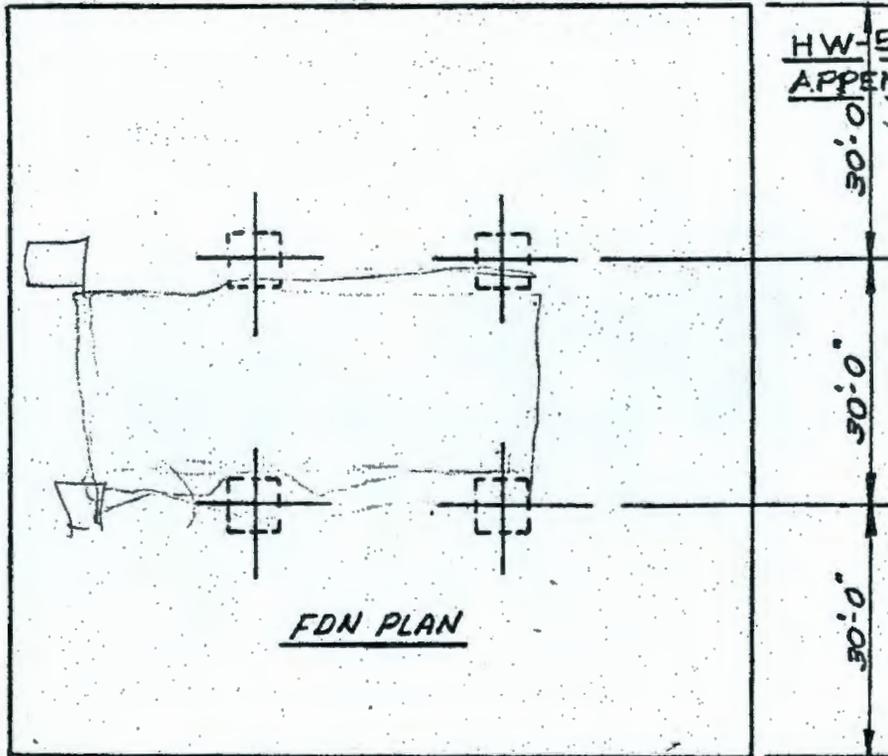

FDN PLAN


W75955

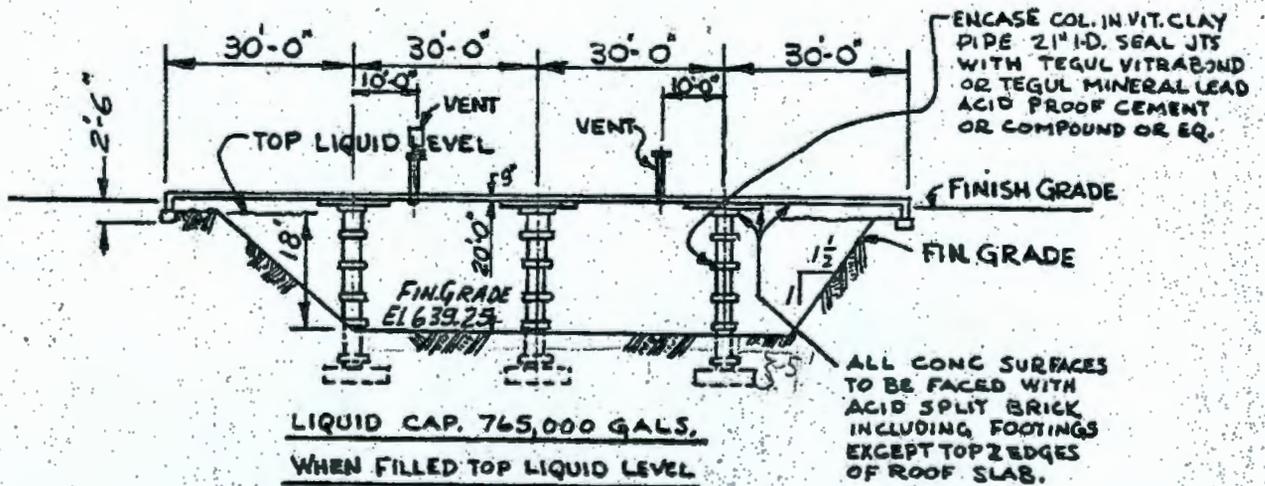

TAKEN FROM H-2-15492


H-2-15491

216-7-9

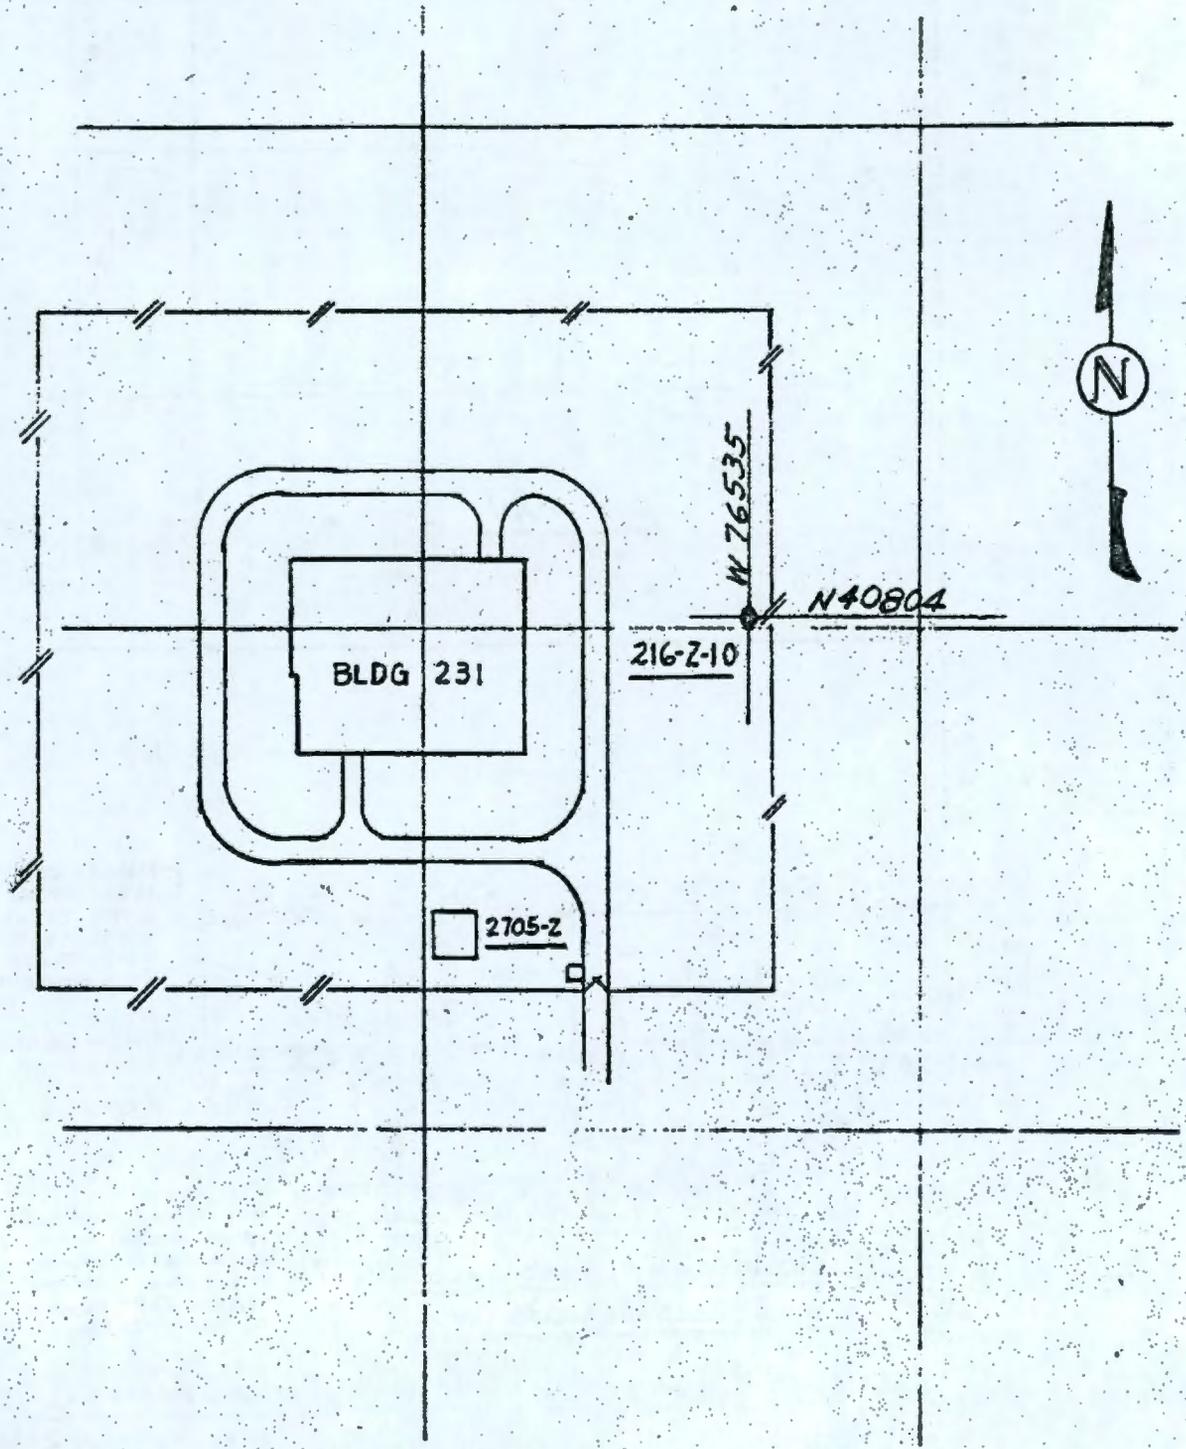

PLAN
216-Z-10


TAKEN FROM
H-2-1697
HW-76419

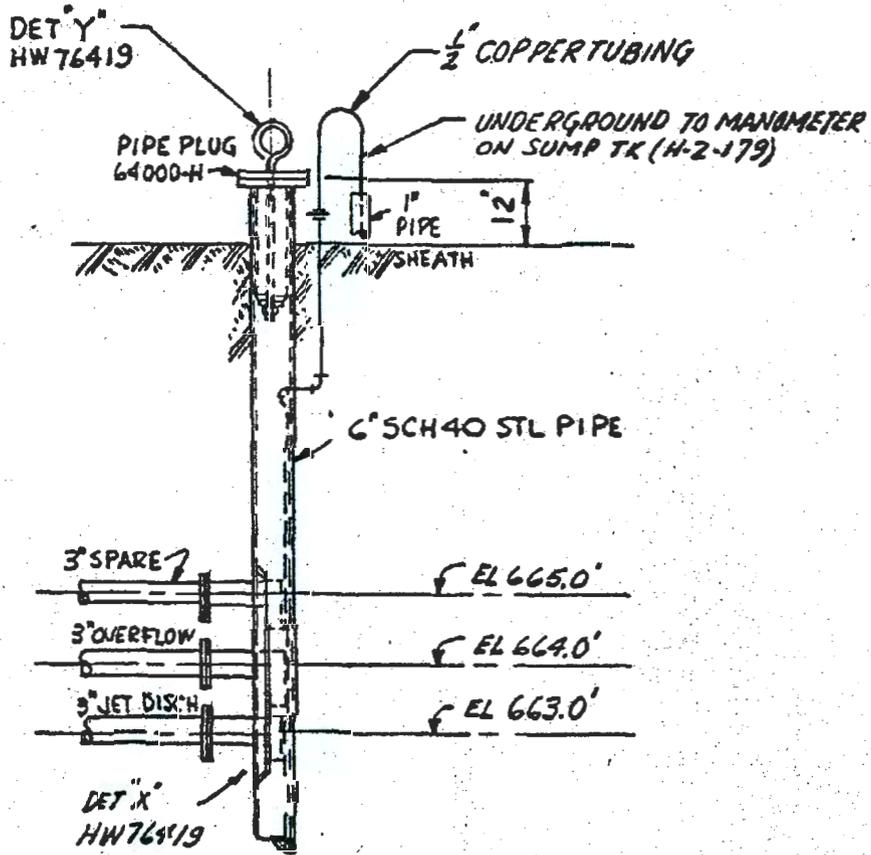

SECTION
216-Z-10

TAKEN FROM
HW-76419


HW-55176-PT2
APPENDIX C-16

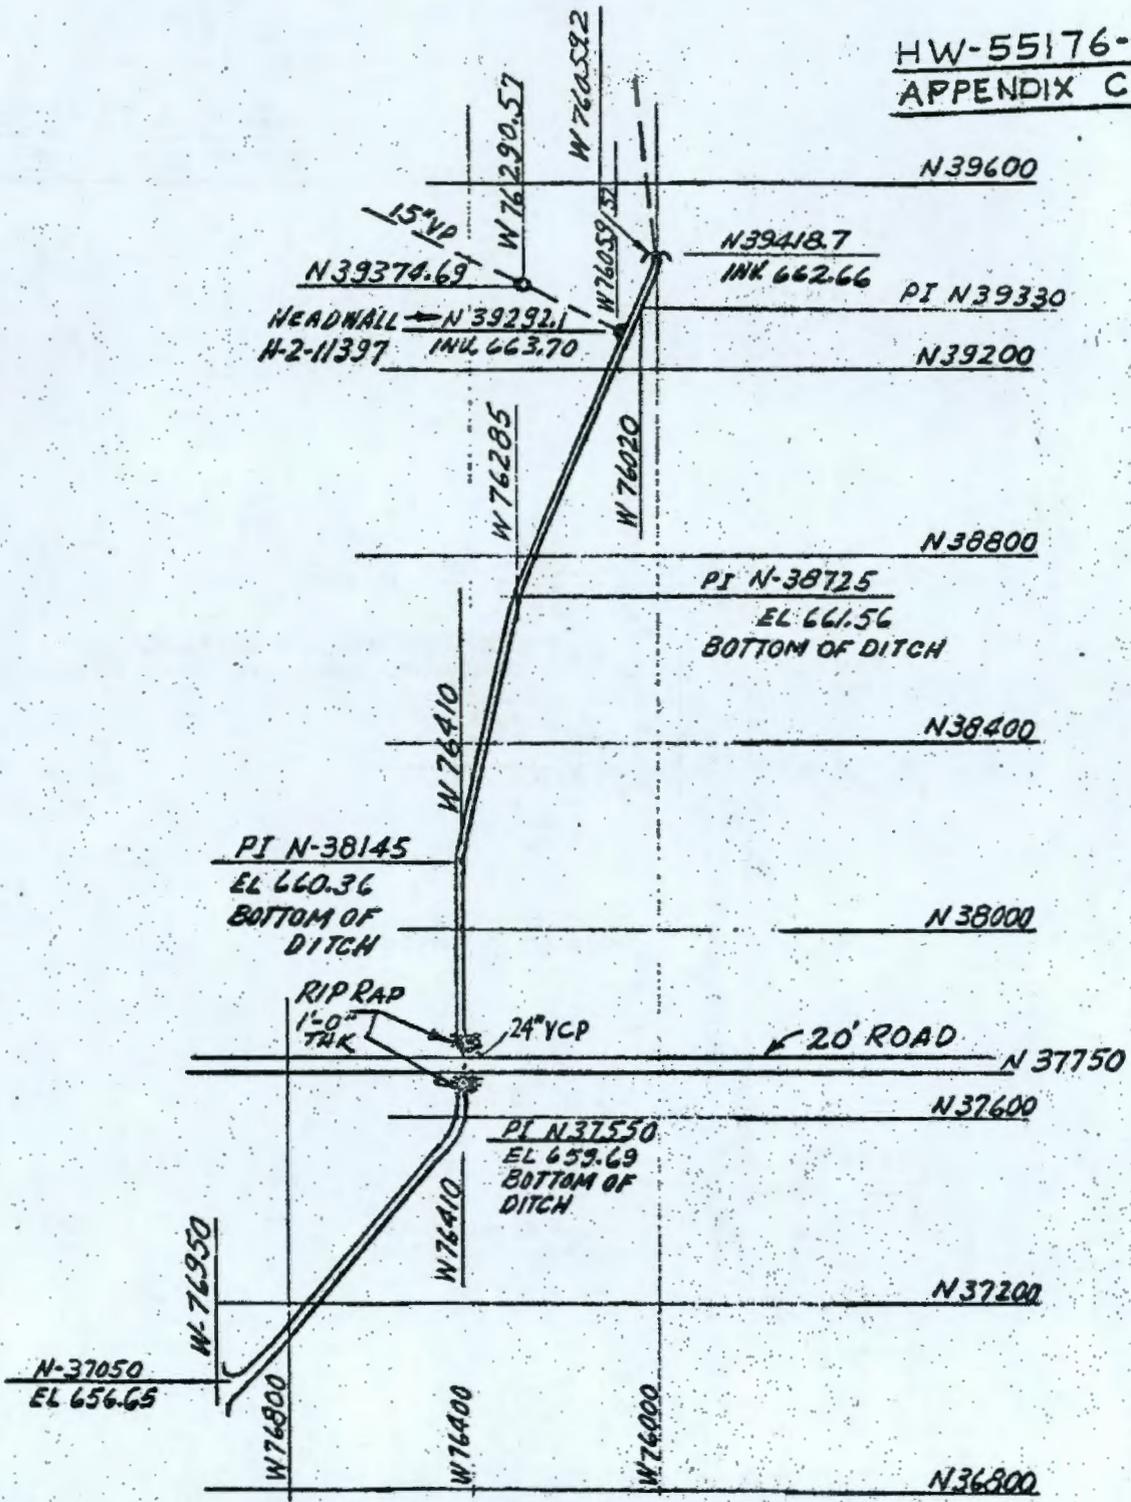

MINIMUM DITCH SECTION
 4'-0" WIDE AT BOTTOM
 2'-0" DEEP
 2½:1 SIDE SLOPES
 GRADE 0.05%


216-Z-11

216-Z-15
216-Z-14
216-Z-13
 H-2-16912

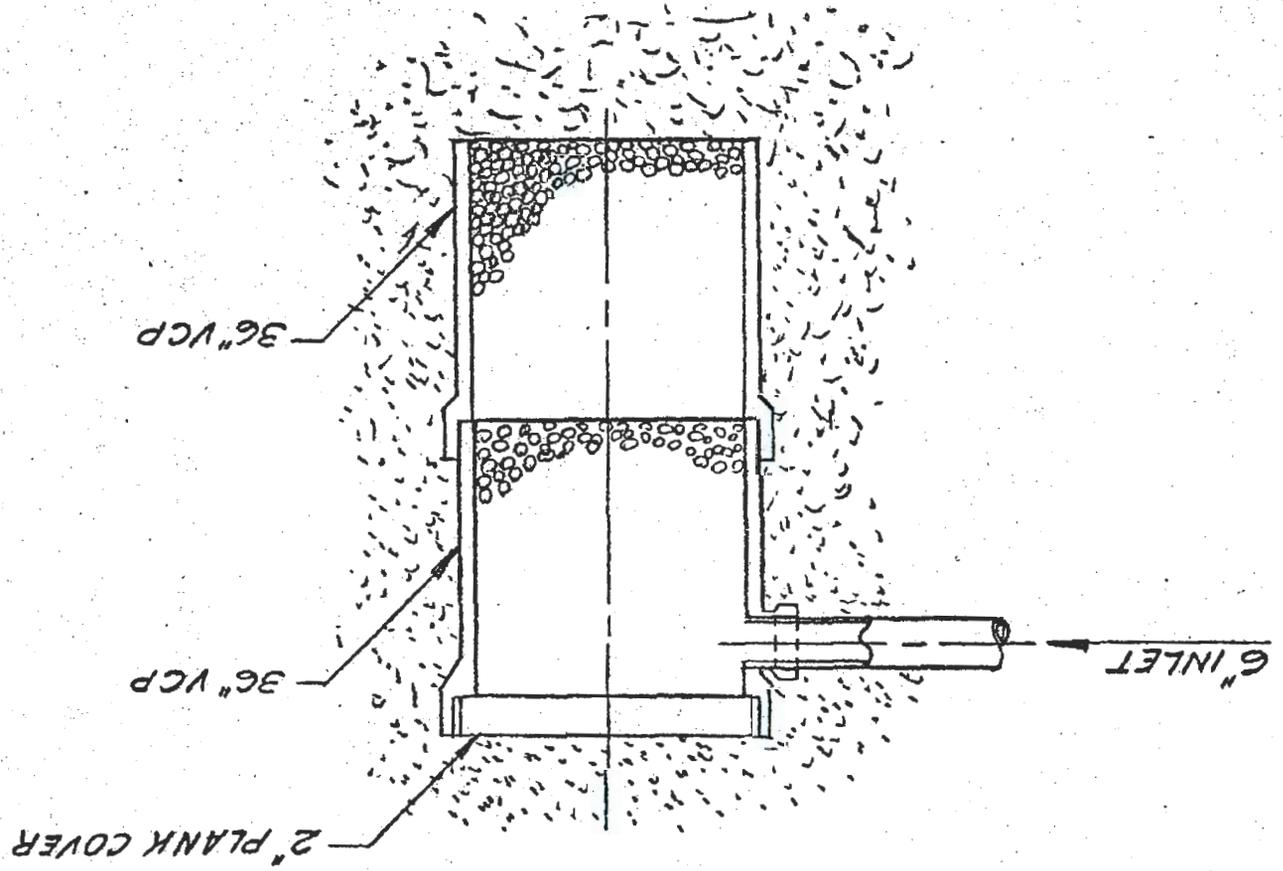

HW 55176-PART 2
 APPENDIX C-19
 DRAWN BY SIMKIZ/10/93

26

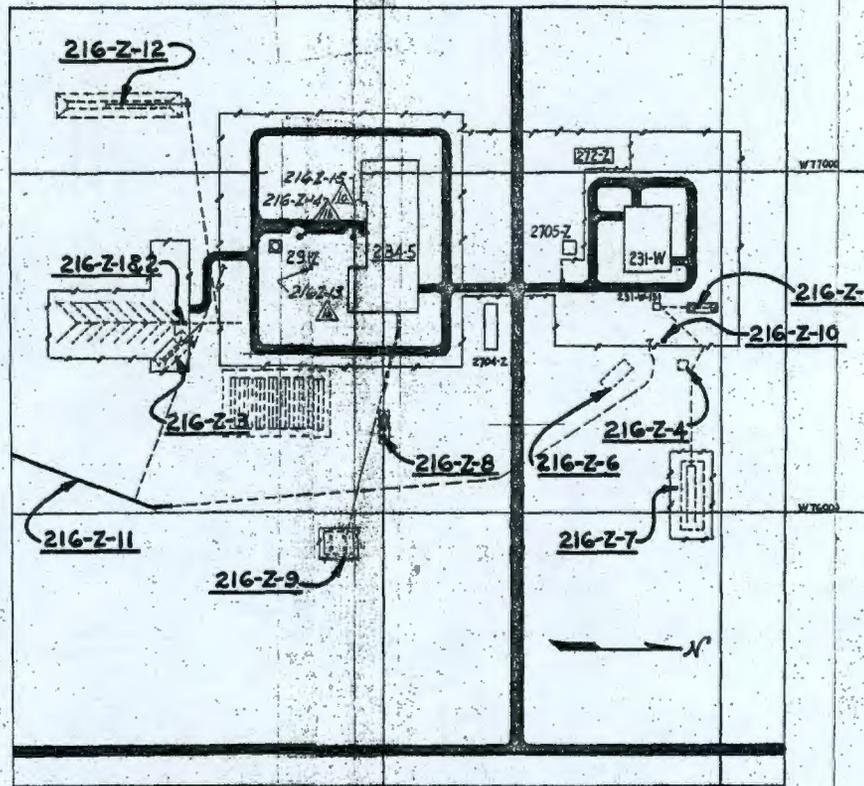

HW-55176-PT II
APPENDIX D

APPROVED
 FOR DESIGN
 NOT FOR CONSTRUCTION

REVISIONS NO. 1 DATE 1/11/78 BY [Signature] FOR [Signature]	
SK-2-17807	
CLASSIFICATION NONE	
SCALE AS SHOWN	
DATE 7/22	
U. S. ATOMIC ENERGY COMMISSION WAPOR ATOMIC PRODUCTS OPERATION GENERAL ELECTRIC	
Z PLANT LIQUID WASTE DISPOSAL SITES 216-Z SERIES	
NO. 216Z SK-2-17807	

21

REDOX

UNCLASSIFIED

HW-55176, Pt. III
Page 1

INDEX OF CPD CRIB BUILDING NUMBERS
DESIGNS OF CPD RADIOACTIVE LIQUID WASTE
DISPOSAL SITES

Part III of VII Parts
Process Technology - Study Report

by

V. W. Wood
Radiological Design and Development
Facilities Engineering Operation
CHEMICAL PROCESSING DEPARTMENT

April 21, 1958

D I S T R I B U T I O N

CR Bergdahl	TG LaFollette
JM Bernard	CE Linderoth
A Bradway	WN Mobley
WG Browne	HE Parker
E Doud	HF Peterson
J Durbin	DW Pearce
JB Fecht	OH Pilkey
DR Gustavson	EL Reed
CT Groswith	RA Roberts
WA Haney	HP Shaw
JF Honstead	ML Short
IM Jacques	W Tressler
EB Jackson	VW Wood
CE Kent	300 Files

UNCLASSIFIED

UNCLASSIFIED

HW-55176, Pt. III

Page 2

INDEX OF CPD CRIB BUILDING NUMBERS
DESIGNS OF CPD RADIOACTIVE LIQUID WASTE
DISPOSAL SITES

Part III of VII Parts
Process Technology - Study Report

INTRODUCTION

During the fourteen years or more which the separations areas have operated, many sites have been used for the disposal of radioactive liquid wastes. Various methods have been used in assigning building numbers to these sites and, in a number of cases, changes have been made which have brought about some confusion. One of the reasons being some currently used building numbers do not agree with the numbers existing on design prints for the facilities. Reference (2) was an effort to establish a listing of the liquid waste disposal sites. It required considerable time and research to locate information concerning these sites.

Many varied designs have been used for the disposal of radioactive liquid wastes. Reverse wells, trenches, cribs or caverns, etc, have been used. Specific information on these facilities is often difficult to obtain for in some instances they were constructed on work orders with no records being retained on the design. In general, the design on each facility has been different. This has made it extremely difficult for people to have a good working knowledge of the various waste disposal sites.

PURPOSE

The purpose of this report (Part III) is to provide a ready reference to the Redox Plant liquid waste disposal sites as well as a compilation of sketches showing the basic information on the design of each facility.

Another objective is to establish a simplified and uniform numbering system. Still another objective is to provide an up-to-date tabulation. Subsequent parts of this report will provide information on cribs for such plants as "B" and "T" Plant.

SUMMARY AND CONCLUSIONS

All radioactive liquid waste disposal sites should have the 216 Building number designation. These should be further grouped by giving all such sites for Purex a prefix of 216-A. Other major series would be 216-S for Redox; 216-T for "T" Plant; 216-B for "B" Plant; 216-B for "B" Plant; and 216-Z for "Z" Plant.

UNCLASSIFIED

The numbering list in "Official Hanford Works Building List - Specification HW-5000" by Engineering Files - Construction Engineering Operation should be revised to more closely follow the above numbering system.

RECOMMENDATIONS

It is recommended that the following action be taken:

1. All groups and services referring to the Redox Plant cribs or report data concerning them should use the index numbering system as presented in this report. In the case of Redox Plant this means several changes. See cross reference, page 4.
2. That all drawings concerning these disposal sites, including maps, be revised to show the proper locations and numbers for these cribs.
3. Any suggestions for improving the usefulness of this report should be referred to the author.

DISCUSSION

When all seven parts of the report are completed, and the work outlined in the report is completed, much confusion will be eliminated and more people will be better informed on the design of each waste disposal facility. The report will provide a firm basis for future building number assignments.

While some sincere efforts have been made to try and keep a methodical system for recording waste disposal sites, a number of problems have developed, for example, HW-5000, Sheet 29 of 50 lists, only eight cribs in the 216-5 series. Also reference 2 has assigned numbers which do not agree with the crib numbers assigned on many drawings.

As indicated earlier, the use of the crib index, as presented in this report should be very easy. In addition, information is presented which is very difficult to locate in the records and in some cases it is not available in the records.

REFERENCES

1. HW-5000, "Official Hanford Works Building List - Specification HW-5000" by Engineering Files - Construction Engineering Operation.
2. HW-43121, "Tabulation of Radioactive Liquid Waste Disposal Facilities" by HV Clukey dated May 10, 1956.
3. HW-33305, "Tabulation of Radioactive Liquid Waste Disposal Facilities" by HV Clukey dated October 8, 1954.
4. HW-41535, "Unconfined Underground Radioactive Waste and Contamination in the 200 Areas" by KR Heid dated January 17, 1956.

CROSS REFERENCE
REDOX PLANT RADIOACTIVE LIQUID WASTE
DISPOSAL SITES

<u>Suggested Crib No.</u>	<u>Number Listed in HW-5000</u>	<u>Number Listed in HW-43121</u>	<u>Number Used On Drawings or Original Number</u>
216-S-1	216-S-1	216-S-5	216-S-1
216-S-2	216-S-2	216-S-5	216-S-2
216-S-3	216-S-3	216-S-8	216-S-3
216-S-4	216-S-4	216-S-7	216-S-4
216-S-5	216-S-5	216-S-9	216-S-5
216-S-6	216-S-6	216-S-13	216-S-6
216-S-7	216-S-7	216-S-15	216-S-7
216-S-8	216-S-8	216-S-3	216-S-8
216-S-9	None	None	216-S-9
216-S-10	None	216-S-10	216-S-10
216-S-11	None	216-S-11	None
216-S-12	None	216-S-12	None
216-S-13	None <i>276-5 Crib</i>	216-S-6	None
216-S-14	None	216-S-4	None
216-S-15	None	216-S-2	None
216-S-16	None	216-S-16	None
216-S-17	None	216-S-1	None
216-S-18	None	216-S-14	None
216-S-19	216-SL-7	216-SL-1	None
216-S-20	None	216-SL-2	None
216-S-21	216-SX-1, 2	216-SX-1	216-SX-1
216-S-22	<i>Fractionator Crib</i>		

APPENDIXA. Explanation of Parts to the Report

Part I will cover the Purex Radioactive Liquid Waste Disposal Sites.

Part II will cover the "Z" Plant Radioactive Liquid Waste Disposal Sites.

Part III will cover the Redox Plant Radioactive Liquid Waste Disposal Sites.

Part IV will cover the "U" Plant Radioactive Liquid Waste Disposal Sites.

Part V will cover the "T" Plant Radioactive Liquid Waste Disposal Sites.

Part VI will cover the "B" Plant Radioactive Liquid Waste Disposal Sites.

Part VII will cover the "C" Plant, Hot Semi-Works, the 200 North Areas and miscellaneous.

UNCLASSIFIED

HW-55176, PT III
Page 5

- B. Index for Redox Plant Radioactive Liquid Waste Disposal Sites.
- C. Sketches of Redox Plant Waste Disposal Facilities.
- D. Map of Redox Plant Sites (SK-2-17808).

UNCLASSIFIED

UNCLASSIFIED


HW-55176, PT III
Appendix B
Revised 10/19/59

CRIB INDEX

Redox

<u>Number</u>	<u>Description Appendix Sheet</u>	<u>Service</u>	<u>Use Dates</u>		<u>Status</u>
			<u>From</u>	<u>To</u>	
216-S-1	C-1, 2 & 3	D-2 Process Condensate	1/52	1/56	Replaced by S-7
216-S-2	C-1, 2 & 3	Overflow from S-1	1/52	1/56	Replaced by S-7
216-S-3	C-4	241-S TK 101 & 104 Condensate	8/53	-	Abandoned
216-S-4	C-4	241-S TK 101 & 104 Condensate	8/53	-	Abandoned
216-S-5	C-5, 6 & 7	Steam Condensate	3/54	11/54	Replaced by S-6
216-S-6	C-8 & 9	Steam Condensate	11/54	-	Active
216-S-7	C-10 & 11	D-2 Process Condensate	1/56	-	Active
216-S-8	C-12	Startup Wastes	11/51	2/52	Abandoned
216-S-9	None	Ditch to Chemical Waste Pit	2/54	-	Active
216-S-10	C-16	Chemical Waste Pit	2/54	5/54	Replaced by S-11
216-S-11	C-16	Chemical Waste Pit	5/54	-	Active
216-S-12	C-17	291-S Stack Wash Water		7/54	Abandoned
216-S-13	C-18 & 19	Organic Waste	2/52	-	Active
216-S-14	C-20	Organic Startup Waste		1/52	Abandoned
216-S-15	C-21	241-S TK 110 Condensate		10/52	Abandoned
216-S-16	C-22	Cooling Water Swamp	4/54	-	Active
216-S-17	C-23	Cooling Water Swamp	3/52	4/54	Replaced by S-16
216-S-18	C-24	Steam Cleaning Pit	10/54	-	Not in use
216-S-19	C-25	222-S Cooling Water	1/52	-	Active
216-S-20	C-26, 27 & 28	222-S & 300 Area Wastes	3/52	-	Active
216-S-21	C-29 & 30	241-SX Condensate	11/54	-	Active
216-S-22	C-31	293-S Caustic Scrubber Wastes	1957	-	Inactive

UNCLASSIFIED

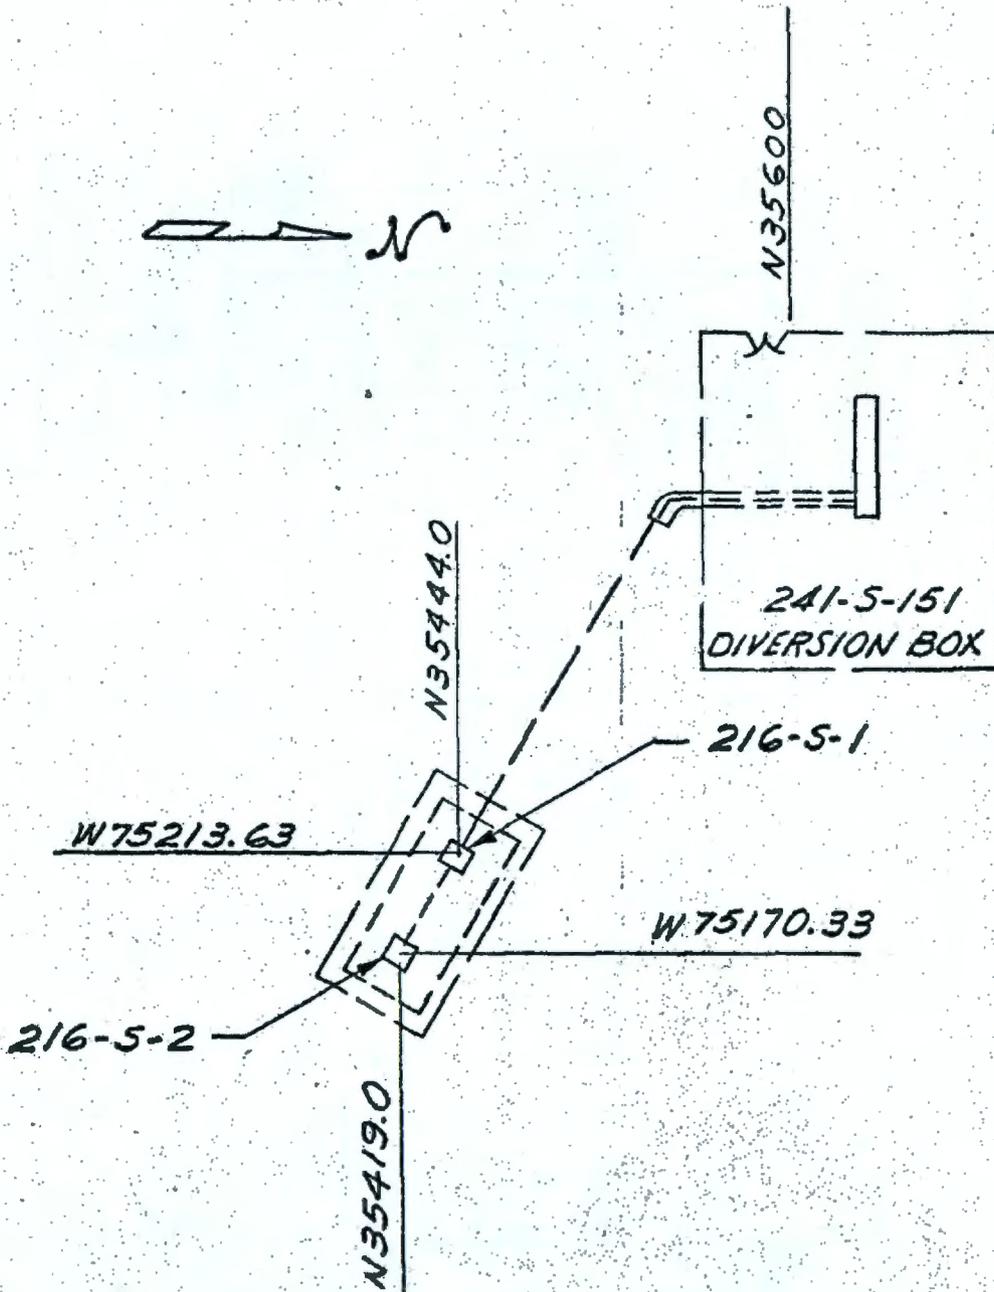


216-S-1
216-S-2
H-2-1813
H-2-1774


216-S-1#2 Gibs


TAKEN FROM
H-2-1613

LONGITUDINAL SECTION

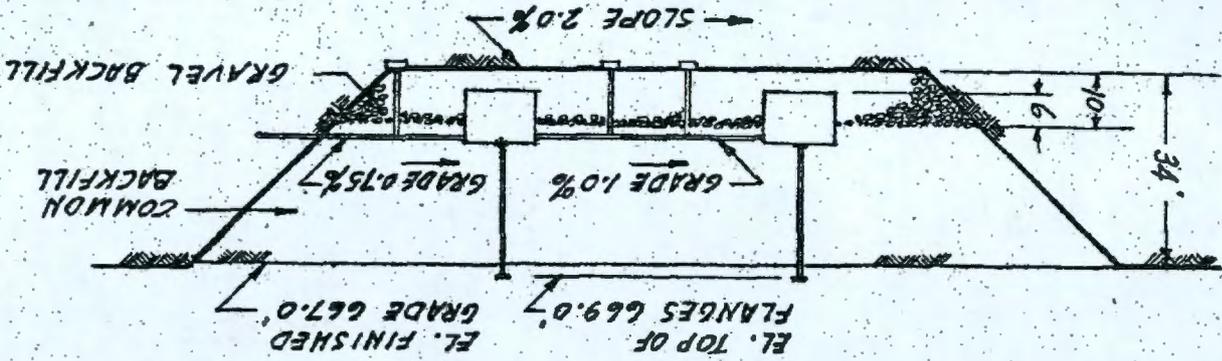


PLAN

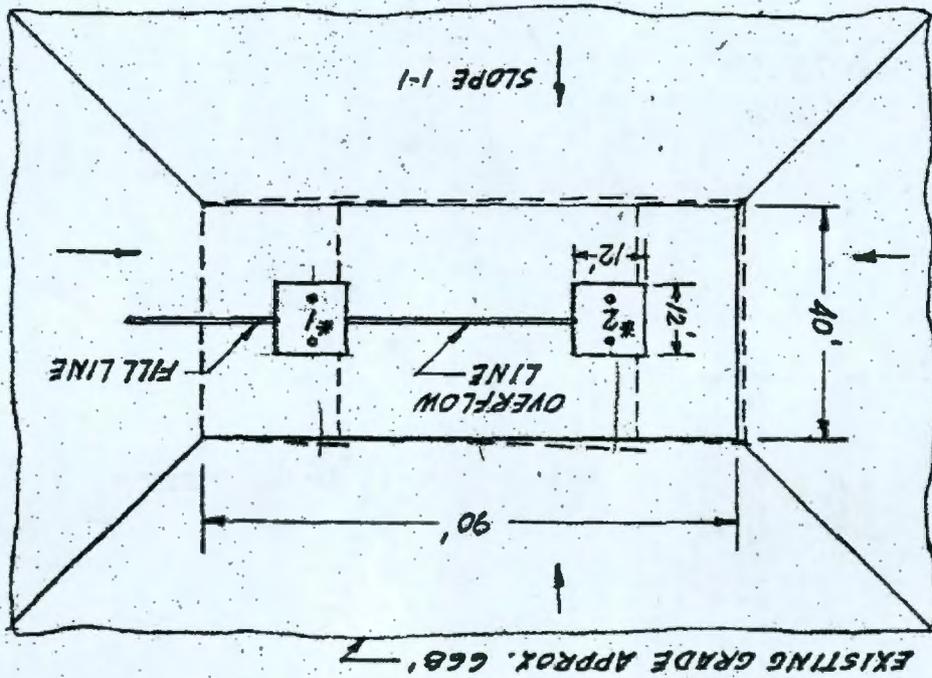

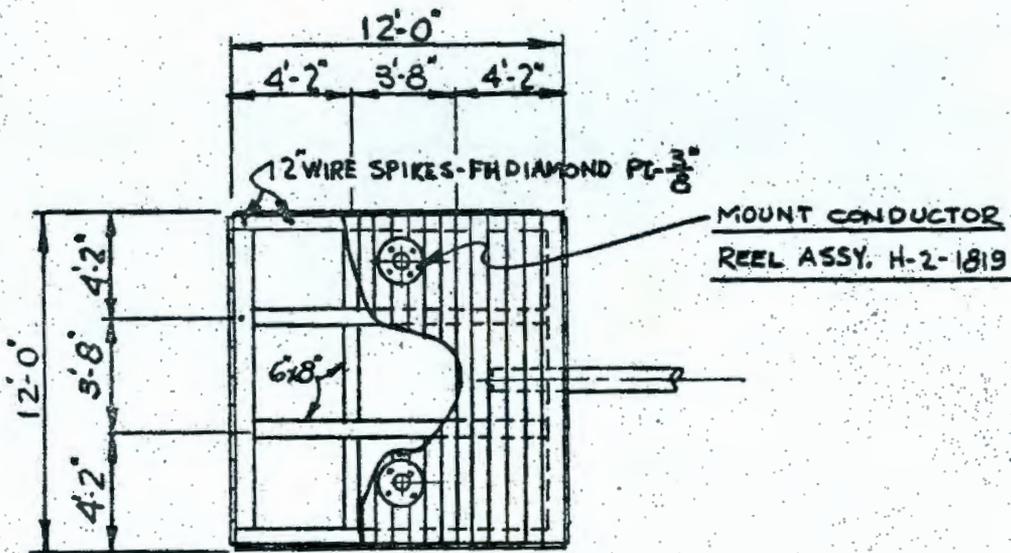

PLAN

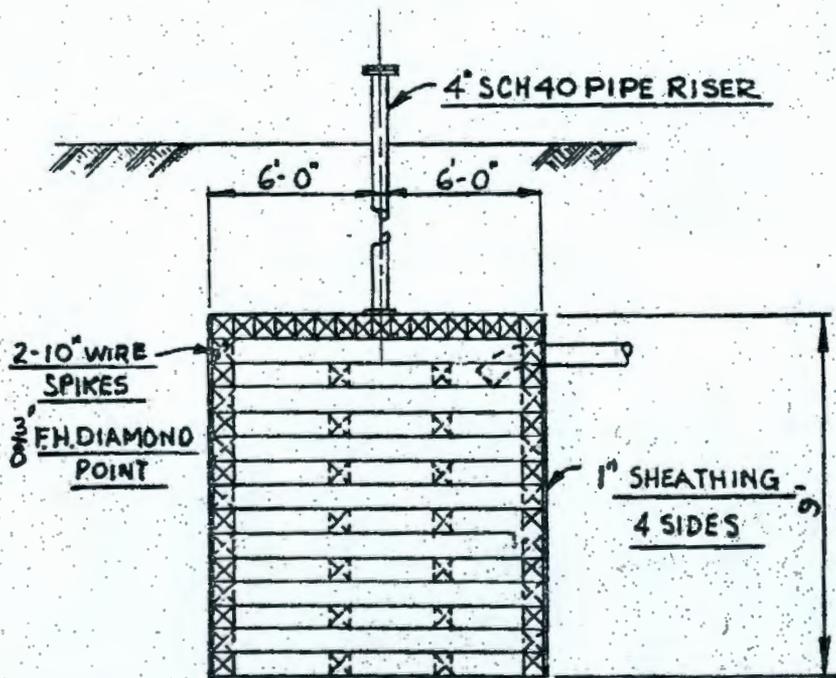


CRIB

TAKEN FROM H-2-1813

216-S-182



4

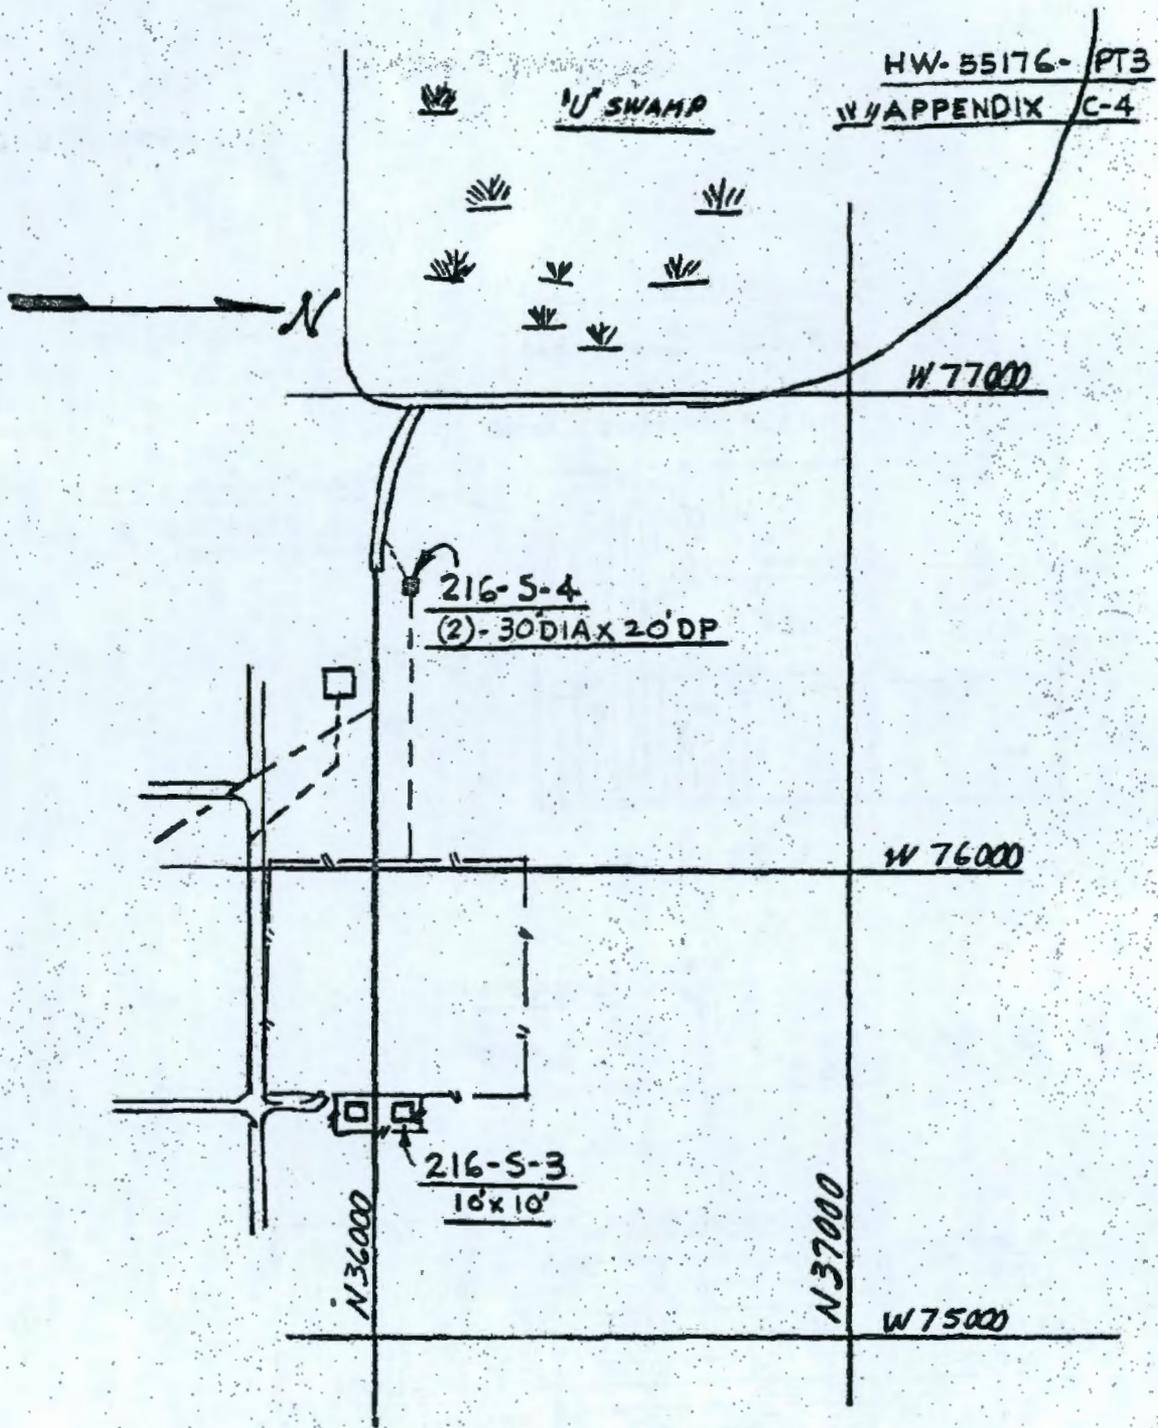


TAKEN FROM SK-2-1726
 SUPERSEDED BY H-2-39574
 NO INFORMATION AVAILABLE
 2892 - SHT19

216-S-3
216-S-4

5

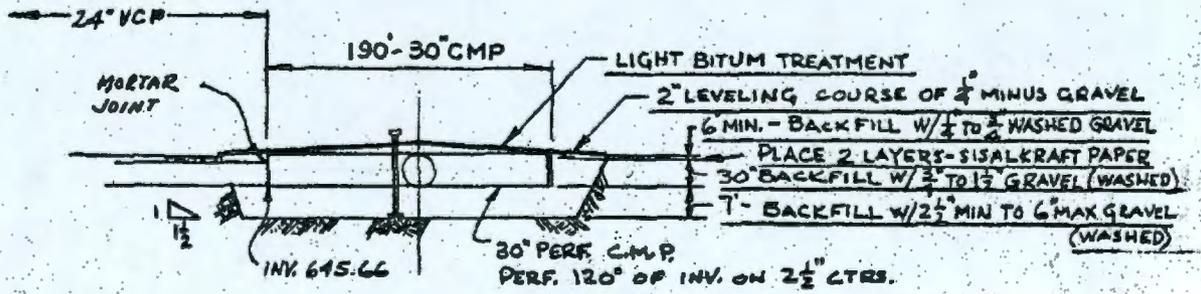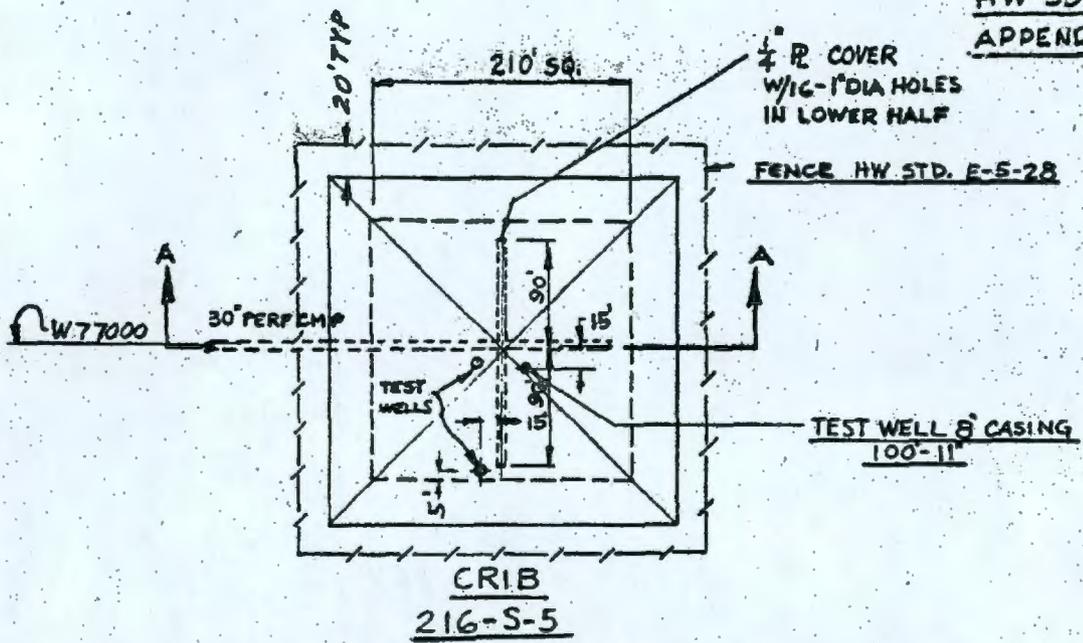

SECTION A-A



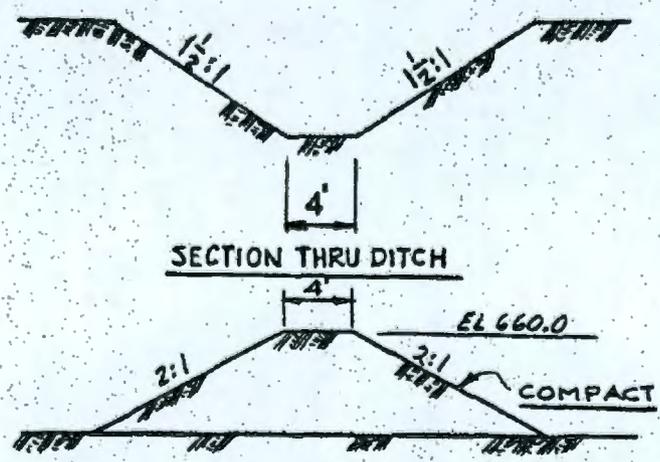


SECTION THRU DIKE

TAKEN FROM H-2-5963


216-S-5

HW-55176-PTS
APPENDIX C-7

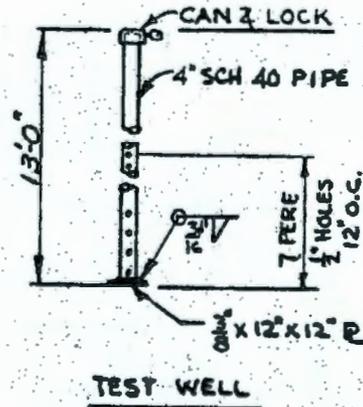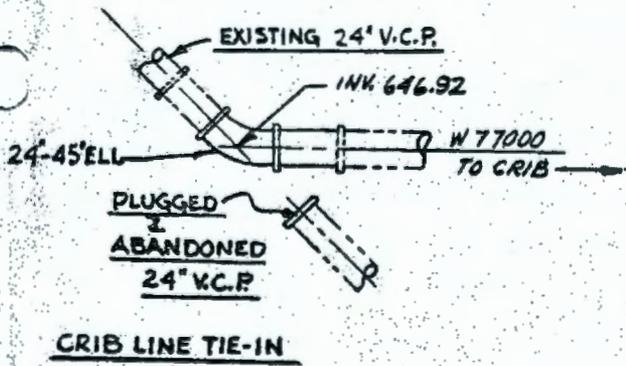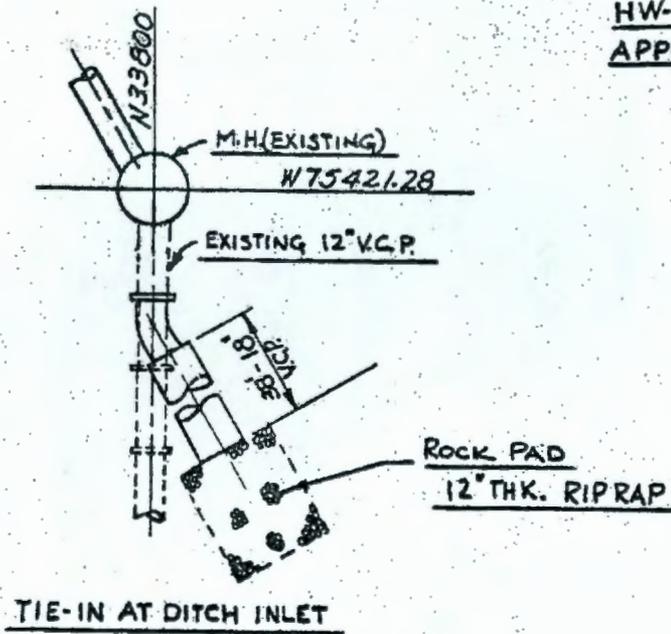


TAKEN FROM H-2-5963

216-S-5

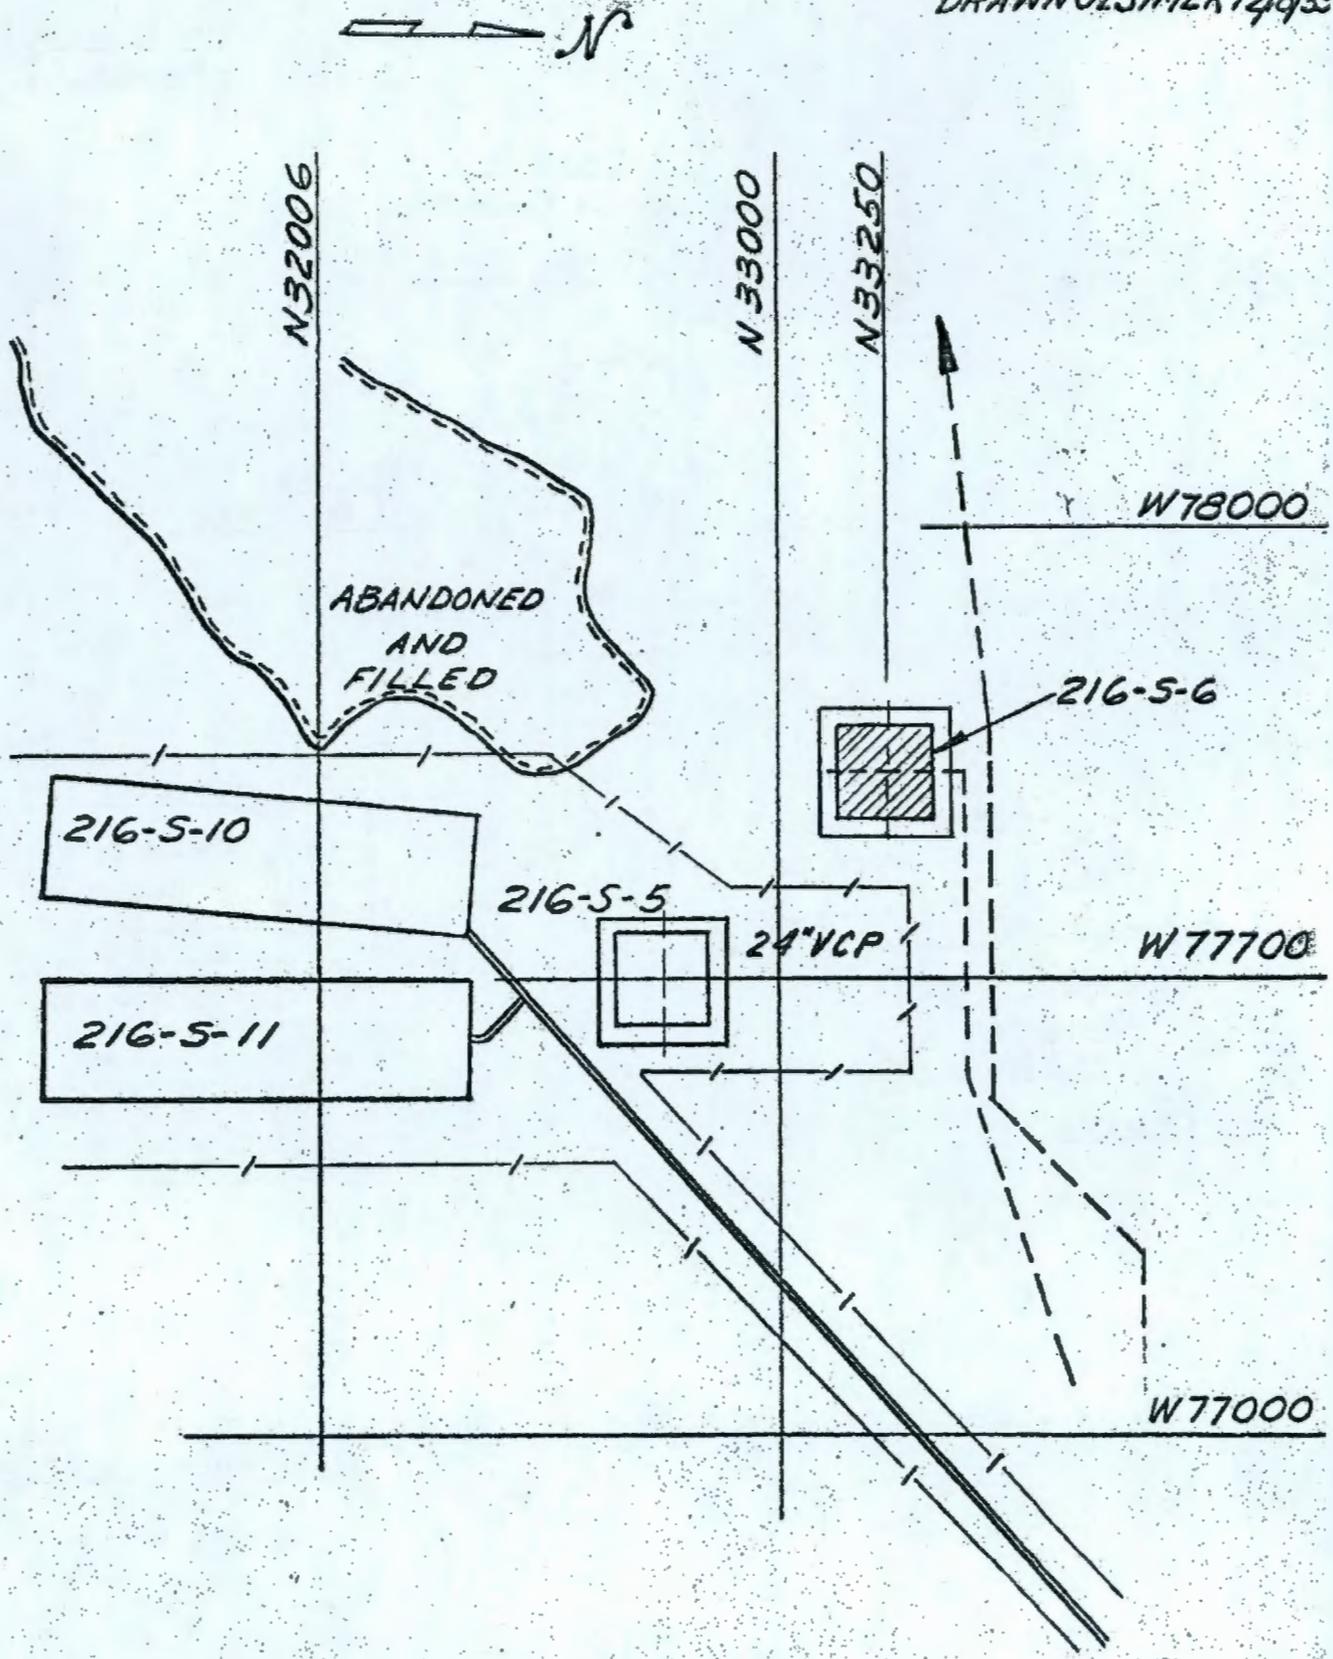



216-S-6
H-2-2594

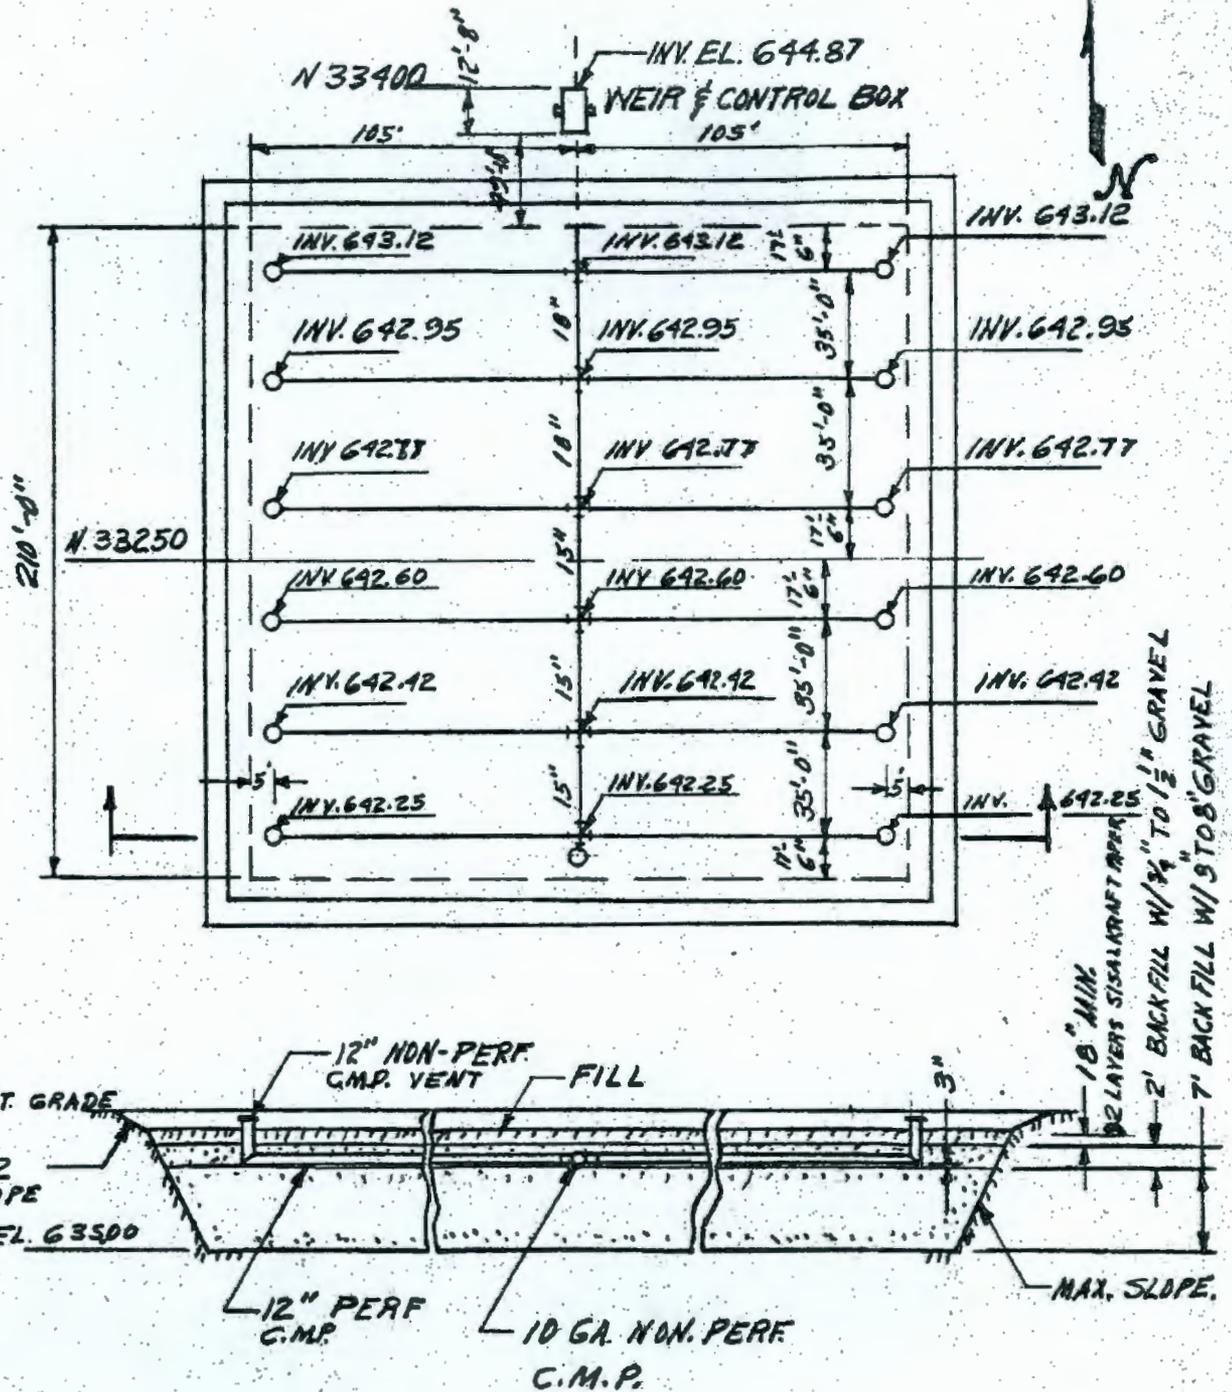


TAKEN FROM H-2-2595

FEDOX WASTE WATER DISPOSAL FACILITIES
CRIB & CONTROL STRUCTURE




216-S-6

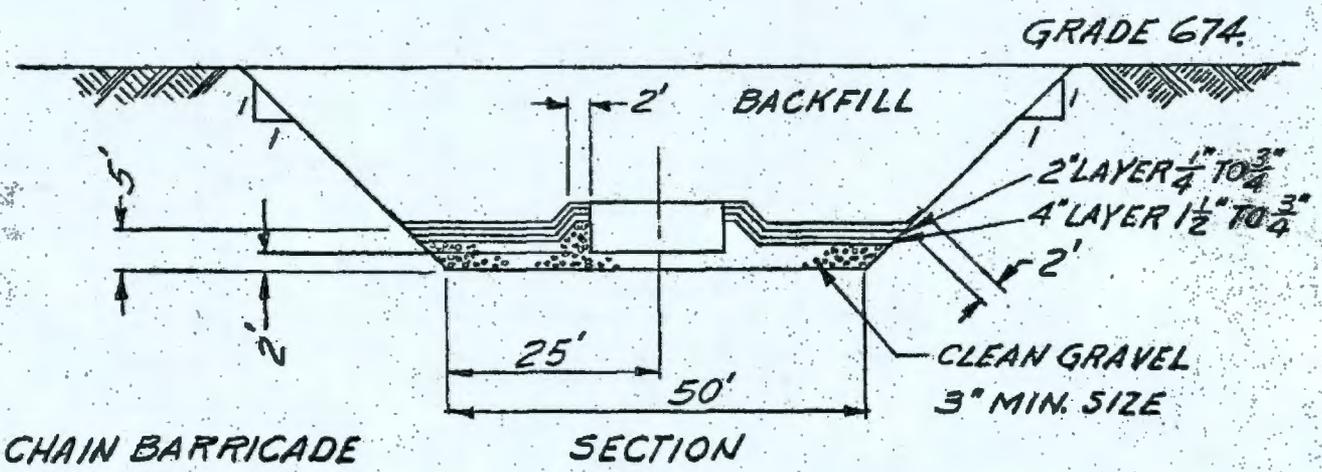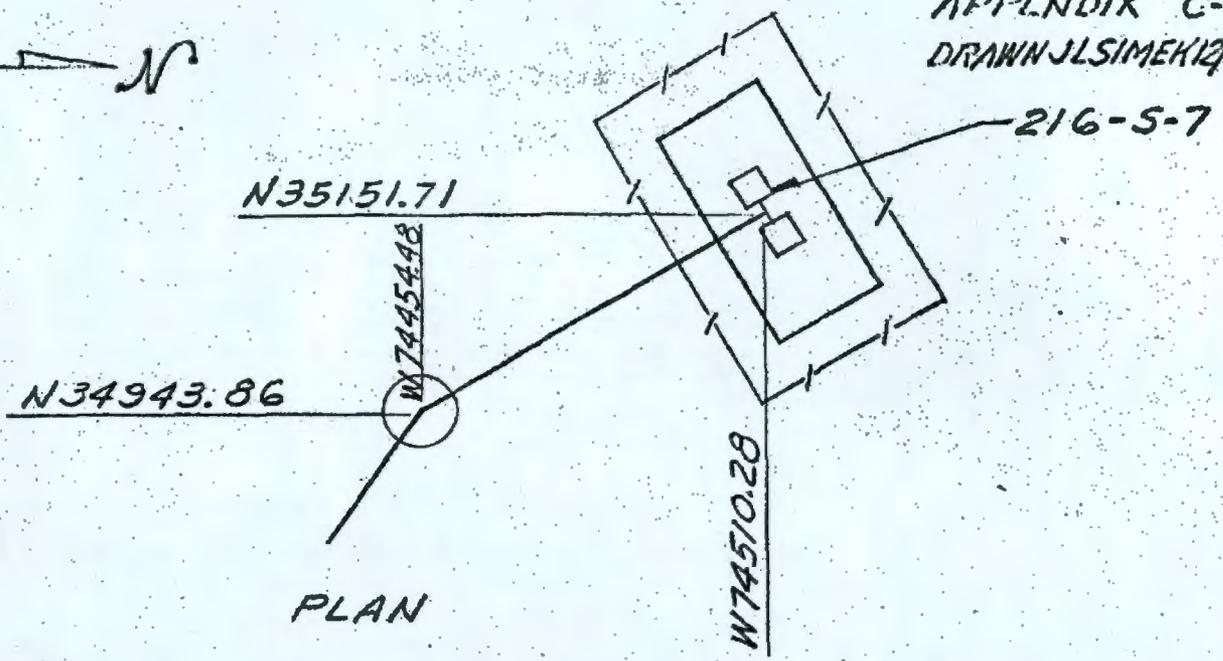

CHAIN BARRICADE
 HWS E-5-23A

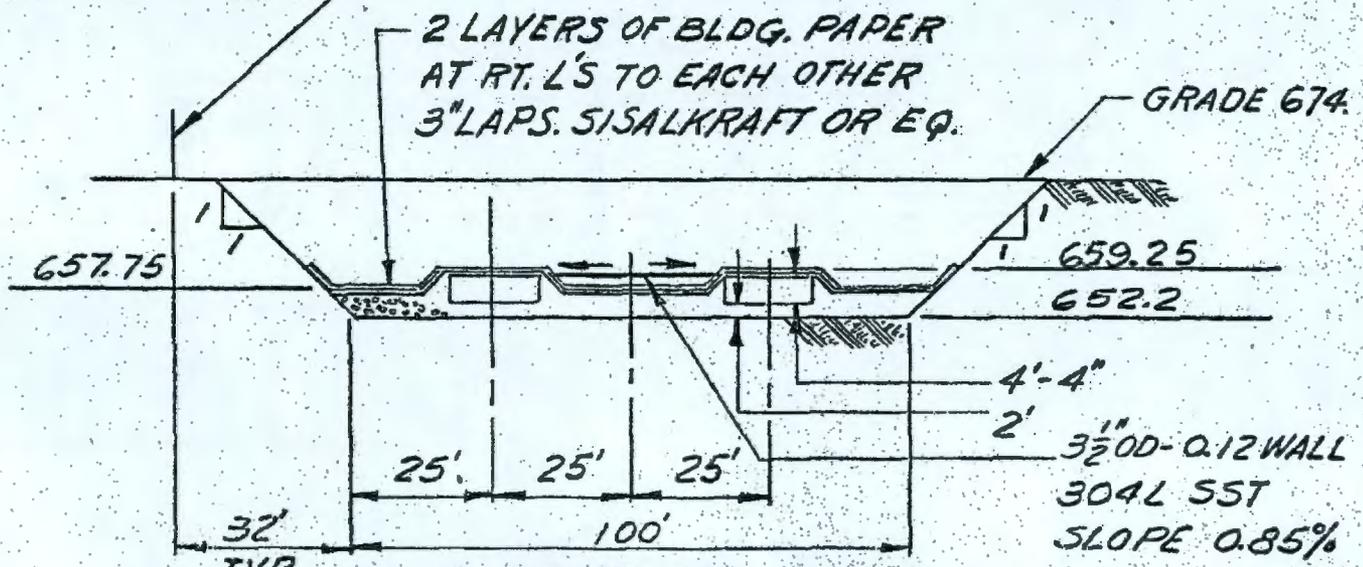


216-5-7
 H-2-30135

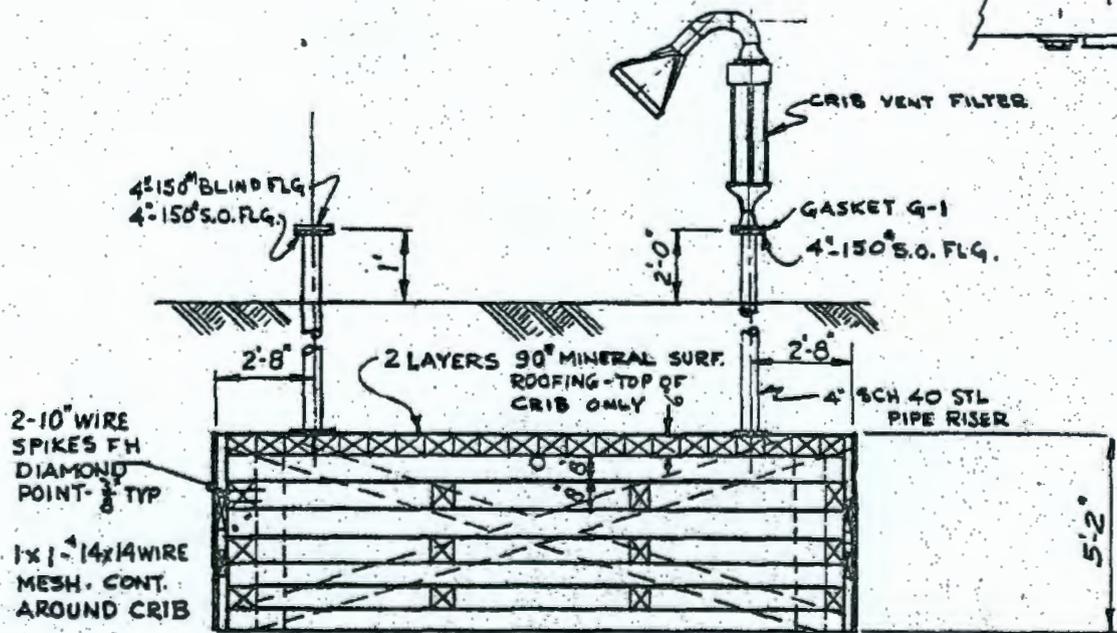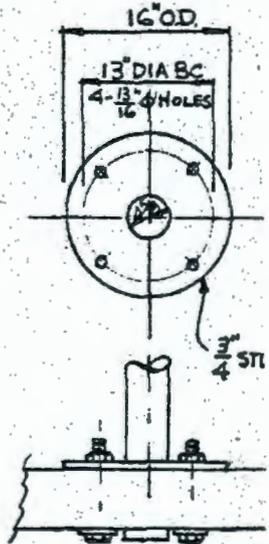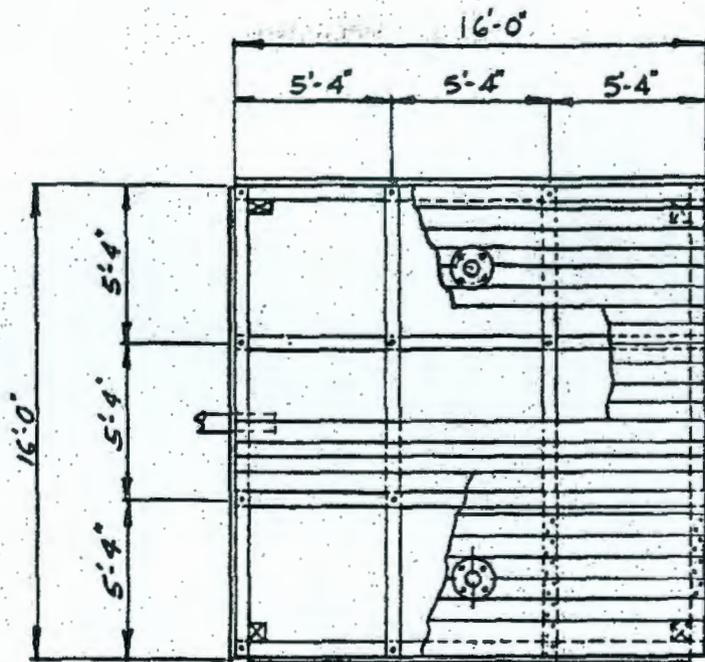


TAKEN FROM H-2-301

216-S-7

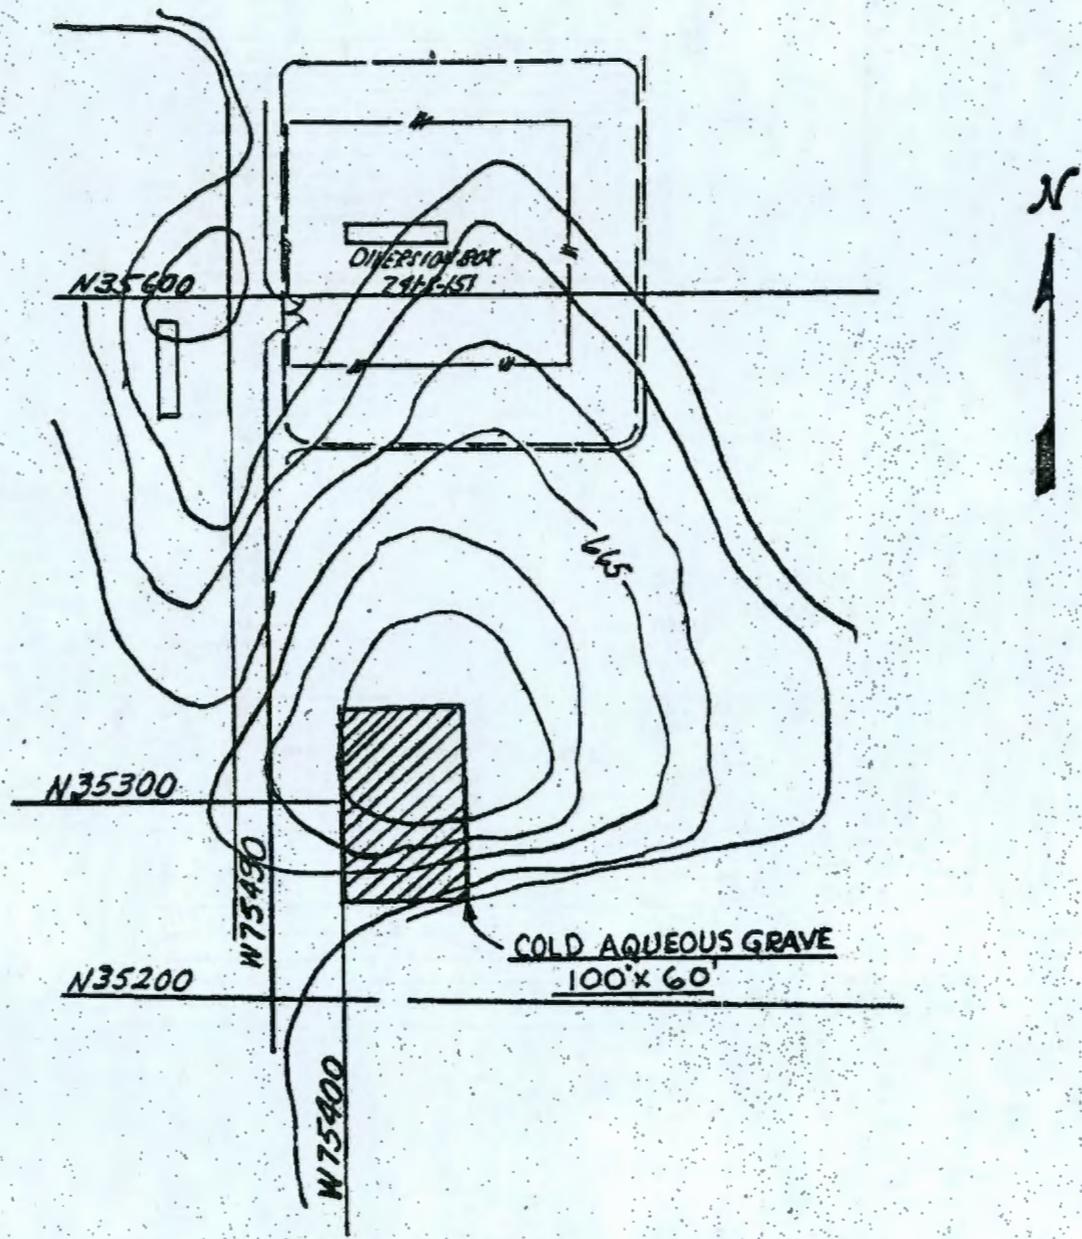

216-5-8


EXCESS MAT'L.
USED TO BACKFILL
EXISTING SWAMP
TO A DEPTH
OF ONE FOOT

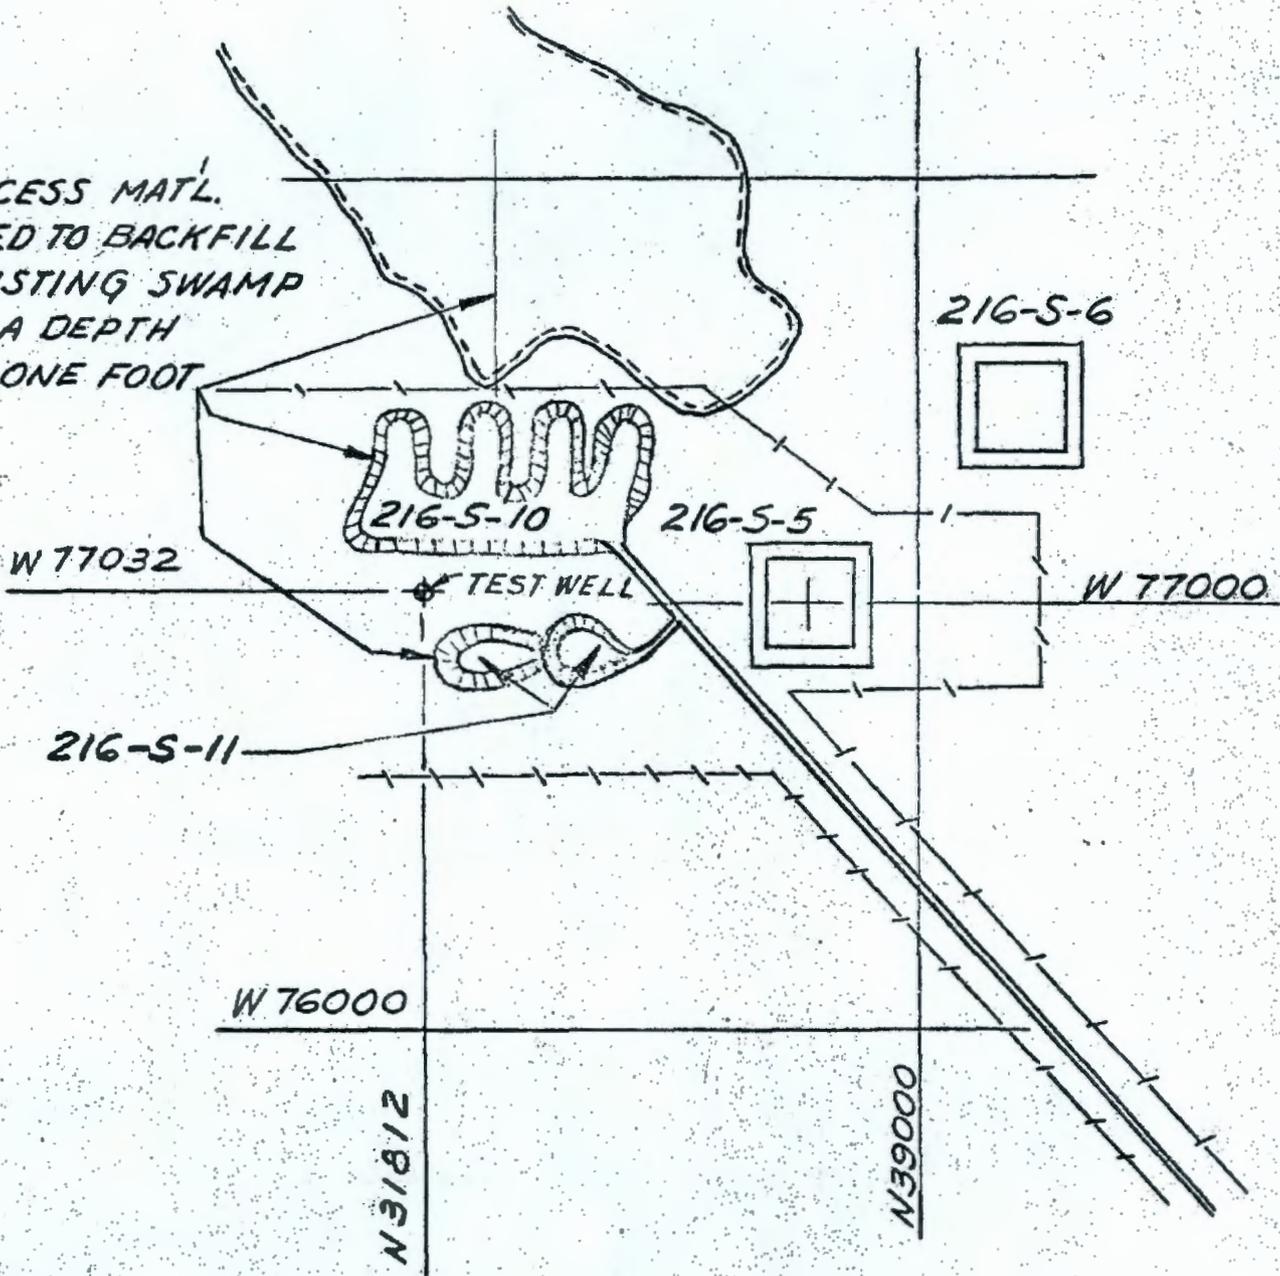

216-S-10



216-S-11

H-2-5962

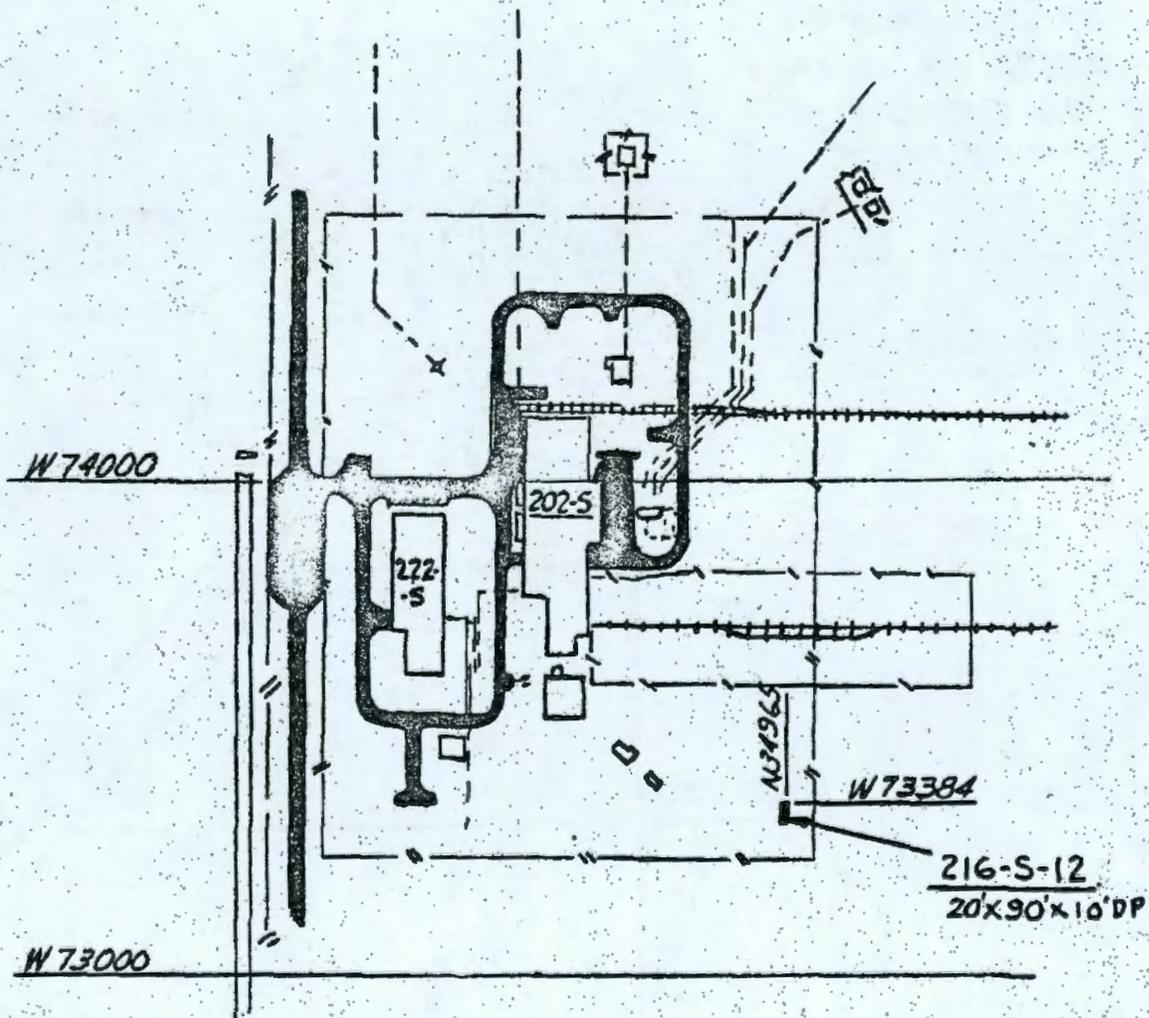



TAKEN FROM H-2-2430

216-S-12

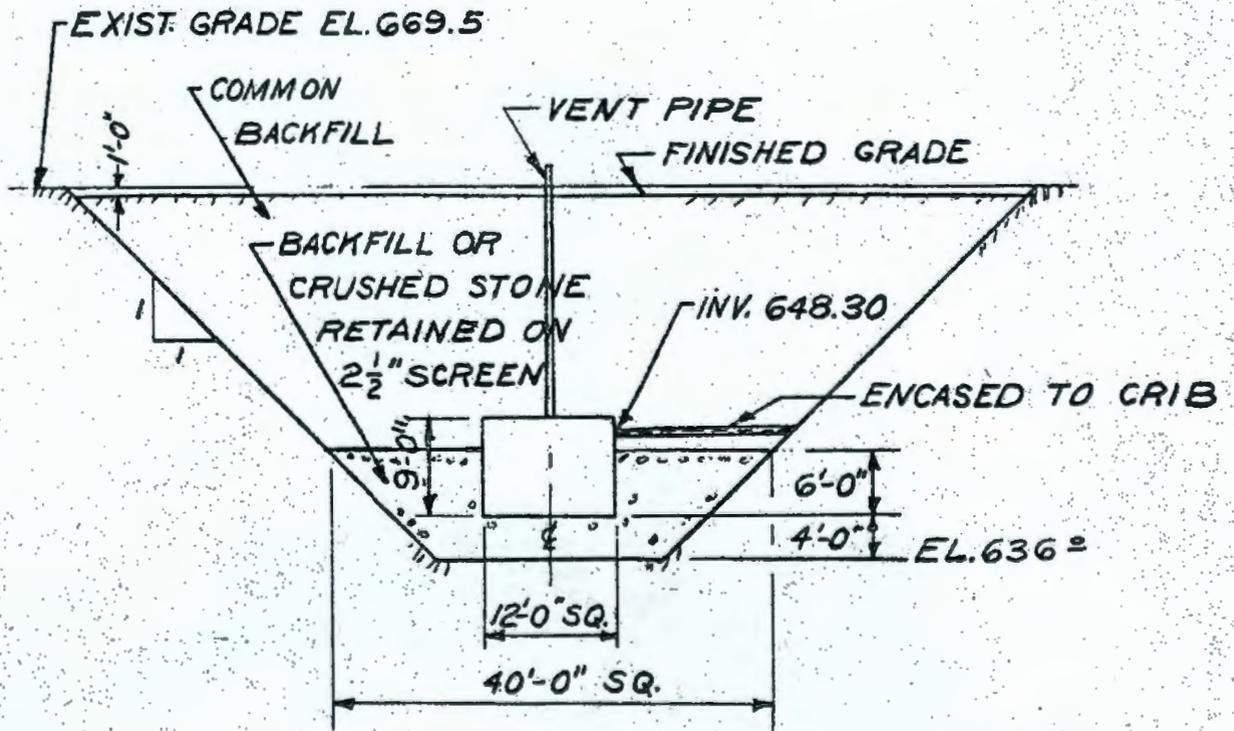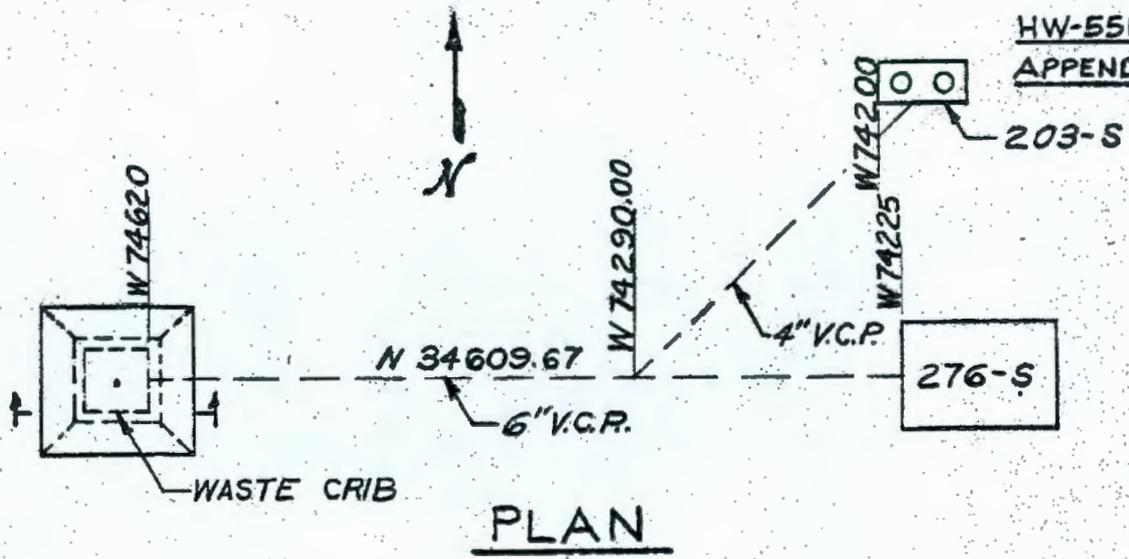


276-S ORGANIC-SOLVENT MAKE-UP & 203-S
DECONTAMINATED METAL STORAGE -CRIB &
WASTE LINE- BLDG. 276-S & 203-S

216-S-13

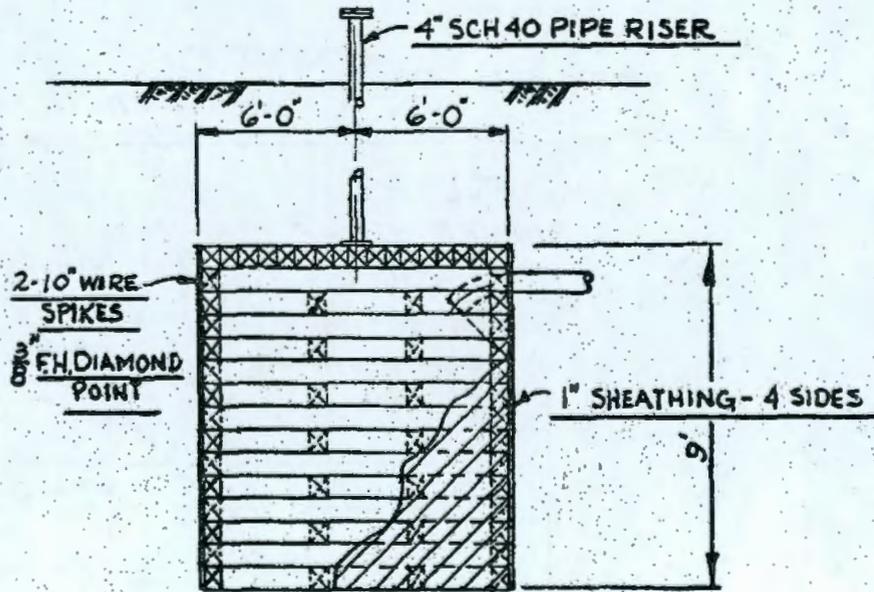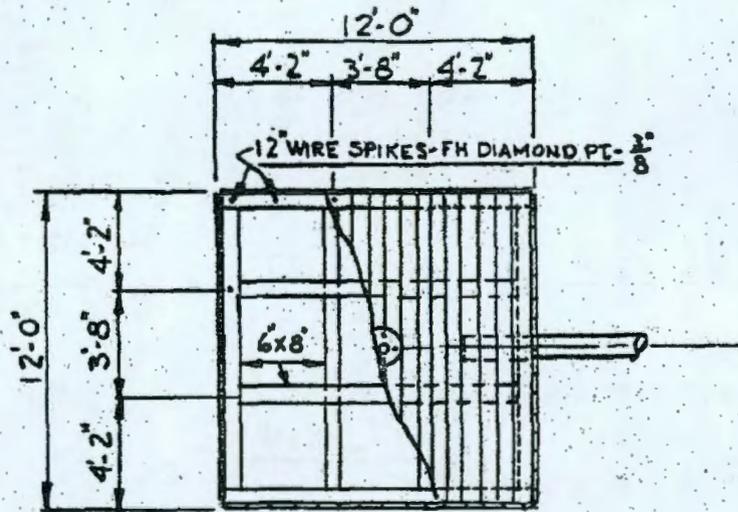


CRIB


TAKEN FROM H-2-5385

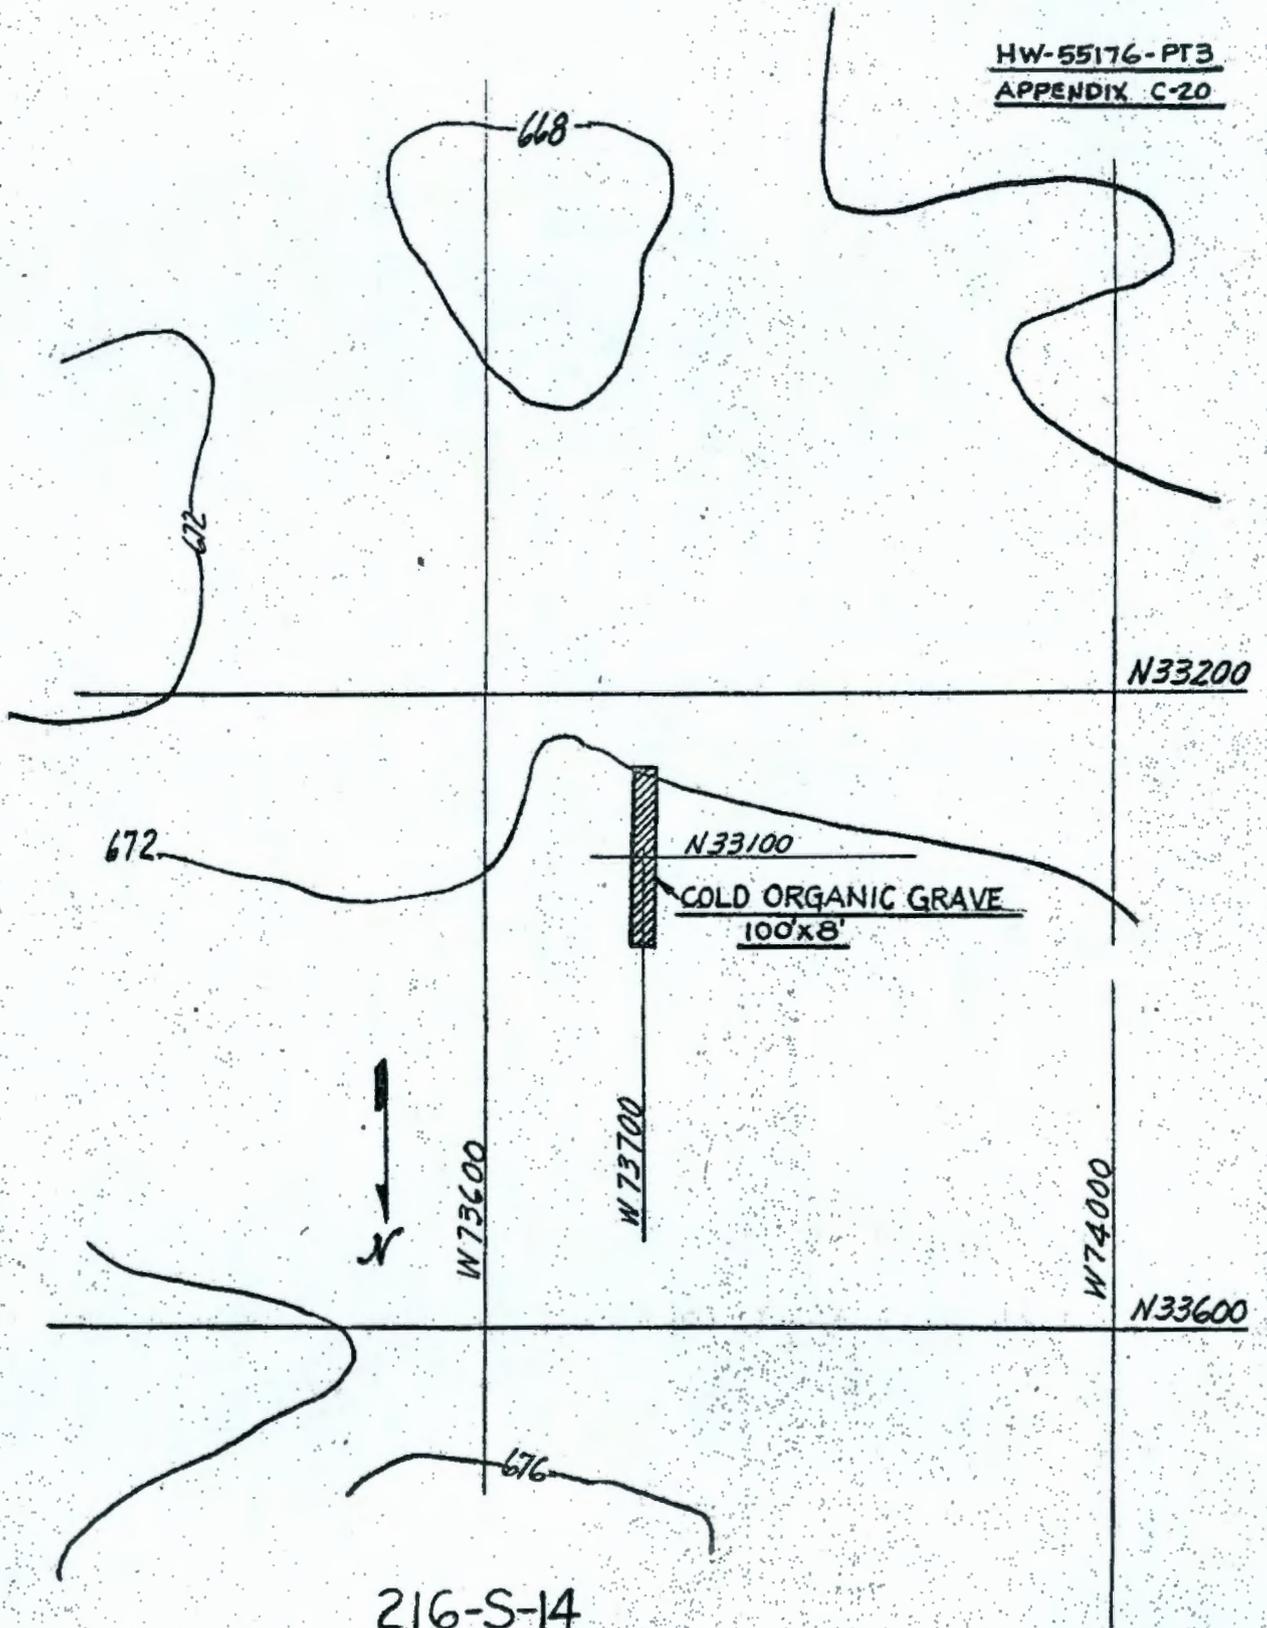

216-S-14

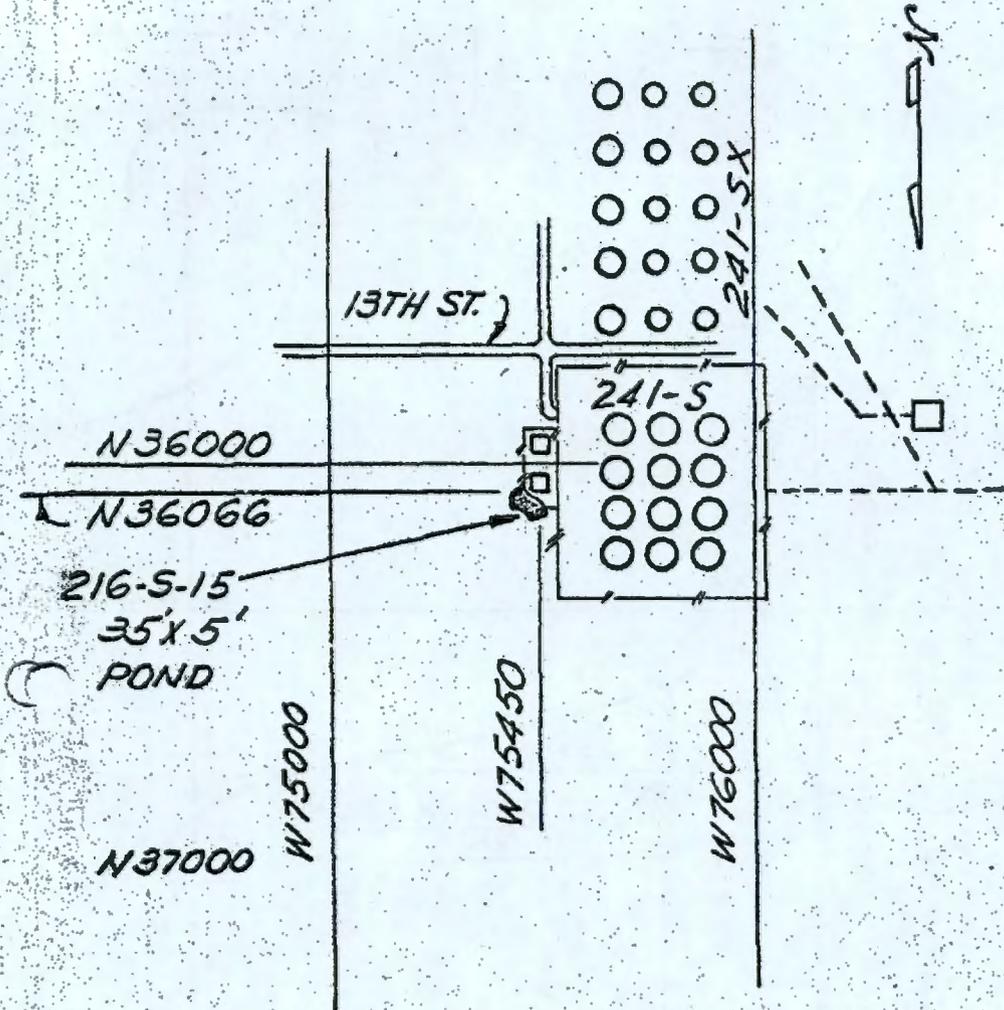

216-S-15
H-2-2430

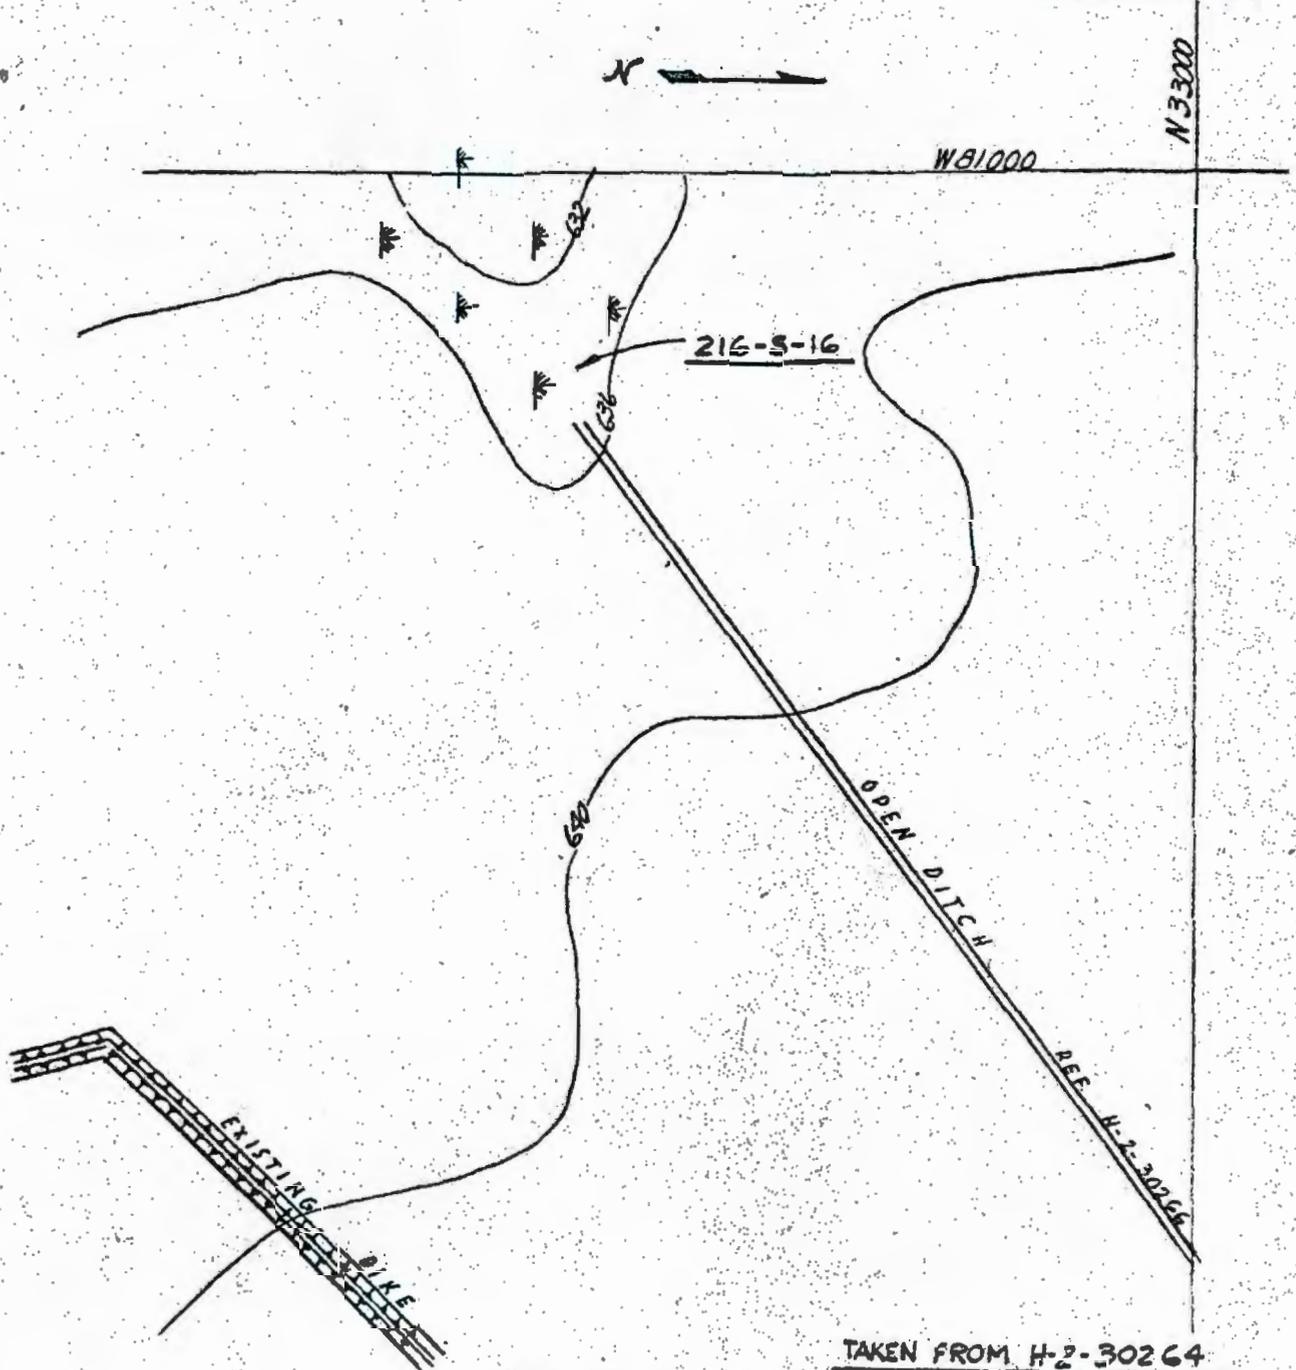

216-5-16

TAKEN FROM H-2-30264

N34000


HW-55176-PT3
APPENDIX C-23



MAX HEIGHT OF SPOIL
AREA 4'-0" ABOVE
EXISTING GRADE

N33000

216-S-17

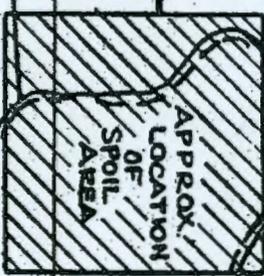


N32000

SWAMP




000BLM

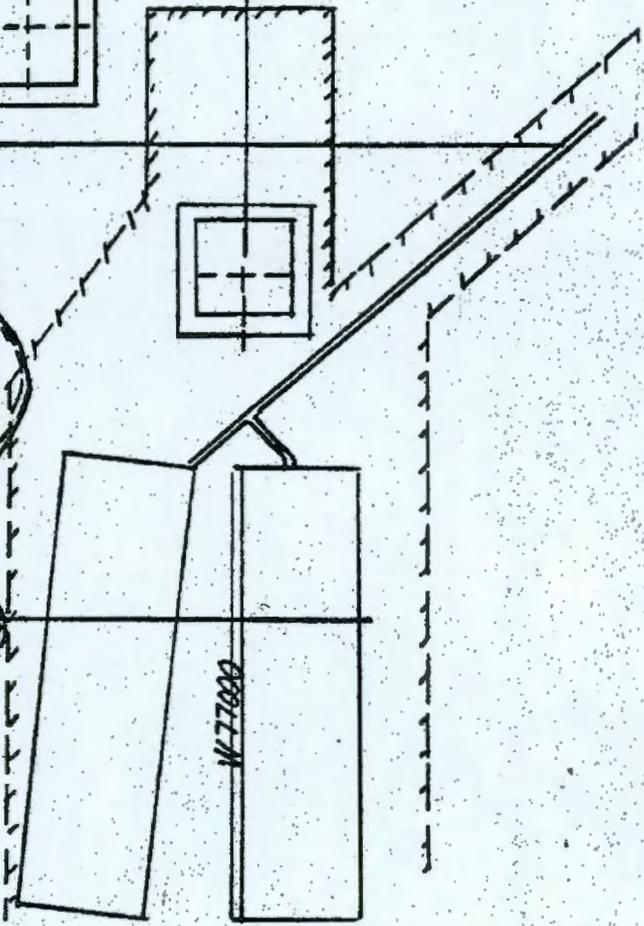

000BLM

TAKEN FROM H-2-2594


216-S-17

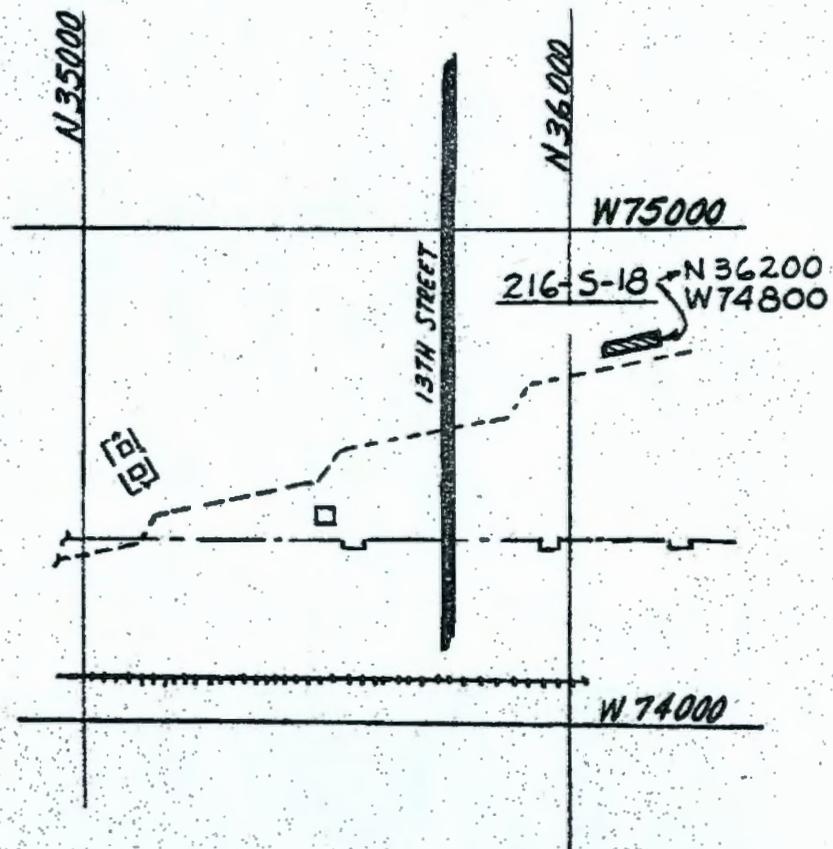

TAKEN FROM H-2-2430


216-S-18

HW-55176-PT3
APPENDIX C-25

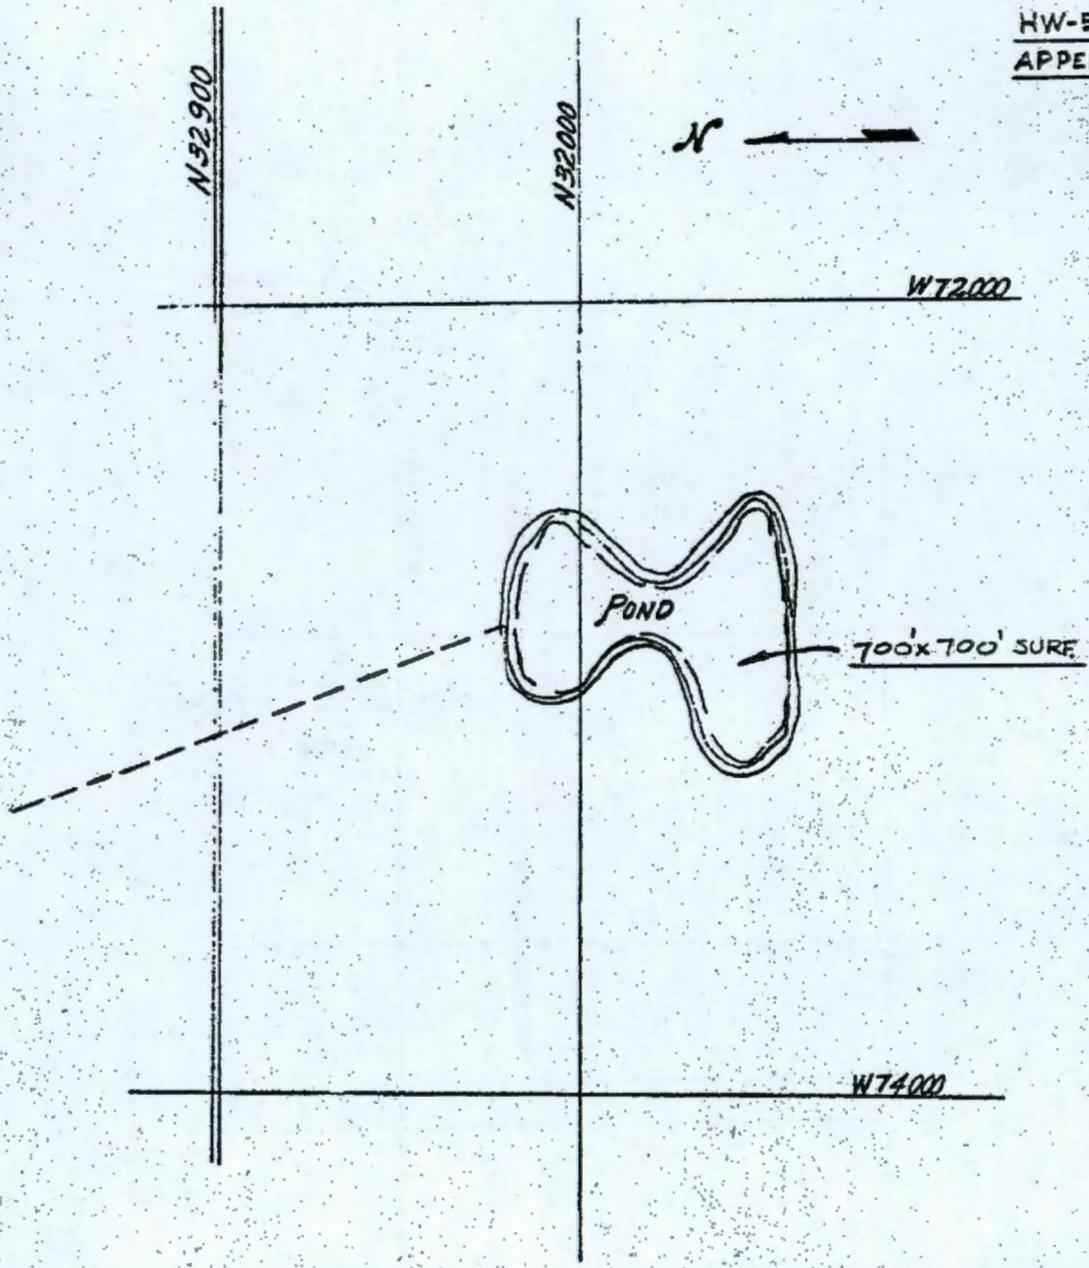


TAKEN FROM H-2-5101
M2892-SKT#27

216-S-19

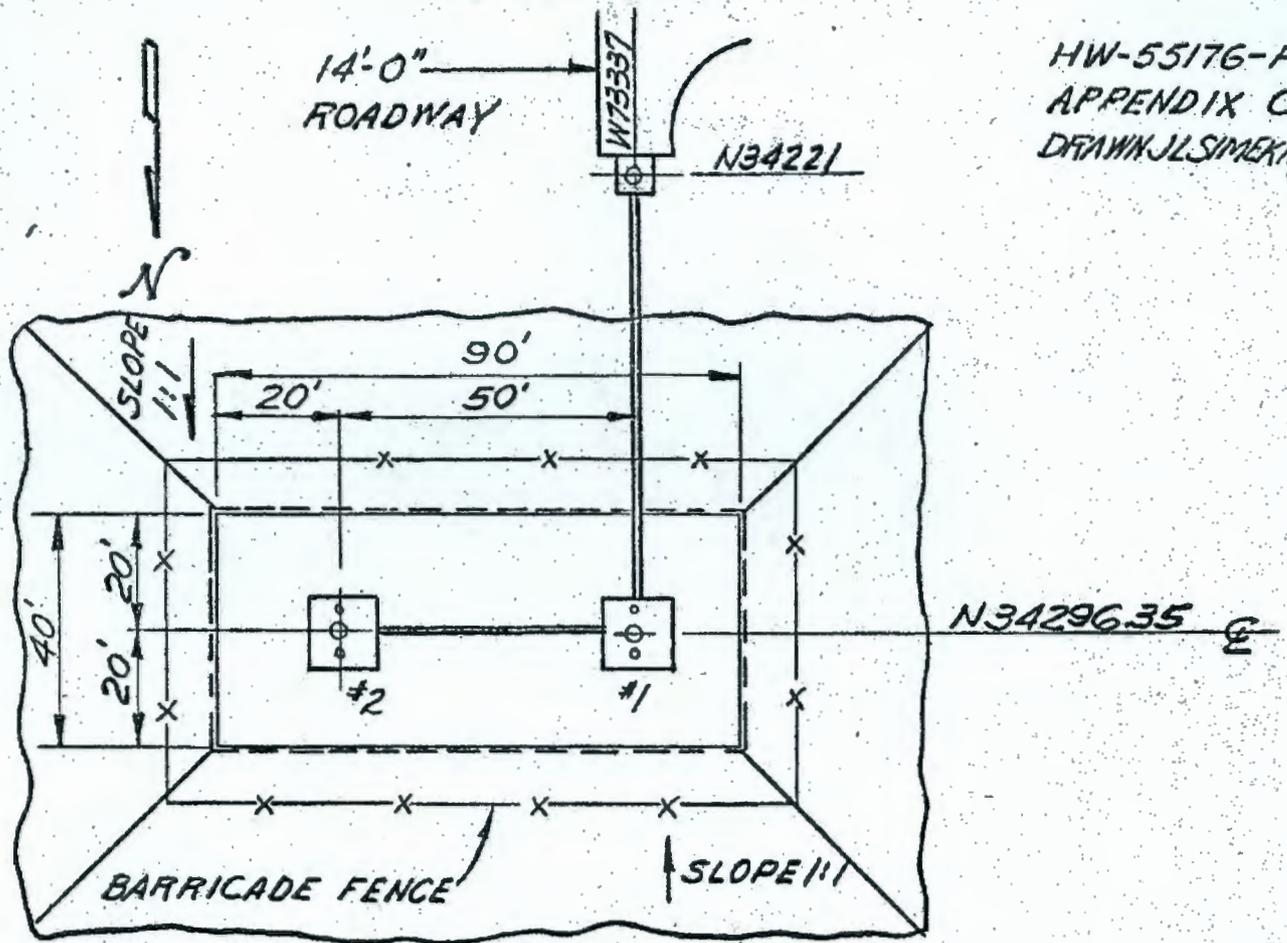

PLAN


VENT-SEE H-2-5229-SHT. #4
 #2 CRIB ONLY

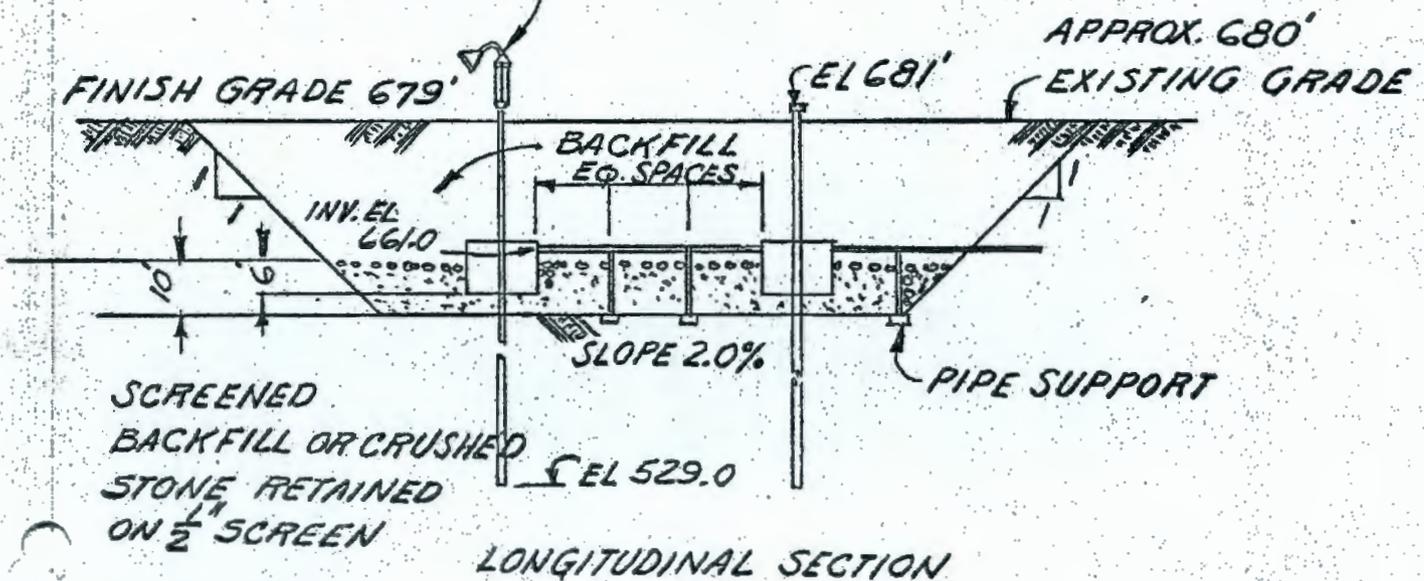


216-5-20

H-2-5229

H-2-5224

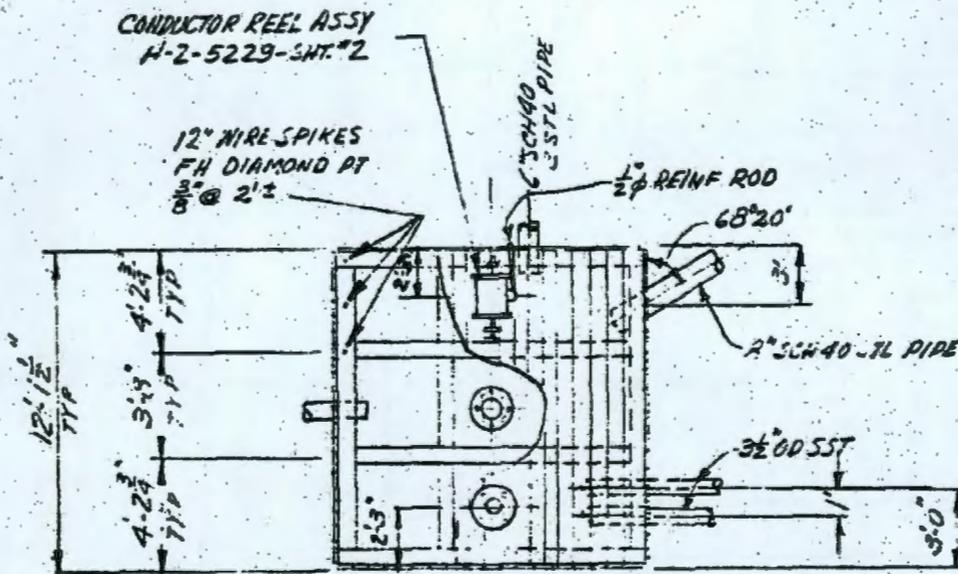




PLAN

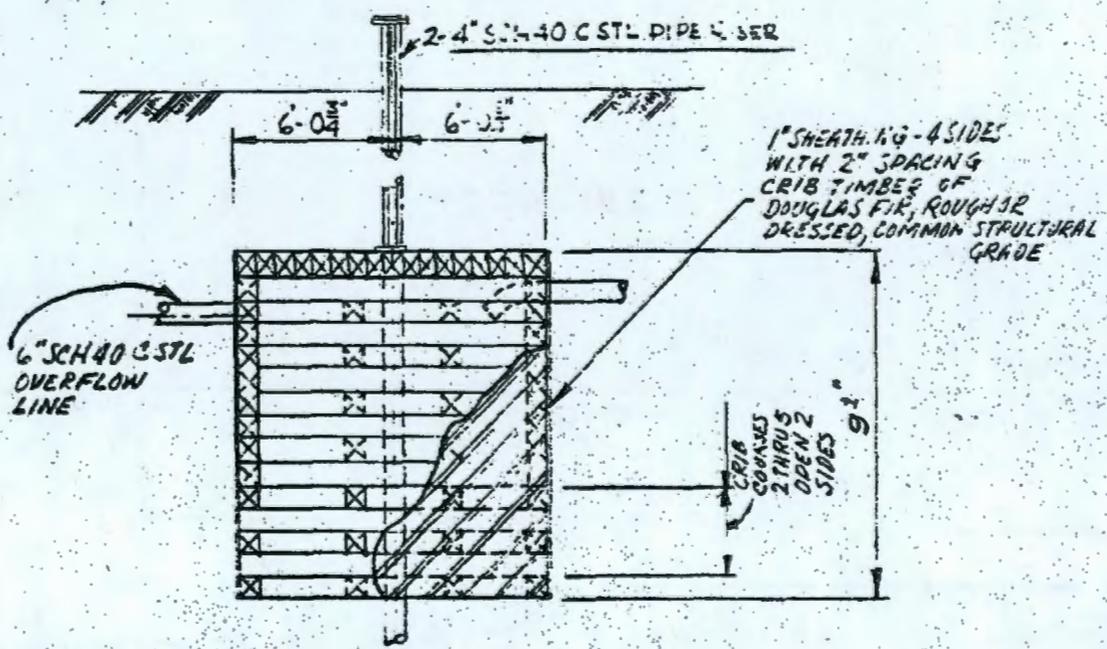

ELEVATION


TAKEN FROM H-2-5229

216-S-20

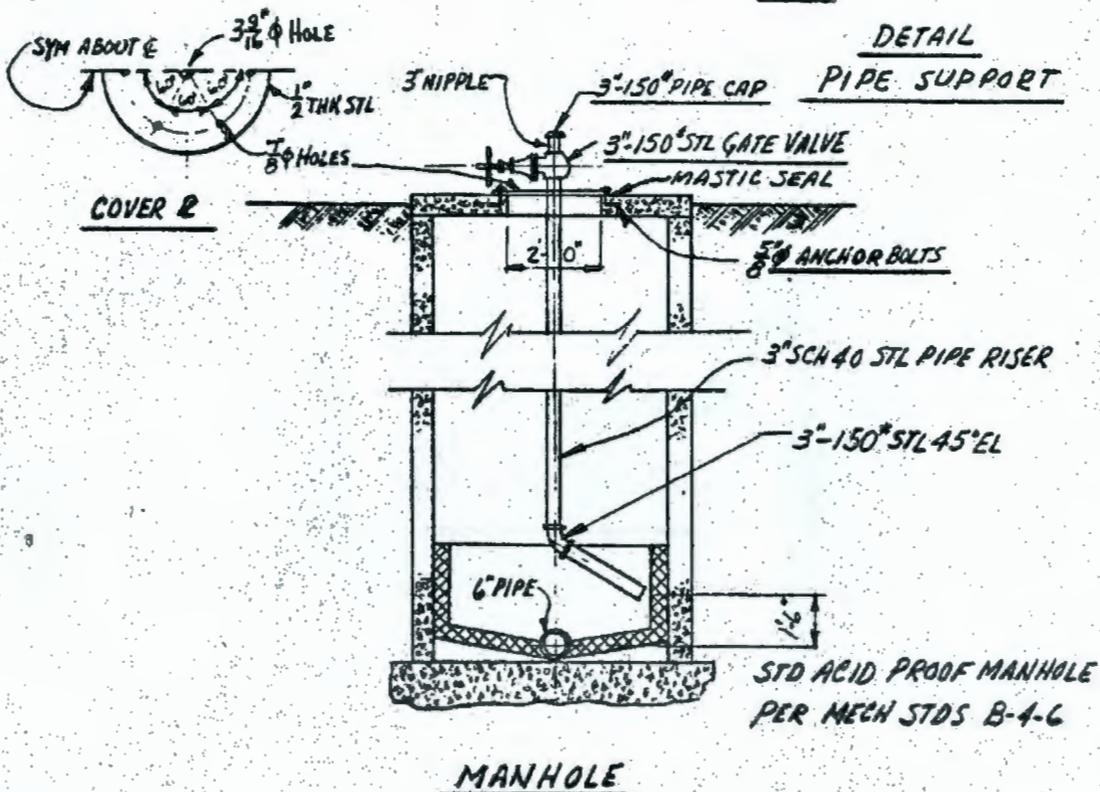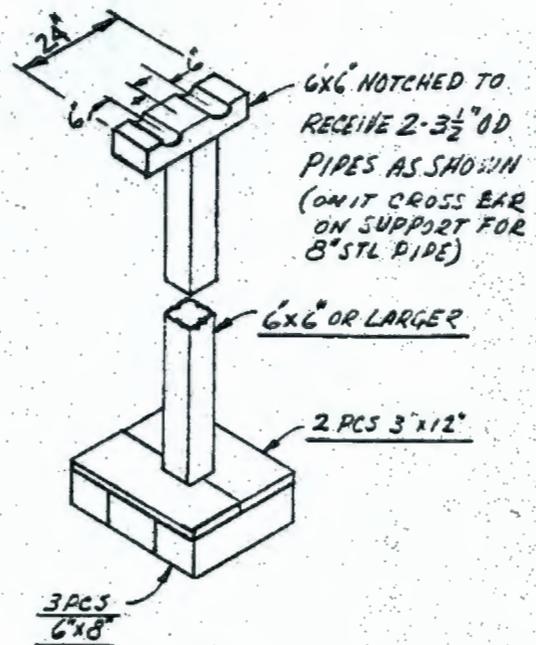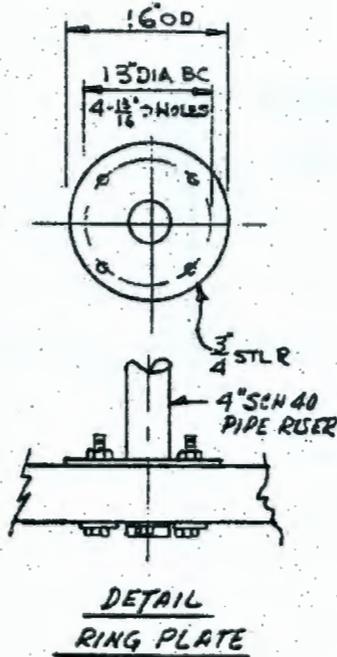

216-S-20


TAKEN FROM H-3-3224

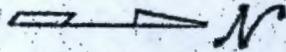

3

3



3

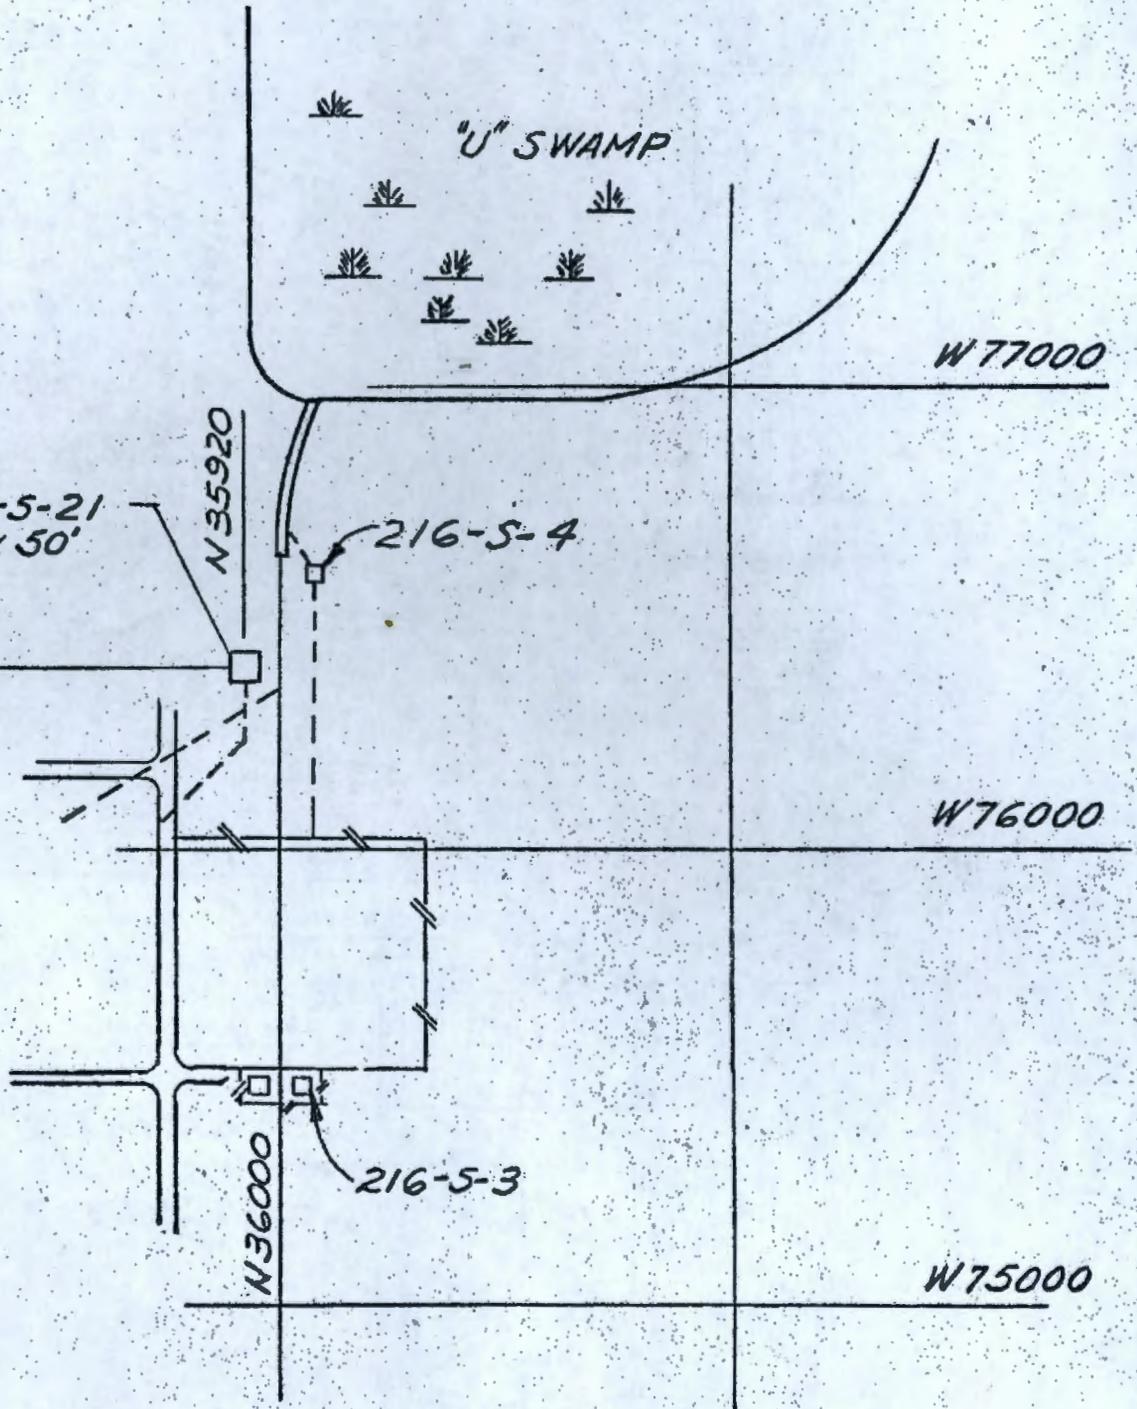


216-S-21
H-2-39579

27

28


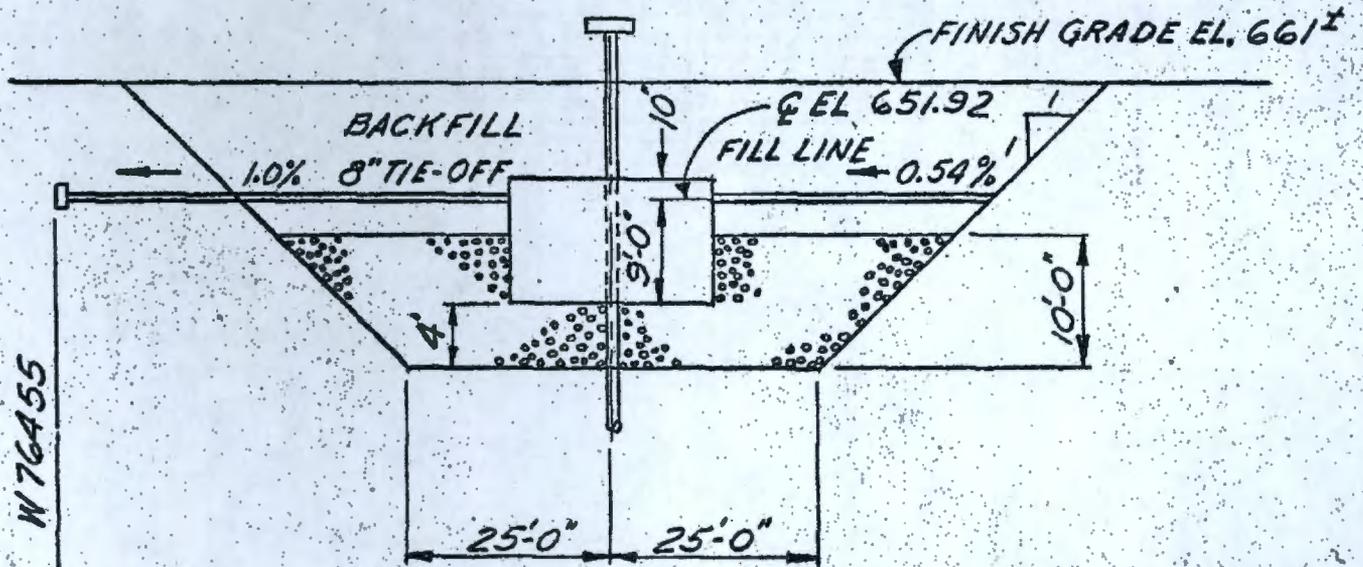
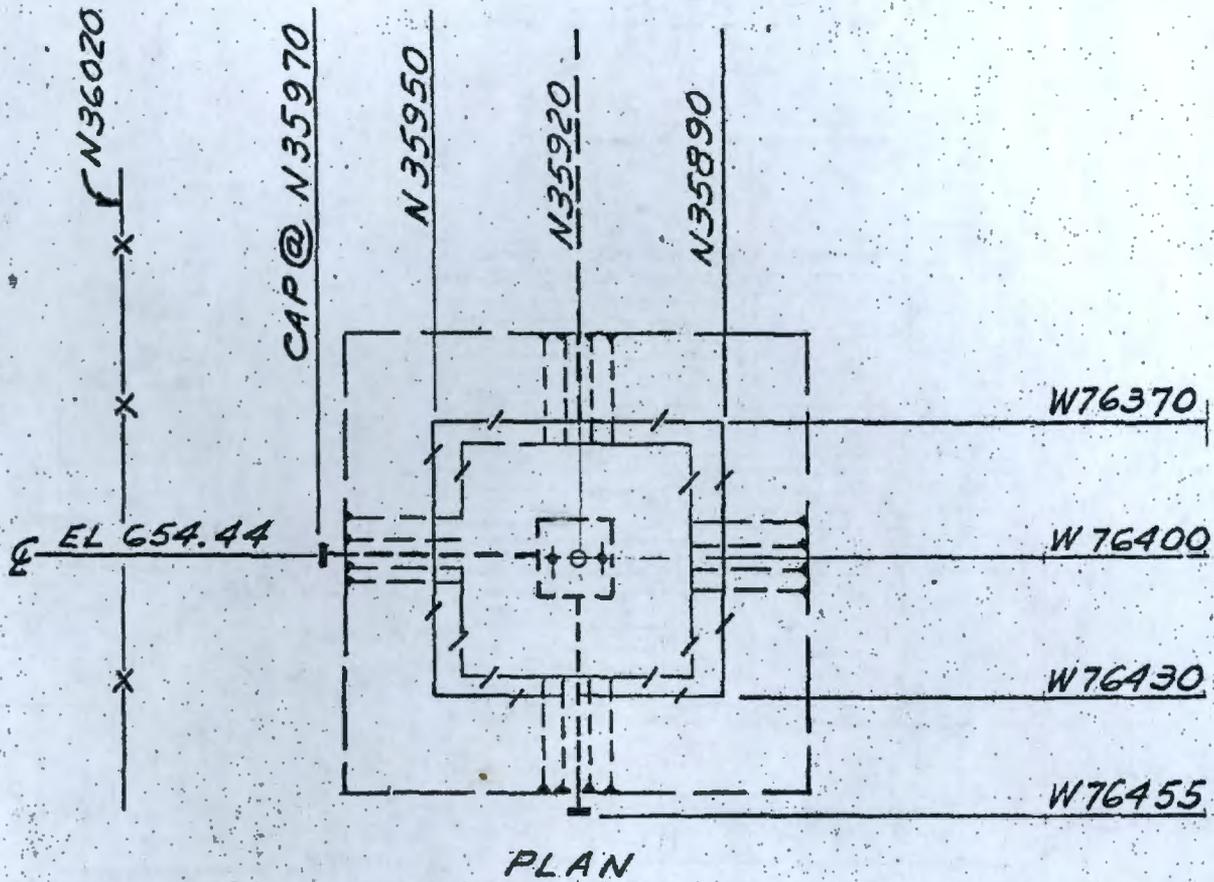


216-S-21
 H-2-39509
 SEE C-30a

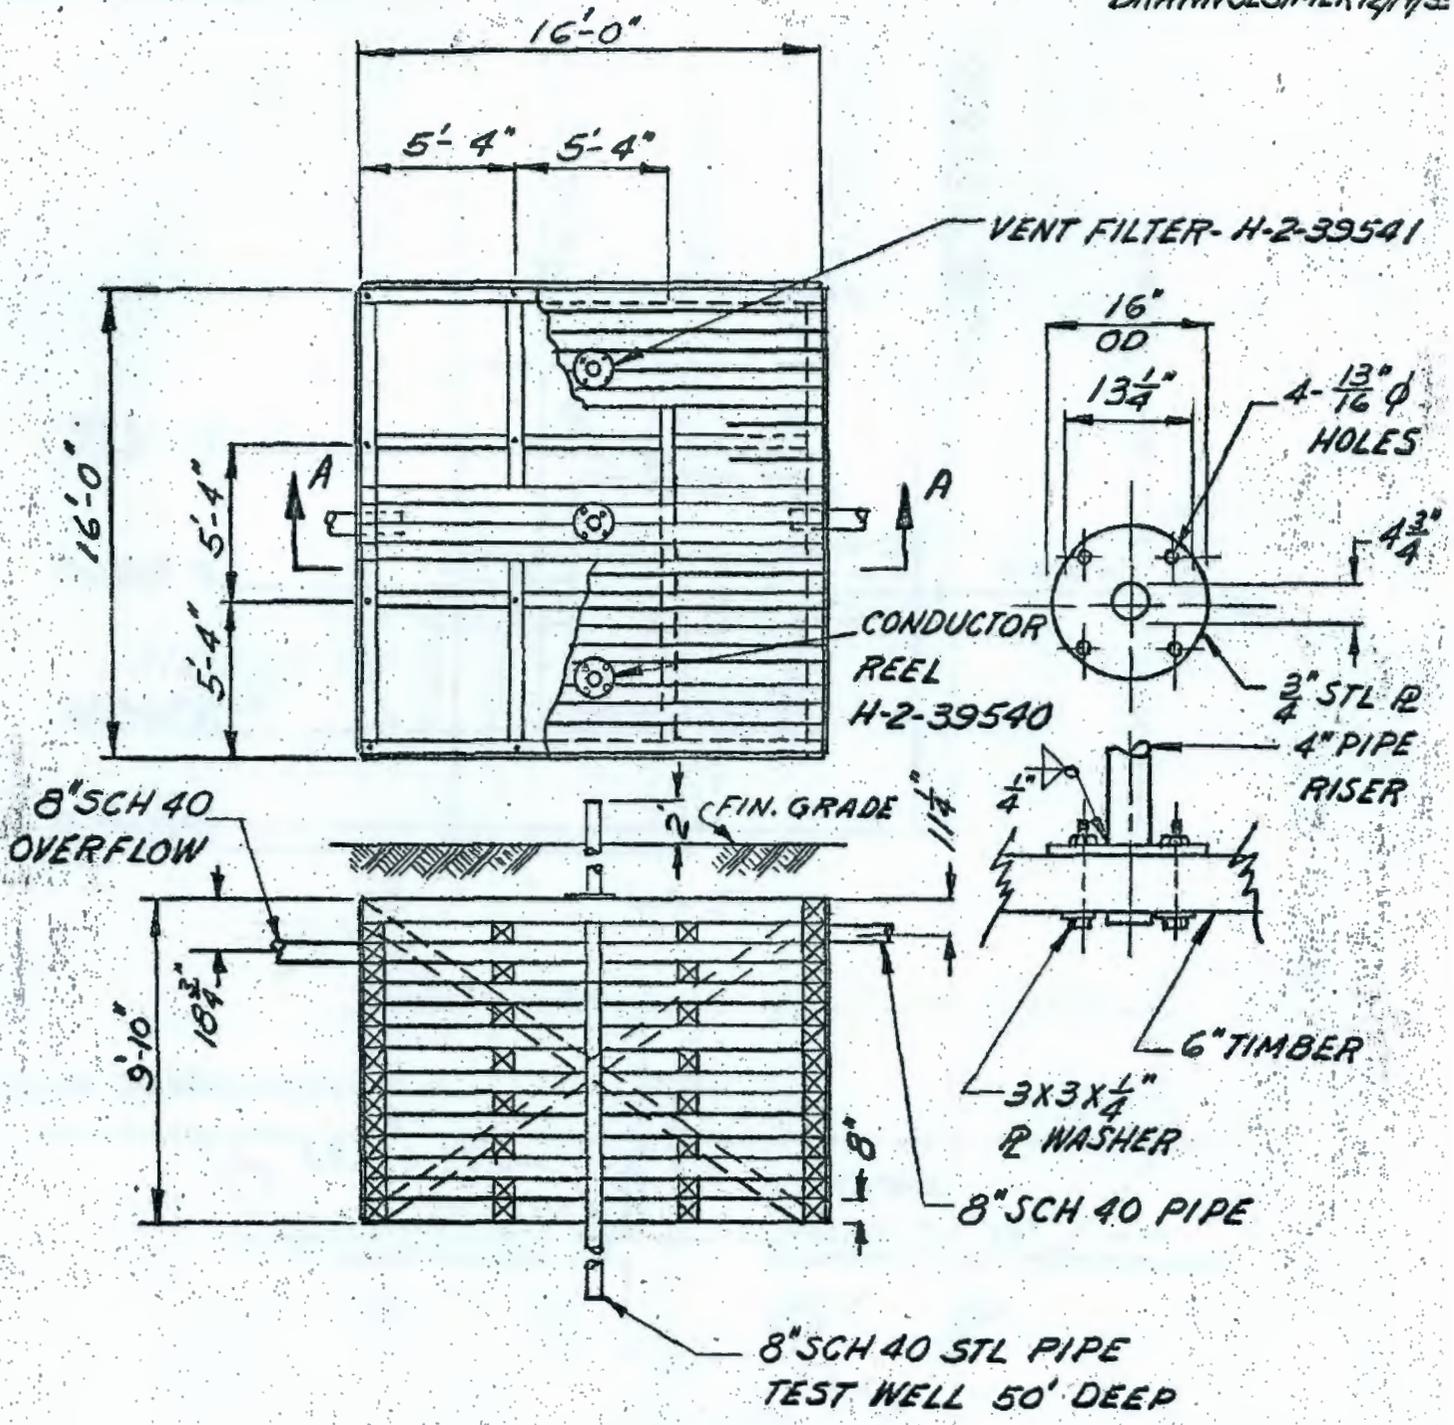


216-S-21
 H-2-39549

HW-55176 - PART III
APPENDIX C-31

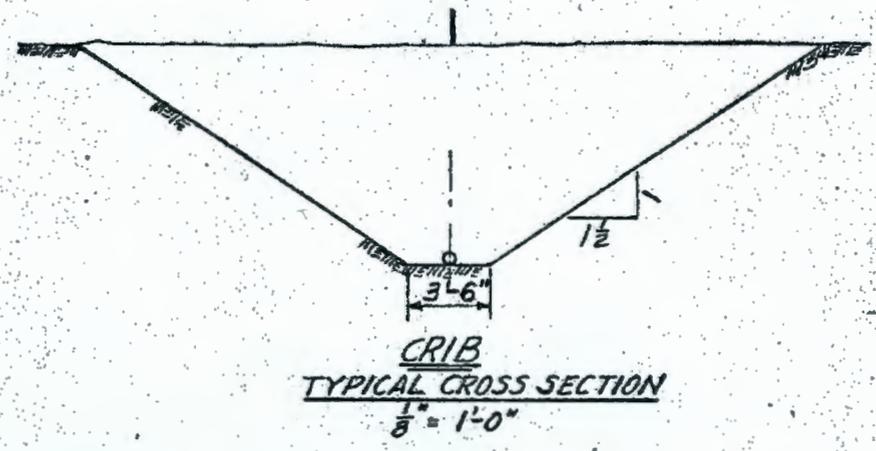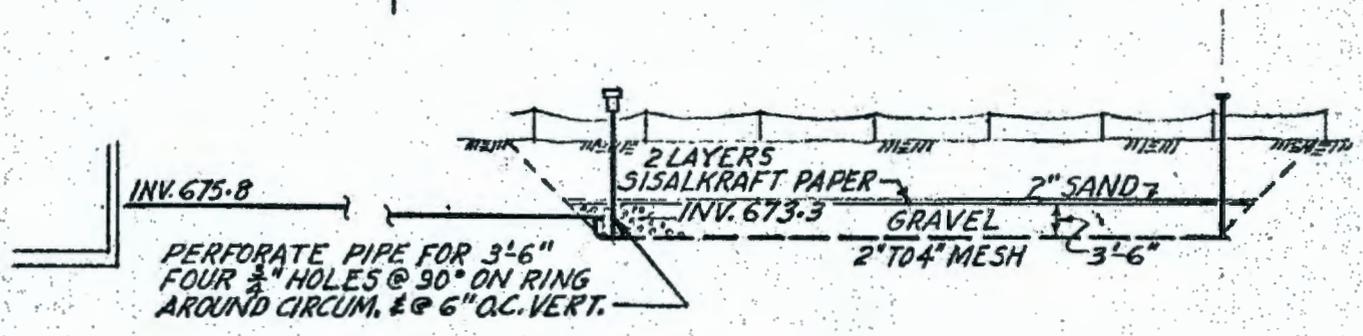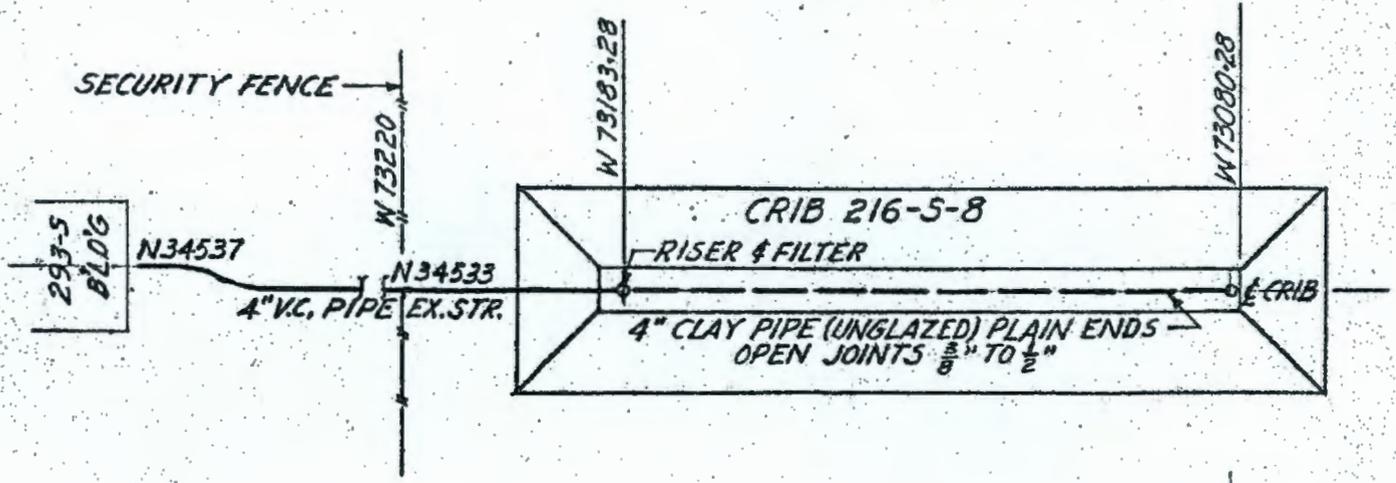

TAKEN FROM H-2-31047

216-S-22

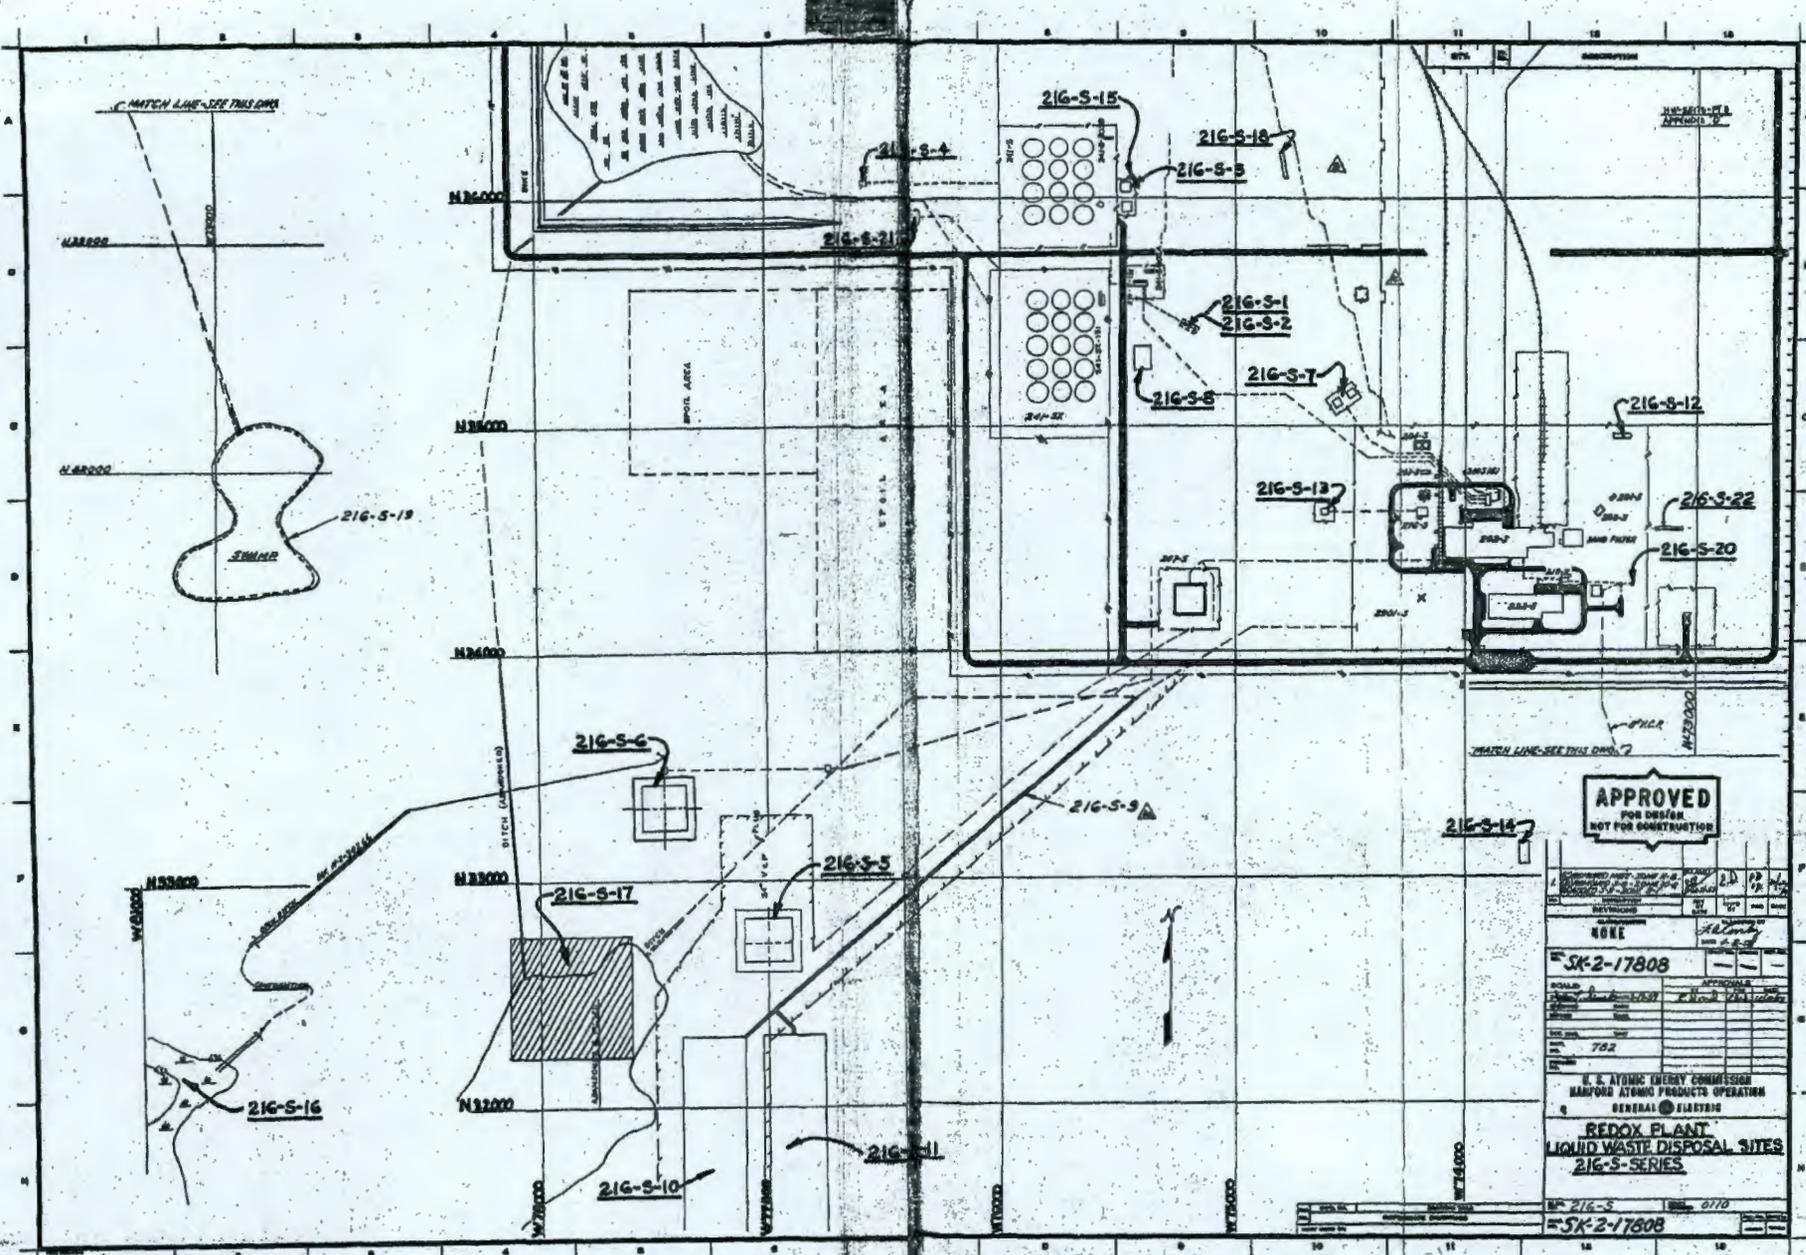

APPROVED
FOR DESIGN
NOT FOR CONSTRUCTION

DESIGNED BY	DATE	SCALE	PROJECT NO.
DRAWN BY	DATE	SCALE	PROJECT NO.
CHECKED BY	DATE	SCALE	PROJECT NO.
APPROVED BY	DATE	SCALE	PROJECT NO.
SK-2-17808			
U. S. ATOMIC ENERGY COMMISSION HARFORD ATOMIC PRODUCTS OPERATION GENERAL ELECTRIC			
REDOX PLANT LIQUID WASTE DISPOSAL SITES 216-S-SERIES			
SHEET NO. 216-S		TOTAL SHEETS 0110	
SK-2-17808			

LI PLANI

UNCLASSIFIED

HW-55176, Pt. IV
Page 1

INDEX OF CPD CRIB BUILDING NUMBERS
DESIGNS OF CPD RADIOACTIVE LIQUID WASTE
DISPOSAL SITES

Part IV of VII Parts
Process Technology - Study Report

by

V. W. Wood
Radiological Design and Development
Facilities Engineering Operation
CHEMICAL PROCESSING DEPARTMENT

April 29, 1958

D I S T R I B U T I O N

GR Bergdahl	TG LaFollette
JM Bernard	CE Linderoth
WG Browne	WN Mobley
E Doud	HE Parker
J Durbin	HF Peterson
JB Fecht	DW Pearce
DR Gustavson	OH Pilkey
CT Groswith	EL Reed
→ WA Haney	RA Roberts
JF Honstead	HP Shaw
IM Jacques	ML Short
EB Jackson	VW Wood
CE Kent	300 Files

UNCLASSIFIED

INDEX OF CPD CRIB BUILDING NUMBERS
DESIGNS OF CPD RADIOACTIVE LIQUID WASTE
DISPOSAL SITES

Part IV of VII Parts
Process Technology - Study Report

INTRODUCTION

During the fourteen years or more which the separations areas have operated, many sites have been used for the disposal of radioactive liquid wastes. Various methods have been used in assigning building numbers to these sites and, in a number of cases, changes have been made which have brought about some confusion. One of the reasons being some currently used building numbers do not agree with the numbers existing on design prints for the facilities. Reference (2) was an effort to establish a listing of the liquid waste disposal sites. It required considerable time and research to locate information concerning these sites.

Many varied designs have been used for the disposal of radioactive liquid wastes. Reverse wells, trenches, cribs or caverns, etc., have been used. Specific information on these facilities is often difficult to obtain for in some instances they were constructed on work orders with no records being retained on the design. In general, the design on each facility has been different. This has made it extremely difficult for people to have a good working knowledge of the various waste disposal sites.

PURPOSE

The purpose of this report (Part IV) is to provide a ready reference to the "U" Plant liquid waste disposal sites as well as a compilation of sketches showing the basic information on the design of each facility.

Another objective is to establish a simplified and uniform numbering system. Still another objective is to provide an up-to-date tabulation. Subsequent parts of this report will provide information on cribs for other areas.

SUMMARY AND CONCLUSIONS

All radioactive liquid waste disposal sites should have the 216 Building number designation. These should be further grouped by giving all such sites for Purex a prefix of 216-A. Other major series would be 216-S for Redox; 216-T for "T" Plant; 216-B for "B" Plant; 216-U for "U" Plant and 216-Z for "Z" Plant.

The numbering list in "Official Hanford Works Building List - Specification HW-5000" by Engineering Files - Construction Engineering Operation should be revised to more closely follow the above numbering system.

RECOMMENDATIONS

It is recommended that the following action be taken:

1. All groups and services referring to the "U" Area cribs or report data concerning them should use the index numbering system as presented in this report. In the case of U Plant this means several changes. See cross reference, page 4.
2. That all drawings concerning these disposal sites, including maps, be revised to show the proper locations and numbers for these cribs.
3. Any suggestions for improving the usefulness of this report should be referred to the author.

DISCUSSION

When all seven parts of the report are completed, and the work outlined in the report is completed, much confusion will be eliminated and more people will be better informed on the design of each waste disposal facility. The report will provide a firm basis for future building number assignments.

While some sincere efforts have been made to try and keep a methodical system for recording waste disposal sites, a number of problems have developed, for example, HW-5000, Sheet 29 of 50, lists only eight cribs in the 216-S series. Also reference 2 has assigned numbers which do not agree with the crib numbers assigned on many drawings.

As indicated earlier, the use of the crib index, as presented in this report should be very easy. In addition, information is presented which is very difficult to locate in the records and in some cases it is not available in the records.

REFERENCES

1. HW-5000, "Official Hanford Works Building List - Specification HW-5000" by Engineering Files - Construction Engineering Operation.
2. HW-43121. "Tabulation of Radioactive Liquid Waste Disposal Facilities by HV Clukey dated May 10, 1956.
3. HW-33305, "Tabulation of Radioactive Liquid Waste Disposal Facilities" by HV Clukey dated October 8, 1954.
4. HW-41535, "Uncoffined Underground Radioactive Waste and Contamination in the 200 Areas" by KR Heid dated January 17, 1956.

CROSS REFERENCE
"U" AREA RADIOACTIVE LIQUID WASTE
DISPOSAL SITES

<u>Suggested Crib No.</u>	<u>Number Listed in HW-5000</u>	<u>Number Listed in HW-43121</u>	<u>Number Used On Drawings or Original Number</u>	<u>Remarks</u>
216-U-1	216-U-1	216-U-3	216-U-1	361-WR
216-U-2	216-U-2	216-U-2 216-U-3	216-U-2	
216-U-3	None	216-U-11	216-U-3	
216-U-4	None	216-U-2	222-U-10	Reverse Well
216-U-5	None	216-U-4	221-U-#2	Grave
216-U-6	None	216-U-5	221-U-#1	Grave
216-U-7	None	216-U-7	None	French Drain
216-U-8	216-WR 1&2	216-U-9	216-WR-1,2,3	
216-U-9	None	216-U-6	None	Ditch Abandoned
216-U-10	None	216-U-1	None	U Swamp
216-U-11	None	216-U-12	None	Ditch
	None	216-U-10	216-T-17	Changed to T Series See Part V

APPENDIXA. Explanation of Parts to the Report

Part I will cover the Purex Radioactive Liquid Waste Disposal Sites.

Part II will cover the "Z" Plant Radioactive Liquid Waste Disposal Sites.

Part III will cover the Redox Plant Radioactive Liquid Waste Disposal Sites.

Part IV will cover the "U" Plant Radioactive Liquid Waste Disposal Sites.

Part V will cover the "T" Plant Radioactive Liquid Waste Disposal Sites.

Part VI will cover the "B" Plant Radioactive Liquid Waste Disposal Sites.

Part VII will cover the "C" Plant, Hot Semi-Works, the 200 North Areas and miscellaneous.

UNCLASSIFIED

HW-55176, Pt. IV
Page 5

- B. Index for "U" Plant Radioactive Liquid Waste Disposal Sites.
- C. Sketches of "U" Plant Waste Disposal Facilities.
- D. Map of "U" Plant Sites. (SK-2-17815).

UNCLASSIFIED



UNCLASSIFIED

HW-55176 PT IV
Appendix B
Revised 10/19/59


CRIB INDEX

U Plant


<u>Number</u>	<u>Description Appendix Sheet</u>	<u>Service</u>	<u>Use Date</u>		<u>Status</u>
			<u>From</u>	<u>To</u>	
216-U-1	C-1	224-U Wastes	3/52	-	Abandoned
216-U-2	C-1	Overflow from U-1	3/52	-	Abandoned
216-U-3	C-2	241-U TK 110 Condensate	5/54	1959	Abandoned
216-U-4	C-3 & 4	222 U Waste	3/47	1959	Abandoned
216-U-5	C-5	Startup Wastes		1952	Abandoned
216-U-6	C-5	Startup Wastes		1952	Abandoned
216-U-7	C-6	Blower Pit Drain	6/53	-	Inactive
216-U-8	C-7 & 8	Process Condensate & Stack Drain	6/52	-	Active
216-U-9	C-9	Cooling Water & Chemical	3/52	3/54	Abandoned
216-U-10	C-10	Cooling Water & Chemical	3/52	-	Active
216-U-11	C-11 & 12	Overflow from U-10	3/52	-	Active
216-U-12	C-13	Process Condensate & Stack Drain	Not used		Replacement for U-8
216-U-13	None	241-UR Steam Cleaning Pit	1952	-	Inactive
216-U-14	None	Laundry Bldg. Ditch to U Swamp	1953	-	Active

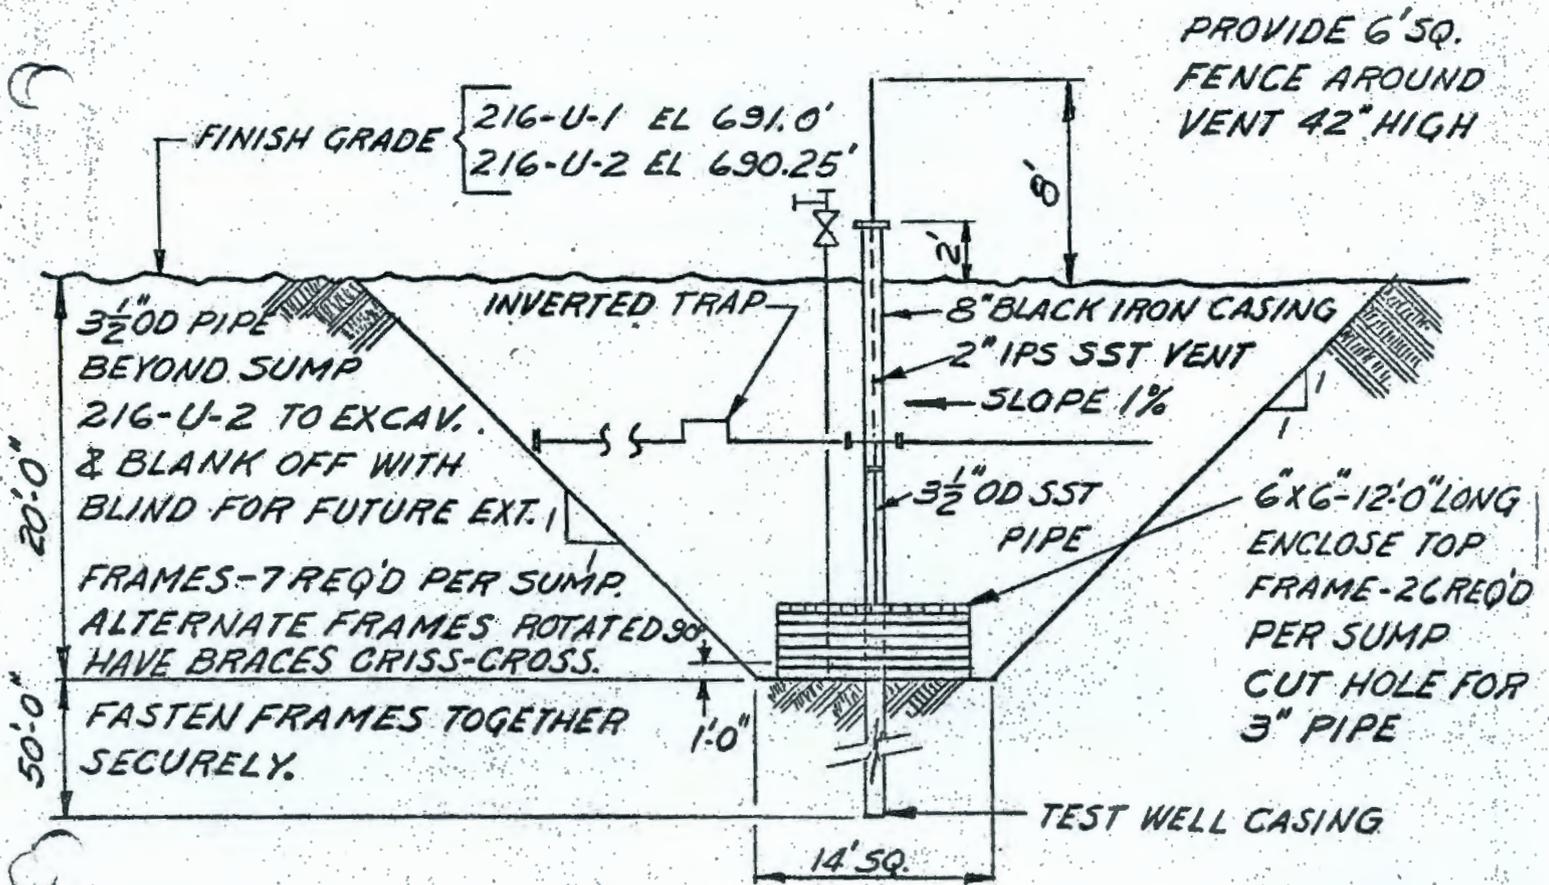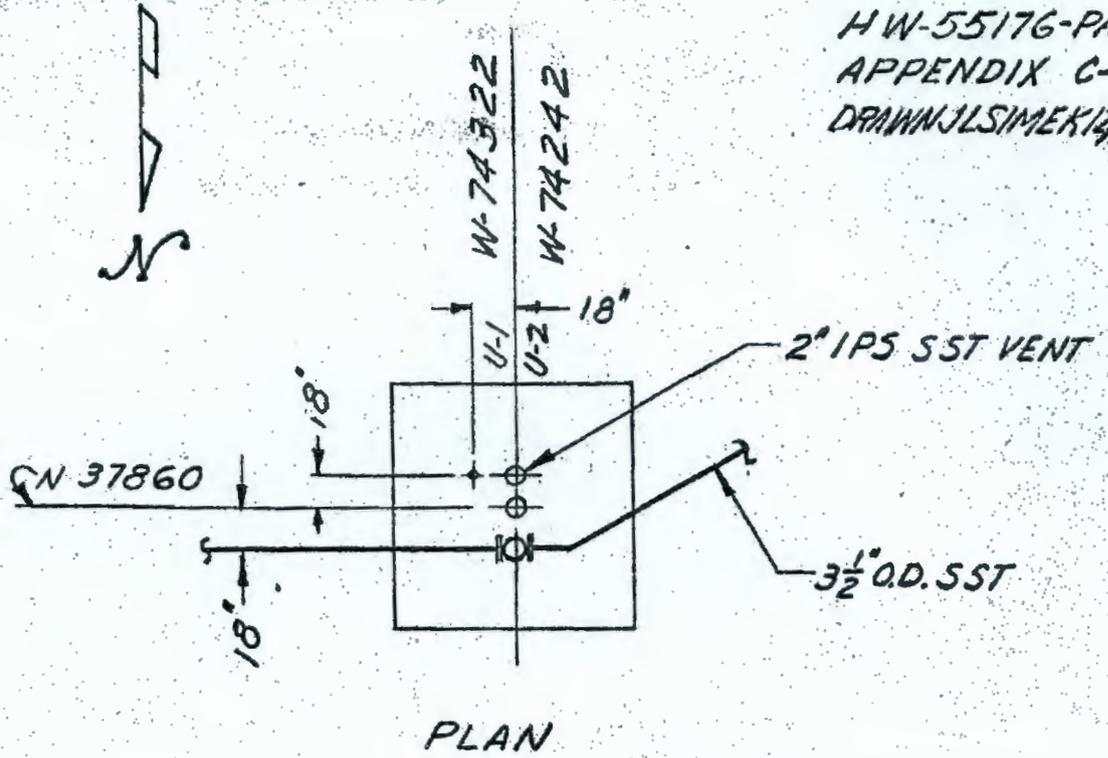


216-U-1
216-U-2

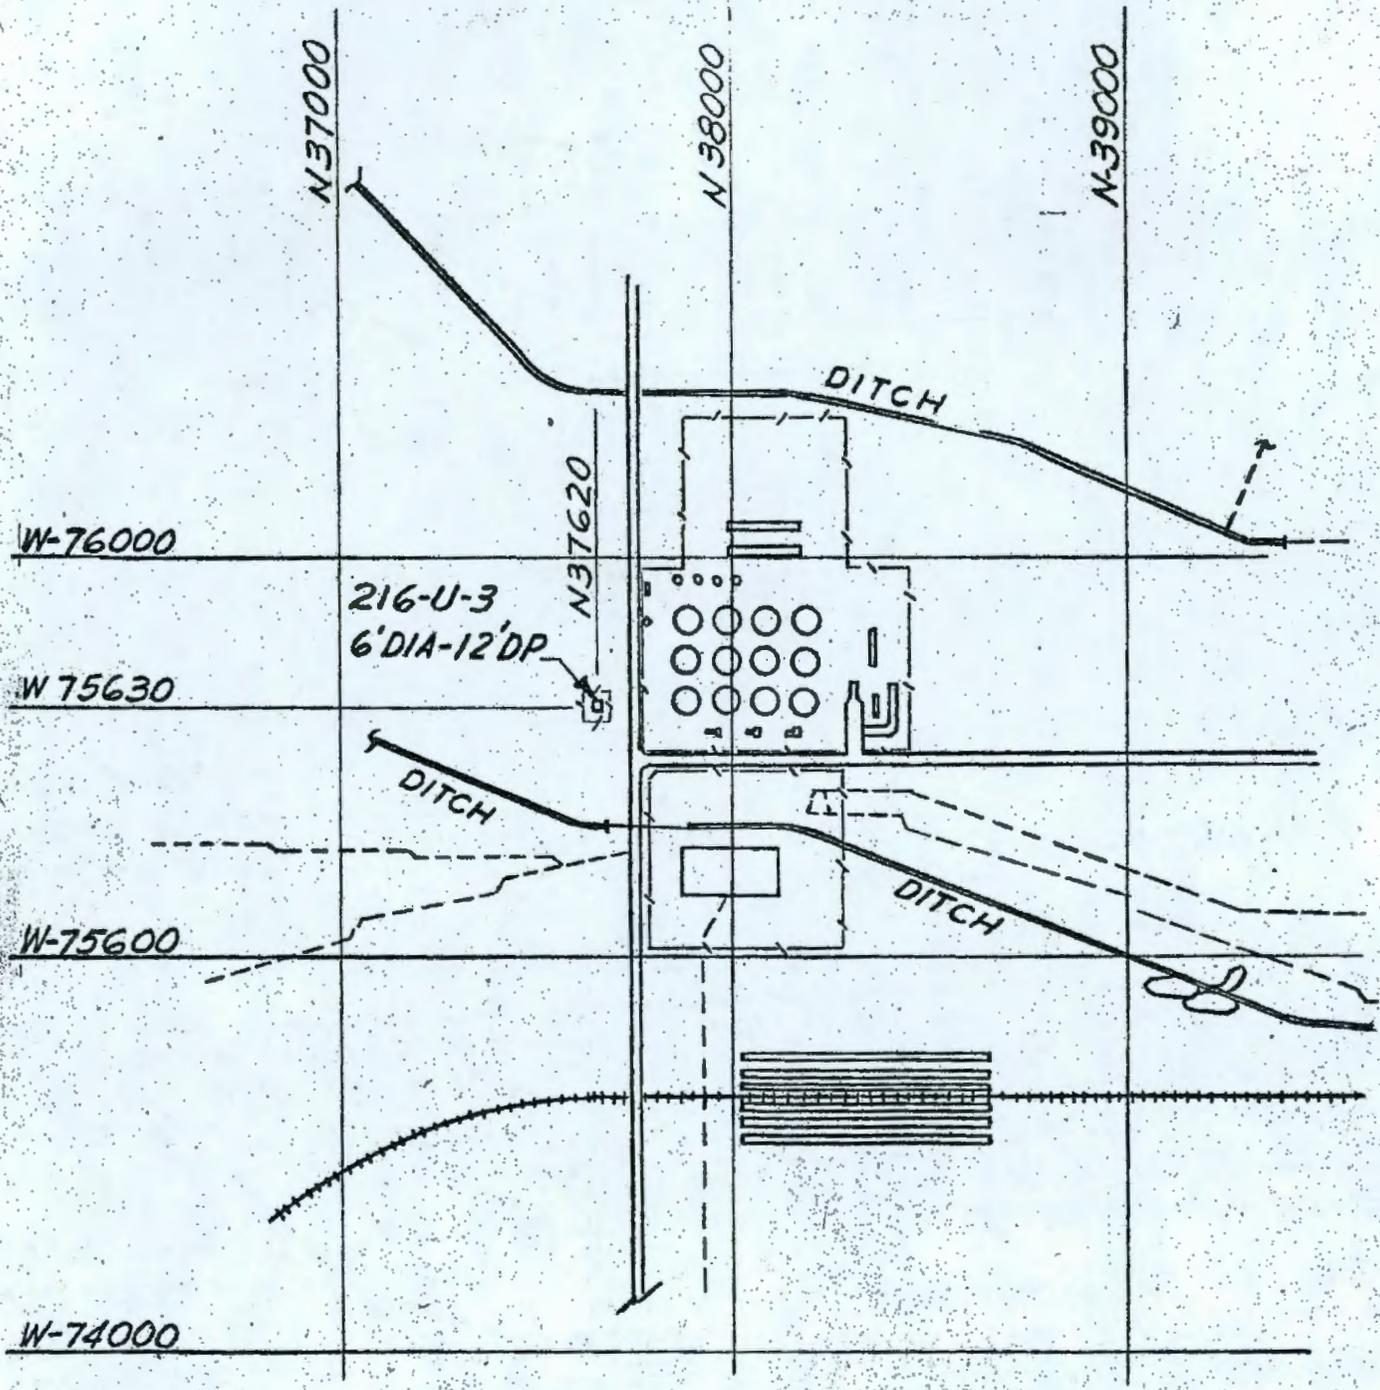

216-U-3
H-2-44004

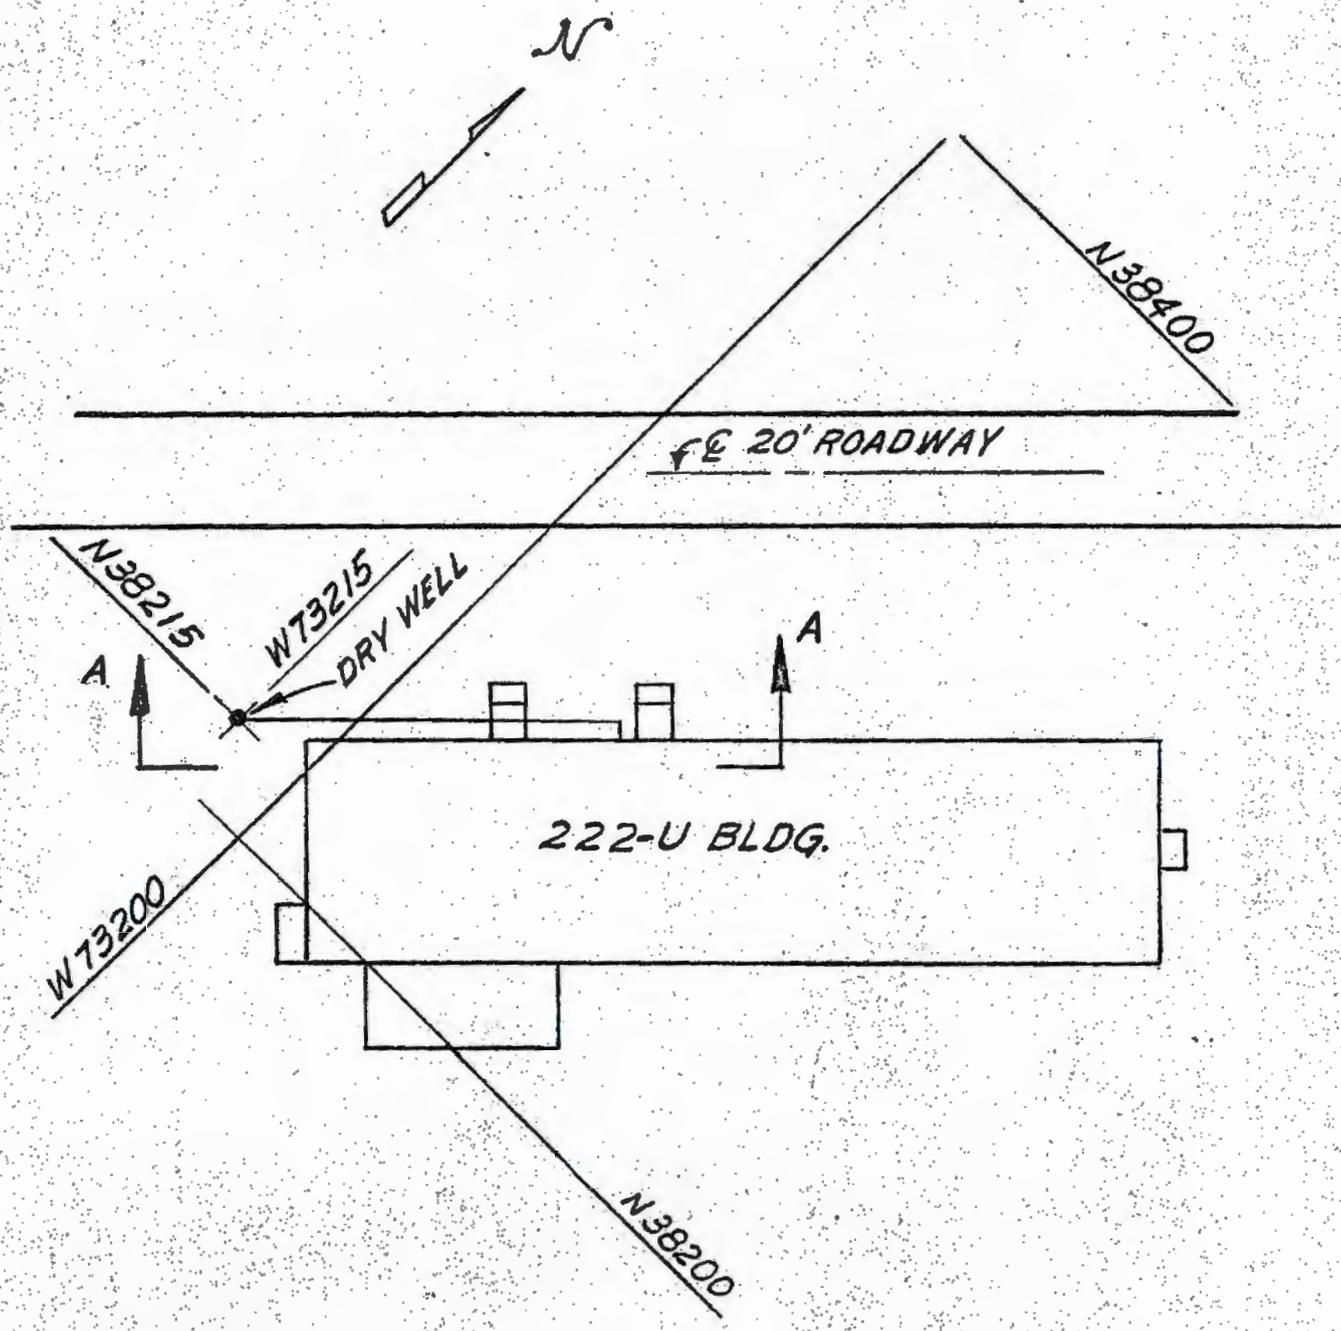


216-U-4
H-2-43081
HW-69870-SHT 2
SEE C-1

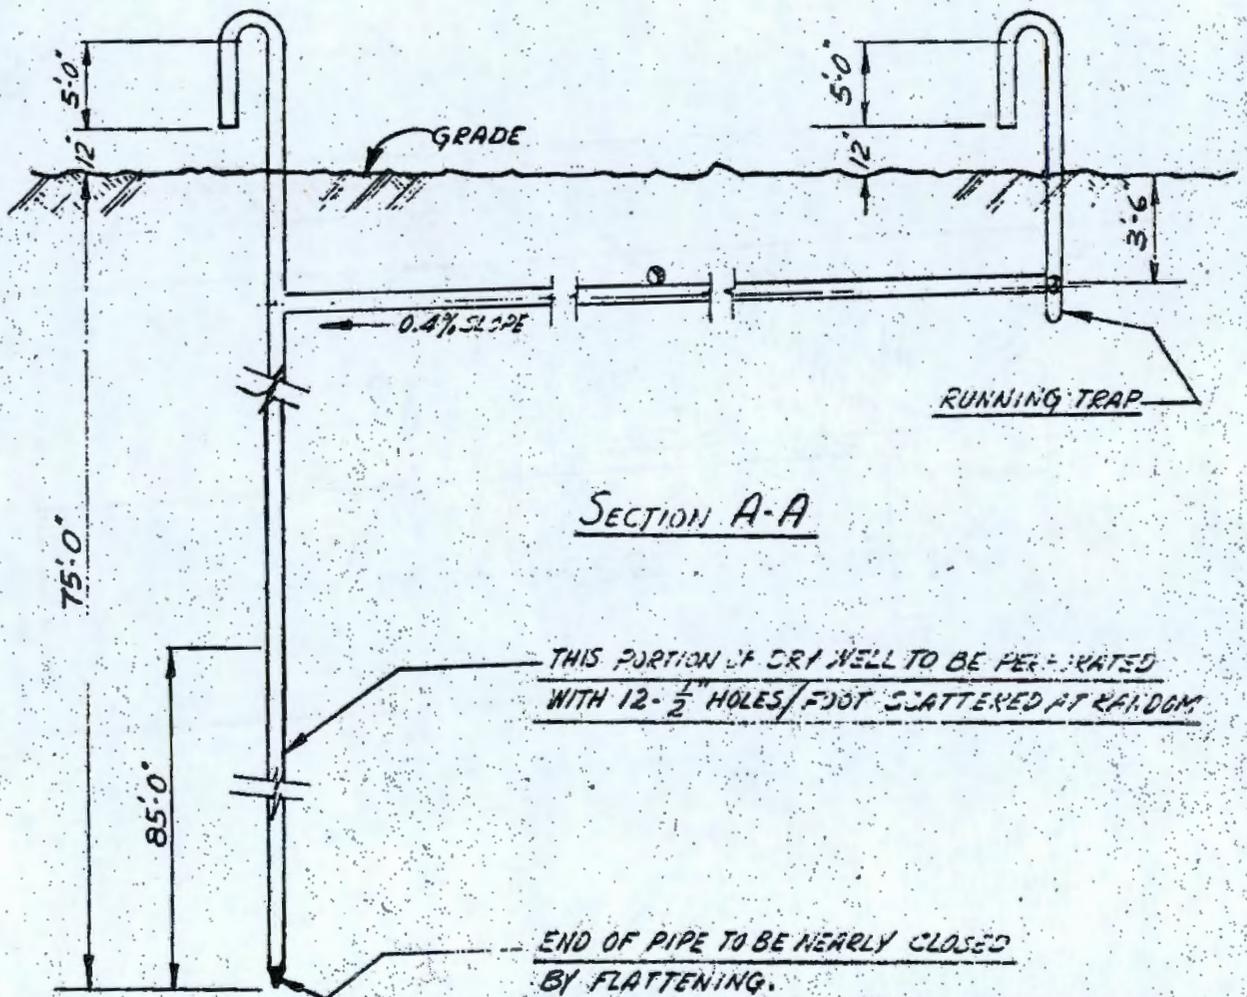

TAKEN FROM
H-2-43081
HW 69877 SH-2

216-U-4

HW-55176 PART IV
APPENDIX C-5

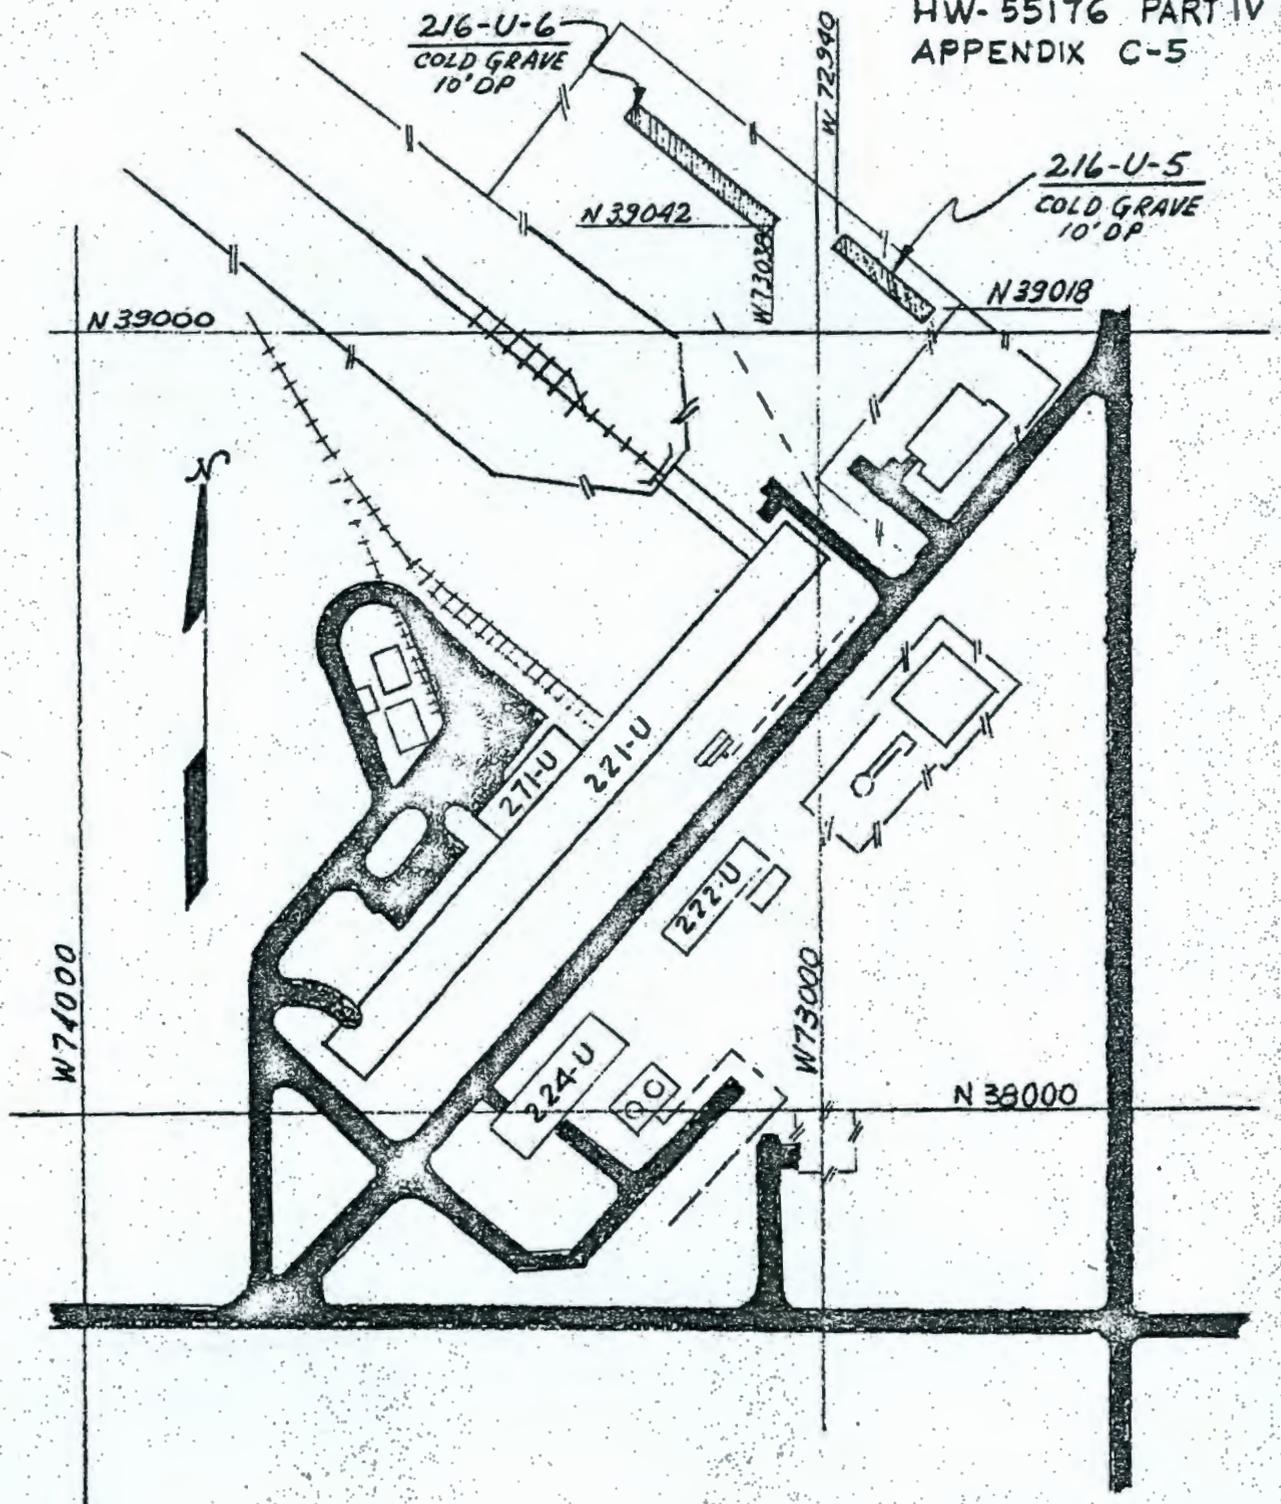

216-U-5
216-U-6

TAKEN FROM M 2600V/S 19



W 74000

W 73035

W 73000

N 39000

N 38480

FRENCH DRAIN

271-U
221-U



222-U

224-U

N 38000


216-U-7
H-2-43039

7

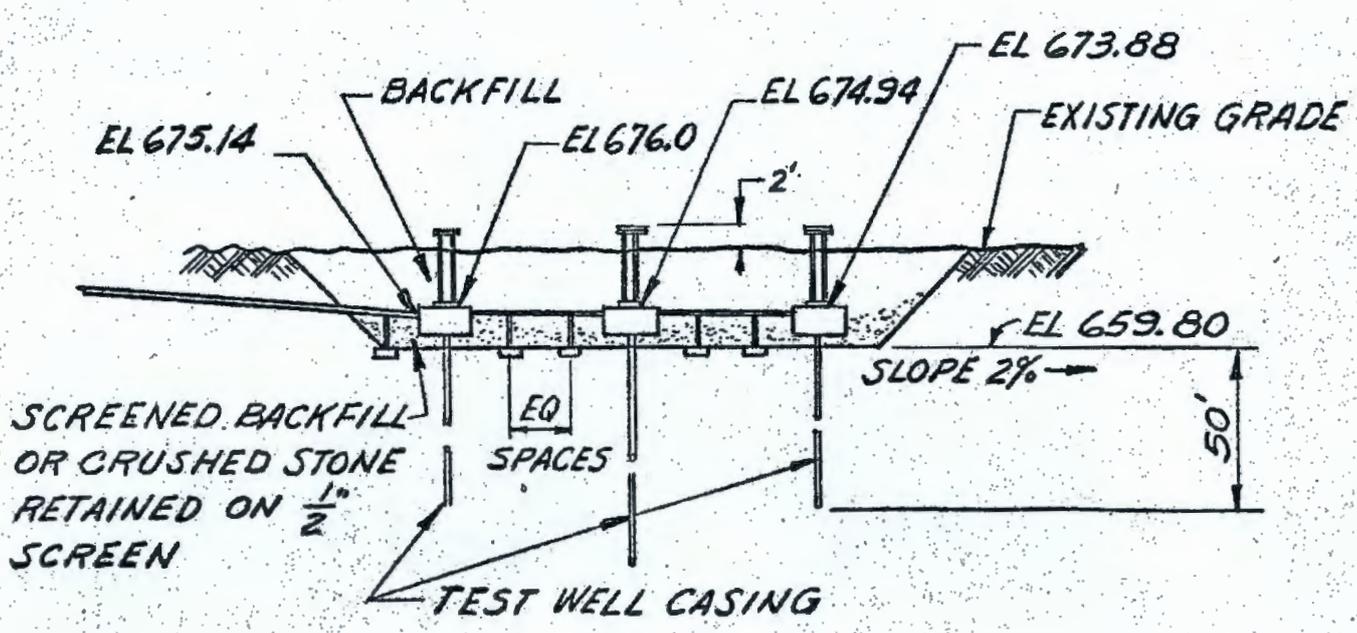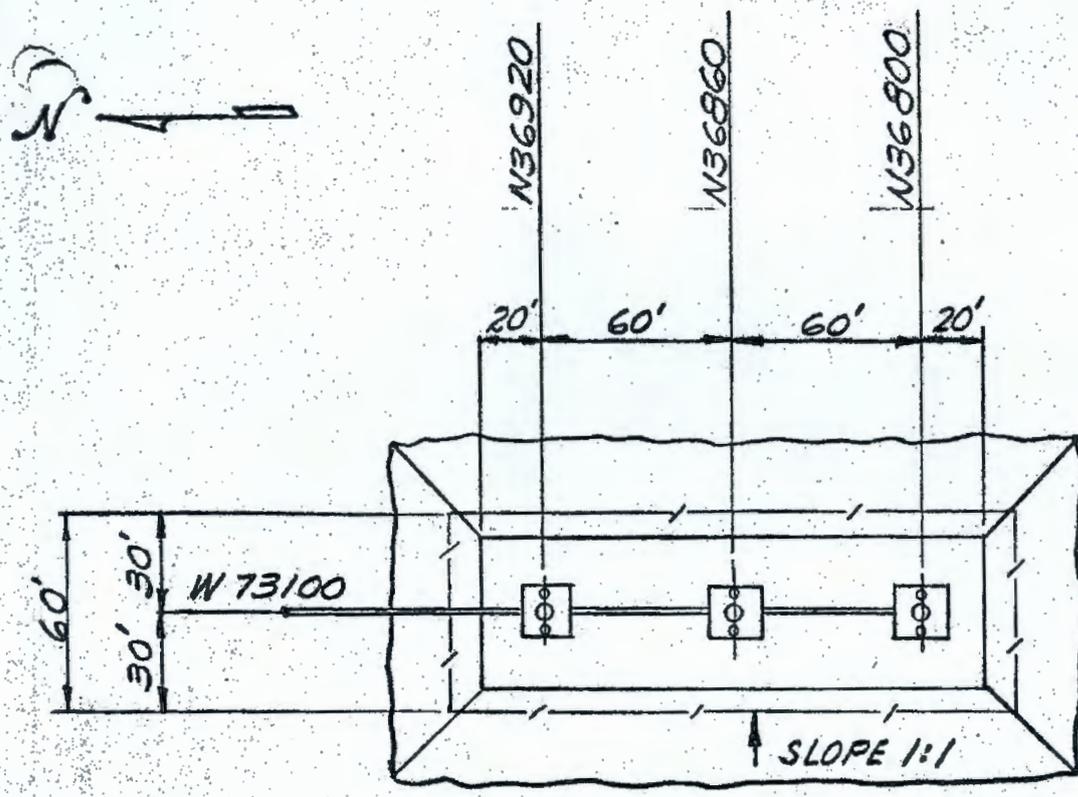


216-U-8
H-2-43028

HW-55176 PART IV
APPENDIX C-8

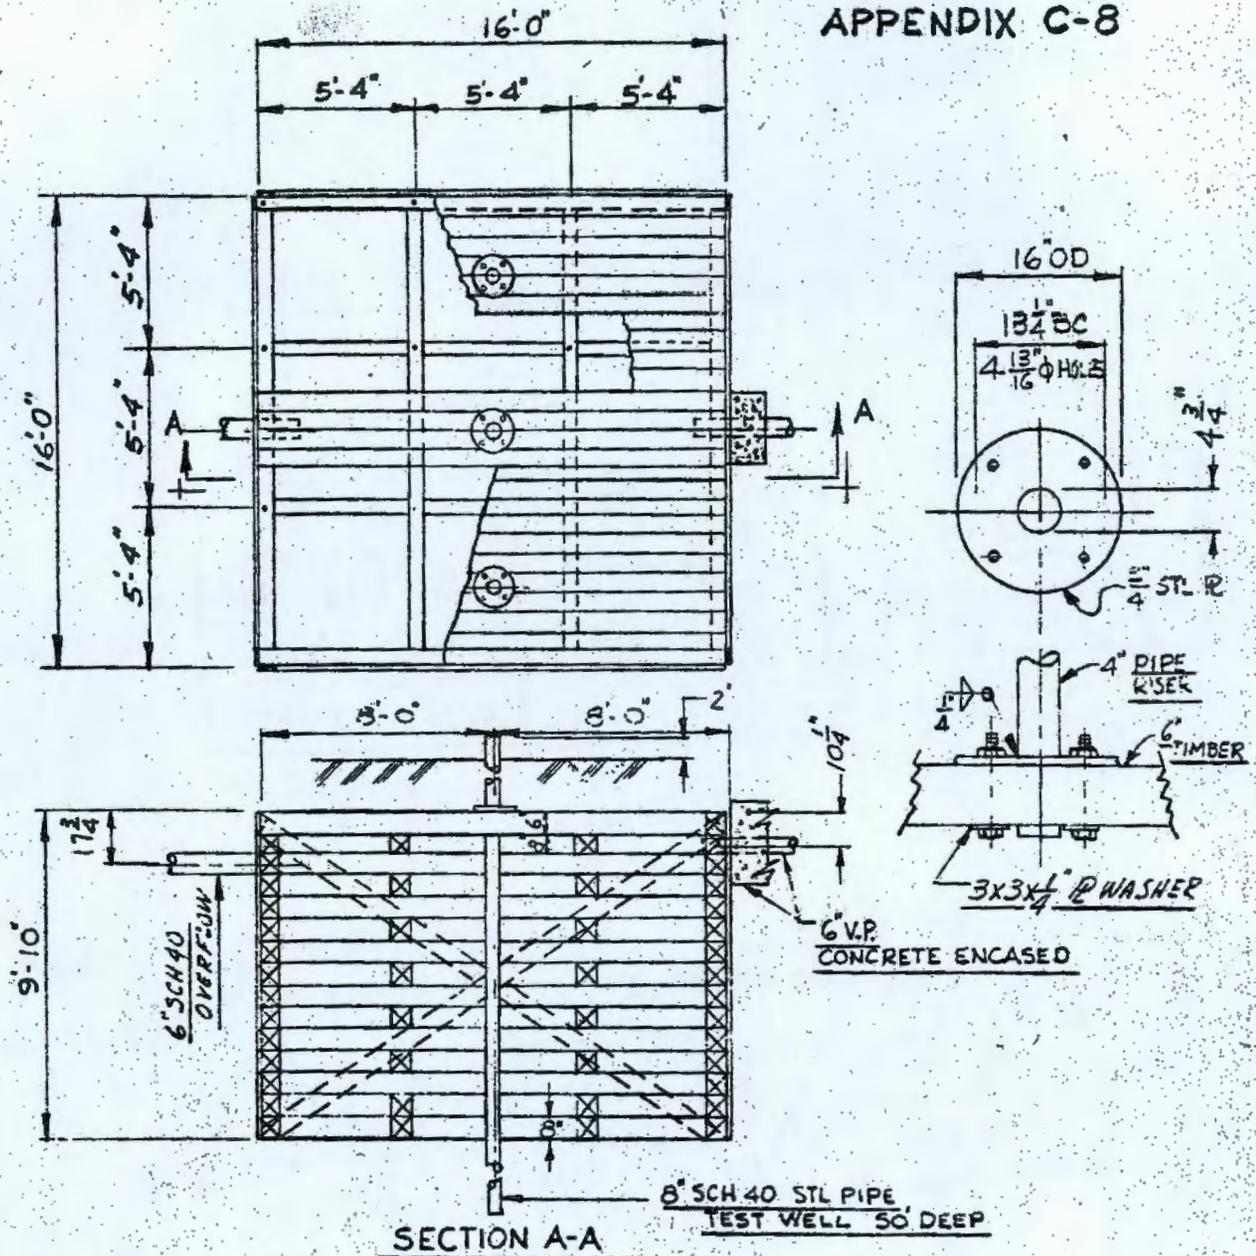


TAKEN FROM H-2-43027


216-U-8

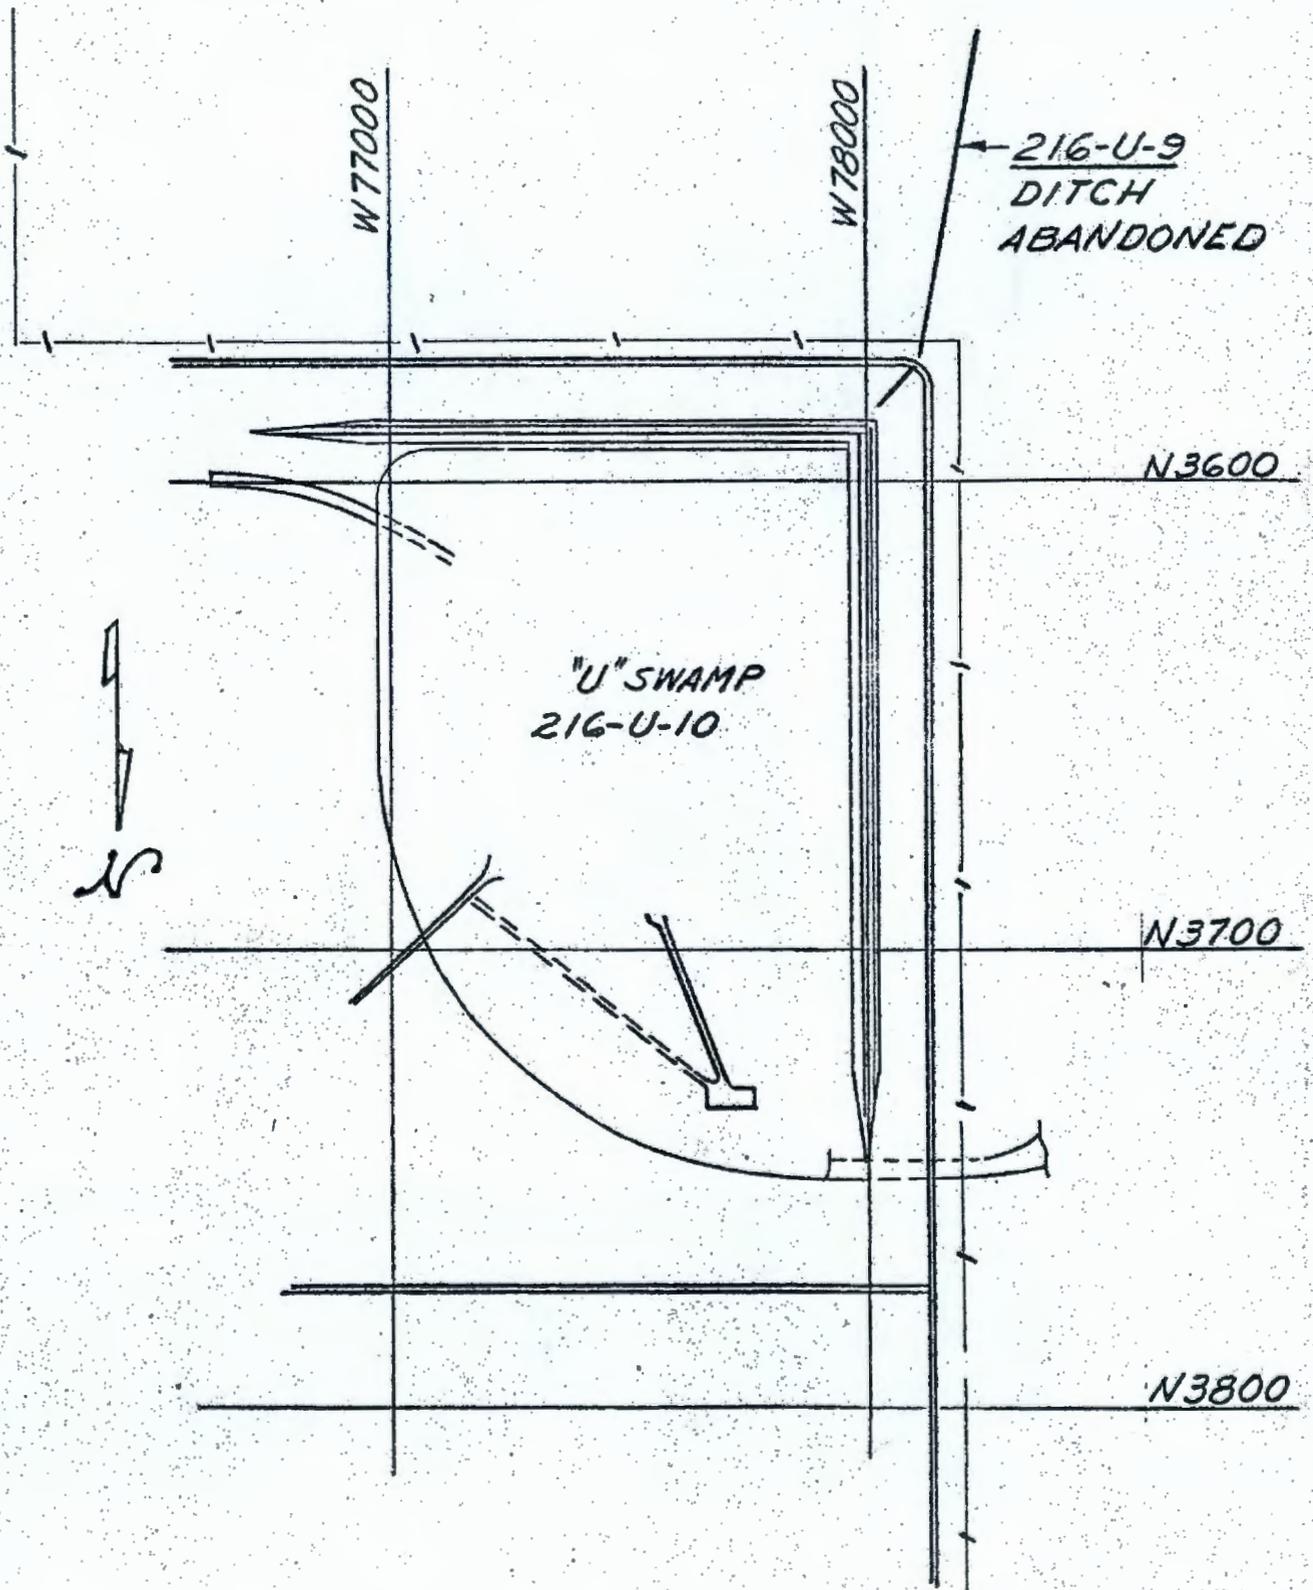

216-U-9-DITCH
H-2-2430

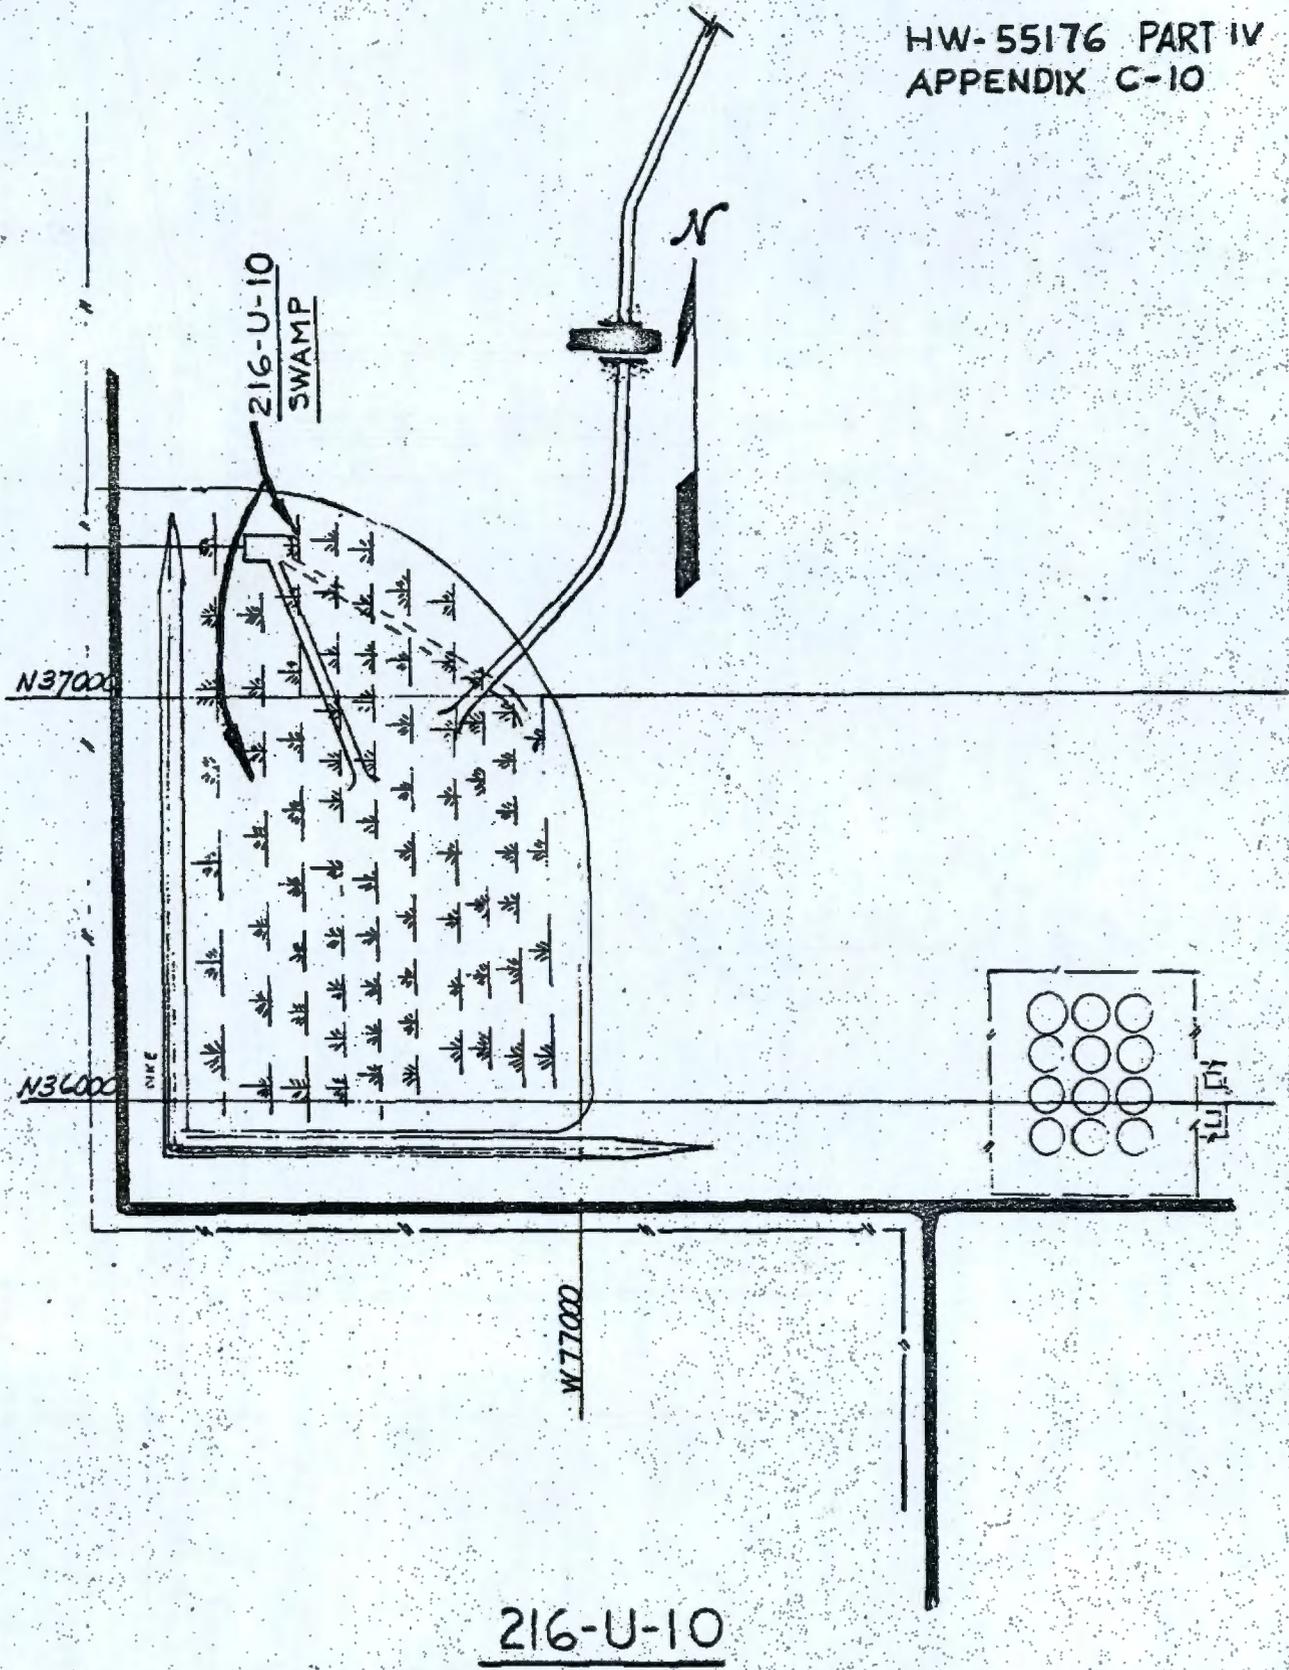


216-U-10

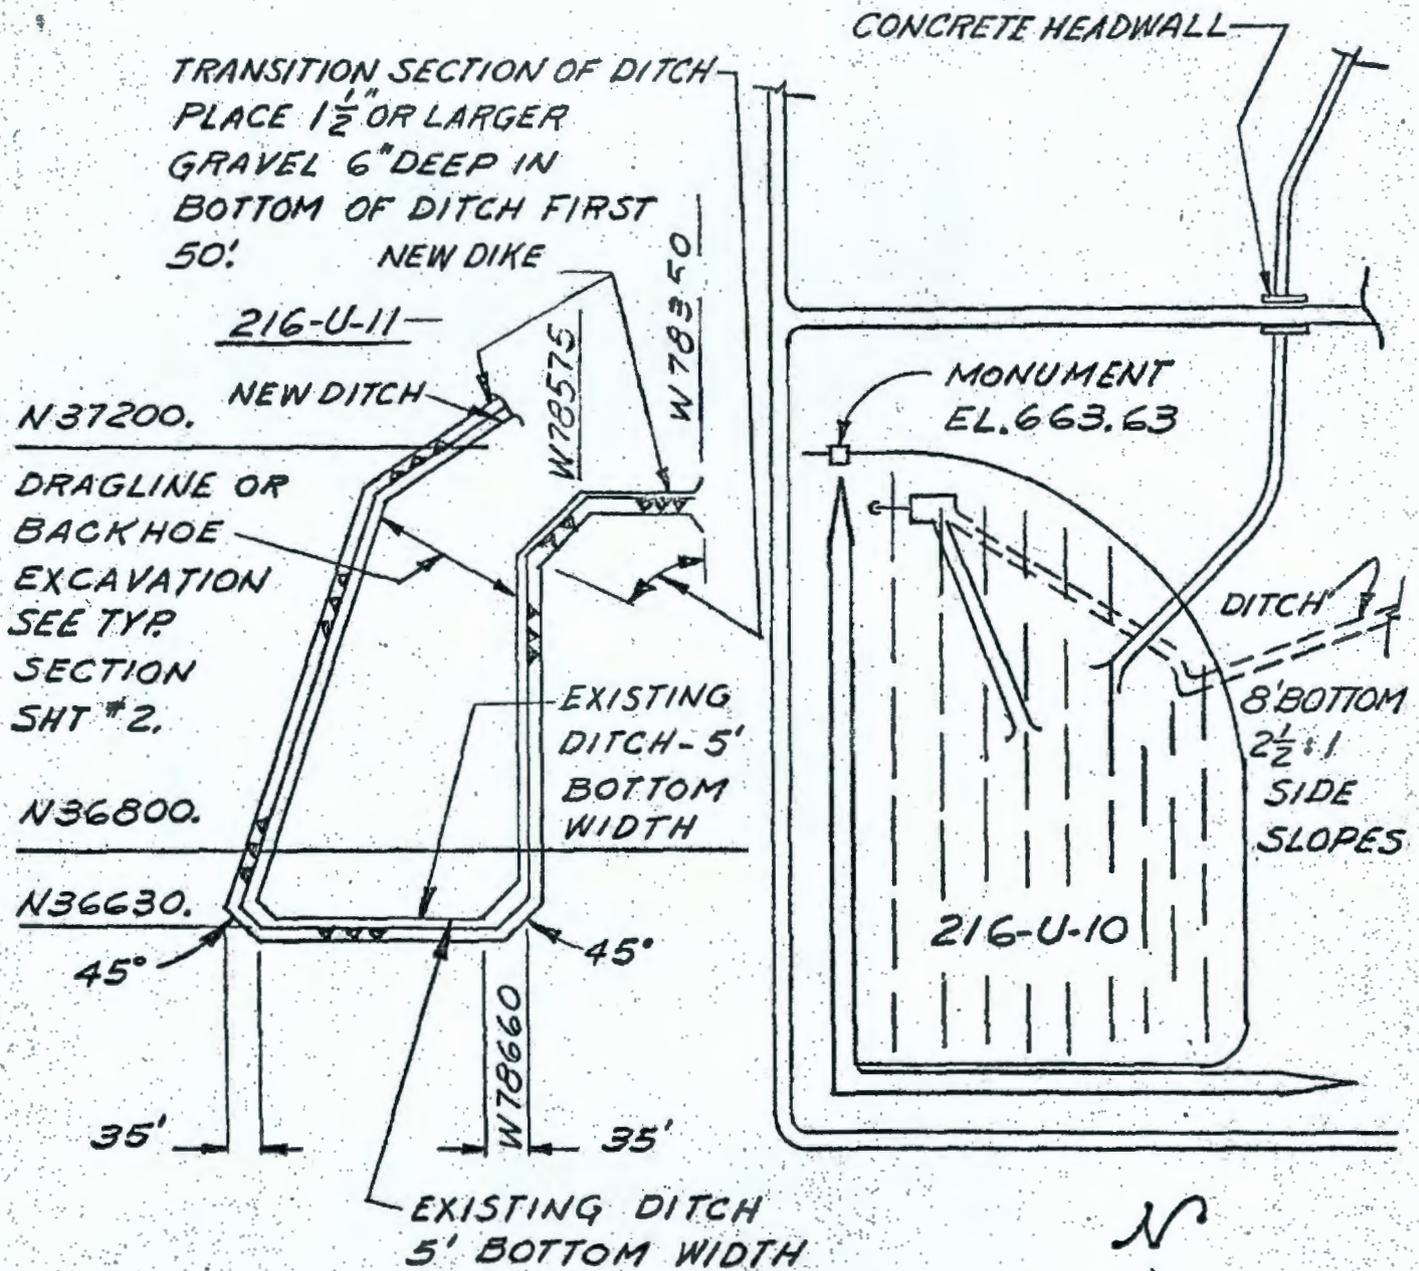


216-U-11
 SK-2-1888

JL 10-12-59

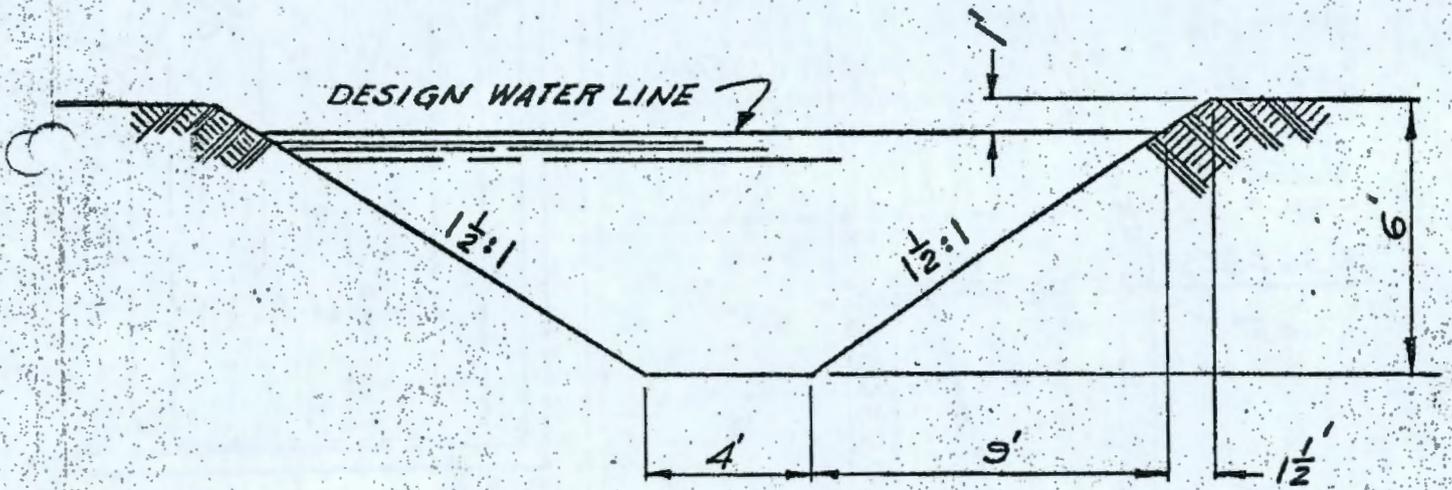


TYPICAL SECTION

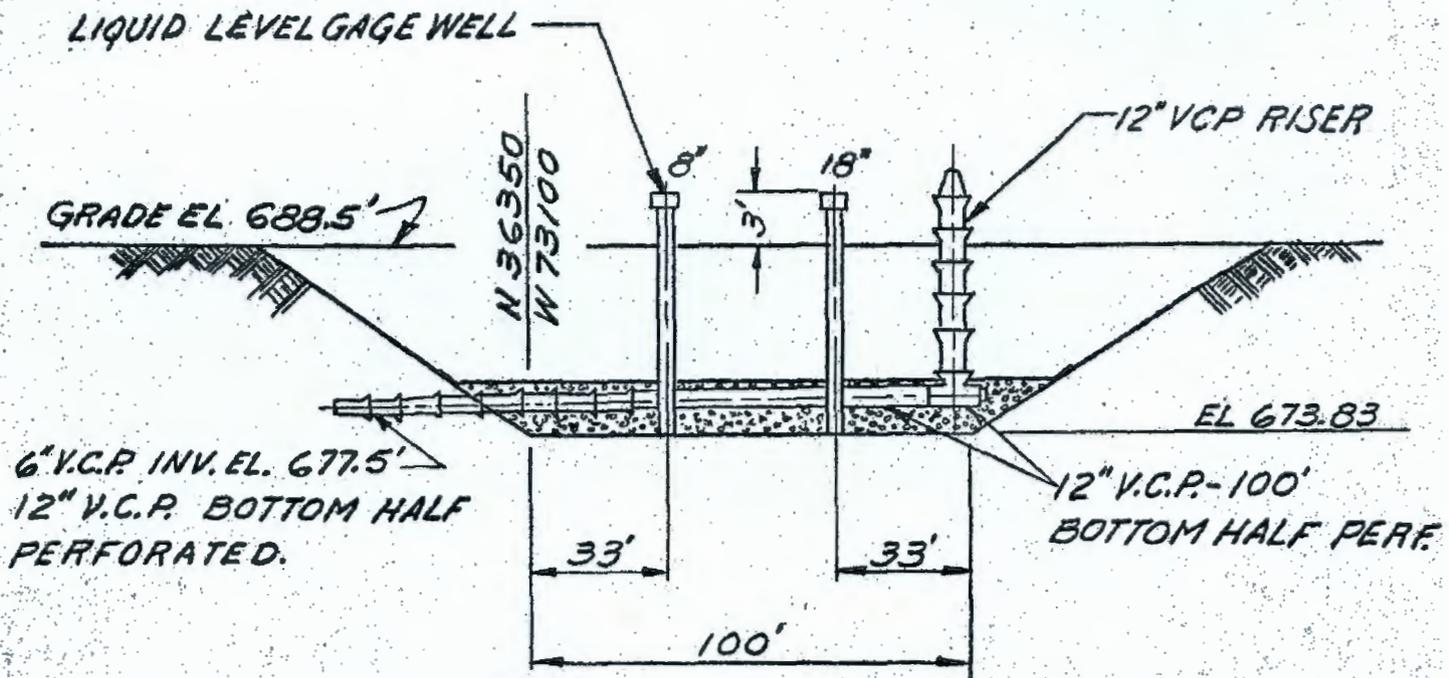


LONGITUDINAL SECTION

27'-6" MIN.

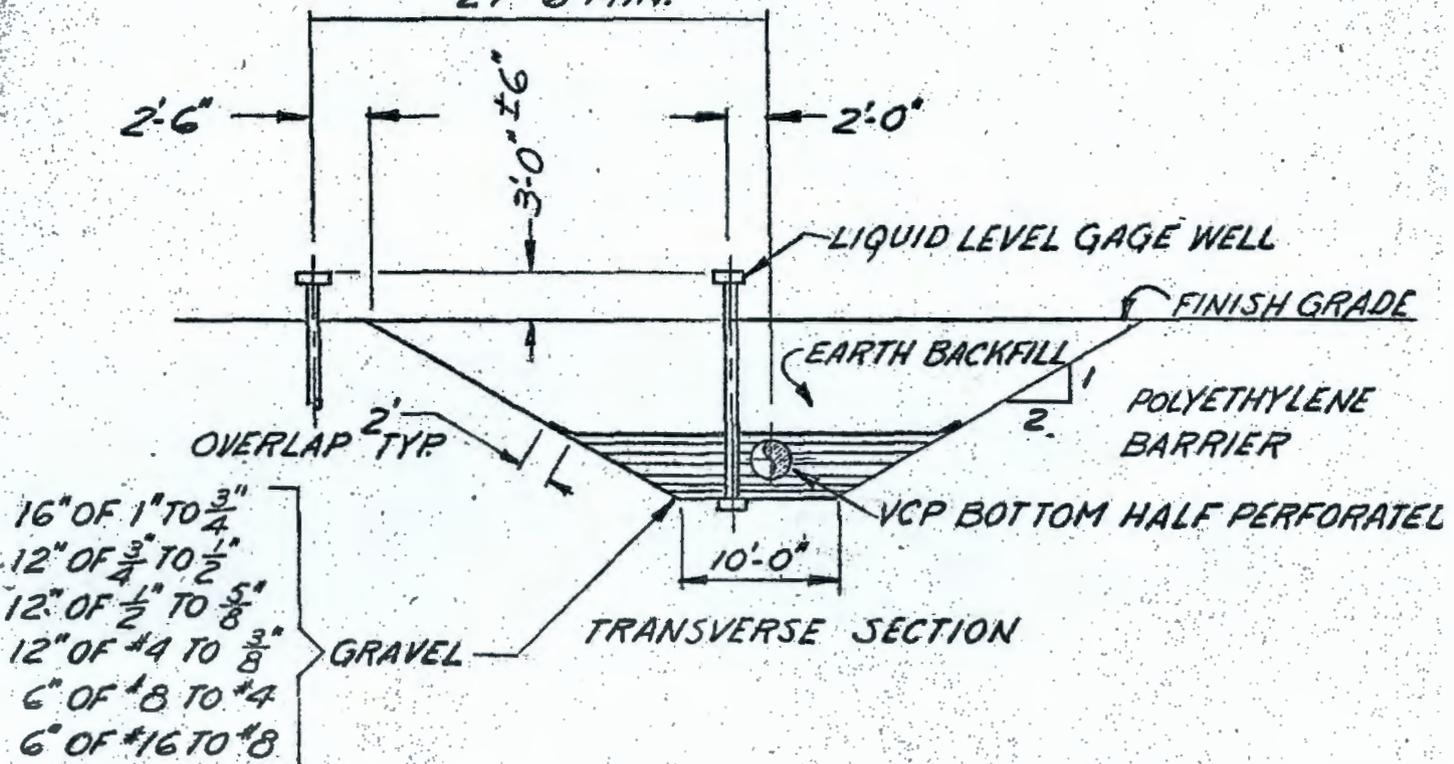

216-U-12
 H-2-31321
 H-2-31322

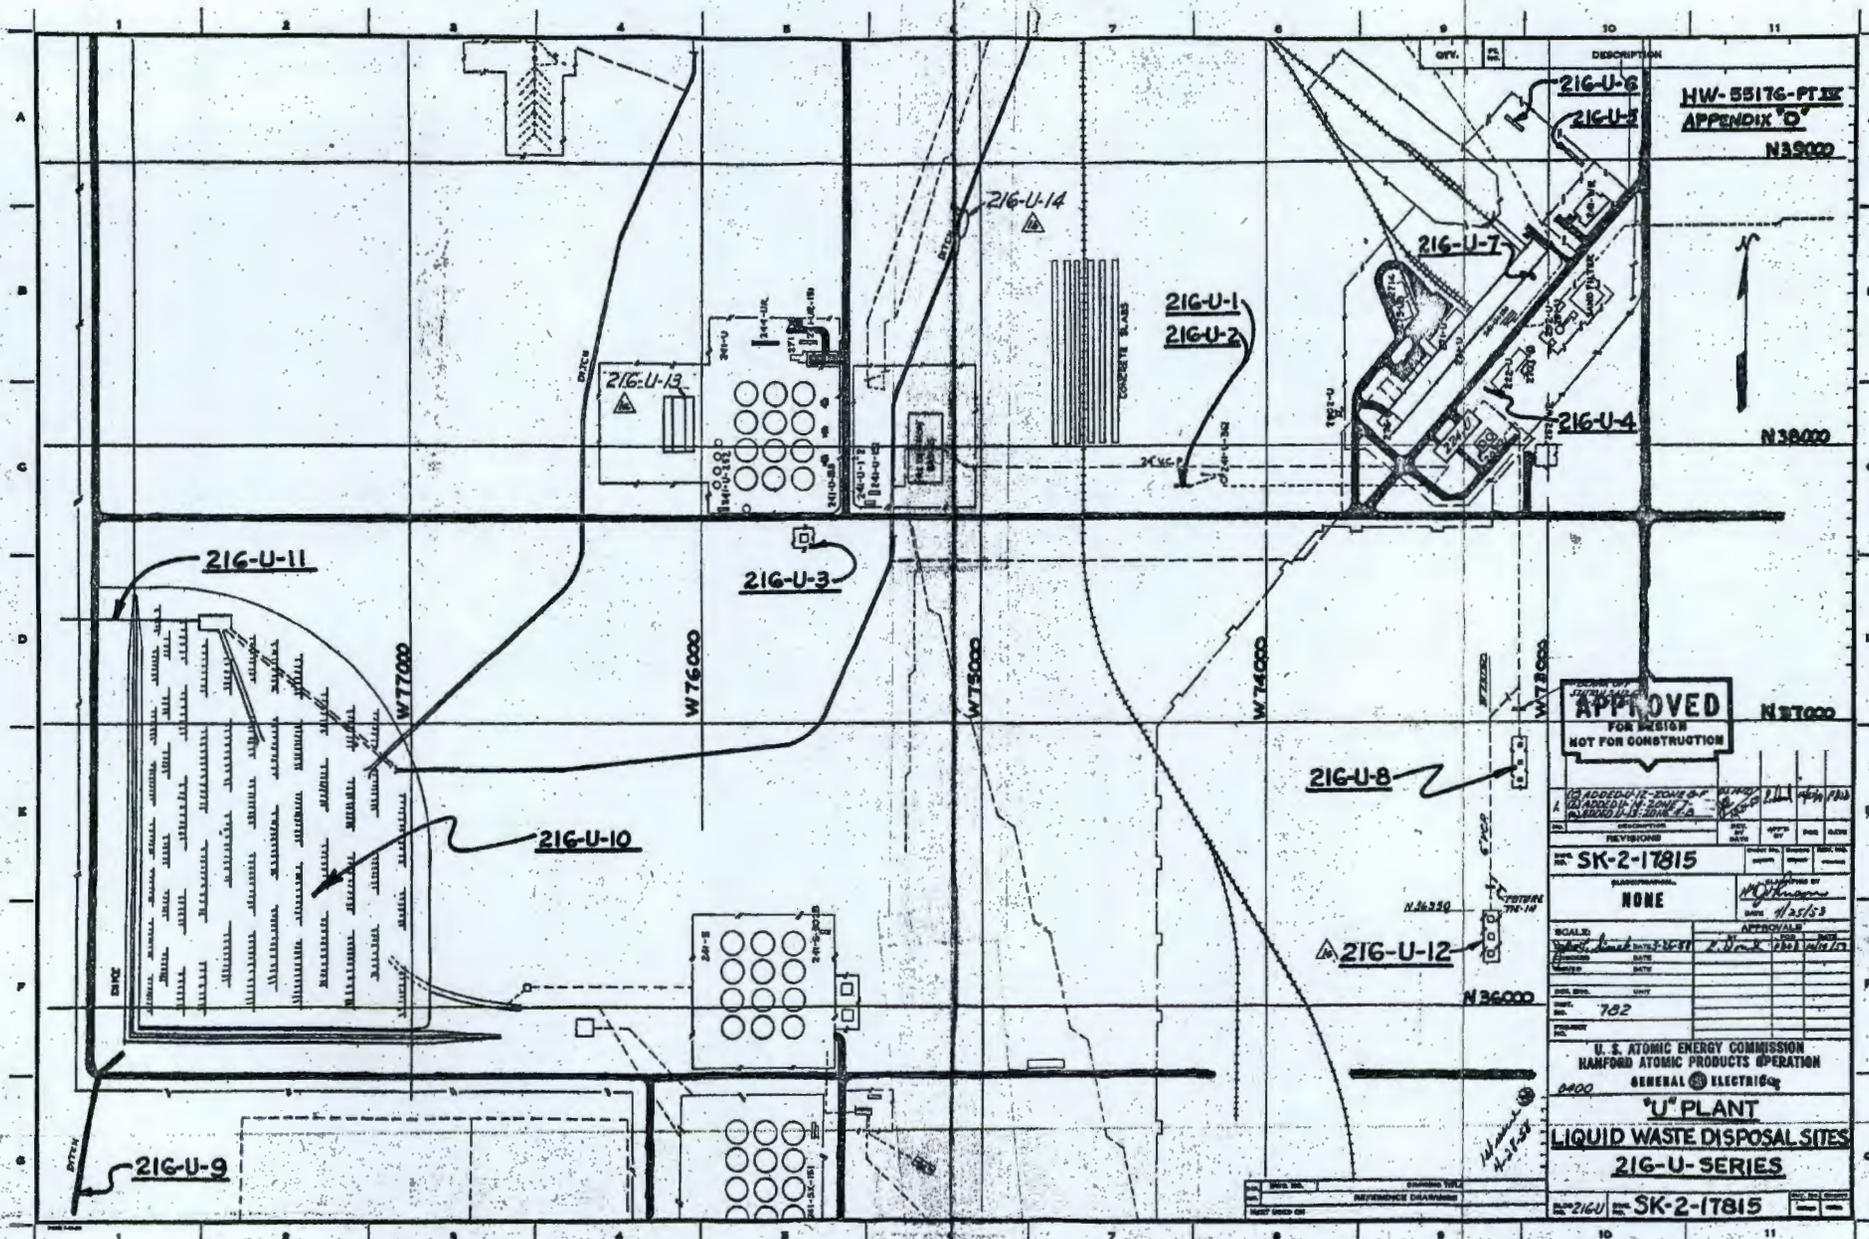

DESCRIPTION
HW-55176-FT-IX
APPENDIX 'D'
 N39000

APPROVED
 FOR DESIGN
 NOT FOR CONSTRUCTION

ADDED IN SOME OF THE AREAS IN THE 216-U-13 AREA
 APPROVED BY: [Signature]
 DATE: 11/25/63

REVISIONS

NO.	DESCRIPTION	DATE	BY	CHKD.
1	ADDED IN SOME OF THE AREAS IN THE 216-U-13 AREA	11/25/63	[Signature]	

SK-2-17815
 NONE

SCALE: NONE
 APPROVAL: [Signature]
 DATE: 11/25/63

702

U. S. ATOMIC ENERGY COMMISSION
 BAFORD ATOMIC PRODUCTS OPERATION
 GENERAL ELECTRIC

U-PLANT
LIQUID WASTE DISPOSAL SITES
216-U-SERIES

SK-2-17815

DATE	BY	REVISION

1 PLANT

UNCLASSIFIED

HW-55176, Pt. V
Page 1

INDEX OF CPD CRIB BUILDING NUMBERS
DESIGNS OF CPD RADIOACTIVE LIQUID WASTE
DISPOSAL SITES

Part V of VII Parts
Process Technology - Study Report

by

V. W. Wood
Radiological Design and Development
Facilities Engineering Operation
CHEMICAL PROCESSING DEPARTMENT

April 29, 1958

D I S T R I B U T I O N

CR Bergdahl	TG LaFollette
JM Bernard	CE Linderoth
WG Browne	HE Parker
E Doud	HF Peterson
J Durbin	DW Pearce
GK Carpenter	OH Pilkey
JR Cartmell	EL Reed
JB Fecht	RA Roberts
DR Gustavson	OC Schroeder/SG Smolen
WA Haney	HP Shaw
JF Honstead	VW Wood
IM Jacques	Records Center
EB Jackson	300 Files
CE Kent	Extras

UNCLASSIFIED

INDEX OF CPD CRIB BUILDING NUMBERS
DESIGNS OF CPD RADIOACTIVE LIQUID WASTE
DISPOSAL SITES

Part V of VII Parts
Process Technology - Study Report

INTRODUCTION

During the fourteen years or more which the separations areas have operated, many sites have been used for the disposal of radioactive liquid wastes. Various methods have been used in assigning building numbers to these sites and, in a number of cases, changes have been made which have brought about some confusion. One of the reasons being some currently used building numbers do not agree with the numbers existing on design prints for the facilities. Reference (2) was an effort to establish a listing of the liquid waste disposal sites. It required considerable time and research to locate information concerning these sites.

Many varied designs have been used for the disposal of radioactive liquid wastes. Reverse wells, trenches, cribs or caverns, etc, have been used. Specific information on these facilities is often difficult to obtain, for in some instances, they were constructed on work orders with no records being retained on the design. In general, the design on each facility has been different. This has made it extremely difficult for people to have a good working knowledge of the various waste disposal sites.

PURPOSE

The purpose of this report (Part V) is to provide a ready reference to the "T" Area waste disposal sites as well as a compilation of sketches showing the basic information on the design of each facility.

Another objective is to establish a simplified and uniform numbering system. Still another objective is to provide an up-to-date tabulation. Subsequent parts of this report will provide information on cribs for other areas.

SUMMARY AND CONCLUSIONS

All radioactive liquid waste disposal sites should have the 216 Building number designation. These should be further grouped by giving all such sites for Purex a prefix of 216-A. Other major series would be 216-S for Redox; 216-T for "T" Area; 216-B for "B" Area; 216-U for "U" Area and 216-Z for "Z" Area.

The numbering list in "Official Hanford Works Building List - Specification HW-5000" by Engineering Files - Construction Engineering Operation should be revised to more closely follow the above numbering system.

RECOMMENDATIONS

It is recommended that the following action be taken:

1. All groups and services referring to the "T" Area cribs or report data concerning them should use the index numbering system as presented in this report.
2. That all drawings concerning these disposal sites, including maps, be revised to show the proper locations and numbers for these cribs.
3. Any suggestions for improving the usefulness of this report should be referred to the author.

DISCUSSION

When all parts of the report are completed, and the work outlined in the report is completed, much confusion will be eliminated and more people will be better informed on the design of each waste disposal facility. The report will provide a firm basis for future building number assignments.

While some sincere effort has been made to try and keep a methodical system for recording waste disposal sites, a number of problems have developed. For example, HW-5000, Sheet 29 of 50 lists only two cribs in the 216-Z series. They are 216-Z-8 and 216-Z-9. Although no coordinates are given, it is doubtful if these refer to the same cribs with the same number as given in Reference "2".

As indicated earlier, the use of the crib index, as presented in this report should be very easy. In addition, information is presented which is very difficult to locate in the records and in some cases it is not available in the records.

REFERENCES

1. HW-5000, "Official Hanford Works Building List - Specification HW-5000" by Engineering Files - Construction Engineering Operation.
2. HW-43121, "Tabulation of Radioactive Liquid Waste Disposal Facilities" by HV Clukey dated May 10, 1956.
3. HW-33305, "Tabulation of Radioactive Liquid Waste Disposal Facilities," by HV Clukey dated October 8, 1954.
4. HW-41535, "Unconfined Underground Radioactive Waste and Contamination in the 200 Areas" by KR Heid.

CROSS REFERENCE FOR "T" AREA RADIOACTIVE LIQUID
WASTE DISPOSAL SITES

<u>Suggested Crib No.</u>	<u>Number Listed in HW-5000</u>	<u>Number Listed in HW-43121</u>	<u>Original Or Number Used On Drawings</u>	<u>Remarks</u>
216-T-1	216-T-1	216-T-1	None	"T" Trench
216-T-2	216-T-2	216-T-2	None	Reverse Wall
216-T-3	None	216-T-3	None	Reverse Wall
216-T-4	216-T-4	216-T-4	None	"T" Swamp
216-T-5	216-T-5	216-T-12	216-T-5	Trench
216-T-6	361-T-H2	216-T-5	361-T-H2	
216-T-7	None	216-T-7	241-T-H2	Crib & Tile Field
216-T-8	222-T-1&2	216-T-8	None	
216-T-9	None	216-T-9	None	Trench
216-T-10	None	216-T-10	None	Trench
216-T-11	None	216-T-11	None	Trench
216-T-12	None	216-T-11	207-T	Sludge Grave
216-T-13	None	216-T-12	269-W	Decontam. Trench
216-T-14	None	216-T-13	216-T-1	Graves
216-T-15	None	216-T-14	216-T-2	Graves
216-T-16	None	216-T-15	216-T-3	Graves
216-T-17	None	216-T-16	216-T-4	Graves
216-T-18	None	None	216-T-17	
216-T-19	None	216-TX-1	241-TX-153	Crib to Tile Field

<u>Suggested Crib No.</u>	<u>Number Listed in HW-5000</u>	<u>Number Listed in HW-43121</u>	<u>Original Or Number Used On Drawings</u>	<u>Remarks</u>
216-T-20	None	216-TX-2	155-TX	Contam. Acid Grave
216-T-21	241-TX-3	216-TX-3	241-TX	Trenches
216-T-22	241-TX-3	216-TX-4	241-TX	Trenches
216-T-23	241-TX-3	216-TX-5	241-TX	Trenches
216-T-24	241-TX-3	216-TX-6	241-TX	Trenches
216-T-25	None	216-TX-7		
216-T-26	216-TY-1	216-TY-1	216-TY	
216-T-27	216-TY-2	216-TY-2	216-TY	
216-T-28	216-TY-3	216-TY-3	216-TY	
216-T-29	None			
216-T-30	None			
216-T-31	None			
216-T-32	None	241-T #1 & 2	241-T #1 & 2	

APPENDIXA. Explanation of Parts to the Report

Part I will cover the Purex Radioactive Liquid Waste Disposal Sites.

Part II will cover the "Z" Plant Radioactive Liquid Waste Disposal Sites.

Part III will cover the Redox Plant Radioactive Liquid Waste Disposal Sites.

Part IV will cover the "U" Plant Radioactive Liquid Waste Disposal Sites.

Part V will cover the "T" Area Radioactive Liquid Waste Disposal Sites.

Part VI will cover the "B" Plant Radioactive Liquid Waste Disposal Sites.

Part VII will cover the "C" Plant, Hot Semi-works, the 200 North Areas and miscellaneous.

B. Index for "T" Area Radioactive Liquid Waste Disposal Sites.

C. Sketches of "T" Area Waste Disposal Facilities.

D. Map of "T" Area Crib Sites. (SK-2-17813).

UNCLASSIFIED


HW-55176, PTV
Appendix B
Revised 10/19/59

CRIB INDEX
T AREA

<u>Number</u>	<u>Description Appendix Sheet</u>	<u>Service</u>	<u>Use Dates</u>		<u>Status</u>
			<u>From</u>	<u>To</u>	
216-T-1	C-1	Startup Wastes	1945		Abandoned
216-T-2	C-2	222-T Lab Wastes	1/45	4/50	Replaced by T-8
216-T-3	C-3	224-T and 5-6 Wastes	1/45	8/46	Abandoned
216-T-4	C-4	Cooling Water & Chemical Sewer	3/47	-	Active
216-T-5	C-4	2nd Cycle and 112-T Wastes		5/55	Specific Ret.
216-T-6	C-5 & 6	224-T and 5-6 Wastes	8/46	6/51	Abandoned
216-T-7	C-7 & 8	224-T, 5-6, and 2nd Cycle	4/48	1956	Abandoned
216-T-8	C-6 & C-9	222-T Lab Wastes	4/50	1956	Abandoned
216-T-9	C-10	Equipment Decontamination Wastes	6/51	3/54	Abandoned
216-T-10	C-10	Equipment Decontamination Wastes	6/51	3/54	Abandoned
216-T-11	C-10	Equipment Decontamination Wastes	6/51	3/54	Abandoned
216-T-12	C-11	Retention Basin Sludge		11/54	Abandoned
216-T-13	C-12	Equipment Decontamination	6/54	-	Active
216-T-14	C-13	1st cycle Supernate	1/54		Spec. Retention
216-T-15	C-13	1st cycle Supernate	1/54	2/54	" "
216-T-16	C-13	1st cycle Supernate		2/54	" "
216-T-17	C-13	1st cycle Supernate	2/54	6/54	" "
216-T-18	C-14	Scavenged Wastes		11/53	" "
216-T-19	C-15	224-T, 242-T, 5-6, & 2nd cycle	9/51	1959	Abandoned
216-T-20	C-16	155 TX Catch Tank Wastes	11/52		Abandoned
216-T-21	C-17	1st cycle supernate	6/54		Spec. Retention
216-T-22	C-17	" " "	7/54		" "
216-T-23	C-17	" " "	7/54	8/54	" "
216-T-24	C-17	" " "		8/54	" "
216-T-25	C-18	Evaporator Bottoms		9/54	" "
216-T-26	C-19 & 20	Scavenged Wastes	8/55	11/56	Not being used
216-T-27	C-19 & 20	" "	Not used		" " "
216-T-28	C-19 & 20	" "	Not used		" " "
216-T-29	None	Sand Filter Drain	1950	-	Active
216-T-30	None	TX-154 Diversion Box Spill	1953		Abandoned
216-T-31	None	241-TX French Drain	1954		Abandoned
216-T-32	C-21	224-T Wastes	4/48	6/52	Abandoned

UNCLASSIFIED


HW-55176-PT 5
APPENDIX Q-1
N43200.0

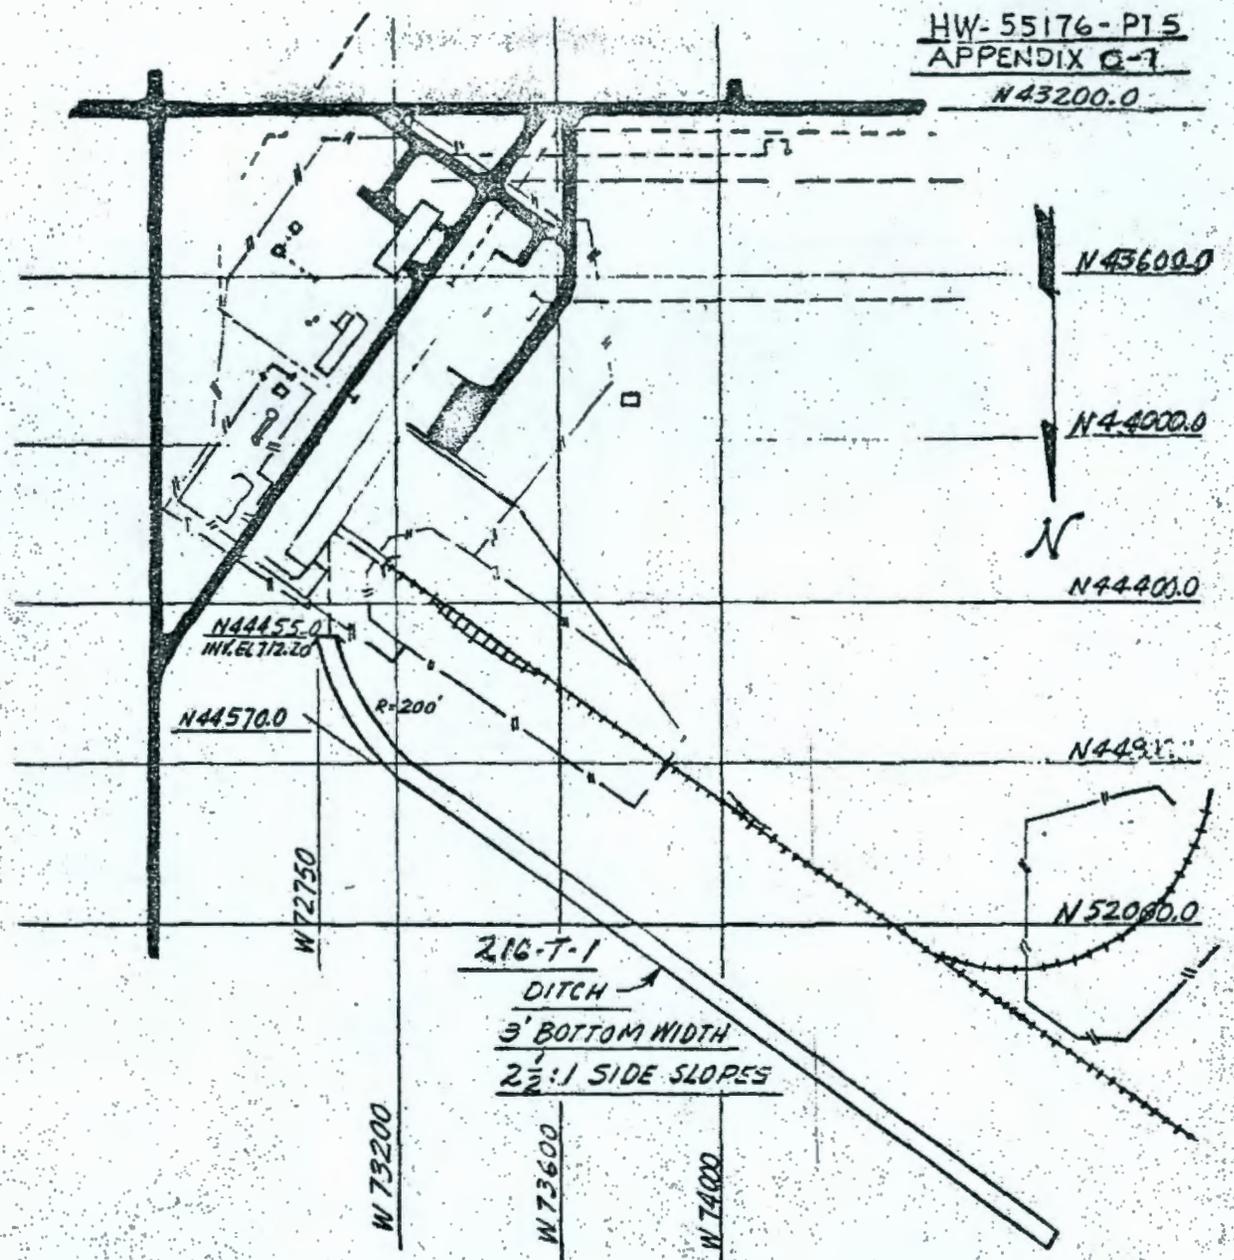

216-T-1
DITCH
3' BOTTOM WIDTH
2½:1 SIDE SLOPES

TAKEN FROM 2892-SHT. 11
H-2-5101

216-T-1

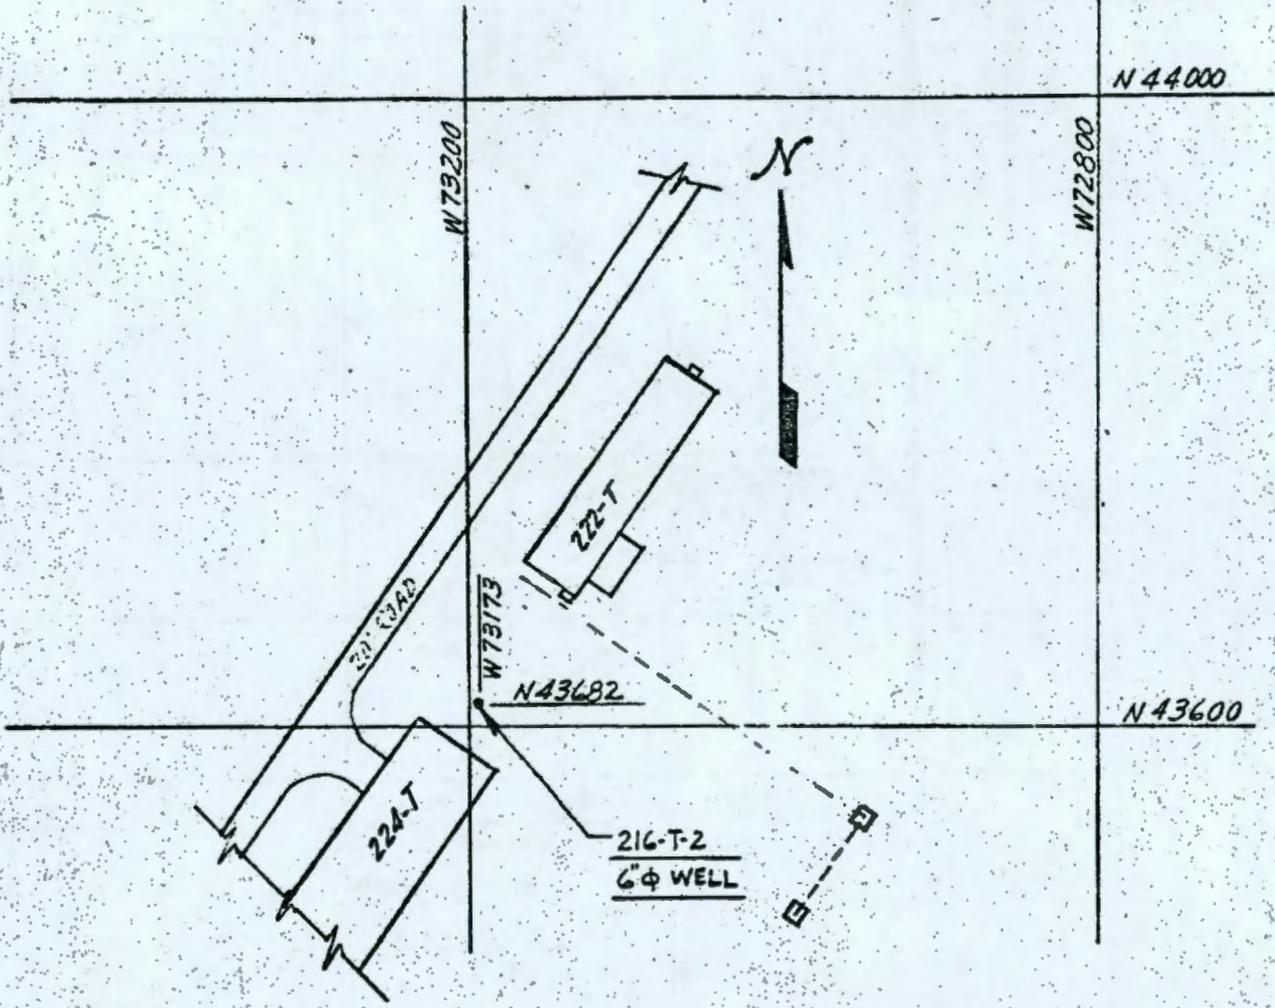


N43682


TAKEN FROM MAP 2924-SHT# 11

216-T-2

HW 55176-PT 5
APPENDIX C-3
DRAWN JLSIMEK 12/16/55

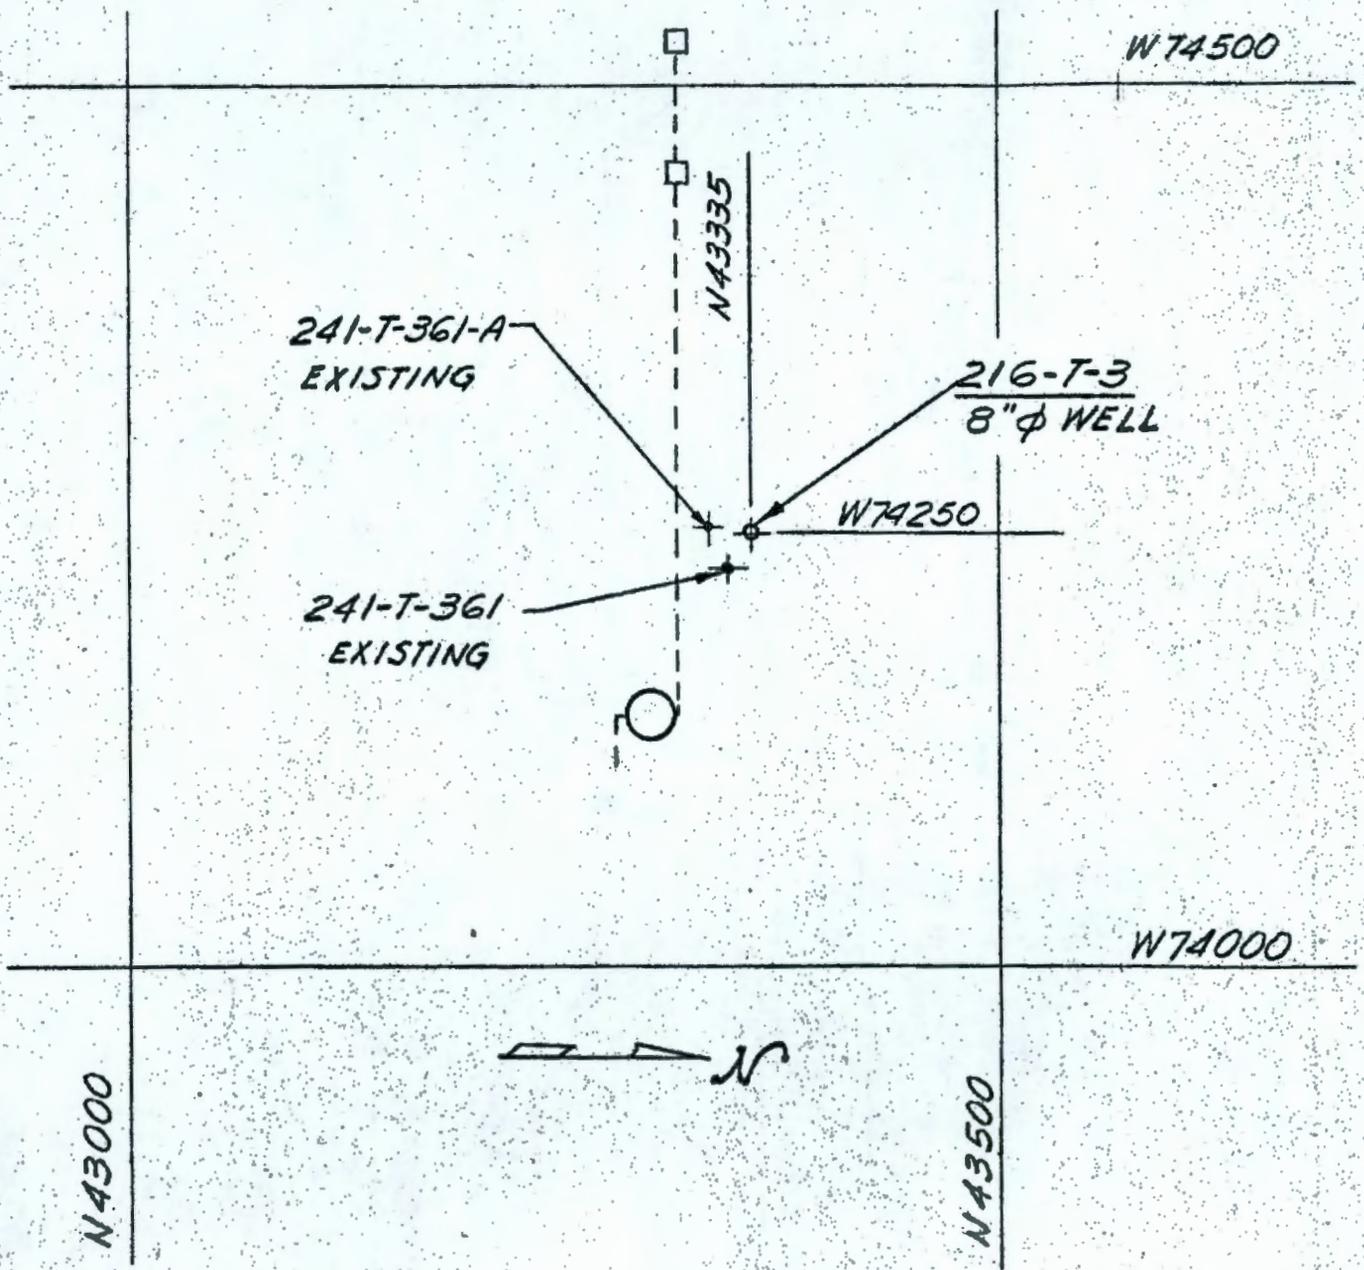

216-T-3
H-2-951

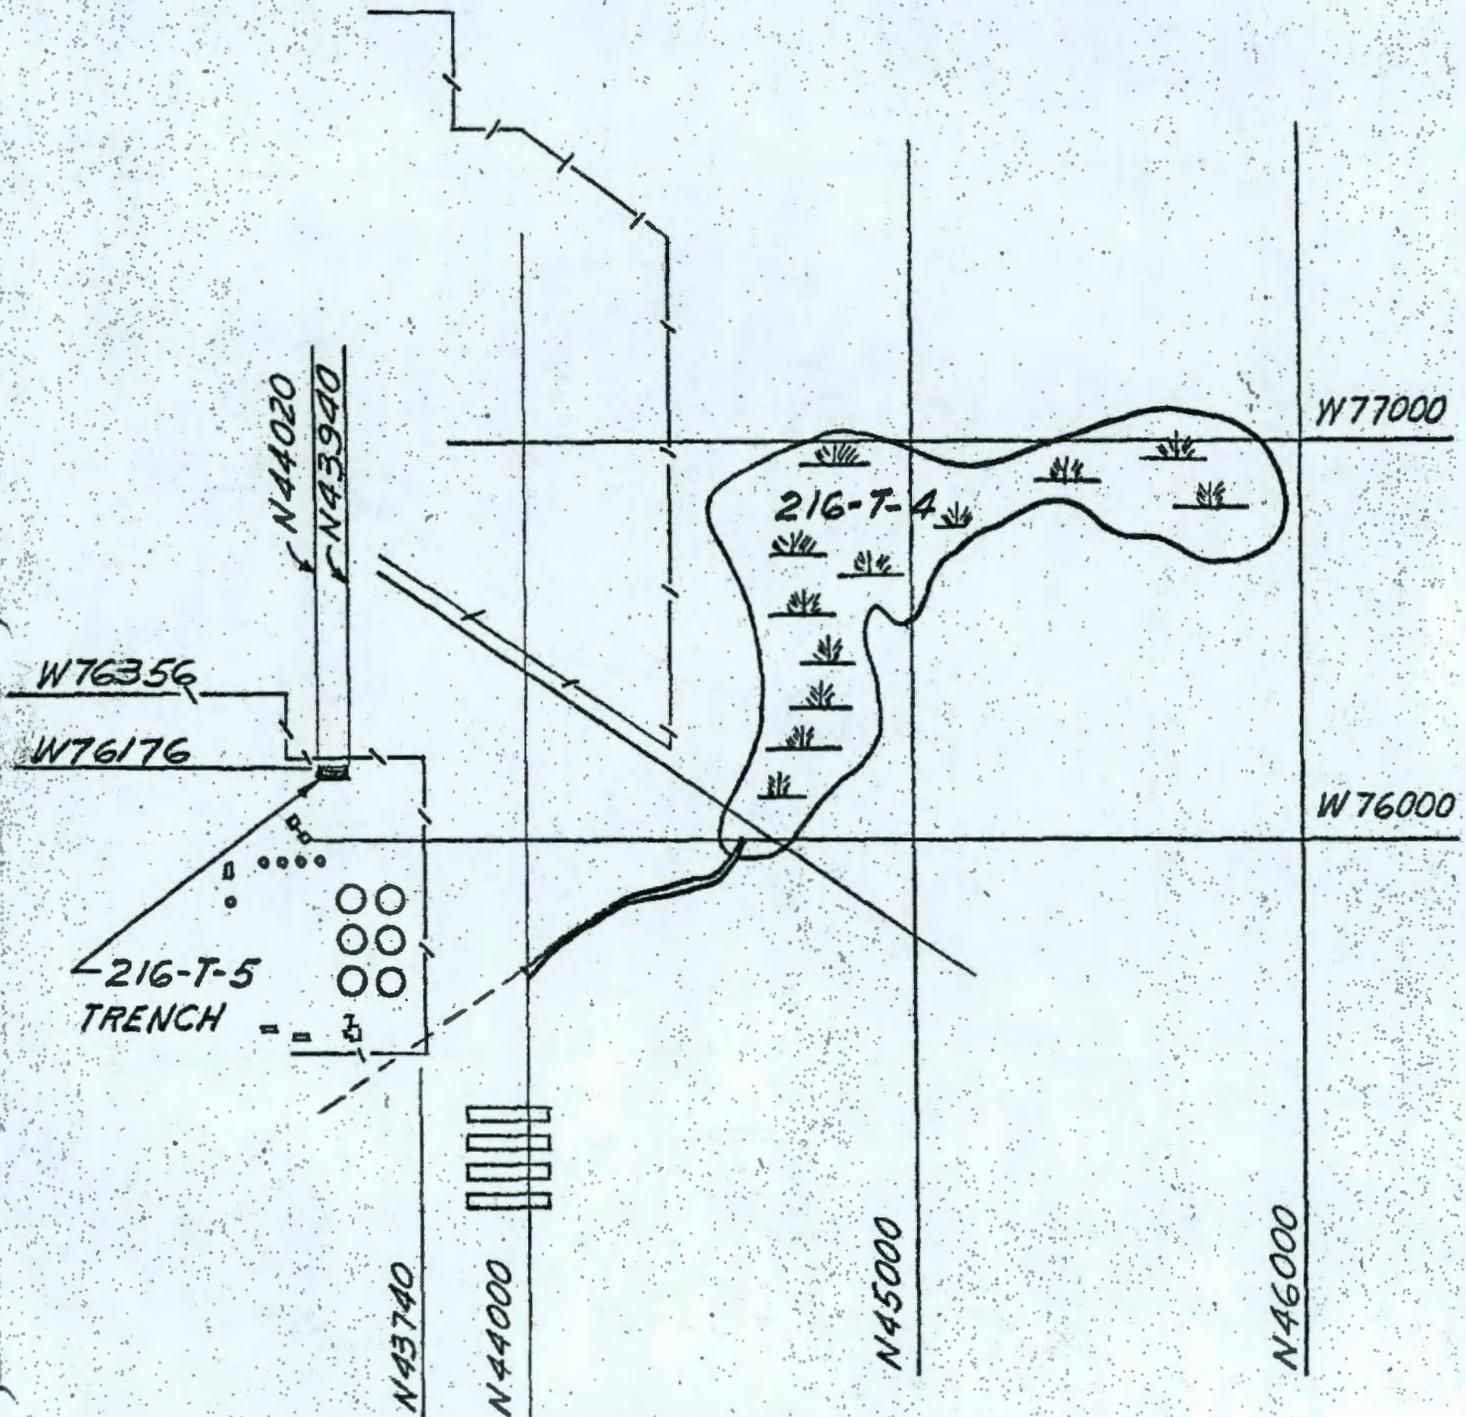


216-T-4

216-T-5


H-2-2430 & H-2-57A

5

47

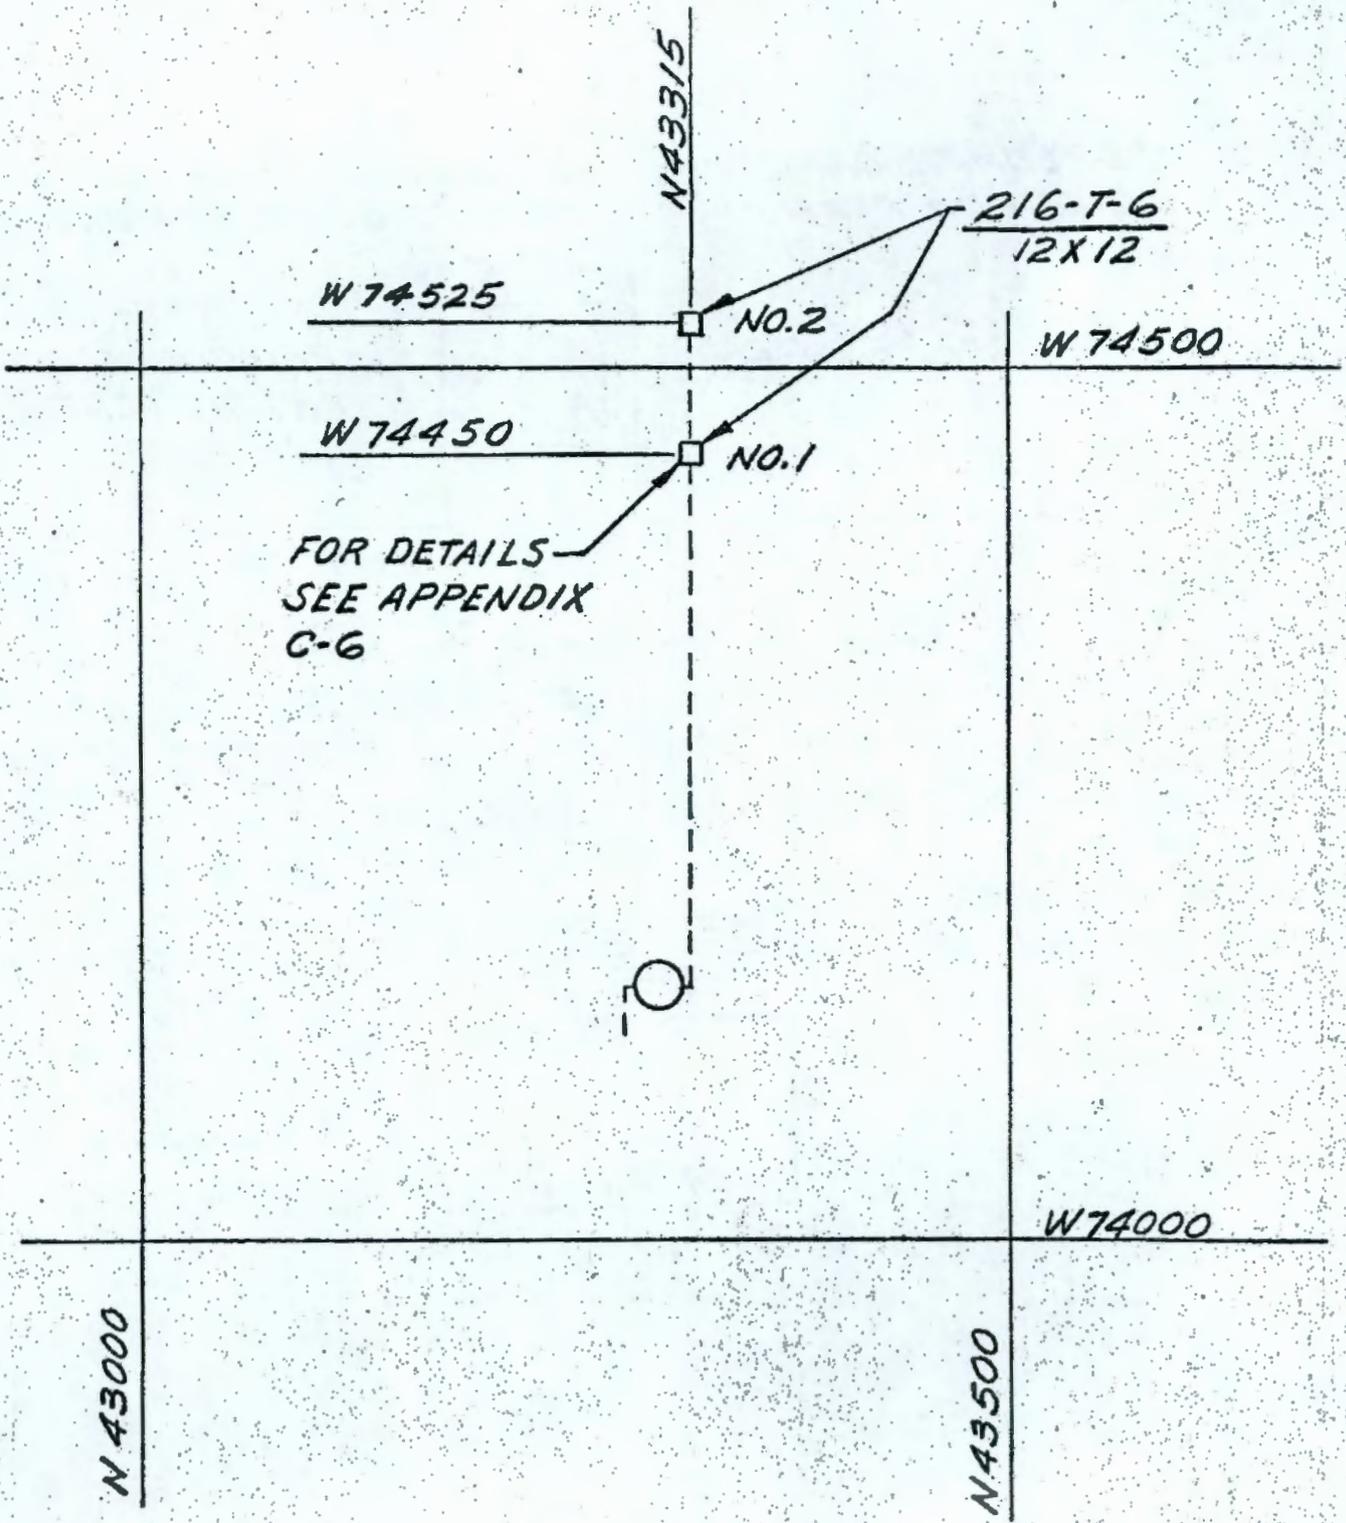

216-T-6
H-2-951

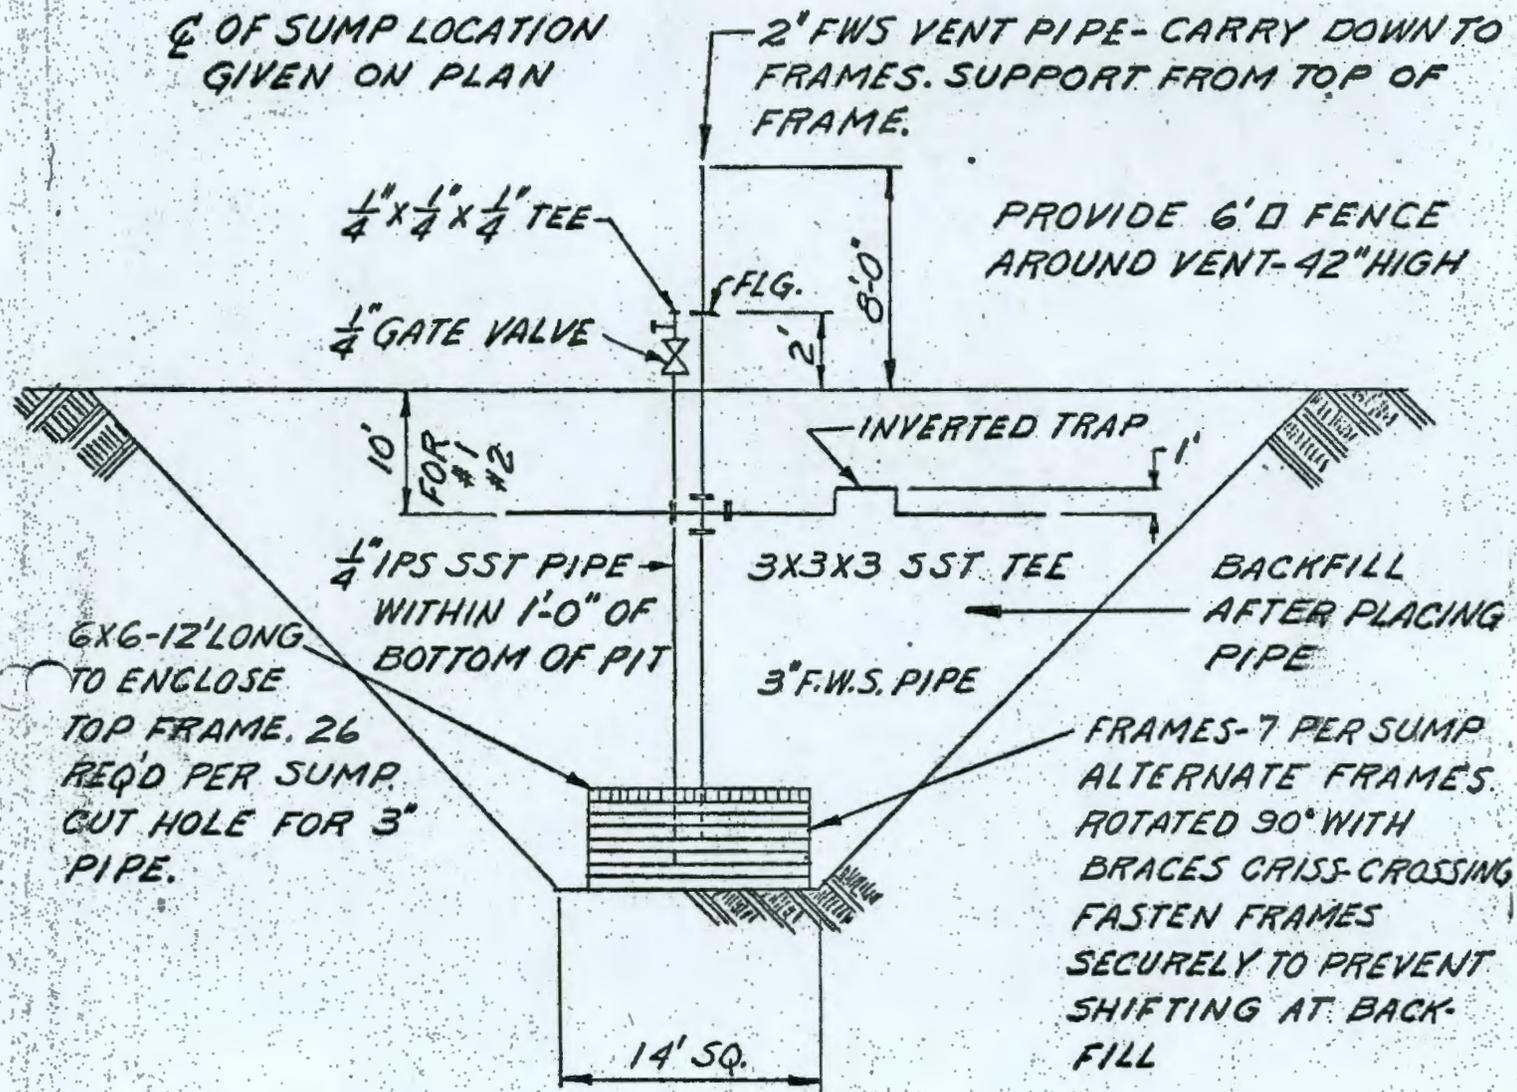


216-T-6


FOR PLAN - SEE APPENDIX C-5

216-T-8

FOR PLAN - SEE APPENDIX C-9

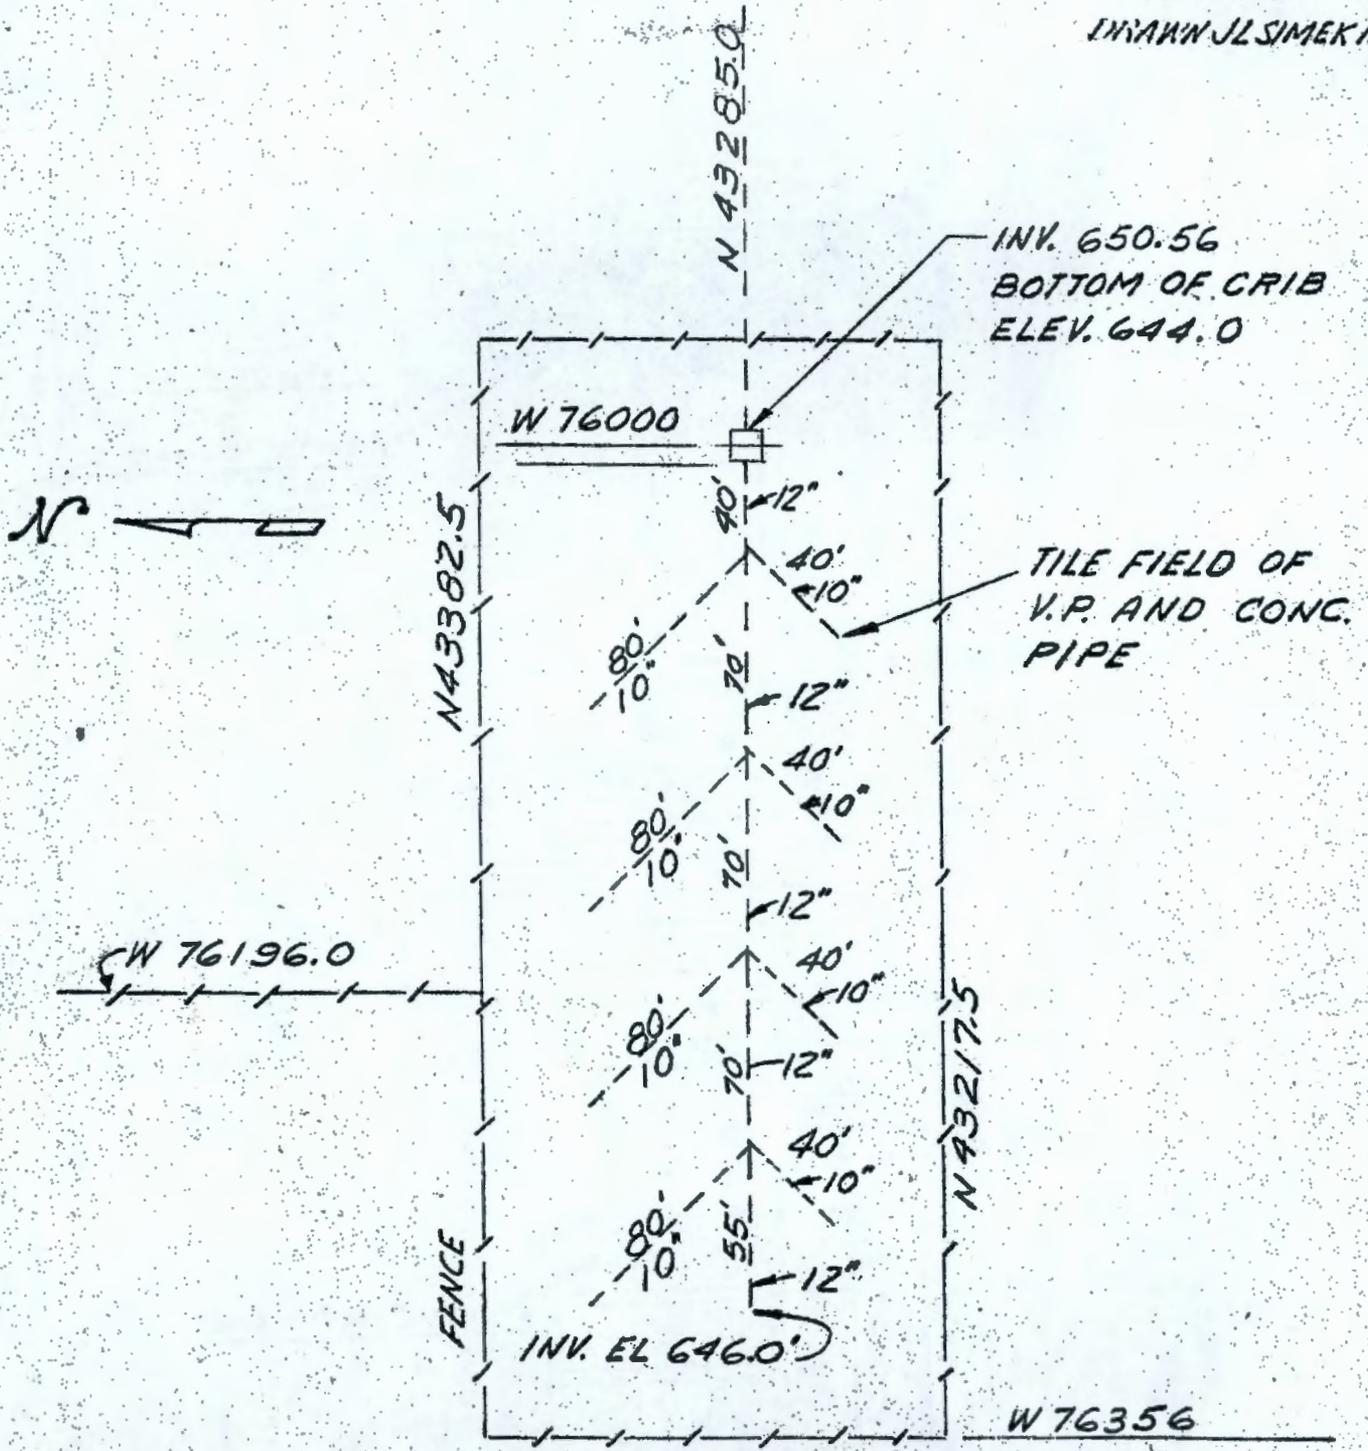


216-T-7
H-2-578

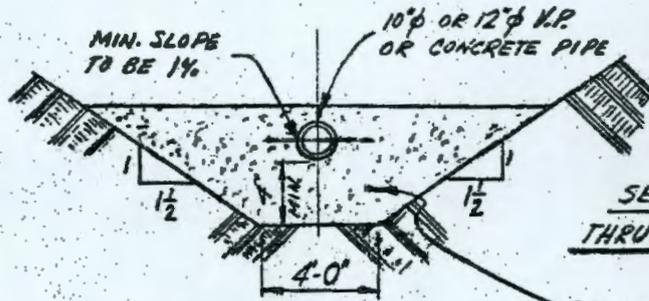

SECTION
THRU TILE FIELD


BACKFILL NOTE AS IN CRIB
SECTION.

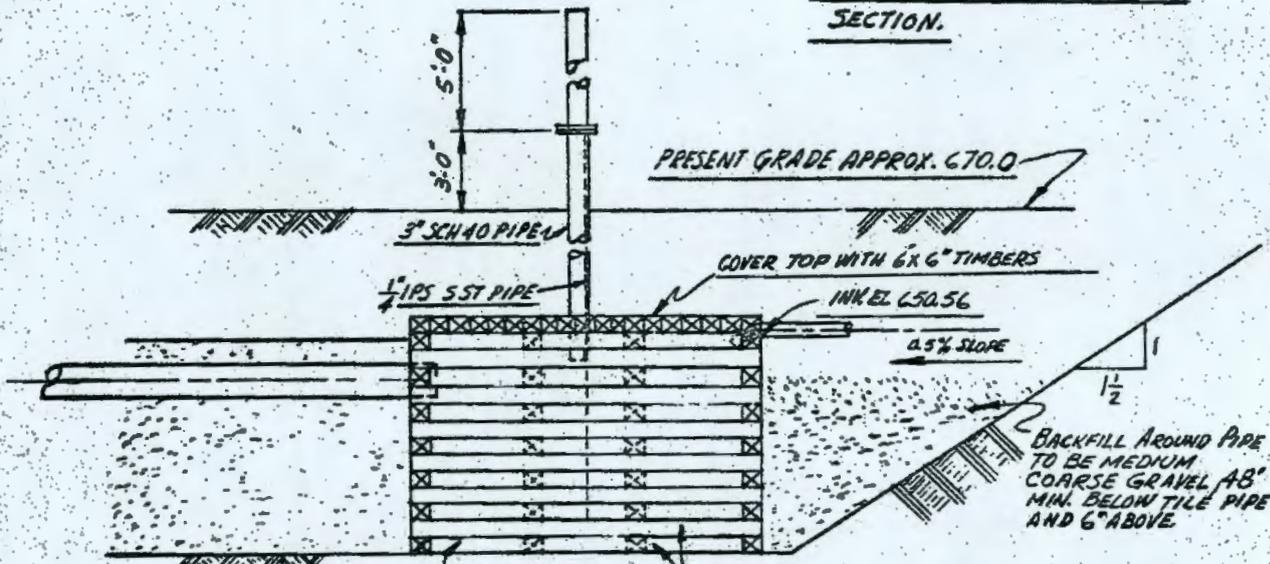

FASTEN FRAME
SECURELY TOGETHER
TO PREVENT SHIFTING
WHILE BACK FILLING

CRIB SECTION

6x6 TIMBERS - SEE FRAME DETAIL

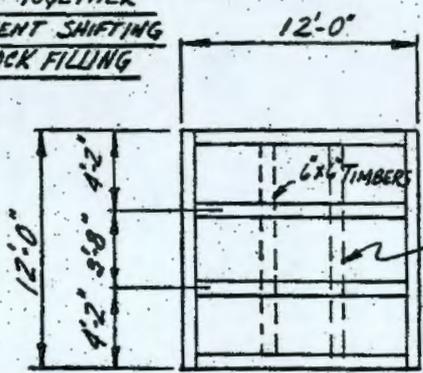


FRAME DETAIL - 13 REQ'D


TAKEN FROM H-2-578

216-T-7

HW 55176-PART 5
APPENDIX C-9
DRAWN JLS/MEK 12/15/59

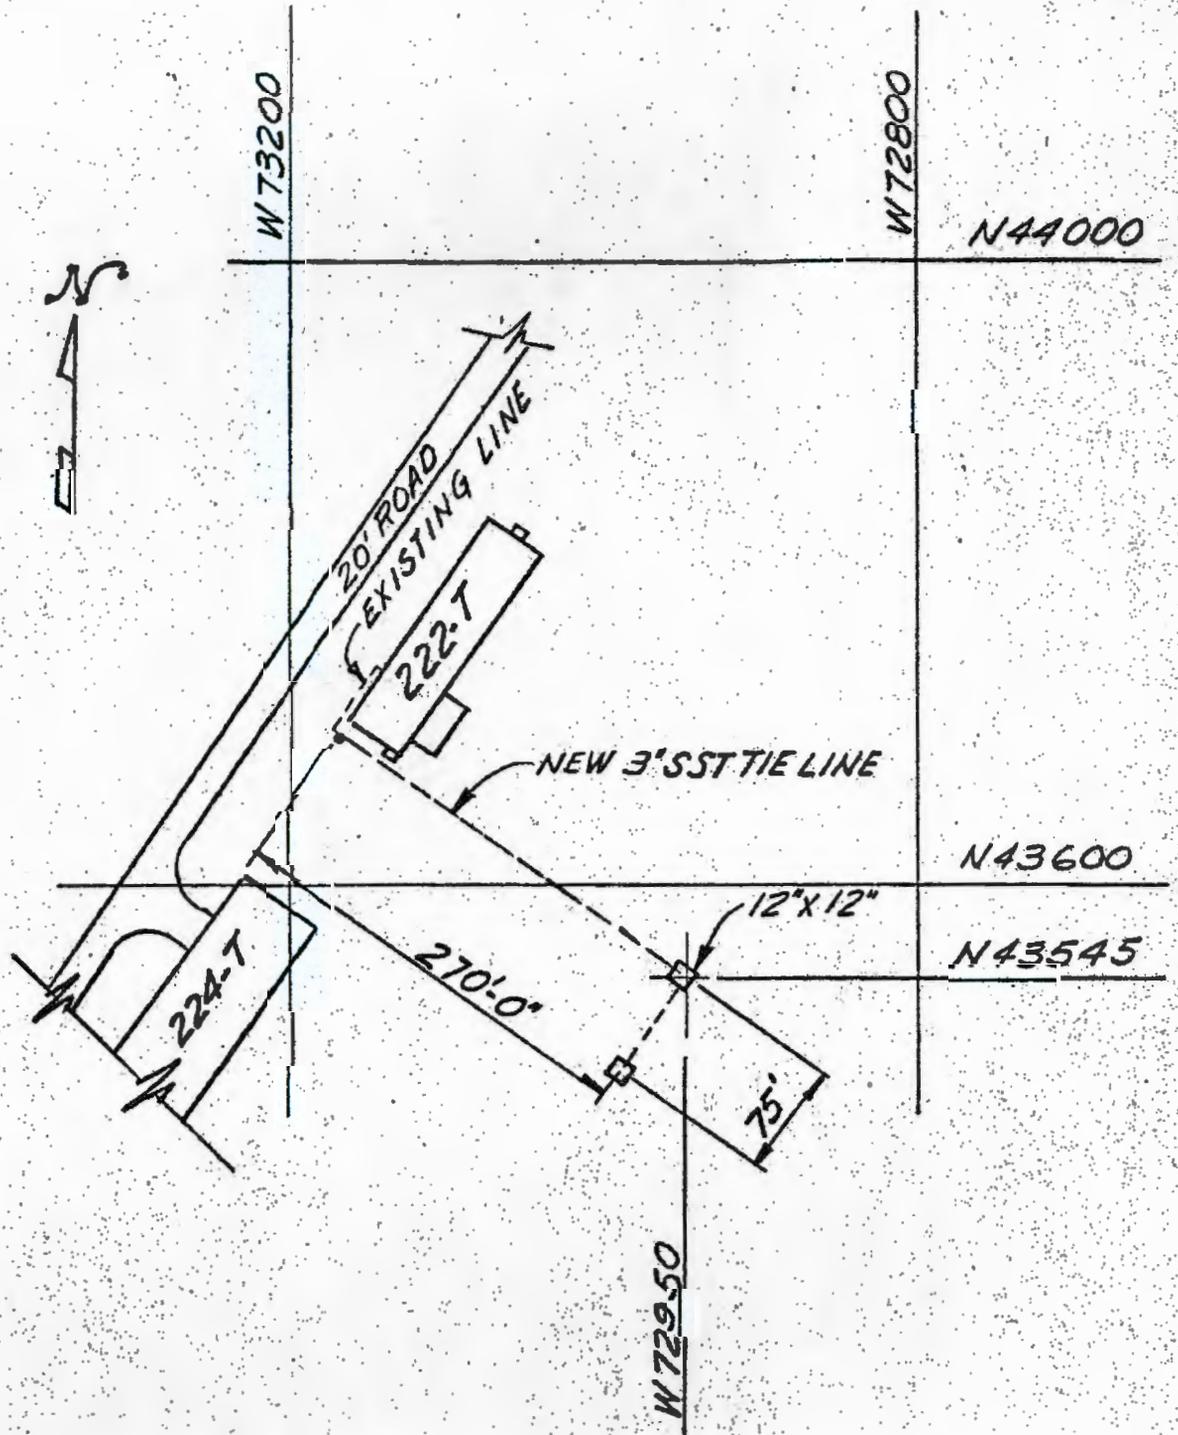


216-T-8
H-2-353

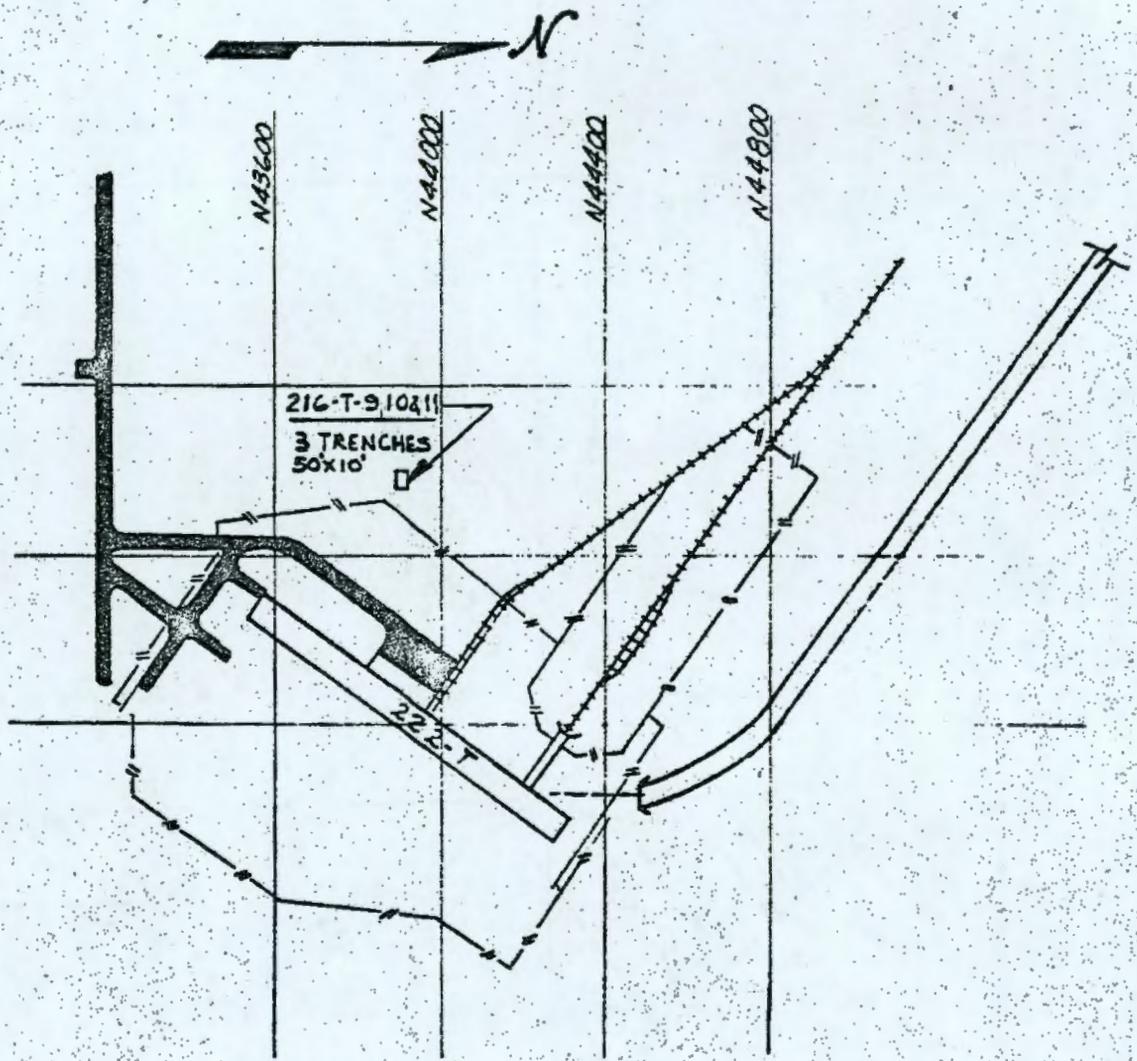

216-T-9,10&11

HW-55176-PT 5
APPENDIX C-II

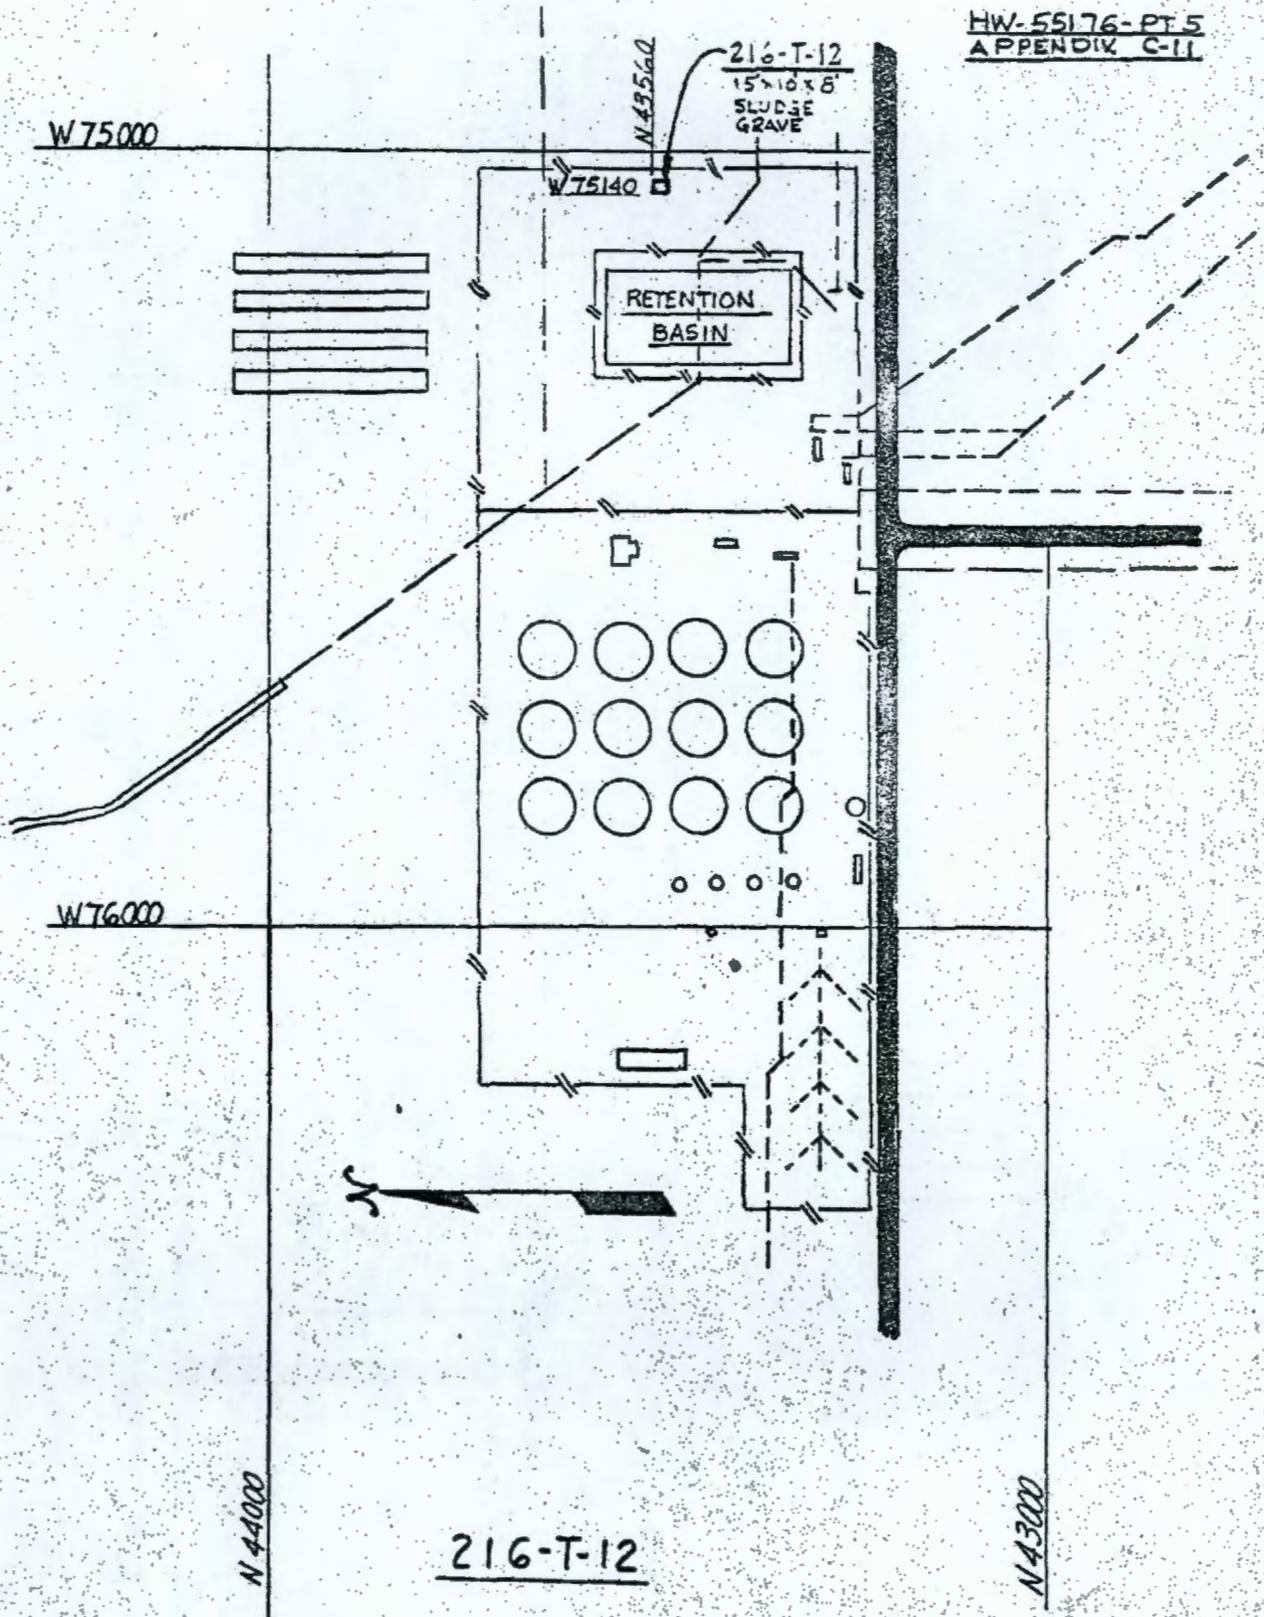

216-T-12



N 4300

N 42970


W 76000

W 75720

216-T-13
25x10x8
DECONTAMINATION
TRENCH

HW-55176-PT 5
APPENDIX C-12


216-T-13

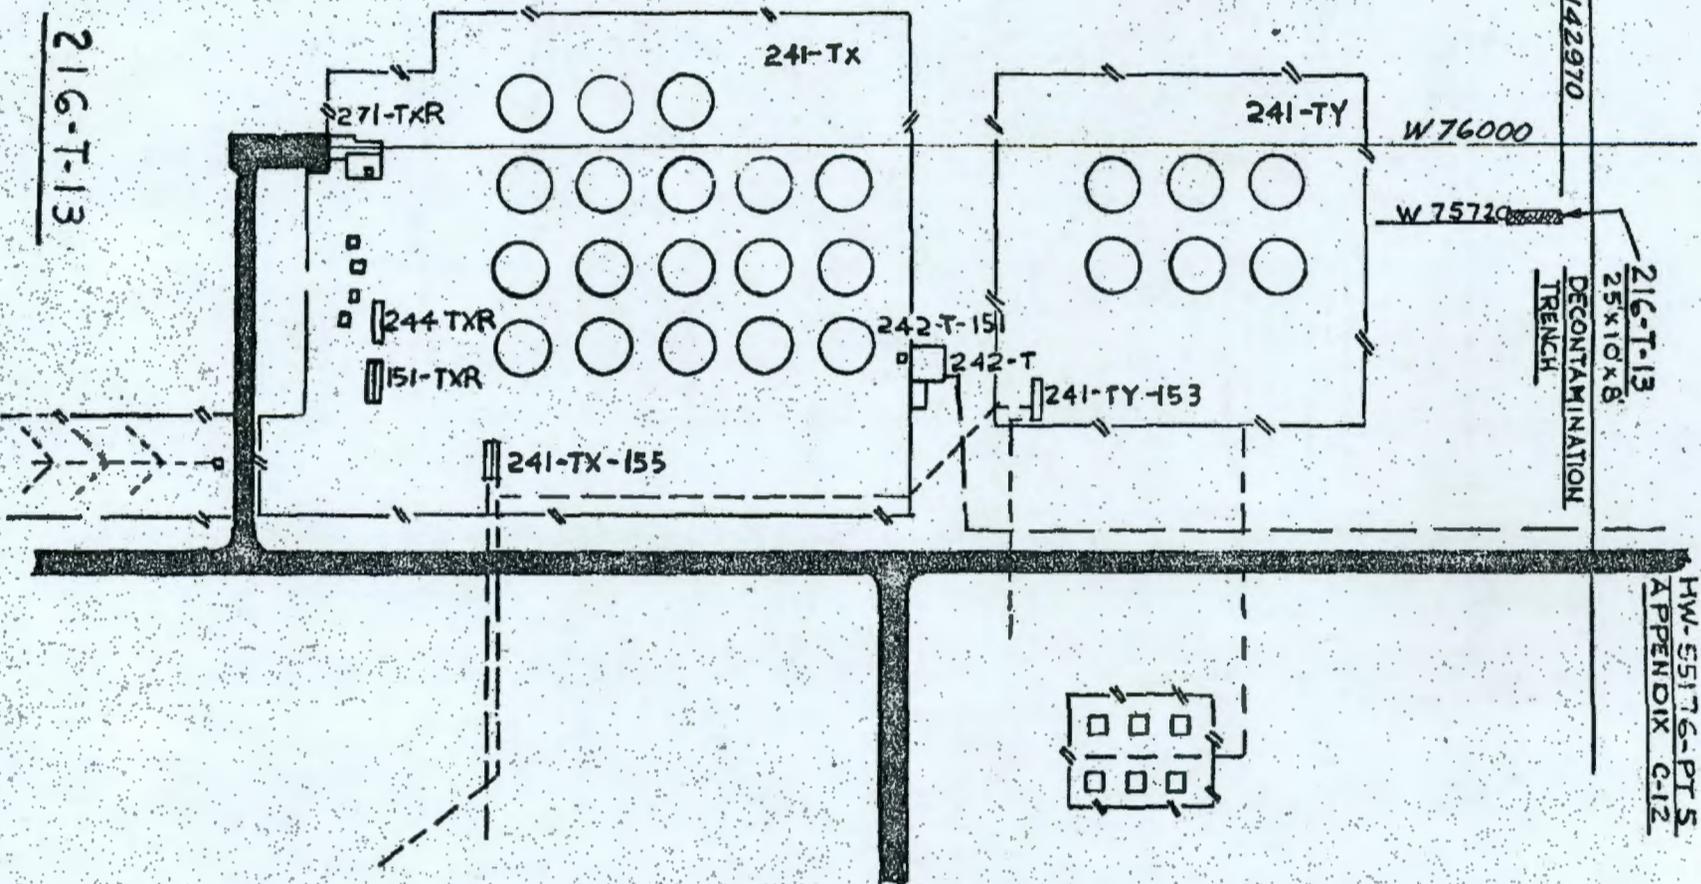


W75000

216-T-14,15,16,17


GRAVES
275x10x10

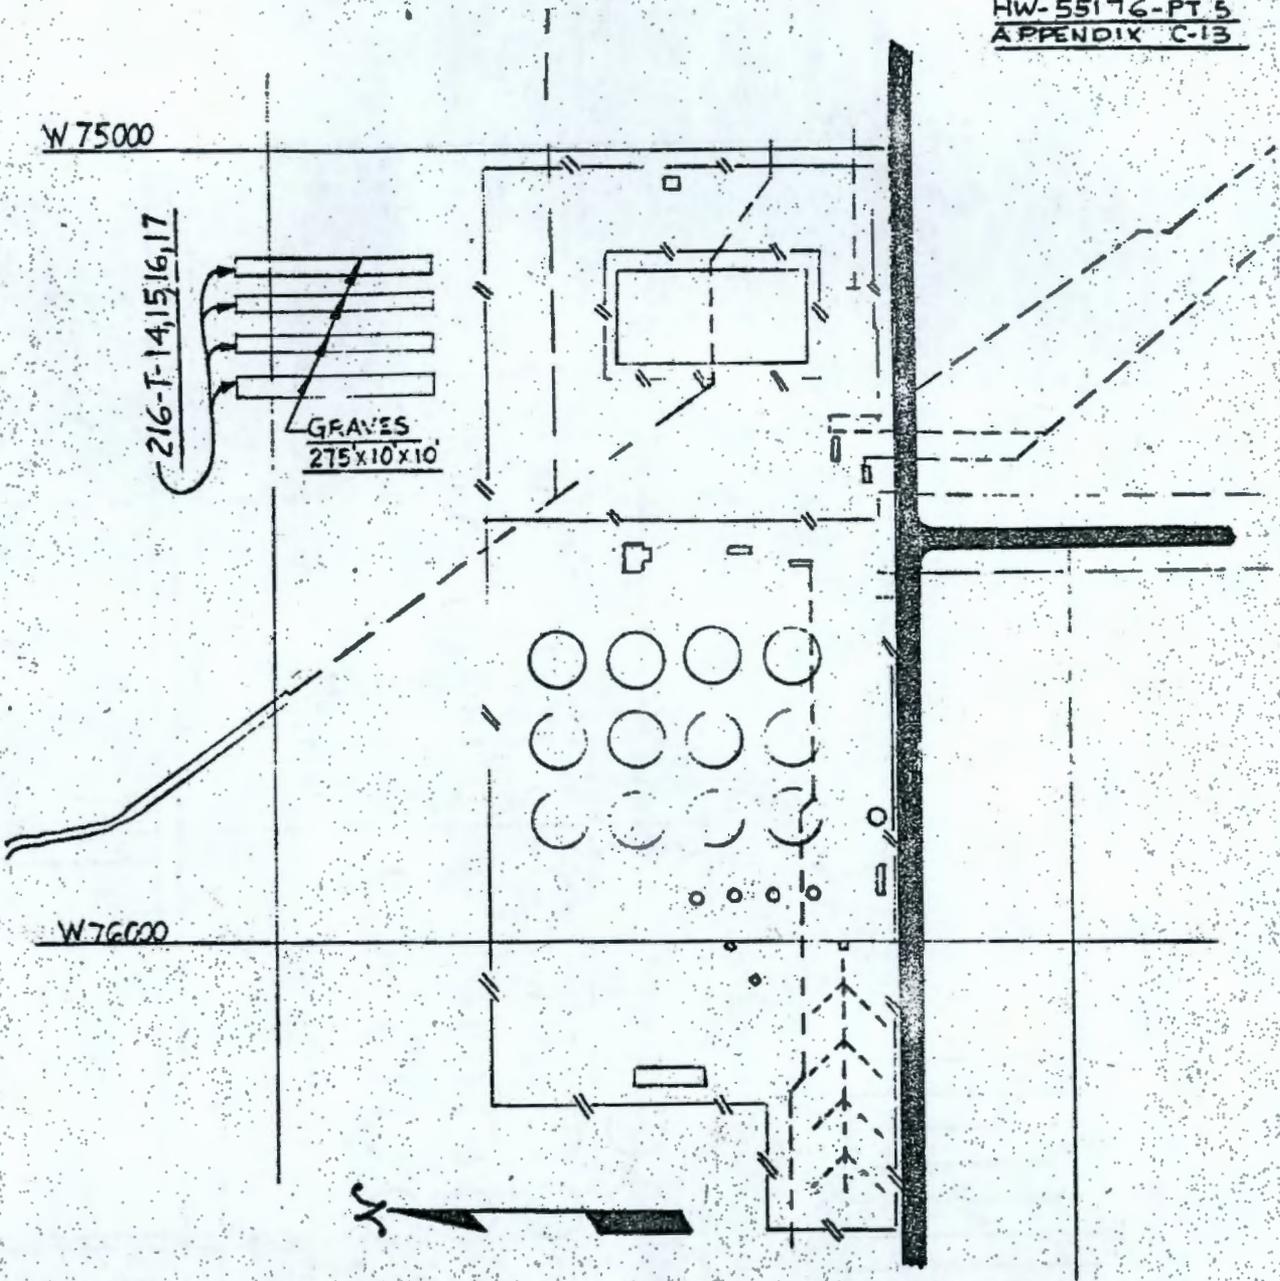


216-T-14,15,16,17

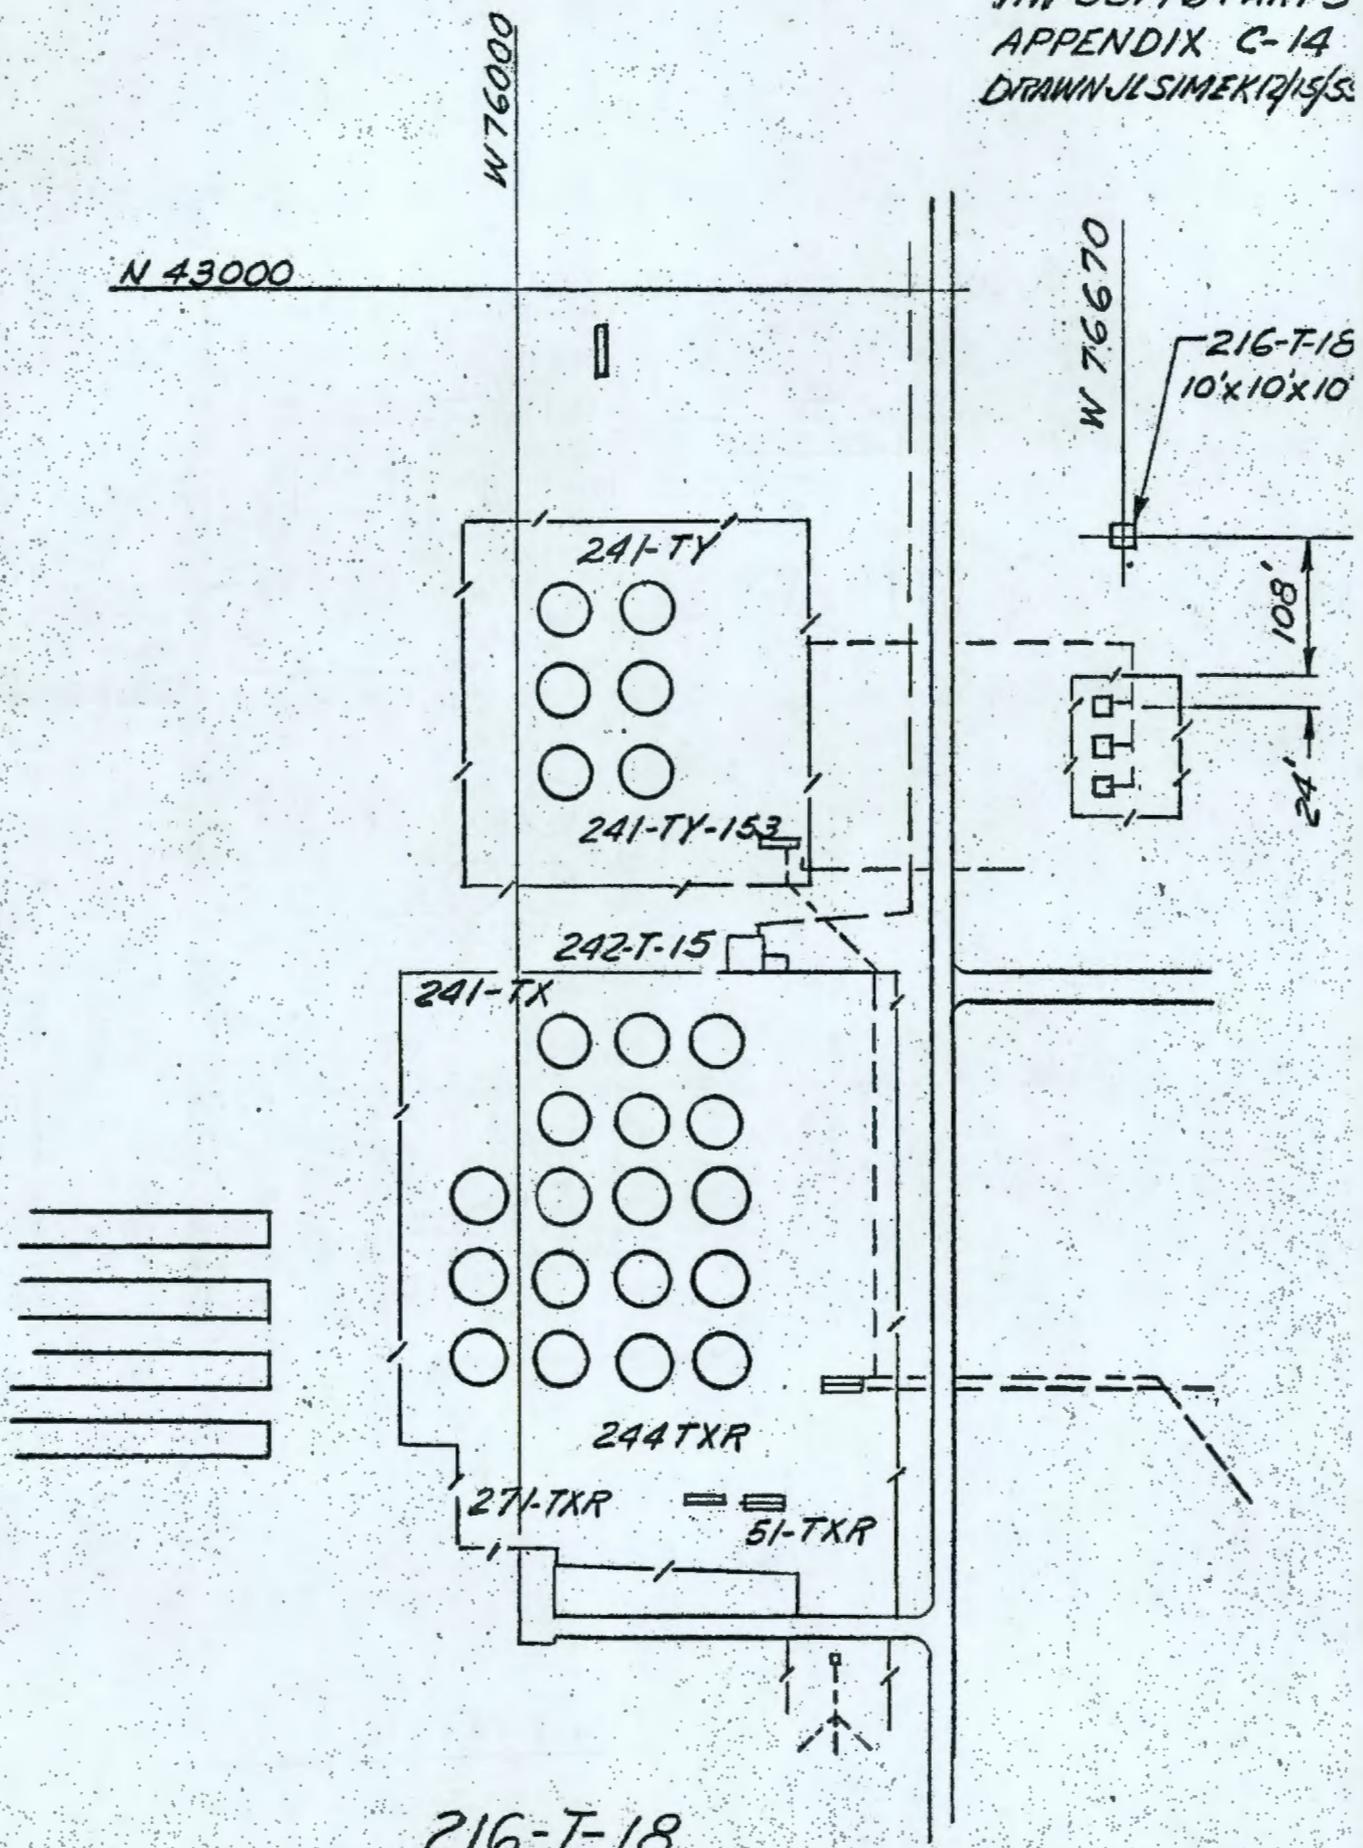


216-T-18
M2600-SHT 11

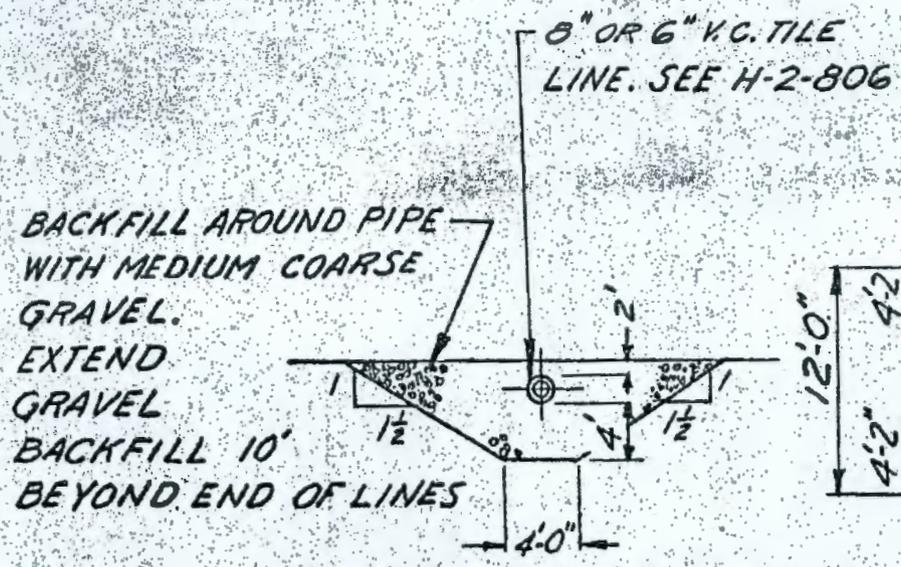

TYP BACKFILL AROUND DRAIN
 PIPE IN TILE FIELD.

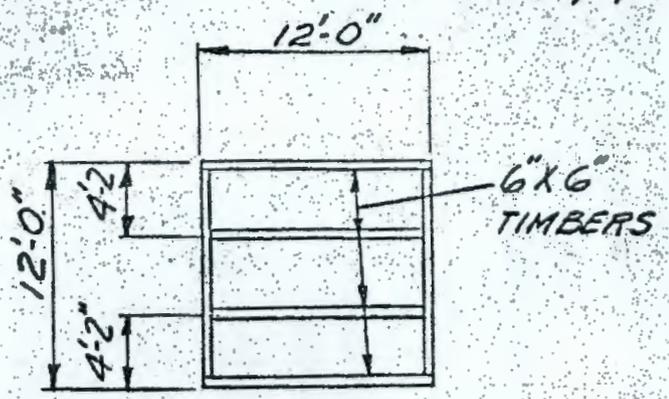


FRAME DETAIL
 18 REQ'D. - ALT. FRAMES
 ROTATED 90° HAVE BRACES

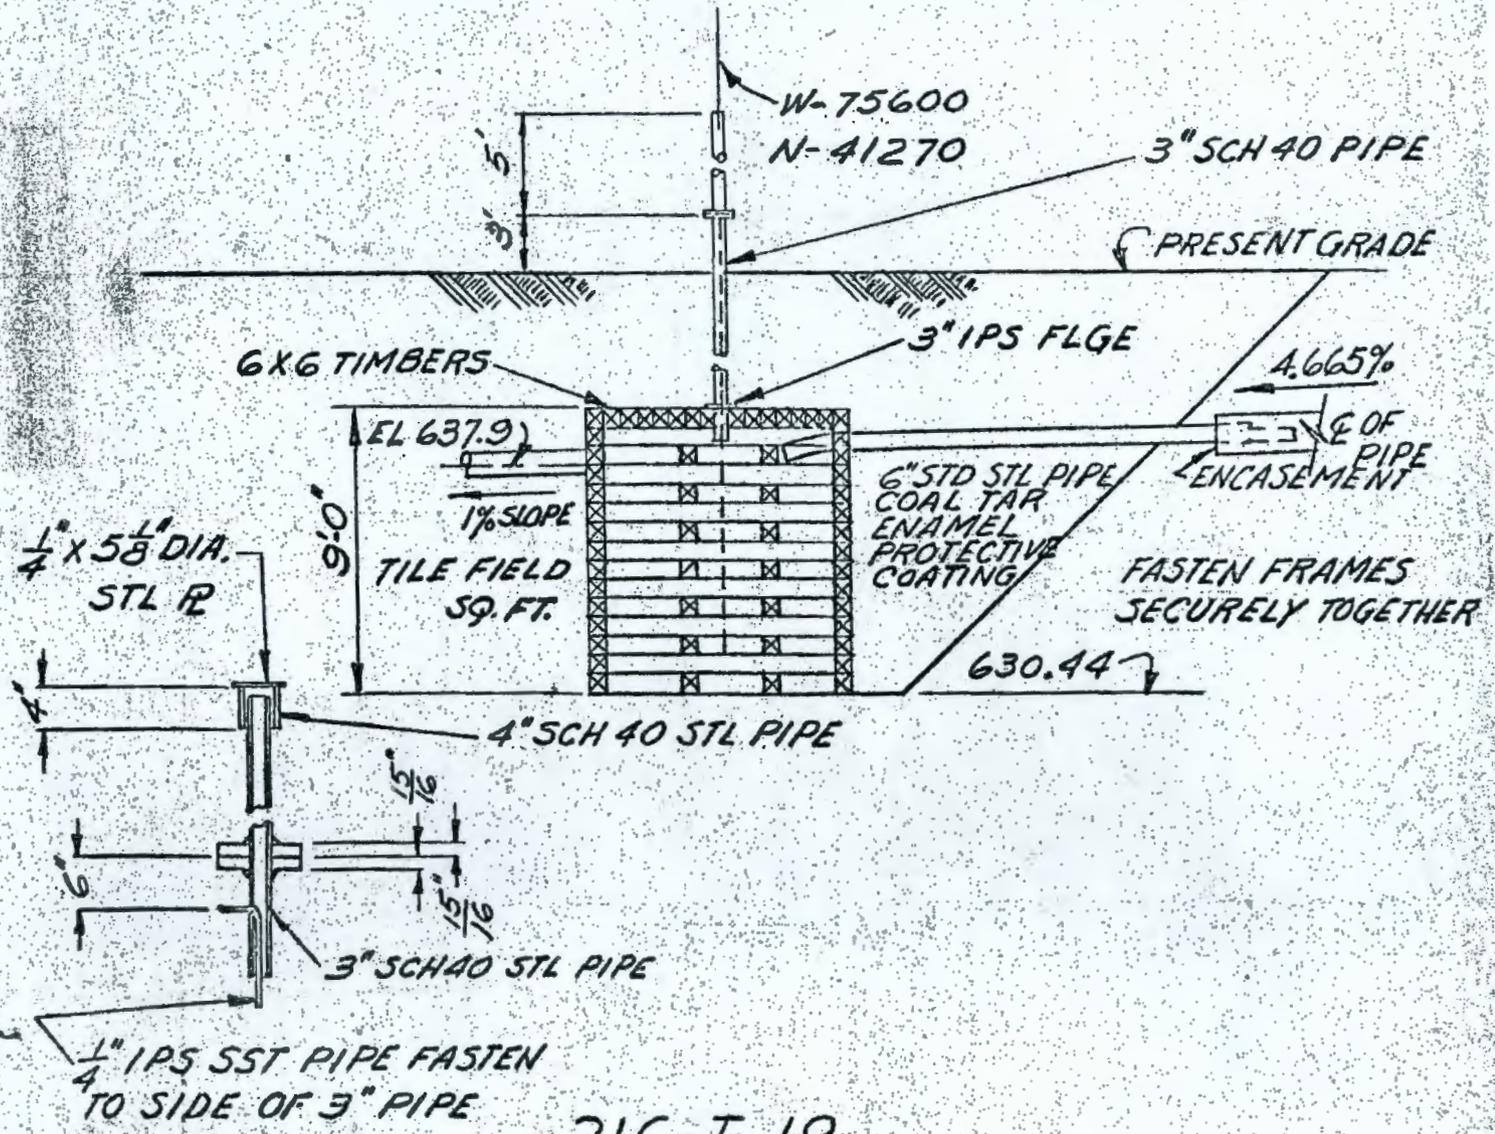


216-T-19
 H-2-806
 H-2-821

HW-55176-PT 5
APPENDIX C-16

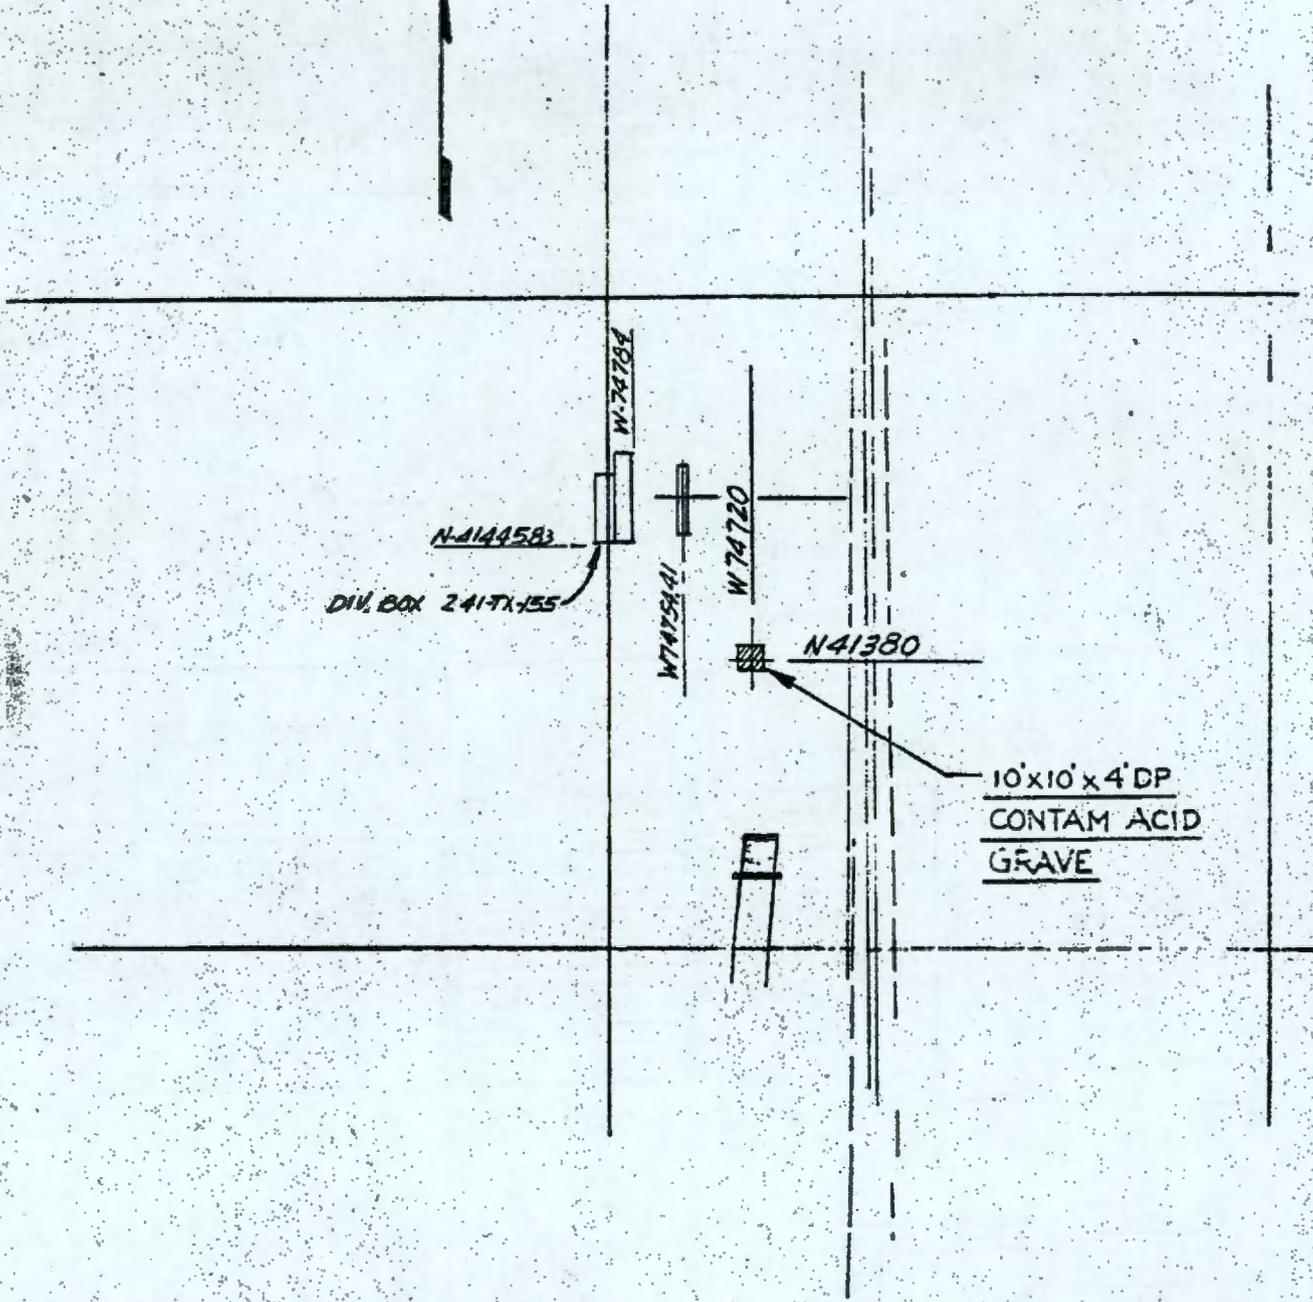


TAKEN FROM M 2892-SHT 14

216-T -20

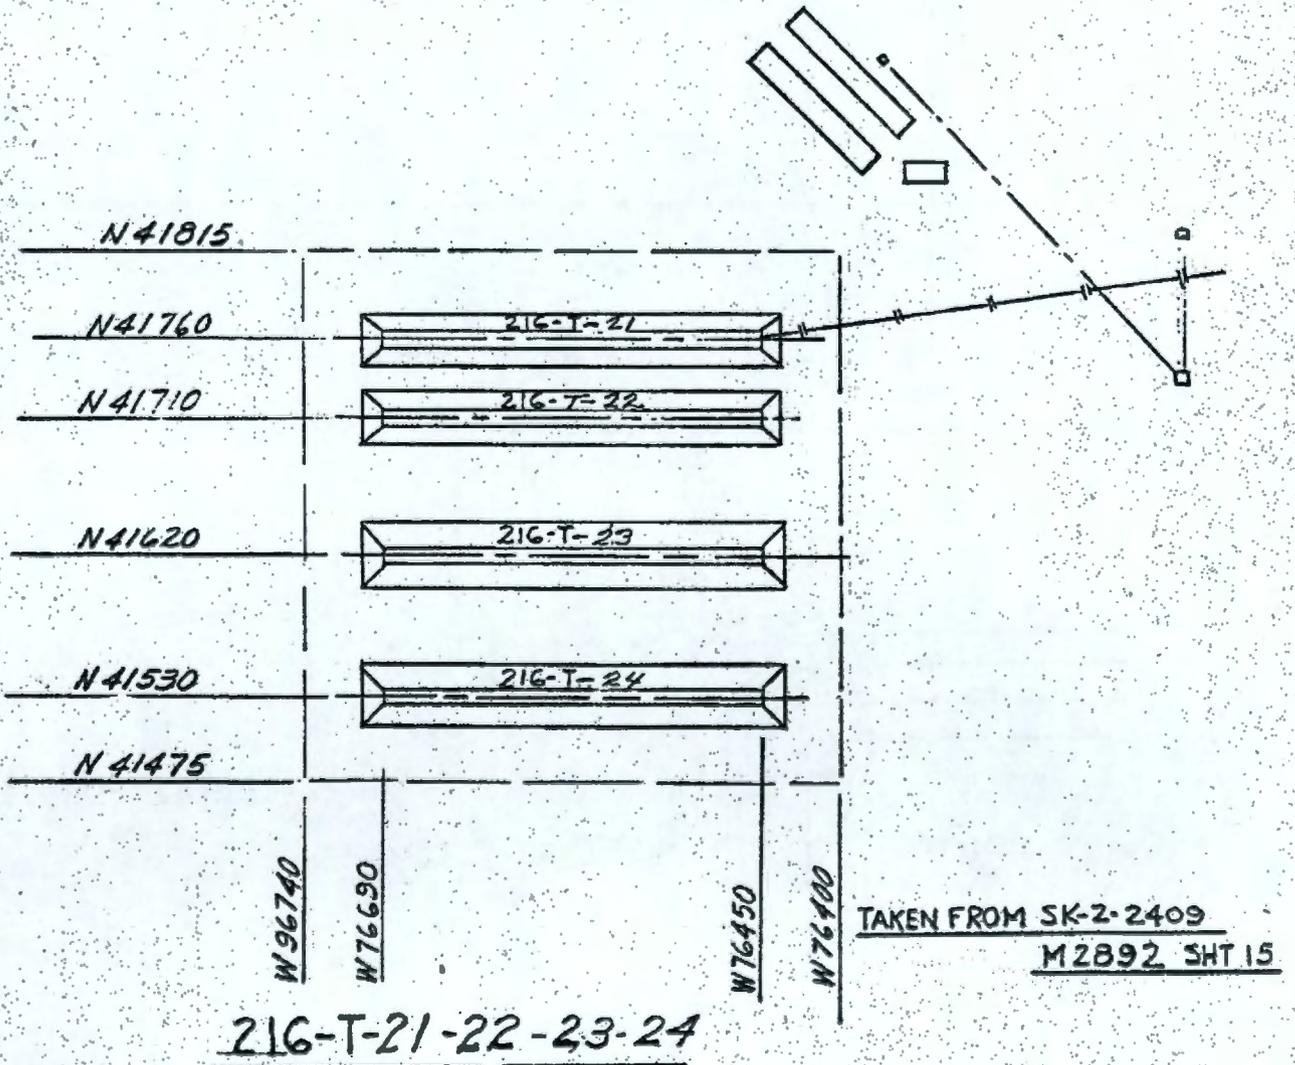


HW-55176-PT E
ZEPHYRUS G-18

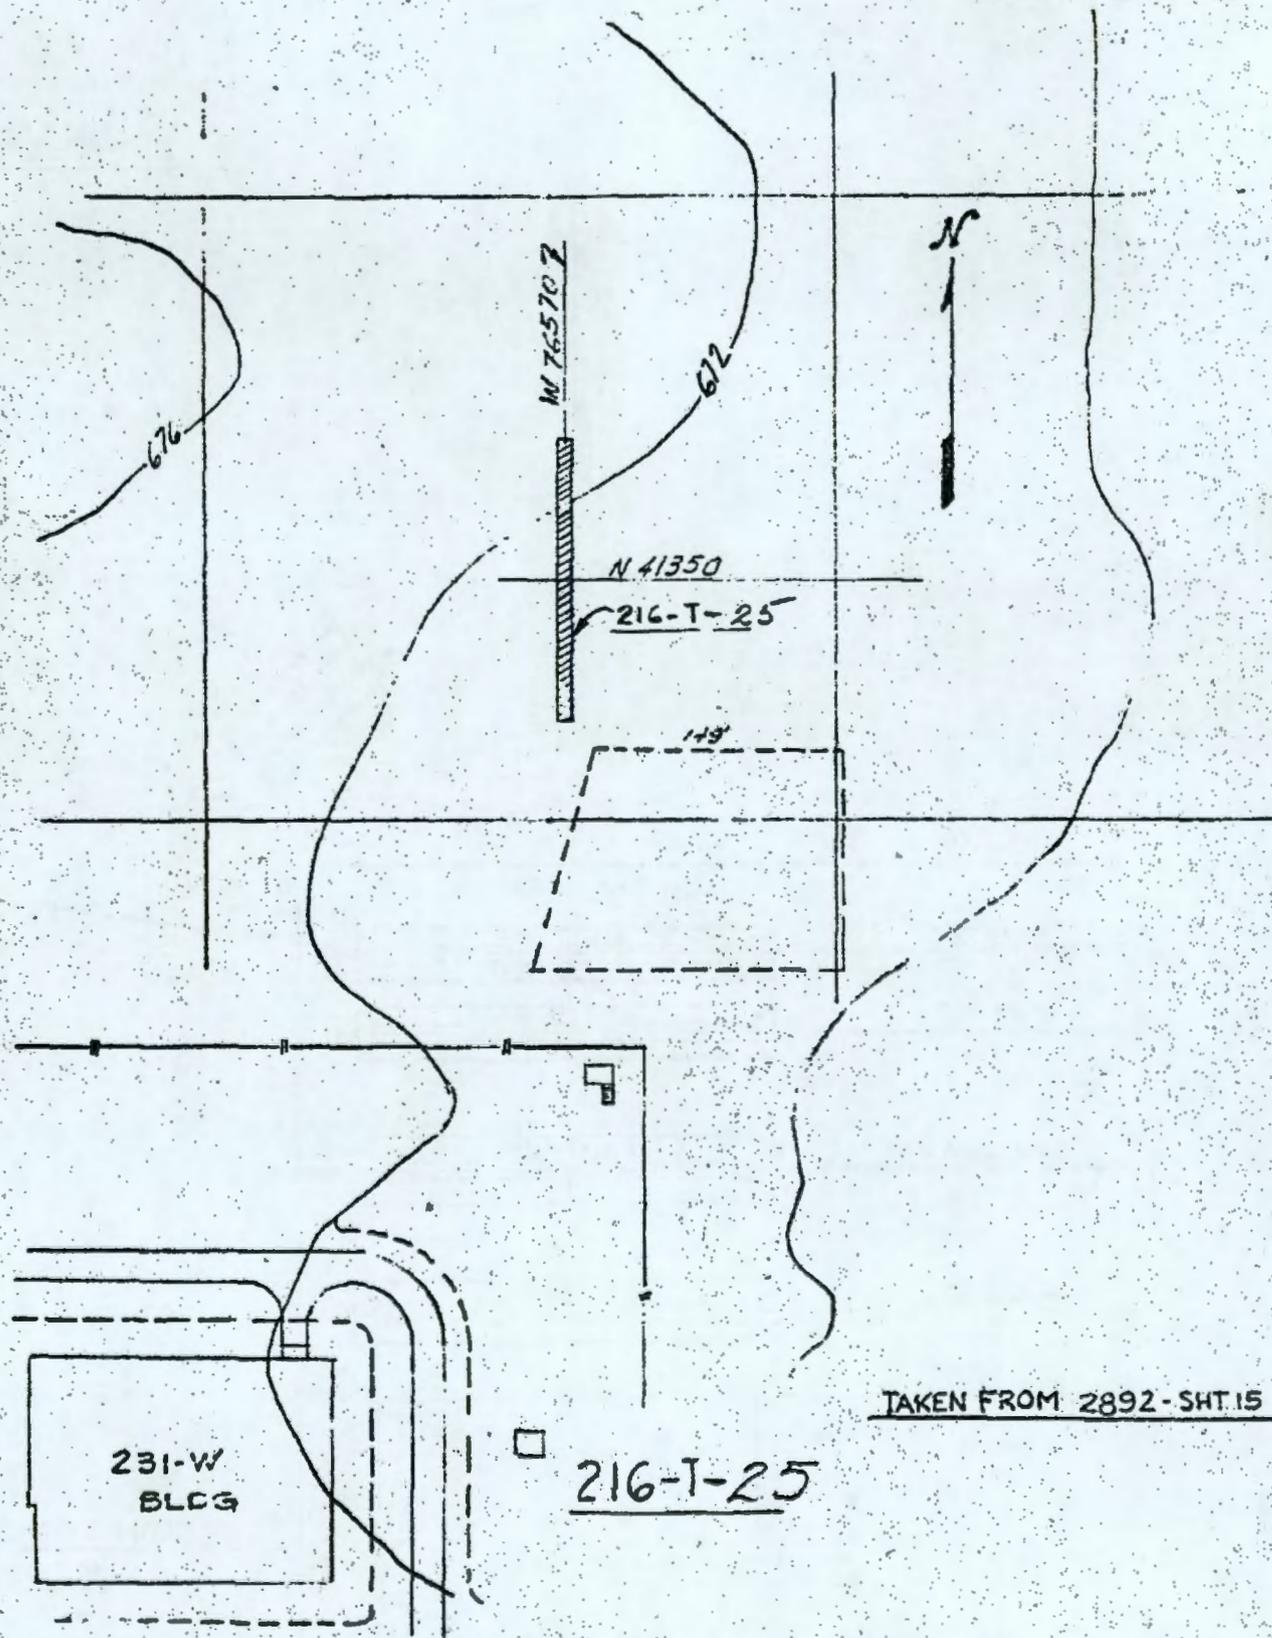

TAKEN FROM 2892-SHT.15


216-T-25

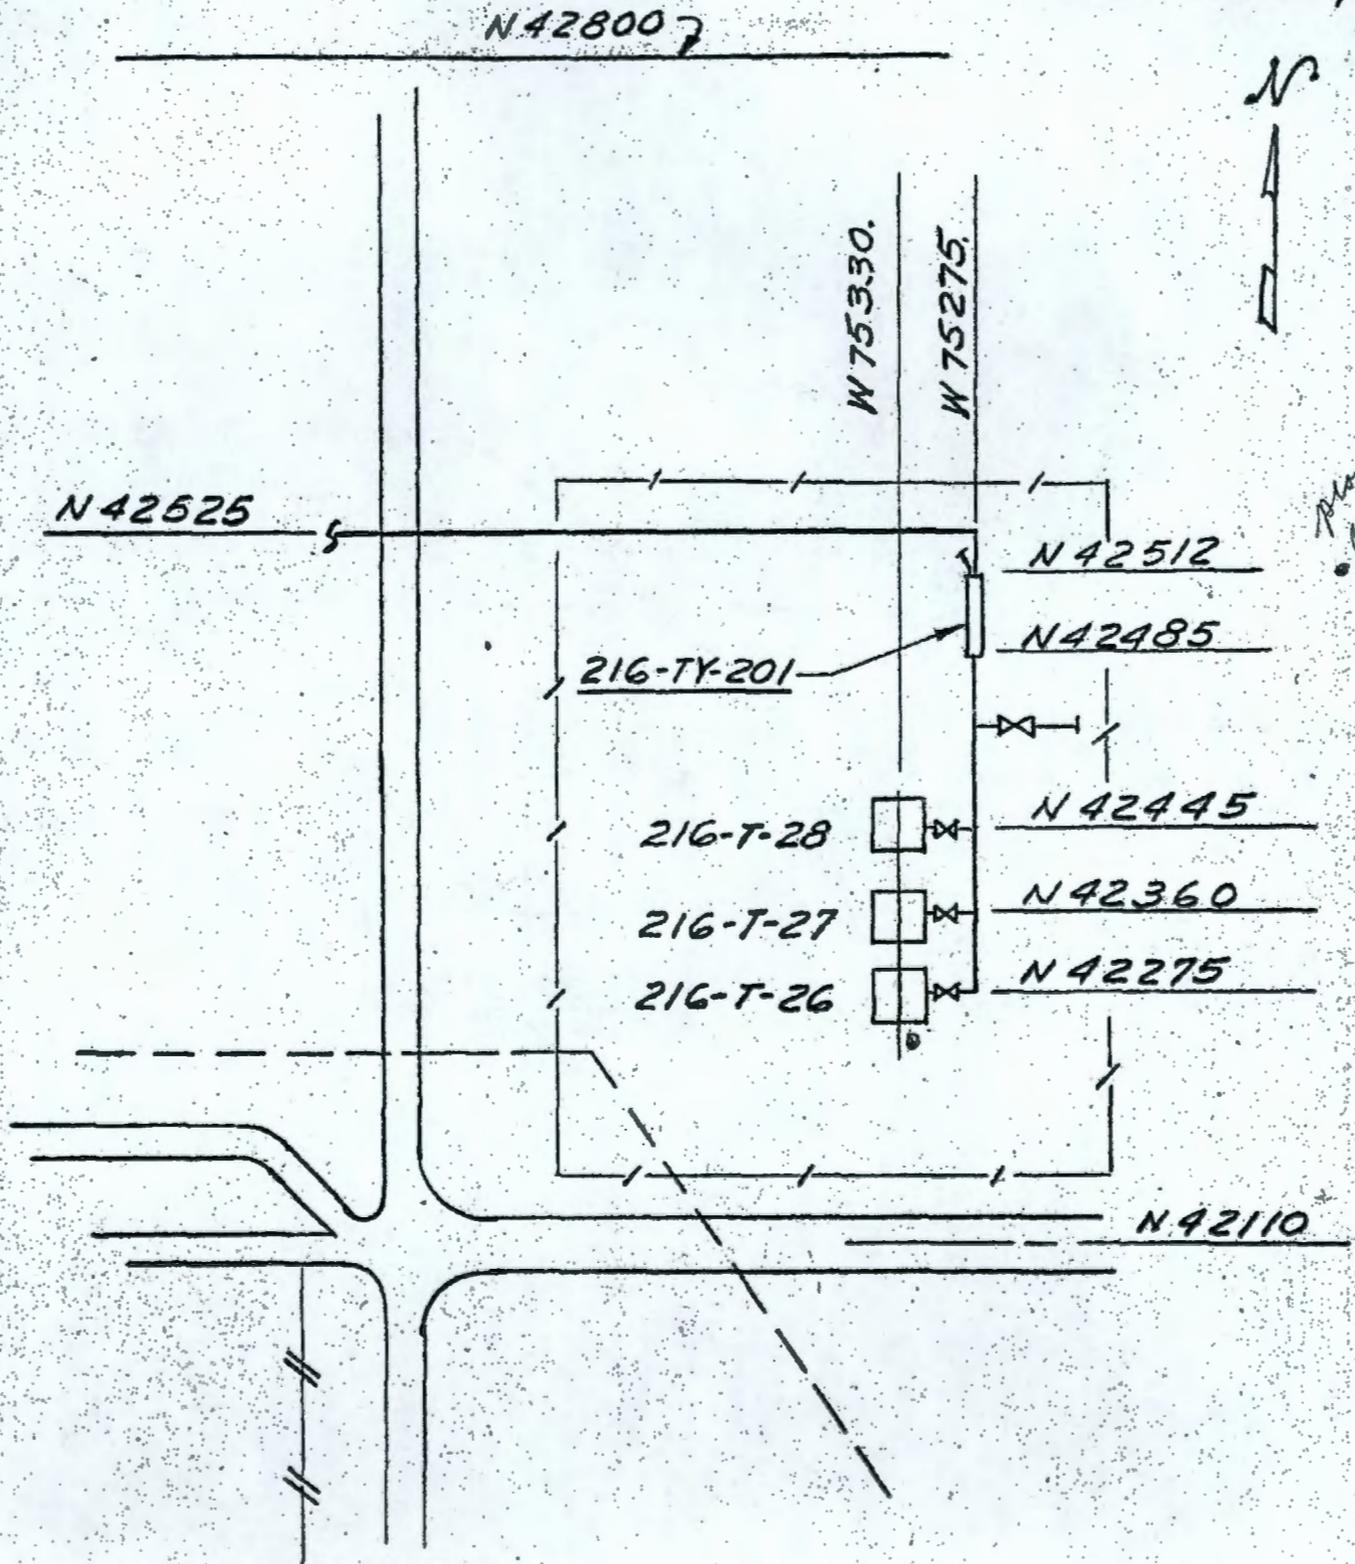


*Proposed
Branch
Well*

216-T-26-27-28
H-2-2733


HW-55176-PT 5
APPENDIX C-20
SHT. NO. 2
JH 10-12-59

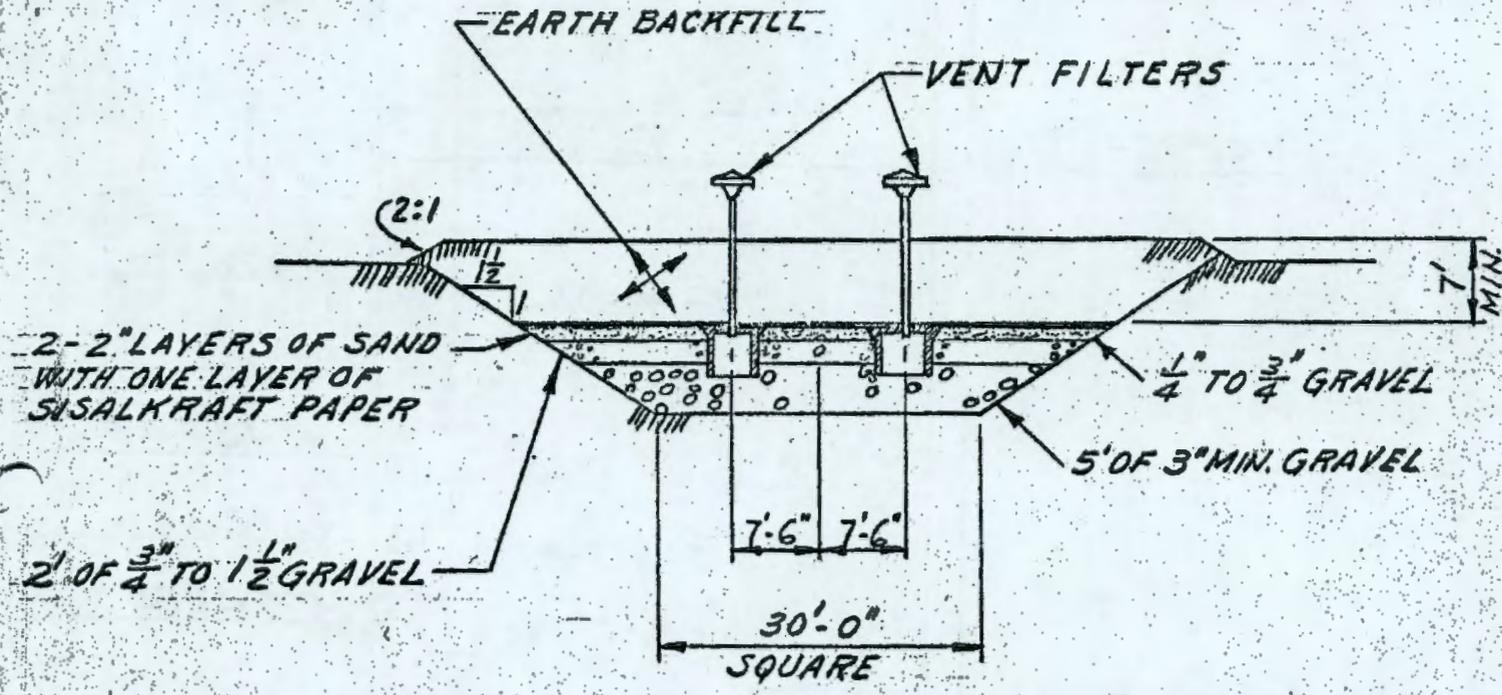

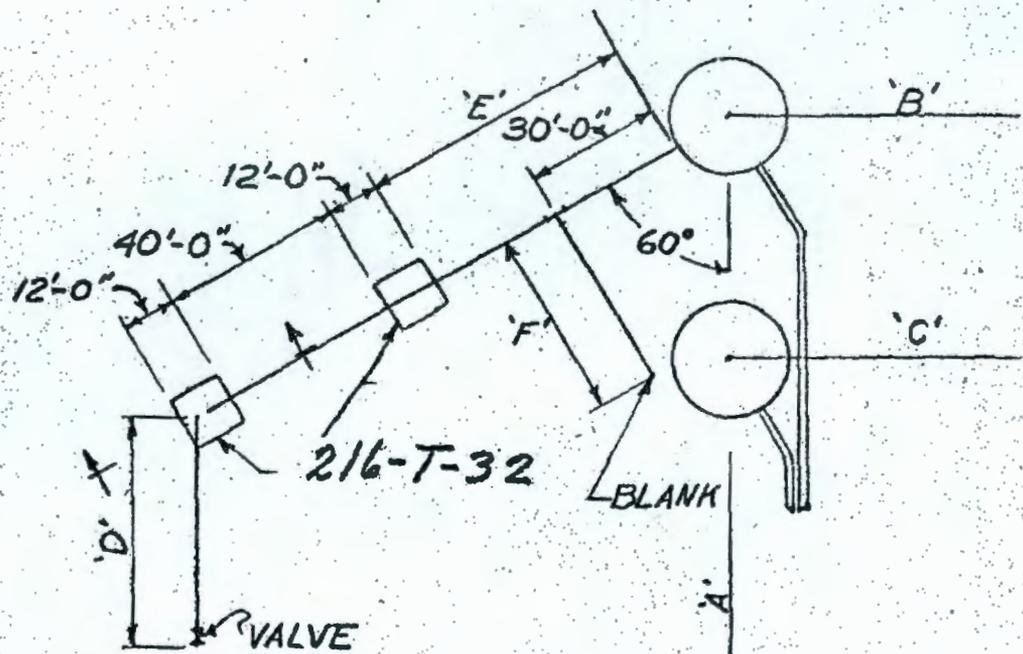


DIM	201-T	241-B
A	W 75937.5	N 45537.5
B	N 43472.5	W 52727.5
C	N 43422.5	W 52777.5
D	50'-0"	
E	60'-0"	84'-0"
F	40'-0"	25'-0"

6" x 6" x 12'-0" LONG TO ENCLOSE
TOP FRAME 26-REQ'D
7 FRAMES REQ'D PER SUMP ALT.
FRAMES TO BE ROTATED 90°

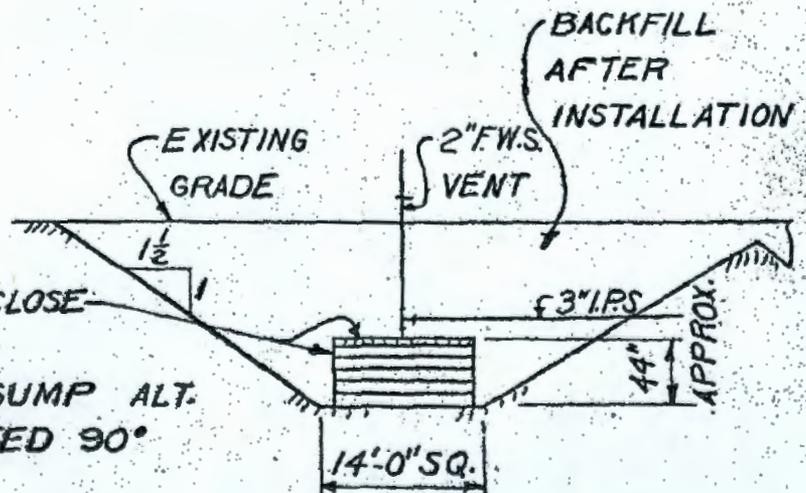

TAKEN FROM H-2-558
V.W. WOOD

ADDITIONAL WASTE FACILITIES IN 200
SERIES TANKS FOR 224 "T" & "B" BLDGS.

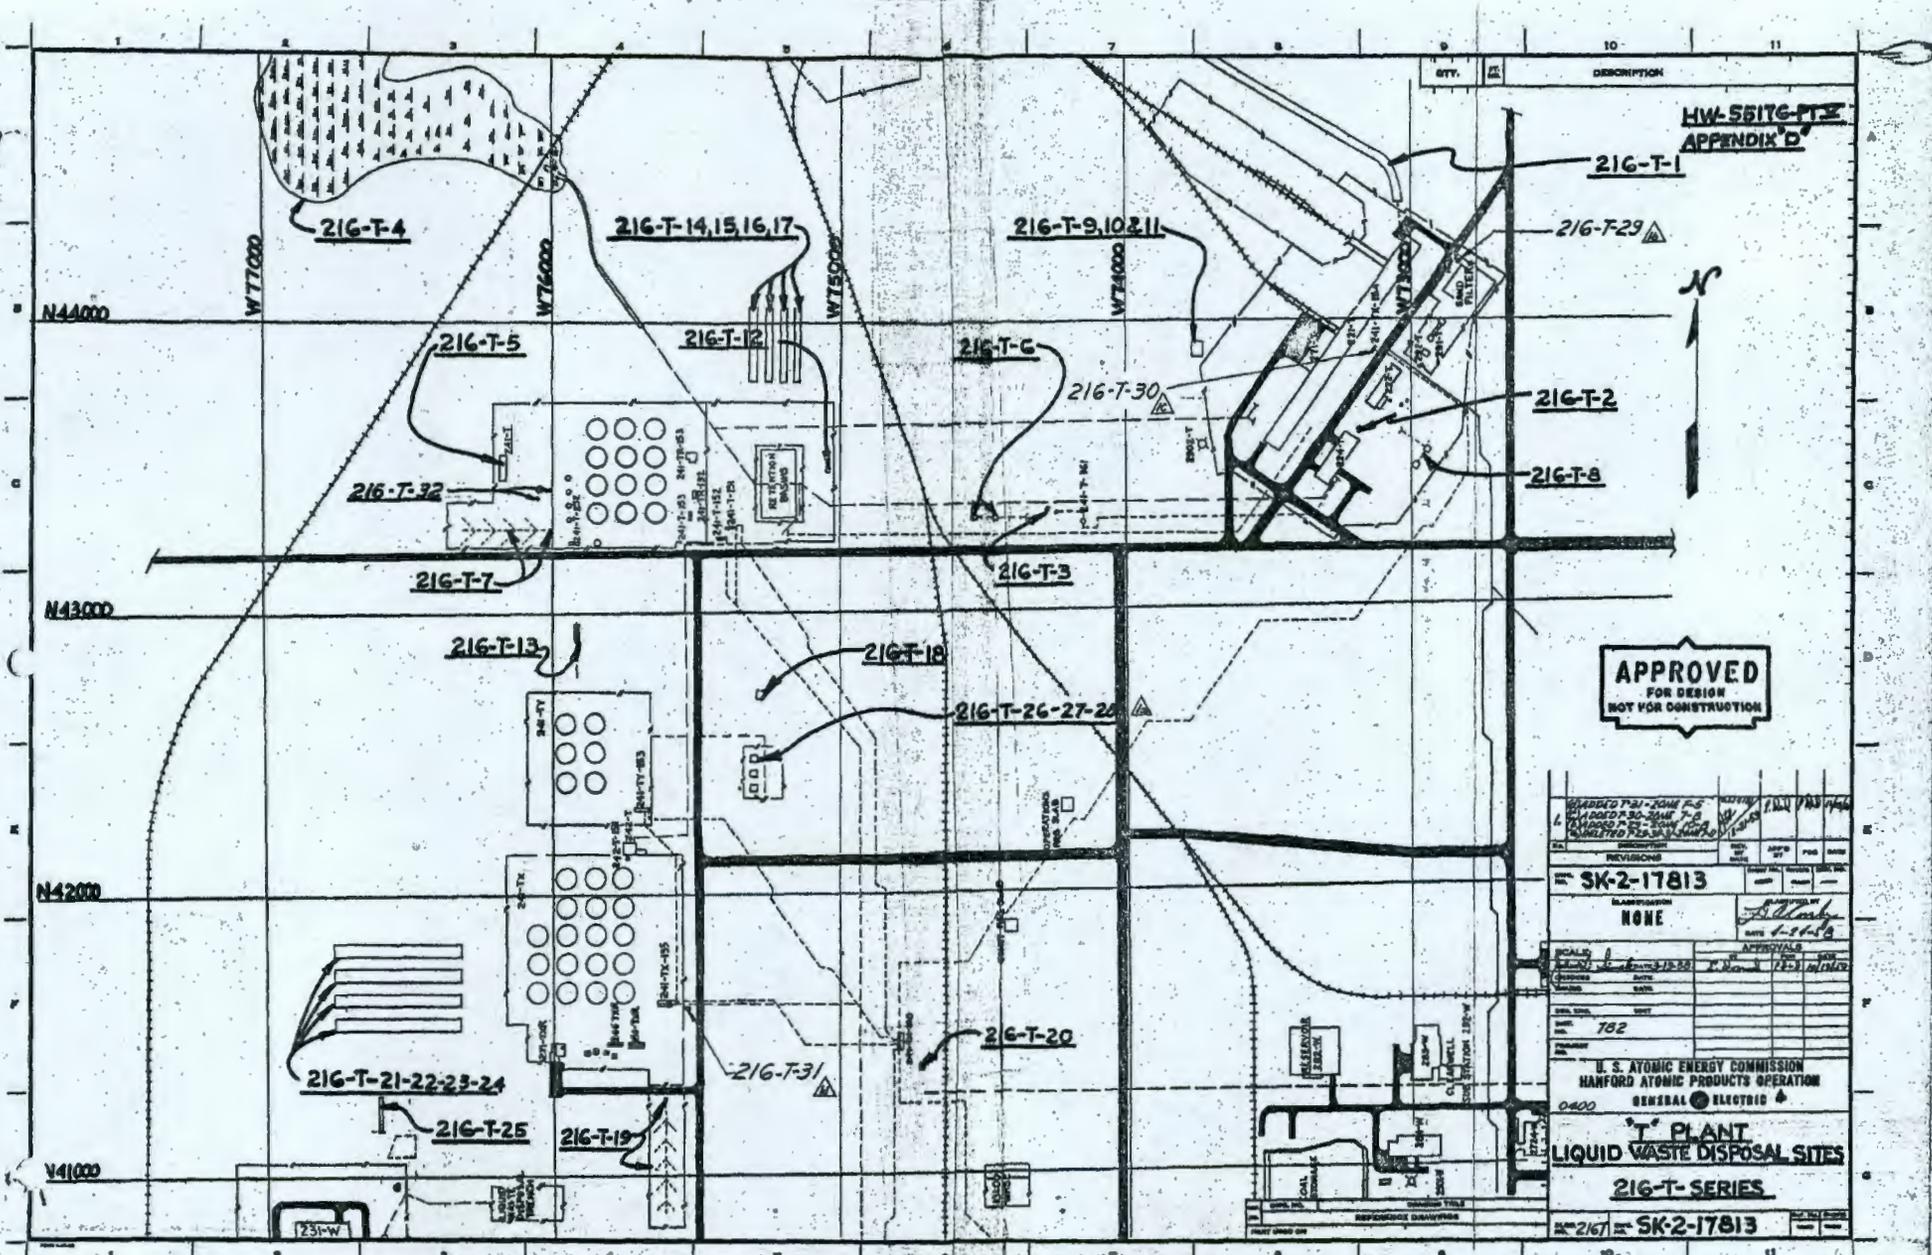

HW-58176-PTX
APPENDIX D

216-T-1

216-T-29

216-T-2

216-T-8

APPROVED
FOR DESIGN
NOT FOR CONSTRUCTION

NO.	DESCRIPTION	DATE	BY	CHKD
1	ISSUED FOR DESIGN	1/24/68	J.M.	J.M.
2	ISSUED FOR DESIGN	2/12/68	J.M.	J.M.
3	ISSUED FOR DESIGN	2/12/68	J.M.	J.M.
SK-2-17813

REVISIONS

SCALE: NONE

DATE: 1/24/68

U. S. ATOMIC ENERGY COMMISSION
HANFORD ATOMIC PRODUCTS OPERATION
GENERAL ELECTRIC

PLANT
LIQUID WASTE DISPOSAL SITES
216-T-SERIES

SK-216/T SK-2-17813

B PLANT

UNCLASSIFIED

HW-55176, Pt. VI
Page 1

INDEX OF CPD CRIB BUILDING NUMBERS
DESIGNS OF CPD RADIOACTIVE LIQUID WASTE
DISPOSAL SITES

Part VI of VII Parts
Process Technology - Study Report

by

V. W. Wood
Radiological Design and Development
Facilities Engineering Operation
CHEMICAL PROCESSING DEPARTMENT

June 18, 1958

D I S T R I B U T I O N

CR Bergdahl	TG LaFollette
JM Bernard	CE Linderoth
WG Browne	WN Mobley
E Doud	HE Parker
J Durbin	HF Peterson
JB Fecht	DW Pearce
DR Gustavson	OH Pilkey
CT Groswith	EL Reed
WA Haney ←	RA Roberts
JF Honstead	HP Shaw
IM Jacques	ML Short
EB Jackson	VW Wood
CE Kent	300 Files

UNCLASSIFIED

UNCLASSIFIED

HW-55176, Pt. VI
Page 2

INDEX OF CPD CRIB BUILDING NUMBERS
DESIGNS OF CPD RADIOACTIVE LIQUID WASTE
DISPOSAL SITES

Part VI of VII Parts
Process Technology - Study Report

INTRODUCTION

During the fourteen years or more which the separations areas have operated, many sites have been used for the disposal of radioactive liquid wastes. Various methods have been used in assigning building numbers to these sites and, in a number of cases, changes have been made which have brought about some confusion. One of the reasons being some currently used building numbers do not agree with the numbers existing on design prints for the facilities. Reference (2) was an effort to establish a listing of the liquid waste disposal sites. It required considerable time and research to locate information concerning these sites.

Many varied designs have been used for the disposal of radioactive liquid wastes. Reverse wells, trenches, cribs or caverns, etc., have been used. Specific information on these facilities is often difficult to obtain for in some instances they were constructed on work orders with no records being retained on the design. In general, the design on each facility has been different. This has made it extremely difficult for people to have a good working knowledge of the various waste disposal sites.

PURPOSE

The purpose of this report (Part VI) is to provide a ready reference of the "B" Plant liquid waste disposal sites as well as a compilation of sketches showing the basic information on the design of each facility.

Another objective is to establish a simplified and uniform numbering system. Still another objective is to provide an up-to-date tabulation. Subsequent parts of this report will provide information on cribs for other areas.

SUMMARY AND CONCLUSIONS

All radioactive liquid waste disposal sites should have the 216 Building number designation. These should be further grouped by giving all such sites for Purex a prefix of 216-A. Other major series would be 216-S for Redox; 216-T for "T" Plant; 216-B for "B" Plant; 216-U for "U" Plant and 216-Z for "Z" Plant.

UNCLASSIFIED

The numbering list in "Official Hanford Works Building List - Specification HW-5000" by Engineering Files - Construction Engineering Operation should be revised to more closely follow the above numbering system.

RECOMMENDATIONS

It is recommended that the following action be taken:

1. All groups and services referring to the "B" Area cribs or report data concerning them should use the index numbering system as presented in this report. In the case of B Plant this means several changes. See cross reference, page 4.
2. That all drawings concerning these disposal sites, including maps, be revised to show the proper locations and numbers for these cribs.
3. Any suggestions for improving the usefulness of this report should be referred to the author.

DISCUSSION

When all seven parts of the report are completed, and the work outlined in the report is completed, much confusion will be eliminated and more people will be better informed on the design of each waste disposal facility. The report will provide a firm basis for future building number assignments.

While some sincere efforts have been made to try and keep a methodical system for recording waste disposal sites, a number of problems have developed, for example, HW-5000, Sheet 29 of 50, lists only eight cribs in the 216-S series. Also reference 2 has assigned numbers which do not agree with the crib numbers assigned on many drawings.

As indicated earlier, the use of the crib index, as presented in this report should be very easy. In addition, information is presented which is very difficult to locate in the records and in some cases it is not available in the records.

REFERENCES

1. HW-5000, "Official Hanford Works Building List - Specification HW-5000" by Engineering Files - Construction Engineering Operation.
2. HW-43121, "Tabulation of Radioactive Liquid Waste Disposal Facilities by HV Clukey dated May 10, 1956.
3. HW-33305, "Tabulation of Radioactive Liquid Waste Disposal Facilities" by HV Clukey dated October 8, 1954.
4. HW-41535, "Unconfined Underground Radioactive Waste and Contamination in the 200 Areas" by KR Heid dated January 17, 1956.

UNCLASSIFIED

HW-55176, Pt. VI
Page 4

CROSS REFERENCE
"B" AREA RADIOACTIVE LIQUID WASTE
DISPOSAL SITES

<u>Suggested Crib No.</u>	<u>Number Listed in HW-5000</u>	<u>Number Listed in HW-43121</u>	<u>Number Used On Drawings or Original Number</u>	<u>Remarks</u>
216-B-1	216-B-1	None	216-B-1	H-2-2933
216-B-2	None	216-B-2	None	'B' Plant Ditch
216-B-3	None	216-B-3	None	'B' Plant Swamp
216-B-4	None	216-B-4	None	French Drain
216-B-5	None	216-B-5	241-B-361	Reverse Well
216-B-6	None	216-B-6	222-B-110	Reverse Well
216-B-7a & b	241-B-1 & 2	216-B-7	241-B-1 & 2	
216-B-8	241-B-3	216-B-8	241-B-3	Crib & Tile Field
216-B-9	216-361-B	216-B-9	241-B-361	
216-B-10a & b	222-B-1 & 2	216-B-10	222-B-1 & 2	
216-B-11a & b	242-B-1 & 2	216-B-11	242-B-1 & 2	
216-B-12	216-ER	216-B-12	216-ER-1, 2 & 3	
216-B-13	291-B	216-B-13		French Drain
216-B-14	216-BC-1	216-BC-1	216-BC-1	H-2-2907
216-B-15	216-BC-2	216-BC-2	216-BC-2	H-2-2907
216-B-16	216-BC-3	216-BC-3	216-BC-3	H-2-2907
216-B-17	216-BC-4	216-BC-4	216-BC-4	H-2-2907
216-B-18	216-BC-5	216-BC-5	216-BC-5	H-2-2907
216-B-19	216-BC-6	216-BC-6	216-BC-6	H-2-2907
216-B-20	216-BC-7	None	216-BC-7	H-2-3203
216-B-21	216-BC-8	None	216-BC-8	H-2-3203
216-B-22	216-BC-9	None	216-BC-9	H-2-3203
216-B-23	216-BC-10	None	216-BC-10	H-2-3232
216-B-24	216-BC-11	None	216-BC-11	H-2-3232
216-B-25	216-BC-12	None	216-BC-12	H-2-3232
216-B-26	216-BC-13	None	216-BC-13	H-2-3232
216-B-27	216-BC-14	None	216-BC-14	H-2-3232
216-B-28	216-BC-15	None	216-BC-15	H-2-3232
216-B-29	216-BC-16	None	216-BC-16	H-2-3336
216-B-30	216-BC-17	None	216-BC-17	H-2-3336
216-B-31	216-BC-18	None	216-BC-18	H-2-3336
216-B-32	216-BC-19	None	216-BC-19	H-2-3336
216-B-33	216-BC-20	None	216-BC-20	H-2-3336
216-B-34	216-BC-21	None	216-BC-21	H-2-3336
216-B-35	None	216-BX-1	216-BX-1	
216-B-36	None	216-BX-2	216-BX-2	
216-B-37	None	216-BX-3	216-BX-3	
216-B-38	None	216-BX-4	216-BX-4	
216-B-39	None	216-BX-5	216-BX-5	
216-B-40	None	216-BX-6	216-BX-6	

UNCLASSIFIED

<u>Suggested Crib No.</u>	<u>Number Listed in HW-5000</u>	<u>Number Listed in HW-43121</u>	<u>Number Used On Drawings or Original Number</u>	<u>Remarks</u>
216-B-41	None	216-BX-7	216-BX-7	
216-B-42	None		216-BX-8	
216-B-43	216-BY-1	216-BY-1	216-BY-1	H-2-2603
216-B-44	216-BY-2	216-BY-2	216-BY-2	H-2-2603
216-B-45	216-BY-3	216-BY-3	216-BY-3	H-2-2603
216-B-46	216-BY-4	216-BY-4	216-BY-4	H-2-2603
216-B-47	216-BY-5	216-BY-5	216-BY-5	H-2-2603
216-B-48	216-BY-6	216-BY-6	216-BY-6	H-2-2603
216-B-49	216-BY-7	216-BY-7	216-BY-7	H-2-2603
216-B-50	216-BY-8	216-BY-8	216-BY-8	H-2-2603
216-B-51	216-BY-9	216-BY-9	216-BY-9	H-2-2908

APPENDIXA. Explanation of Parts to the Report

Part I will cover the Purex Radioactive Liquid Waste Disposal Sites.

Part II will cover the "Z" Plant Radioactive Liquid Waste Disposal Sites.

Part III will cover the Redox Plant Radioactive Liquid Waste Disposal Sites.

Part IV will cover the "U" Plant Radioactive Liquid Waste Disposal Sites.

Part V will cover the "T" Plant Radioactive Liquid Waste Disposal Sites.

Part VI will cover the "B" Plant Radioactive Liquid Waste Disposal Sites.

Part VII will cover the "C" Plant, Hot Semi-Works, the 200 North Areas and miscellaneous.

B. Index for "B" Plant Radioactive Liquid Waste Disposal Sites.

C. Sketches of "B" Plant Waste Disposal Facilities.


D. Map of "B" Plant Sites (SK-2-17840).

CRIB INDEX
B PLANT

Number	Description Appendix Sheet	Service	Use Dates		Status
			From	To	
216-B-1	None	Not built	-	-	-
216-B-2	C-2	Cooling Water and Chemical Sewer	4/45	-	Active
216-B-3	C-3	Cooling Water & Chemical Sewer	4/45	-	Active
216-B-4	C-4 & 5	292-B Floor Drain	4/45	12/49	Abandoned
216-B-5	C-6	224-B and 5-6 Wastes	4/45	10/47	Abandoned
216-B-6	C-7 & 8	222-B Wastes	4/45	12/49	Abandoned
216-B-7	C-9 & 10	224-B Wastes & 5-6 Cell Drain	9/46	1958	Abandoned
216-B-8	C-11 & 12	224-B, 5-6 and 2nd Cycle Wastes	1945	1952	Abandoned
216-B-9	C-13 & 14	5-6 and 2nd Cycle Wastes	8/48	7/51	"
216-B-10	C-15 & 16	222-B and 292-B Wastes	12/49	1958	"
216-B-11	C-17 & 18	242-B Condensate	12/51	11/54	"
216-B-12	C-19 & 20	U Plant Condensate	11/52	1957	"
216-B-13	C-21 & 22	291-B Stack Drain	4/45	-	Active
216-B-14	C-23, 23A & 24	U Plant Scavenged Waste	1/56	2/56	Abandoned
216-B-15	" " " " " "	" " " " " "	4/56	12/57	"
216-B-16	" " " " " "	" " " " " "	4/56	8/56	"
216-B-17	" " " " " "	Tank Farm Scavenged Waste		1/56	"
216-B-18	" " " " " "	U Plant Scavenged Waste	3/56	4/56	"
216-B-19	" " " " " "	U Plant and Tank Farm Scavenged	2/57	10/57	"
216-B-20	C-25, 26 & 26A	" " " " " "	8/56	9/56	Spec. Ret.
216-B-21	" " " " " "	" " " " " "	9/56	-	" "
216-B-22	" " " " " "	" " " " " "	10/56	-	" "
216-B-23	C-26, 27 & 28	" " " " " "	10/56	-	" "
216-B-24	" " " " " "	U Plant Scavenged Waste	10/56	11/56	" "
216-B-25	" " " " " "	" " " " " "	11/56	12/56	" "
216-B-26	" " " " " "	" " " " " "	12/56	1/57	" "
216-B-27	" " " " " "	" " " " " "	2/57	4/57	" "
216-B-28	" " " " " "	U Plant & Tank Farm Scavenged	4/57	5/57	" "
216-B-29	C-29 & 30	U Plant Scavenged Waste	6/57	-	" "
216-B-30	" " " " " "	U Plant and Tank Farm Scavenged	6/57	-	" "
216-B-31	" " " " " "	" " " " " "	7/57	-	" "
216-B-32	" " " " " "	" " " " " "	8/57	9/57	" "
216-B-33	" " " " " "	" " " " " "	9/57	10/57	" "
216-B-34	" " " " " "	" " " " " "	10/57	11/57	" "
216-B-35	C-31 & 32	1st Cycle Supernatant	2/54	-	" "
216-B-36	" " " " " "	" " " " " "	4/54	-	" "
216-B-37	" " " " " "	Evaporator Bottoms	8/54	9/54	" "
216-B-38	" " " " " "	1st Cycle Supernatant	7/54	-	" "
216-B-39	" " " " " "	" " " " " "	12/53	11/54	" "
216-B-40	" " " " " "	" " " " " "	4/54	8/54	" "


CRIB INDEX B PLANT (cont.)

Number	Description		Service	Use Dates		Status
	Appendix	Sheet		From	To	
216-B-41	C-31	& 32	1st Cycle Supernatant	11/54	-	Spec. Ret.
216-B-42	"	"	U Plant Scavenged Waste	2/55	-	" "
216-B-43	C-33		U Plant Scavenged Waste	11/54	-	Abandoned
216-B-44	C-33		"	12/54	3/55	"
216-B-45	C-33		"	4/55	6/55	"
216-B-46	C-33		"	9/55	12/55	"
216-B-47	C-33		"	9/55	-	"
216-B-48	C-33		"	11/55	2/57	"
216-B-49	"		"	11/55	12/55	"
216-B-50	"		"	Not Used		"
216-B-51	C-34	& 35	Pipe Line Drain	Not Used		Abandoned
216-B-52	C-26,	27 & 28	Tank Farm Scavenged Waste	12/57	1/58	Spec. Ret.

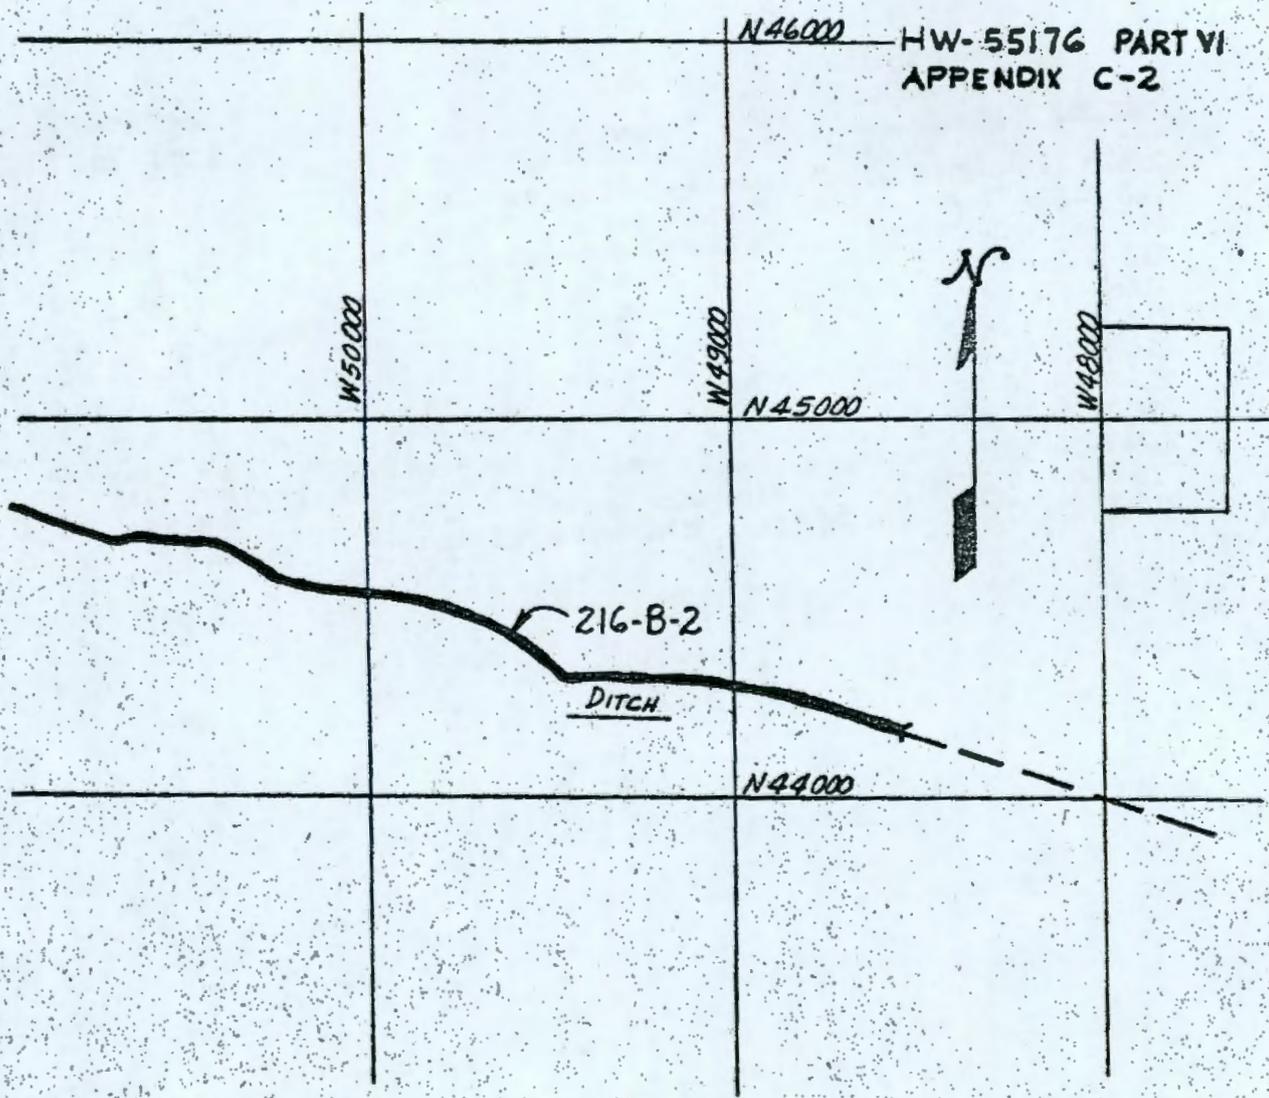

216-B-2


HW-55176 PART VI
APPENDIX C-3

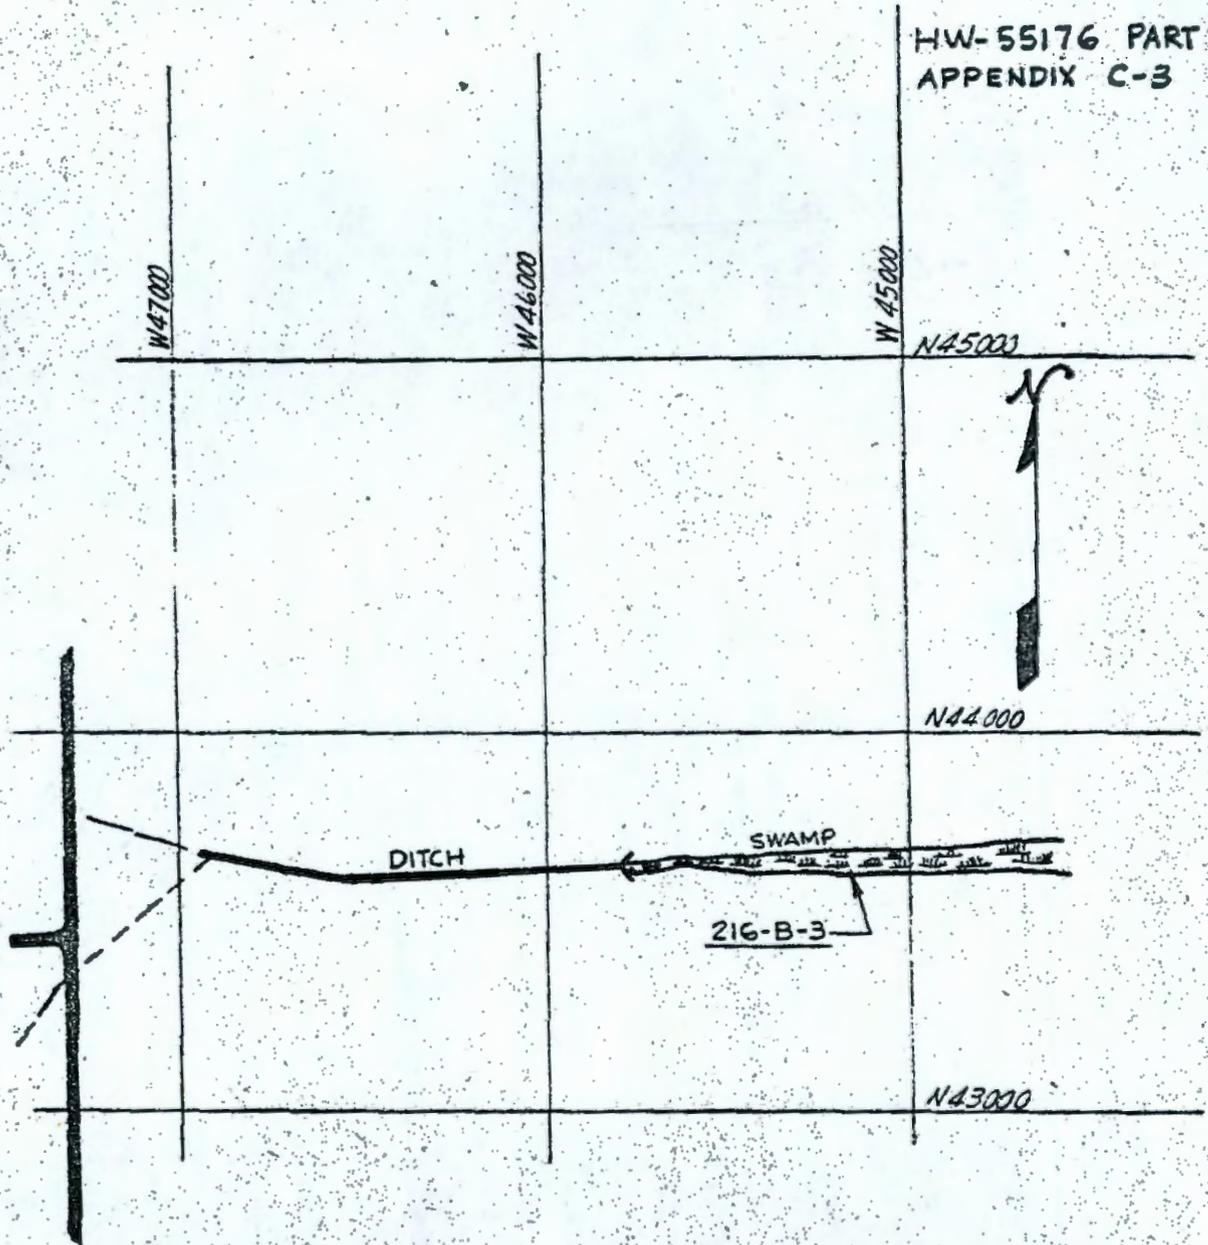


216-B-3

4

HW-55176 PART VI
APPENDIX C-4

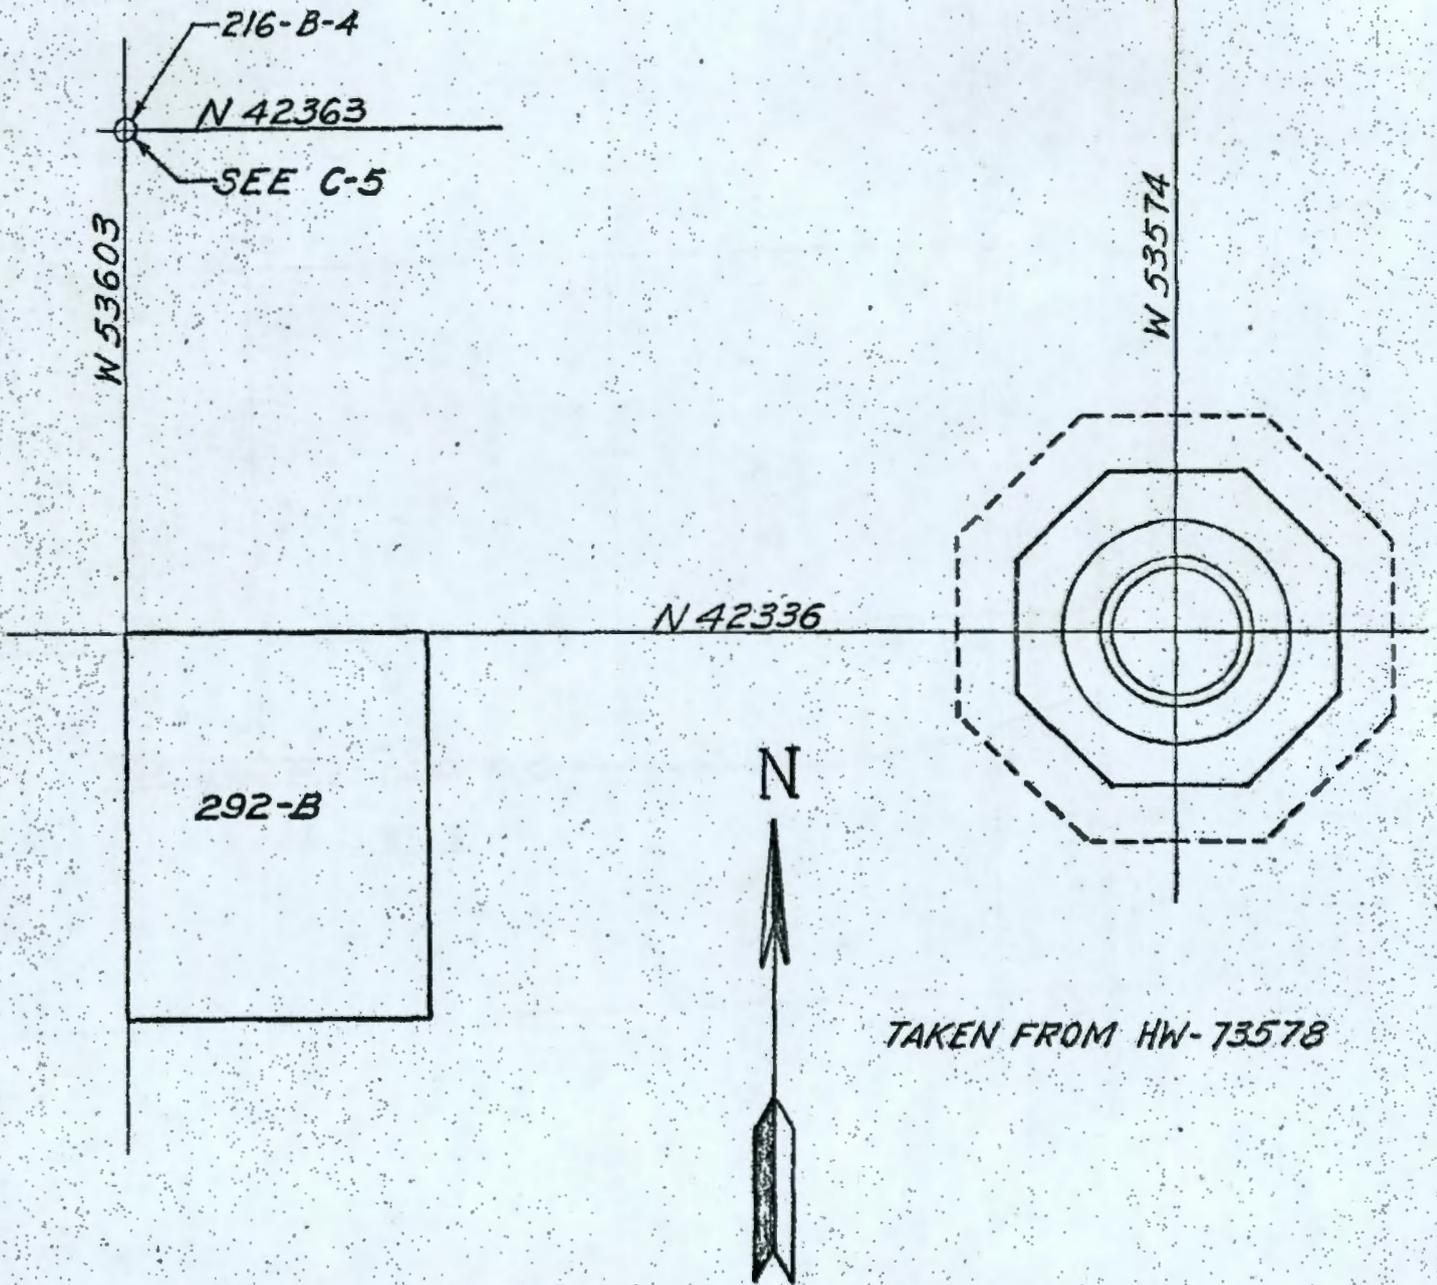


216-B-4

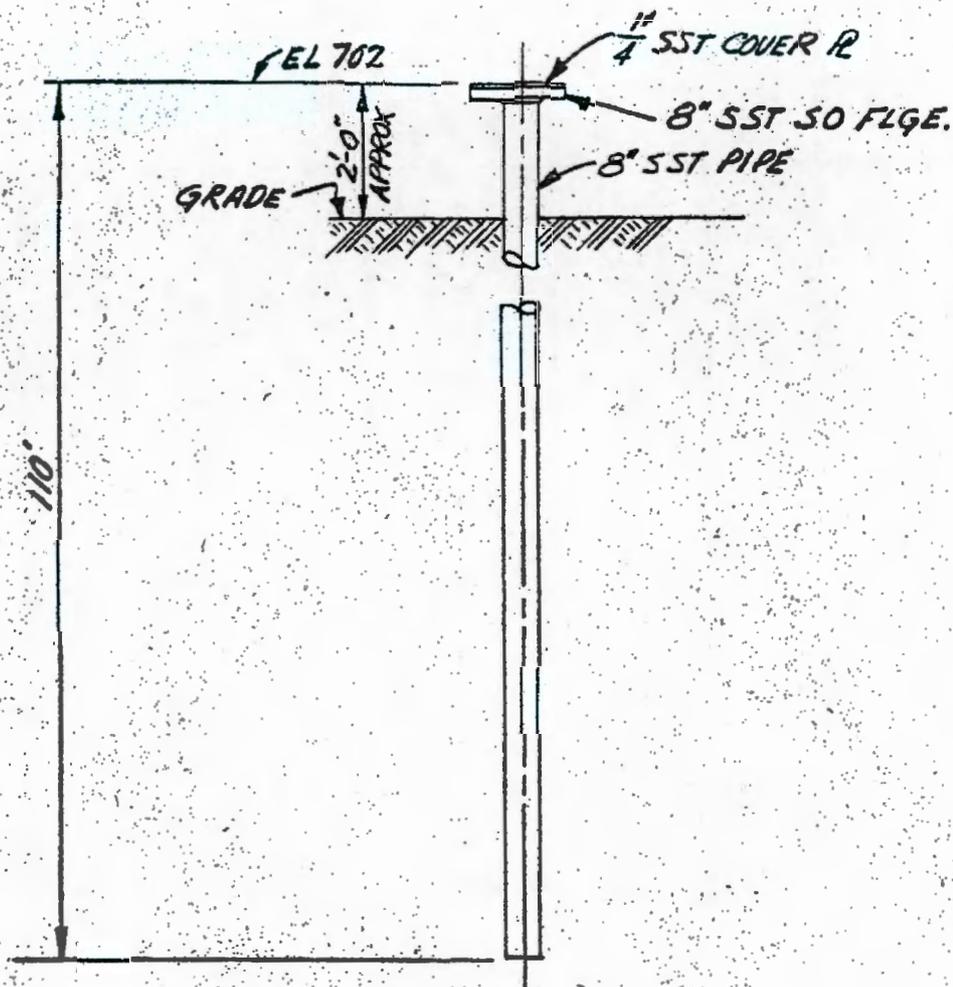

TAKEN FROM H-2-1100

216-B-4

HW-55176-PART 6
APPENDIX C-6
DRAWN JLS/MEK 12/19/65

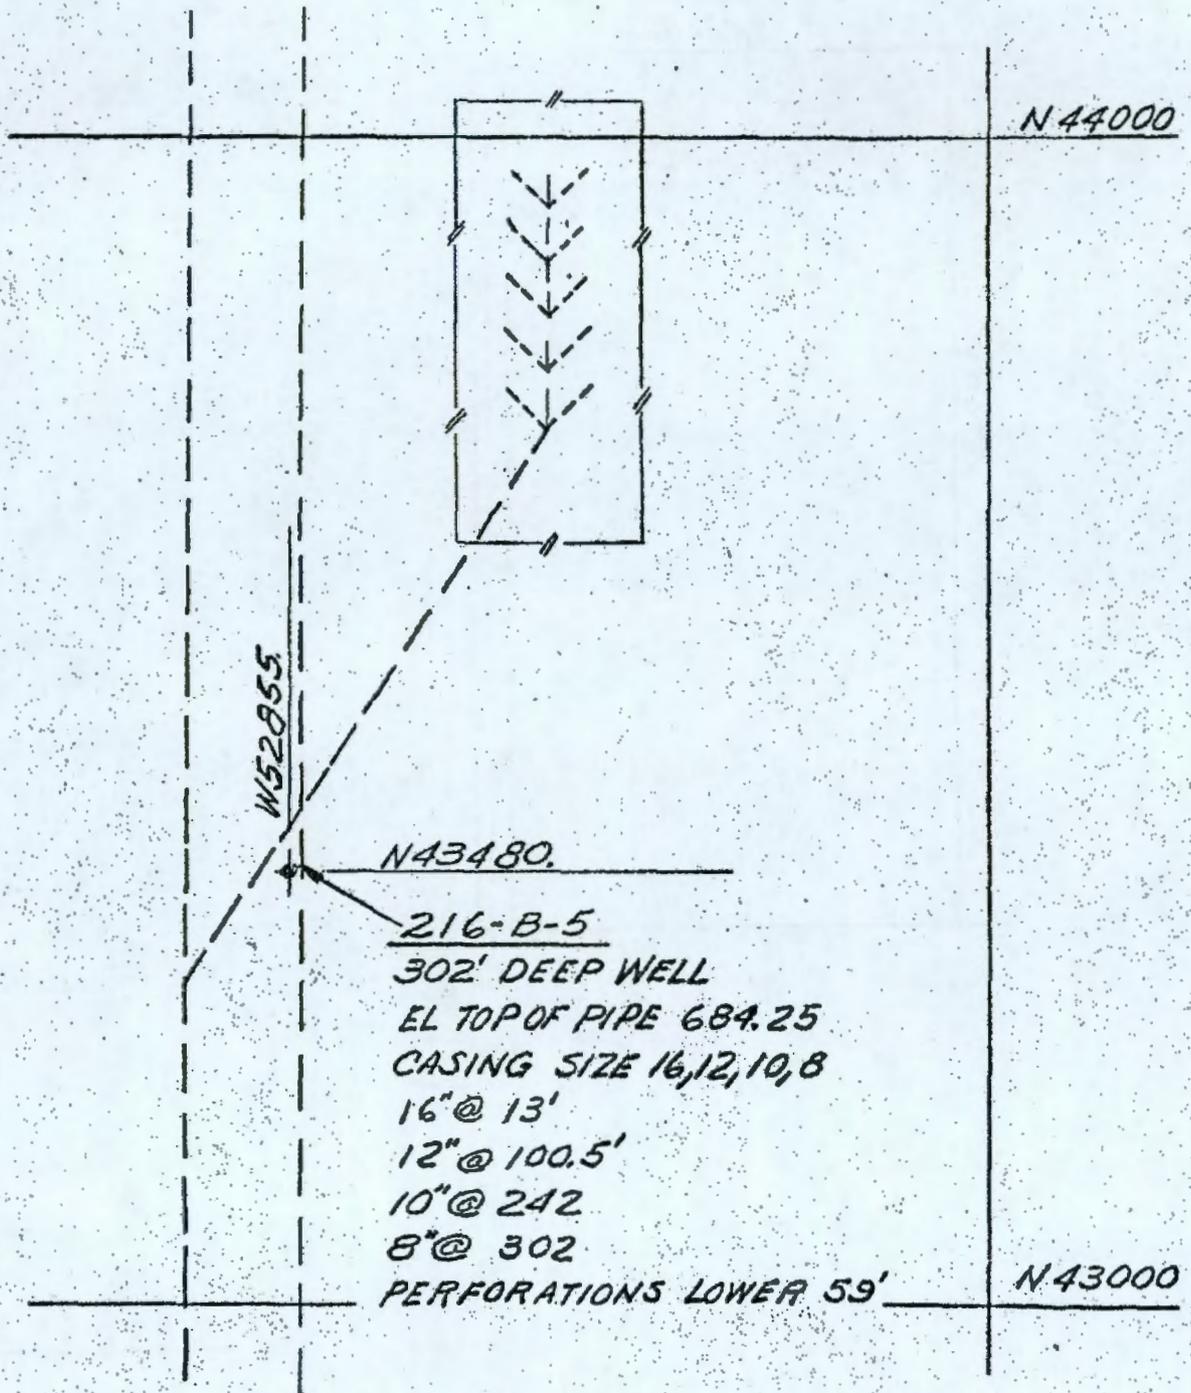

N43480.

216-B-5

302' DEEP WELL

EL TOP OF PIPE 684.25

CASING SIZE 16,12,10,8

16" @ 13'

12" @ 100.5'

10" @ 242

8" @ 302

PERFORATIONS LOWER 59'

N43000

216-B-5

H-2-1123

H-2-1031

7

60

HW-55176-PART 6
APPENDIX C-7
DRAWN JLSIMEX 11/14/59

W55000

N 43000



20' ROADWAY

N42403

N42400

A

216-B-6
SEE C-8

A

222-B BLDG

W53870


W 53858.5

N-42000

216-B-6

H-2-2431


HW 69870 SHT 3

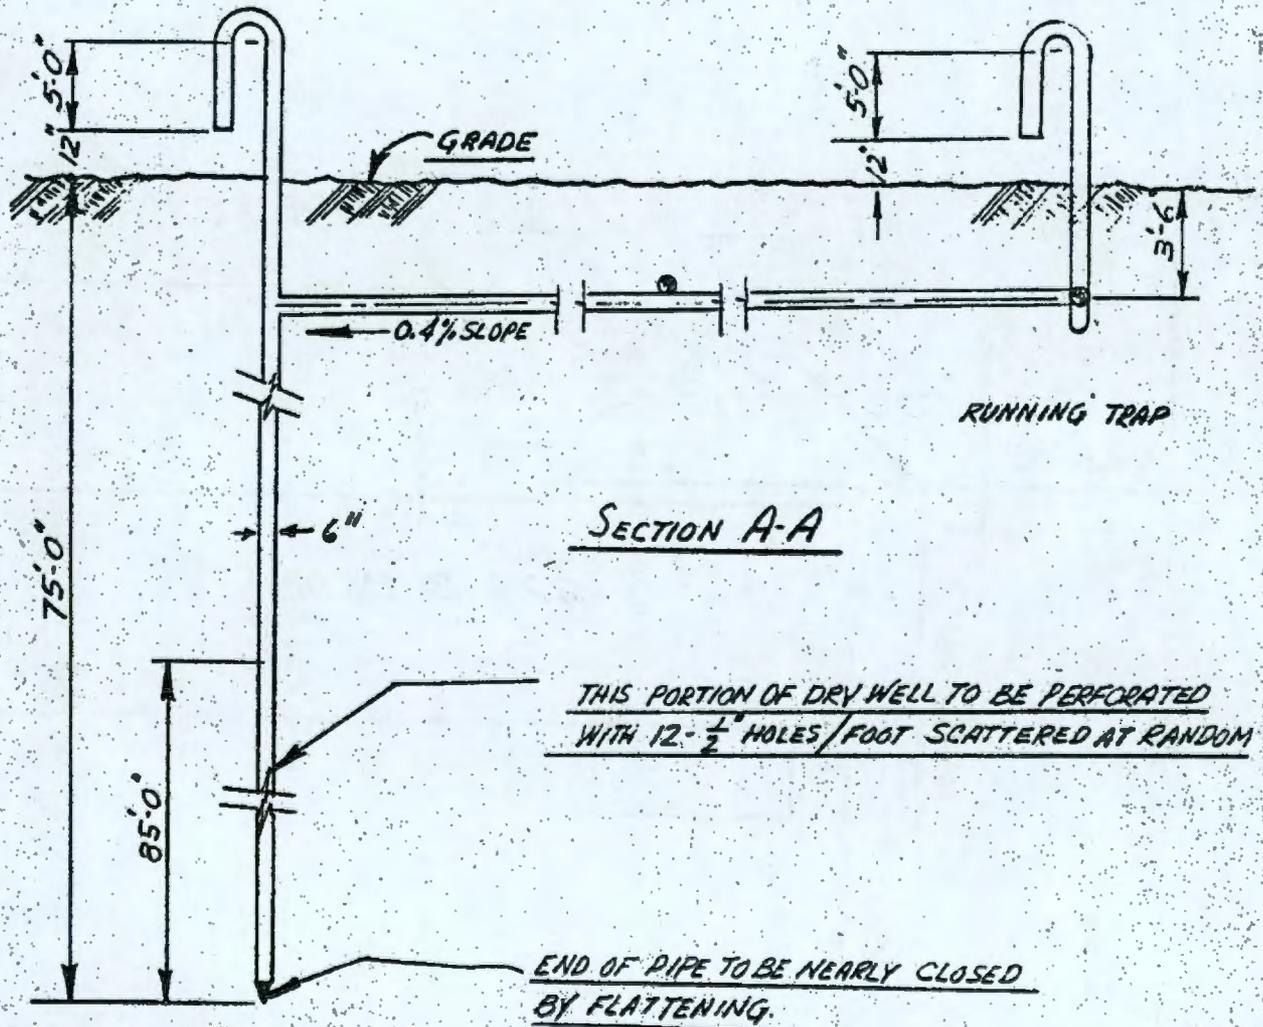


216-B-6

TAKEN FROM
HW 69870 SHT 3

HW-55176 PART VI
APPENDIX C-9

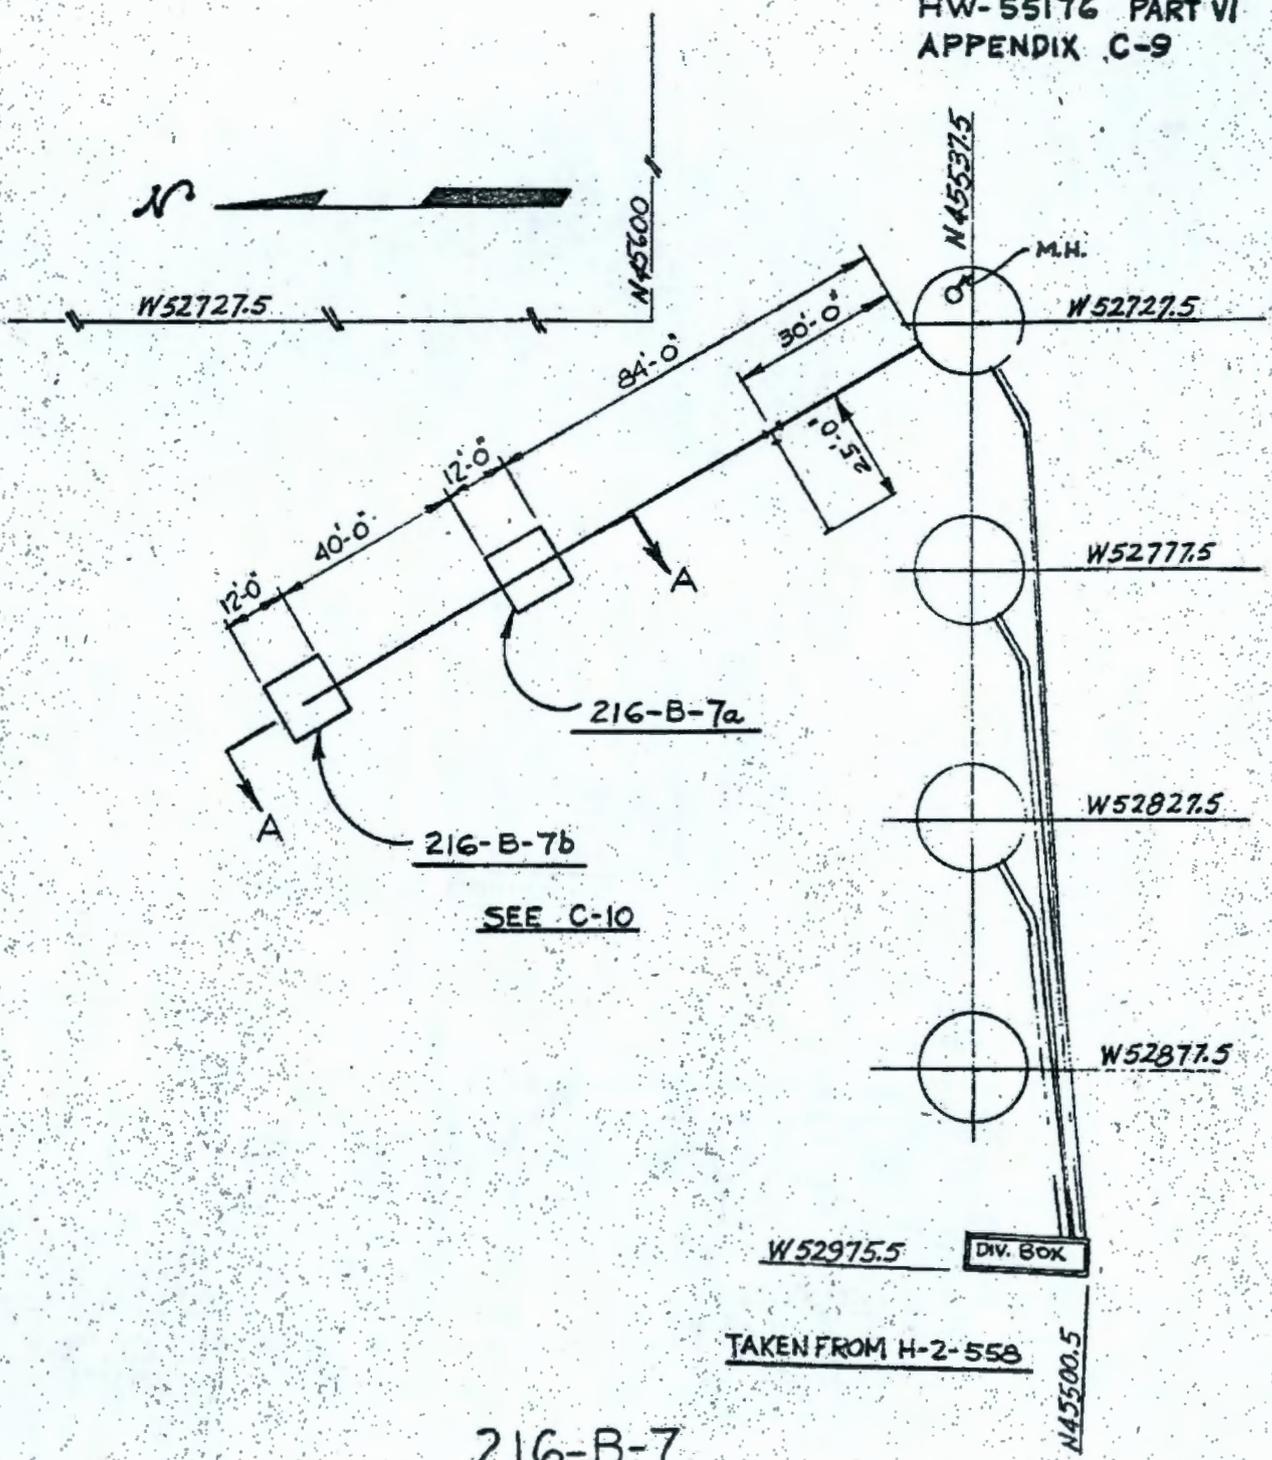


216-B-7

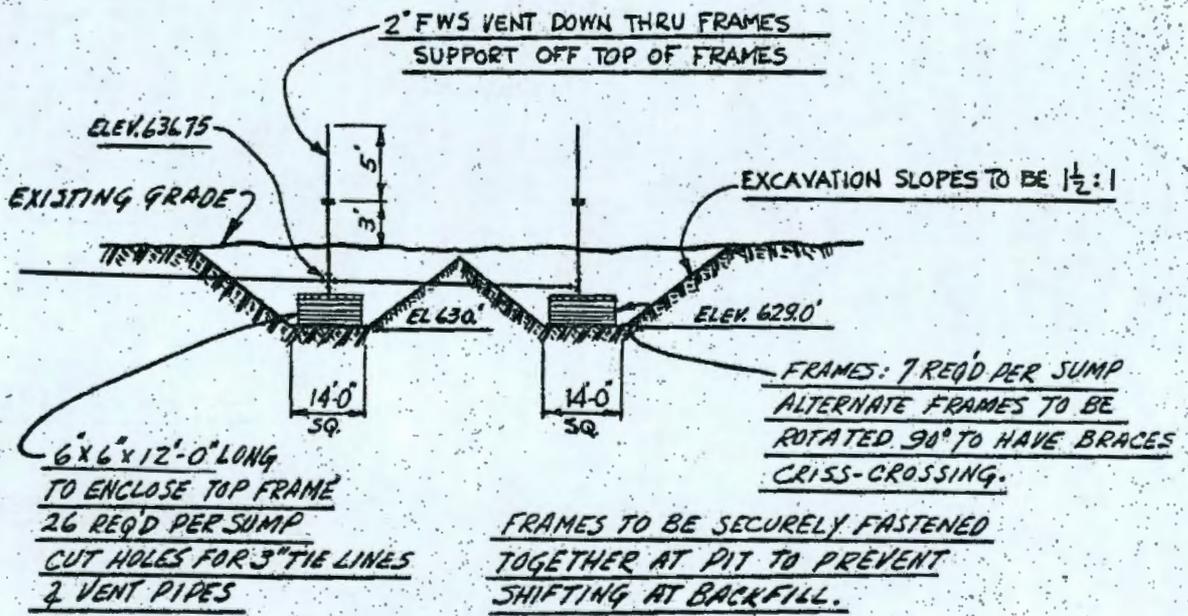

216-B-7

HW-55176 PART VI
APPENDIX C-11

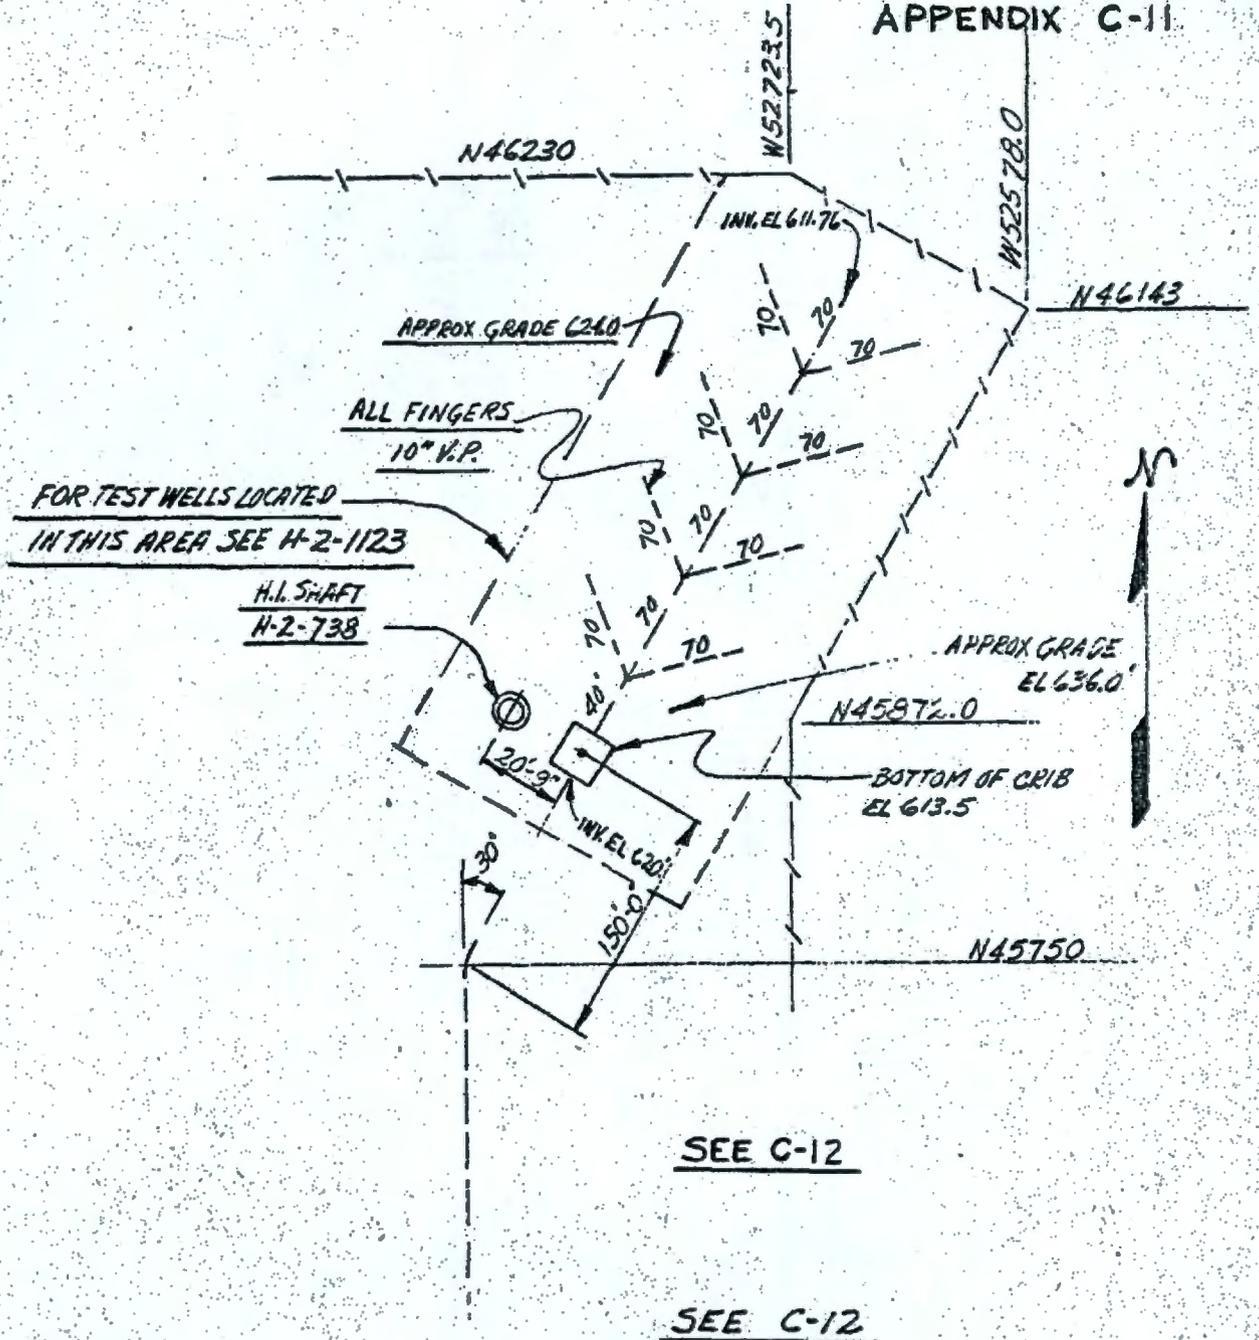


PLAN

216 B-8

12


HW-55176 PART VI
APPENDIX C-12

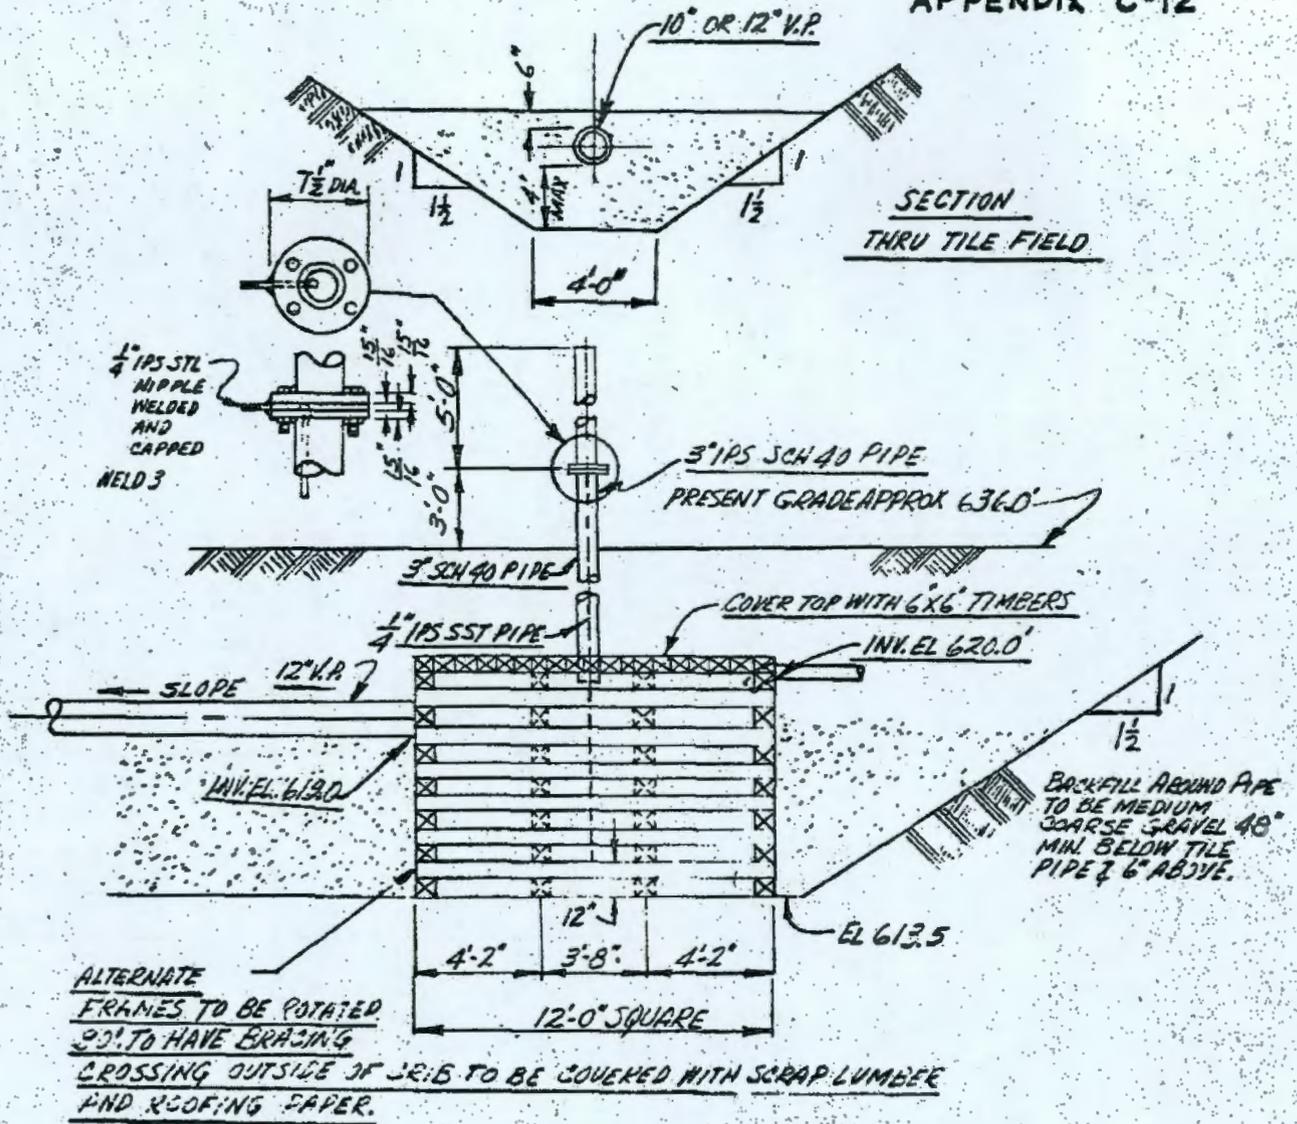

TAKEN FROM H-2-579

216-B-8


HW-55176 PART VI
APPENDIX C-13

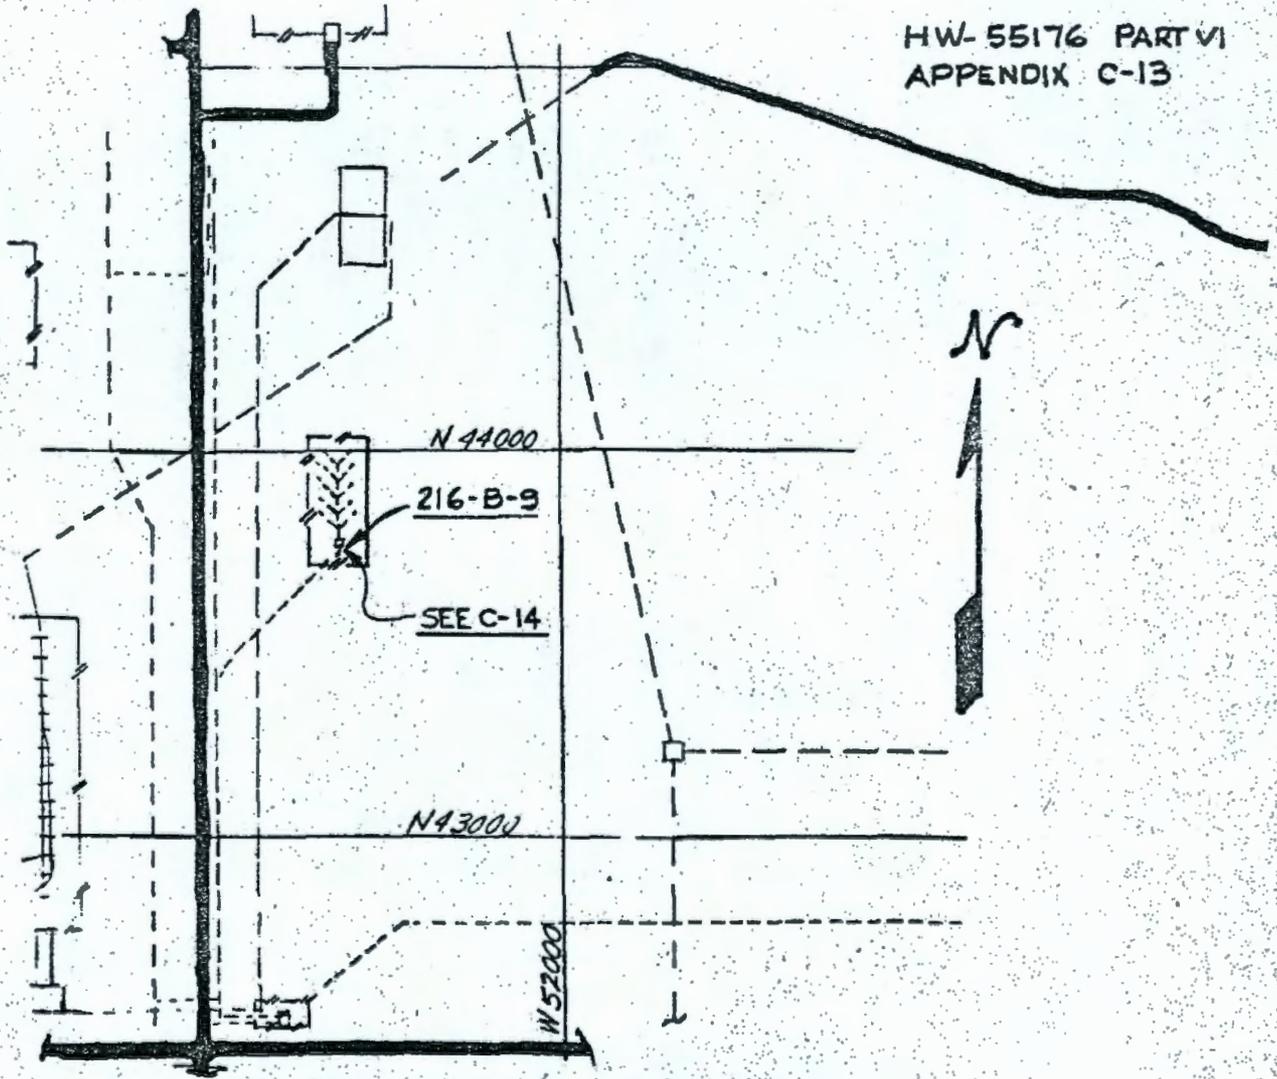


TAKEN FROM H-2-1123
H-2-1031

216-B-9


HW-55176 PART VI
APPENDIX C-14

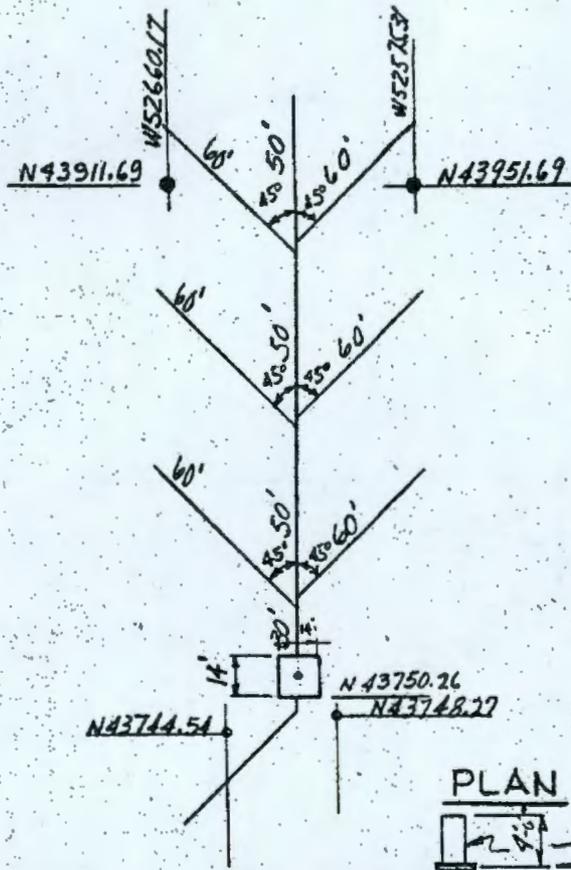

PLAN

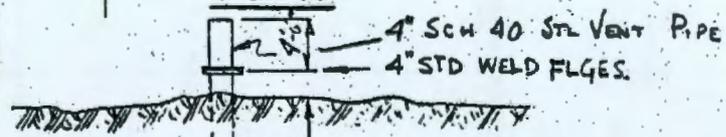

OUTSIDE OF CRIB TO BE COVERED WITH 15# ROOFING FELT & SCRAP LUMBER


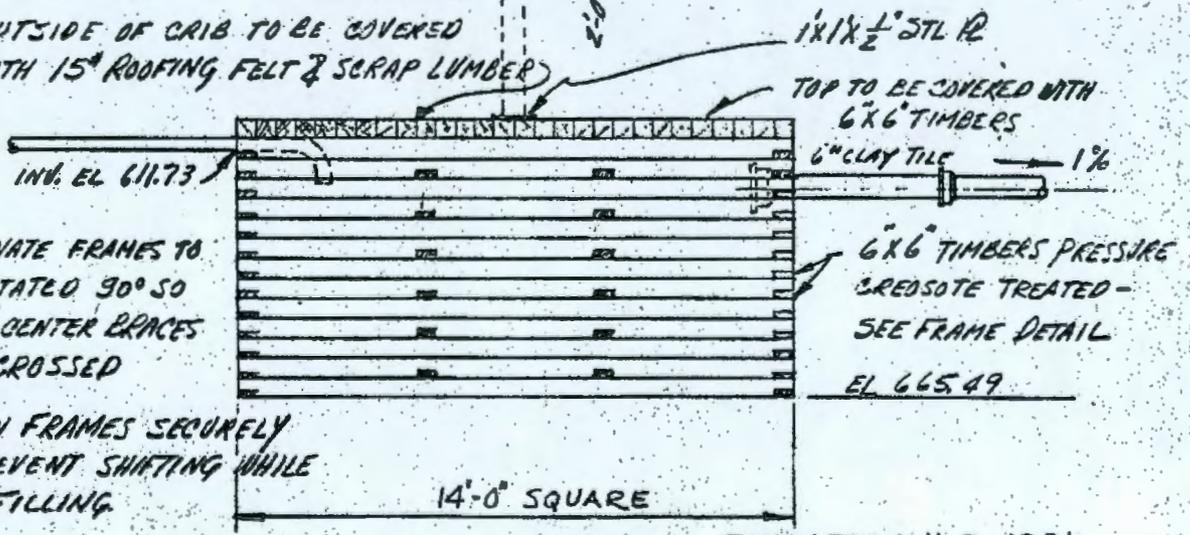


ALTERNATE FRAMES TO BE ROTATED 90° SO THAT CENTER BRACES ARE CROSSED

FASTEN FRAMES SECURELY TO PREVENT SHIFTING WHILE BACKFILLING

216-B-9

TAKEN FROM H-2-1031


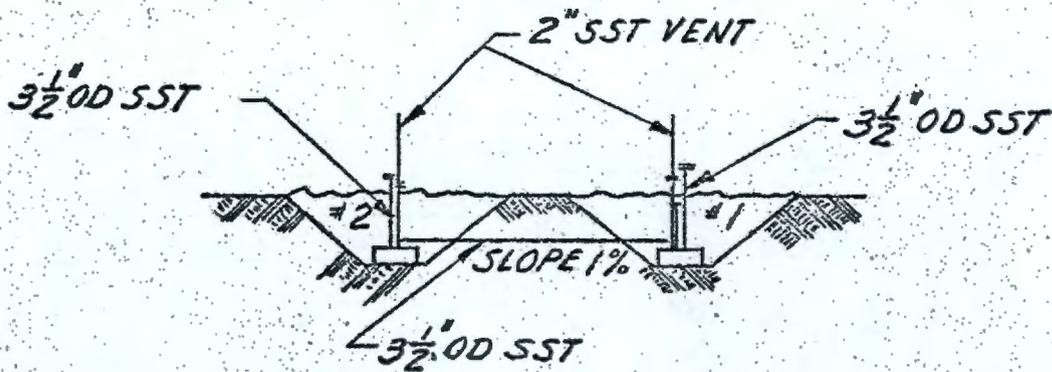
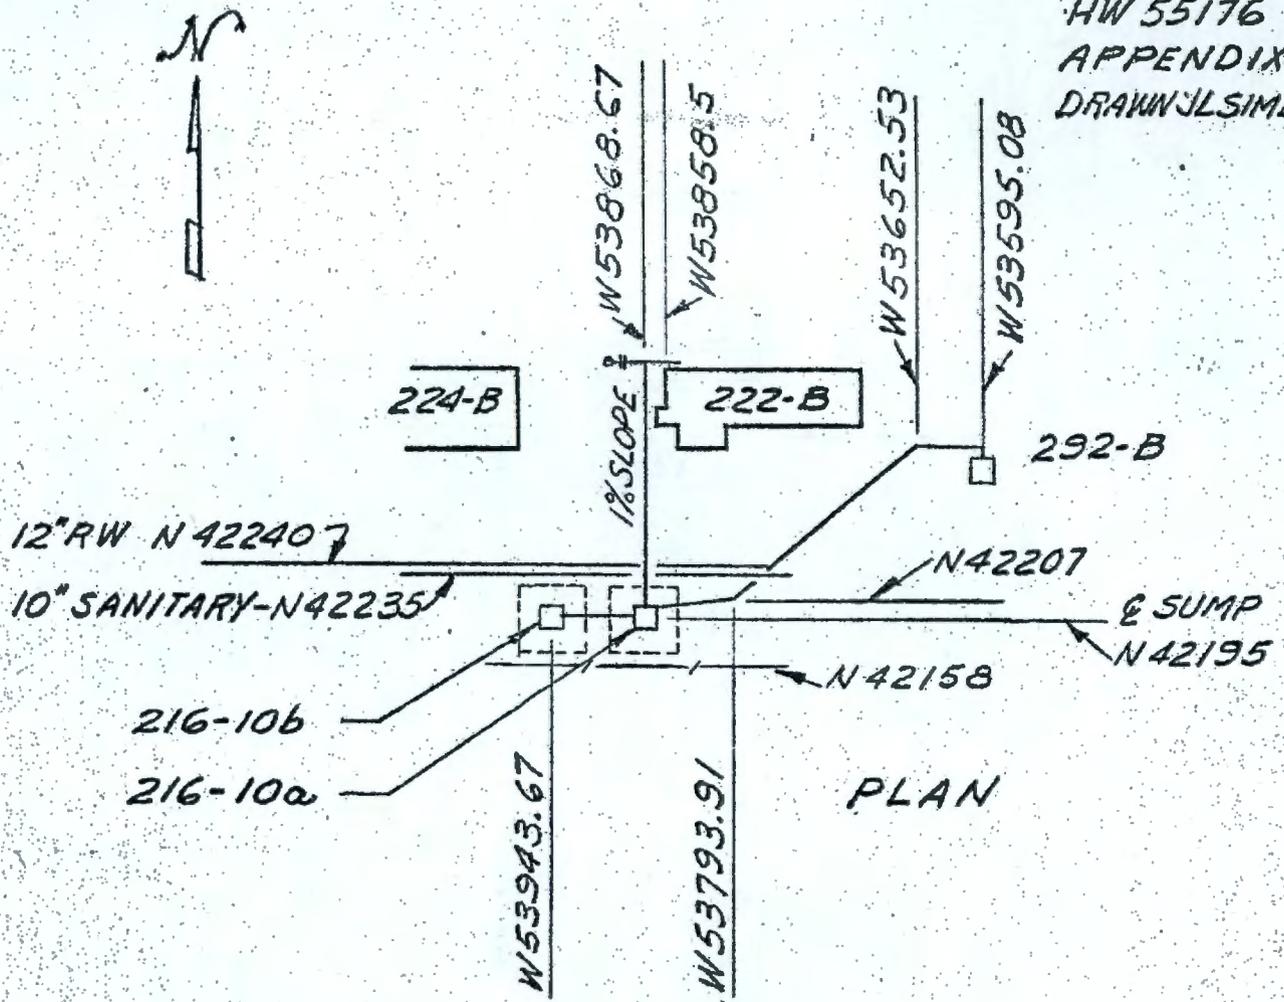


216-B-10a

216-B-10b

H-2-1649


HW-55176 PART VI
APPENDIX C-16

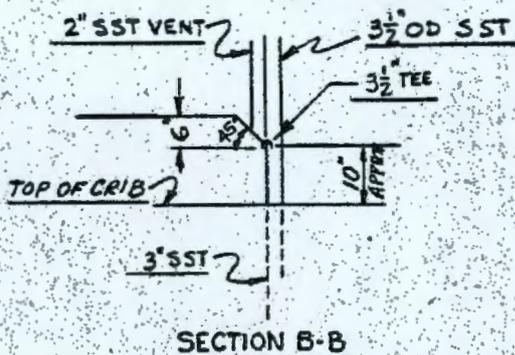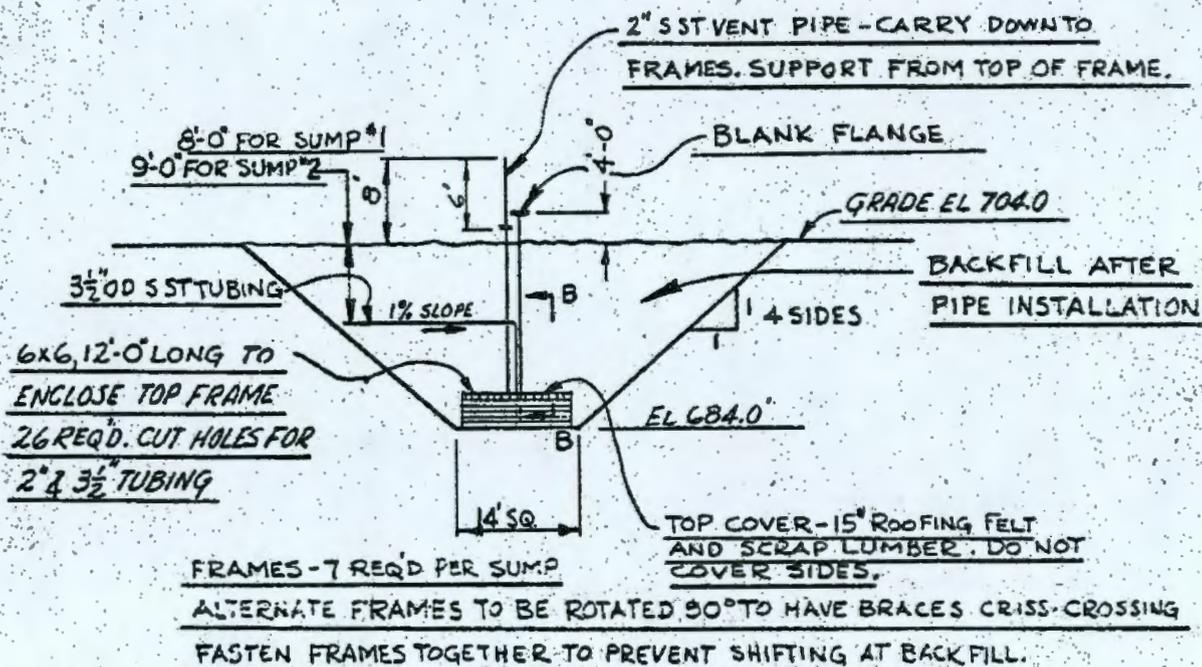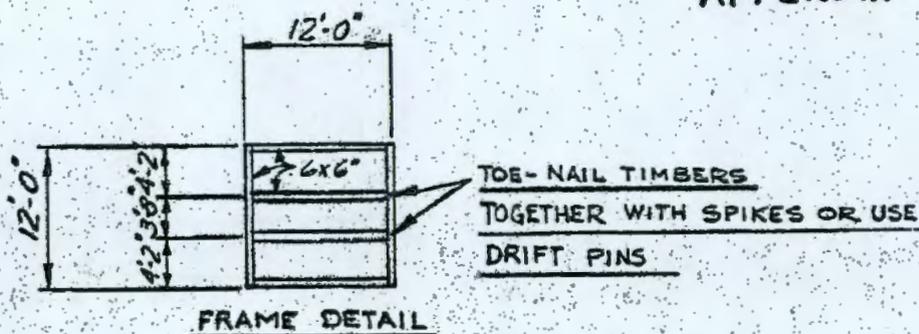


TAKEN FROM
H-2-1649

216-B-10a & 10b

HW-55176 PART VI
APPENDIX C-17

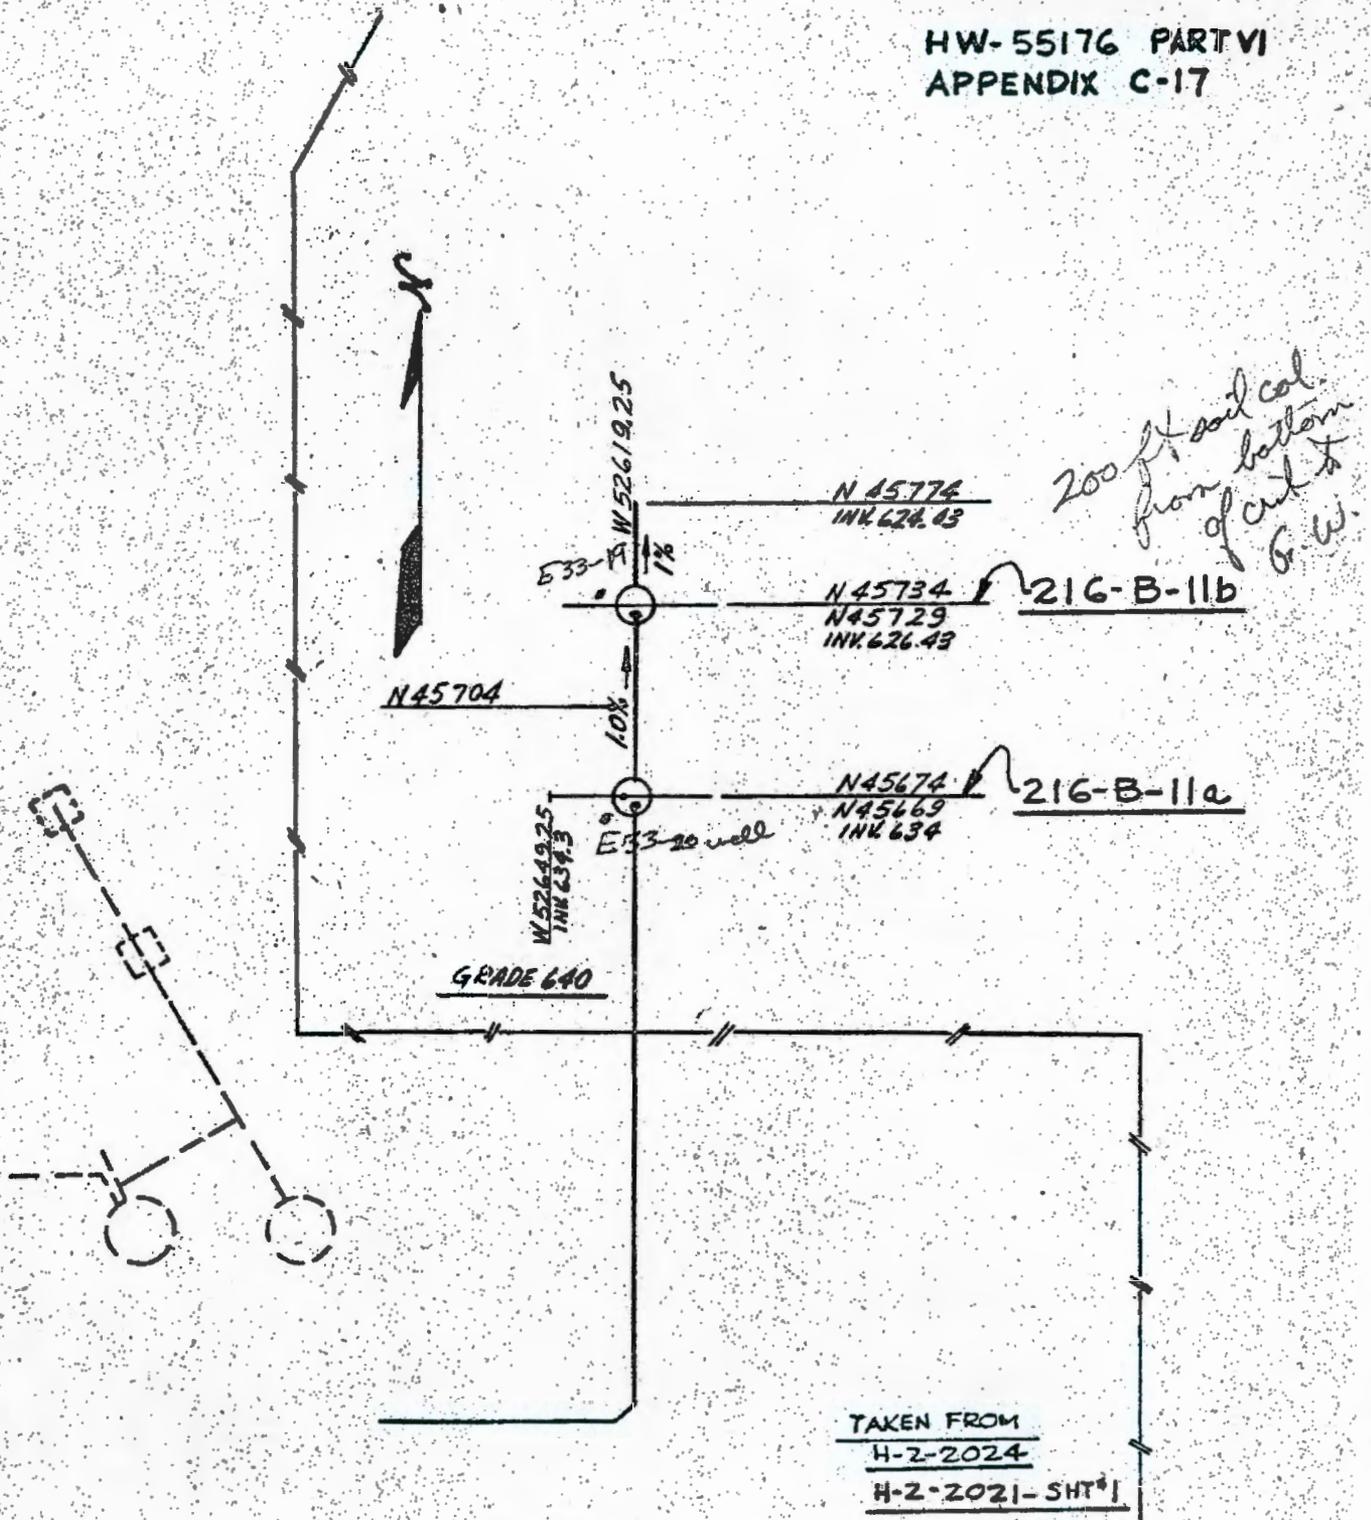

216-B-11a & 11b

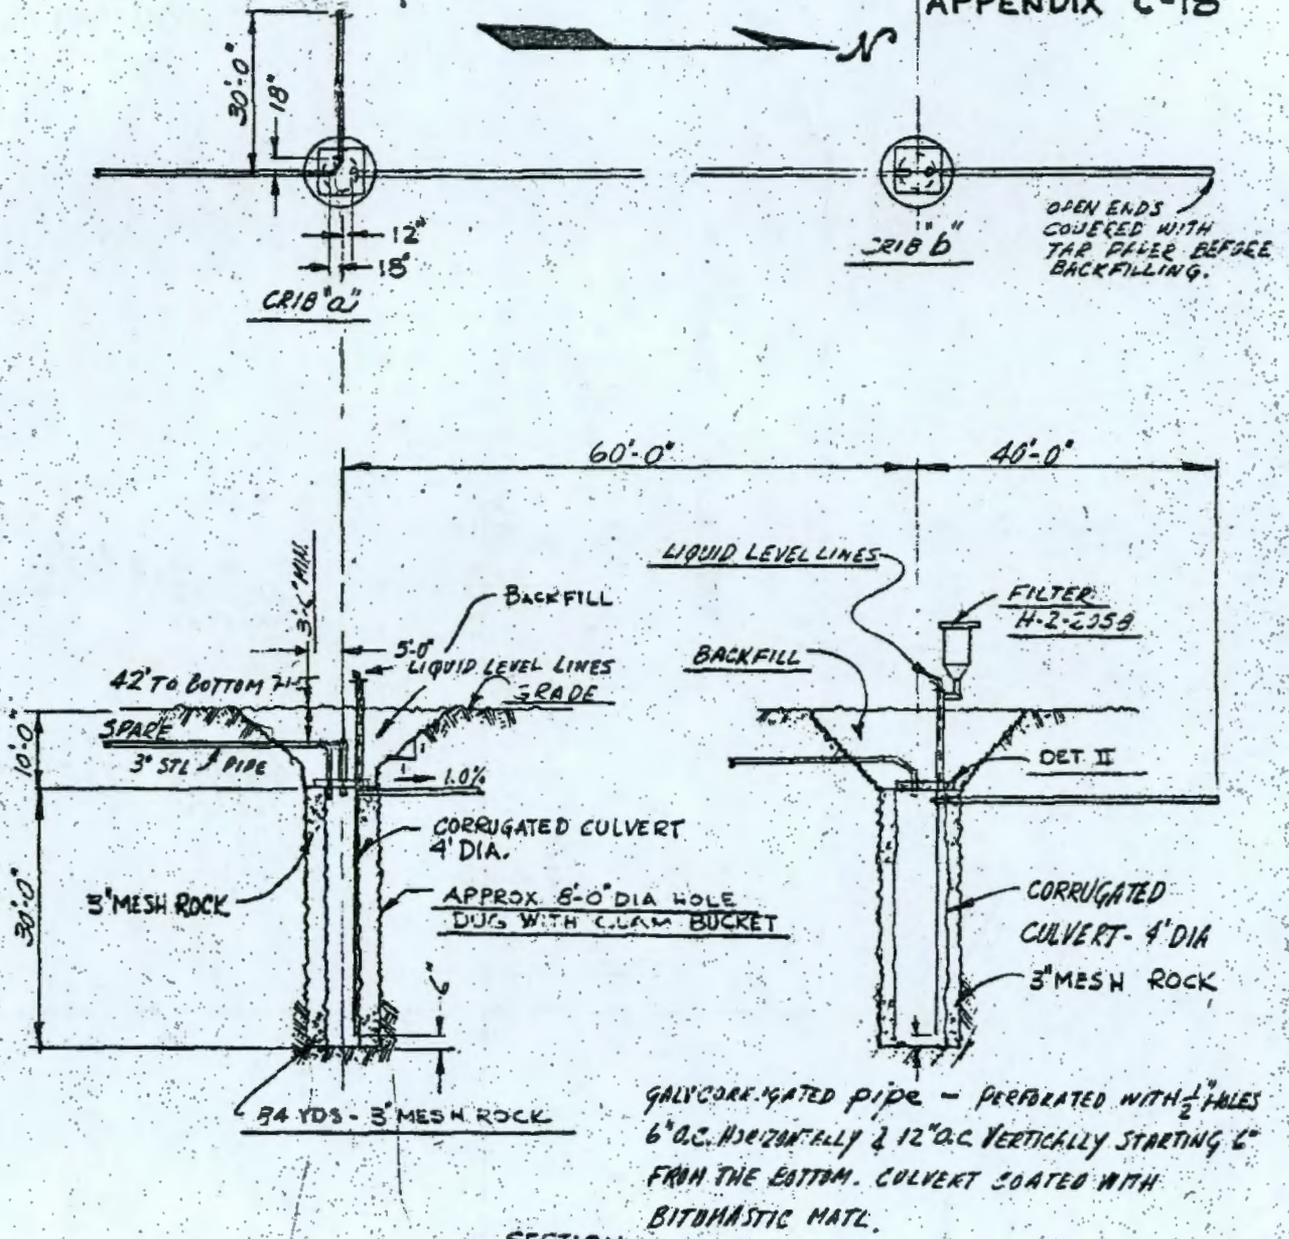


TAKEN FROM
H-2-2024
H-2-2025 - 477

216-B-11a, 11b



14400

HW 55176-PART 6
APPENDIX C-19
DRAWN JLS/MEK 12/16/55

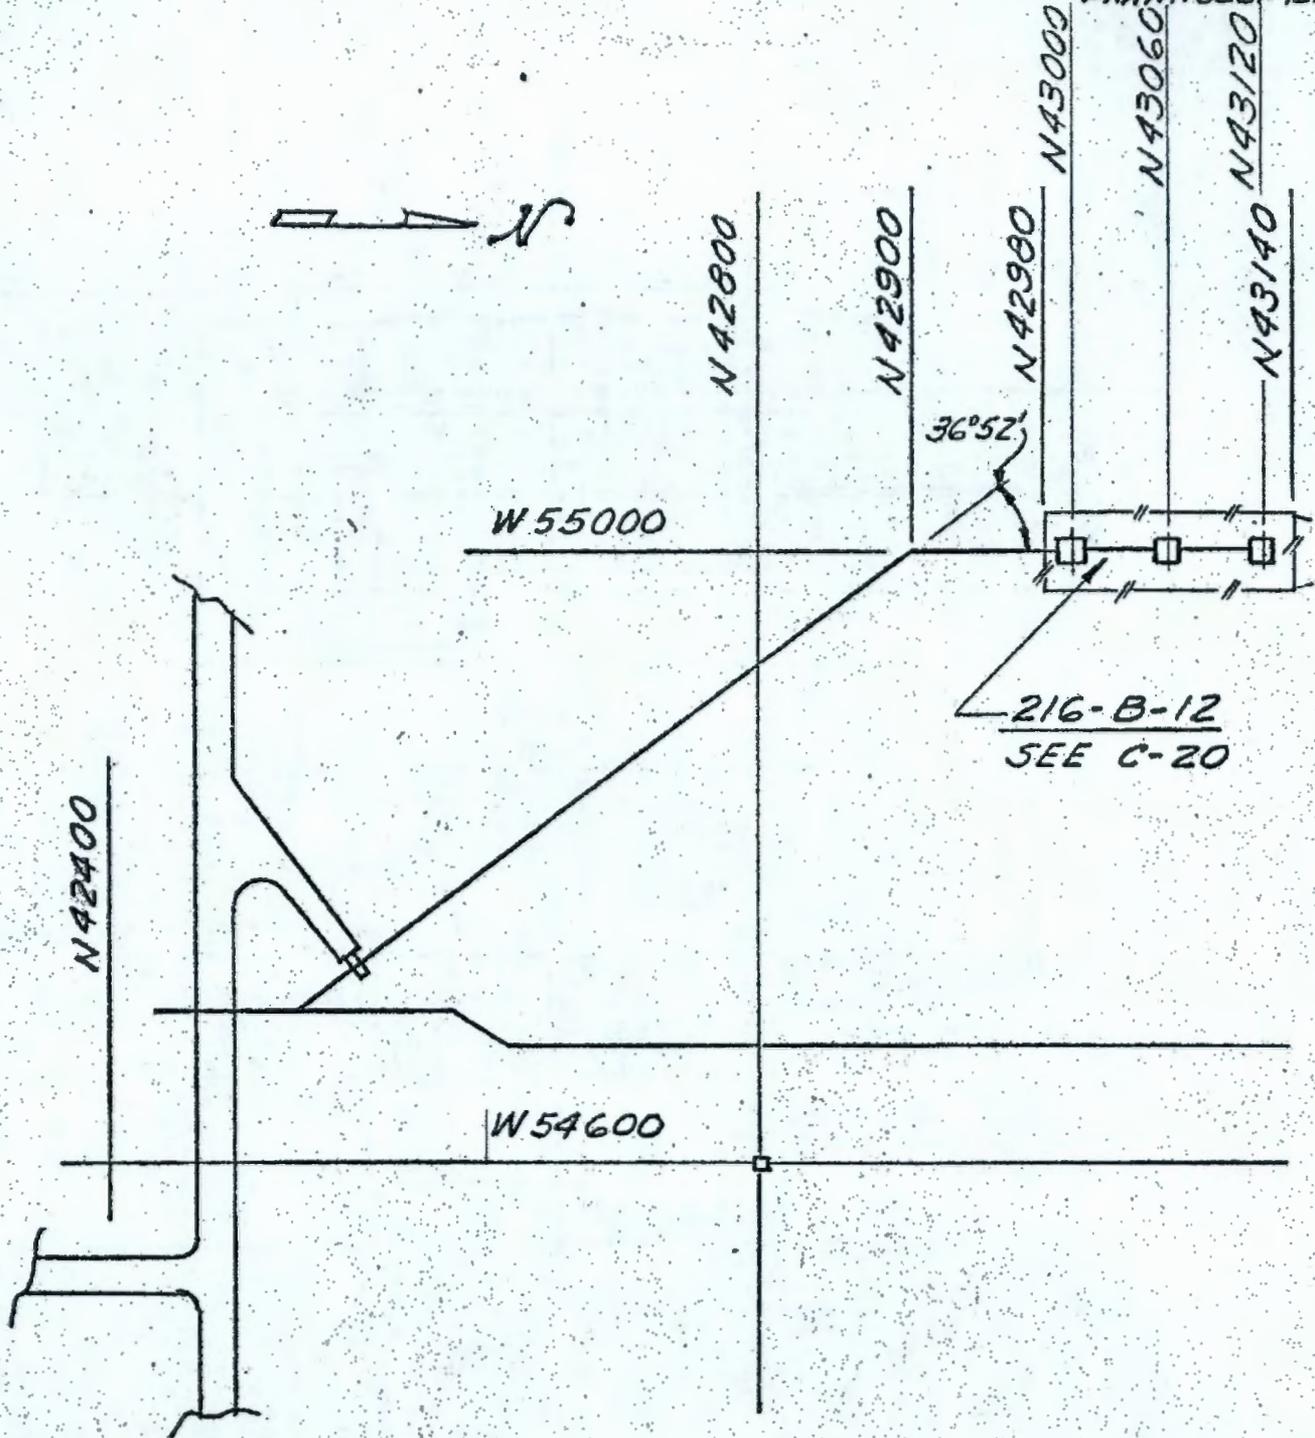

216-B-12
H-2-43046


HW-55176 PART VI
APPENDIX C-20

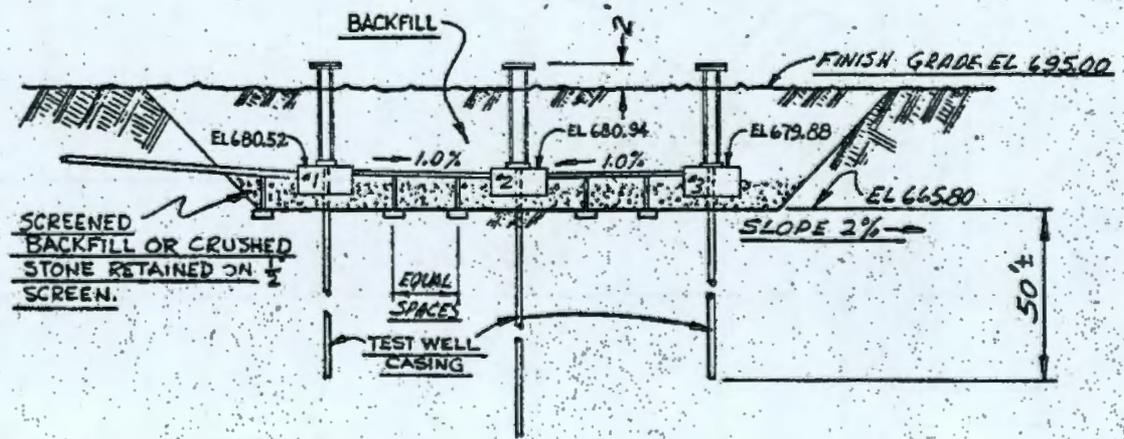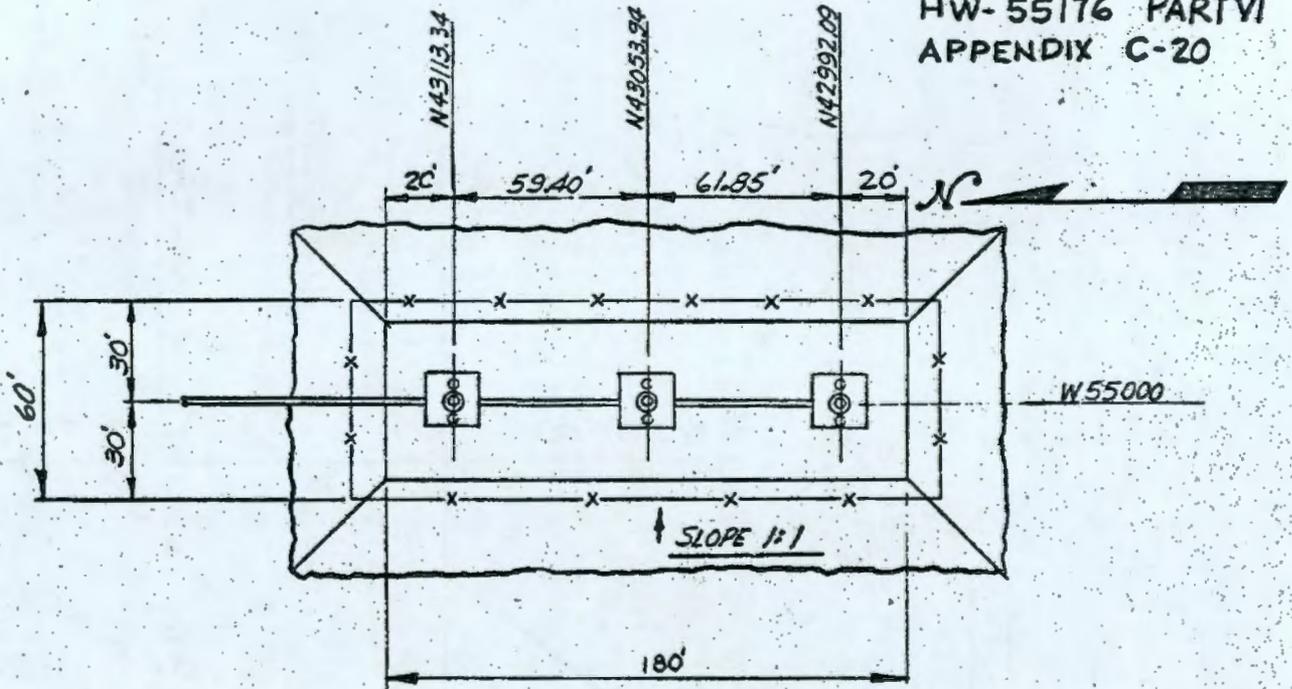

TAKEN FROM H-2-43029


216-B-12

HW-55176 PART VI
APPENDIX C-21

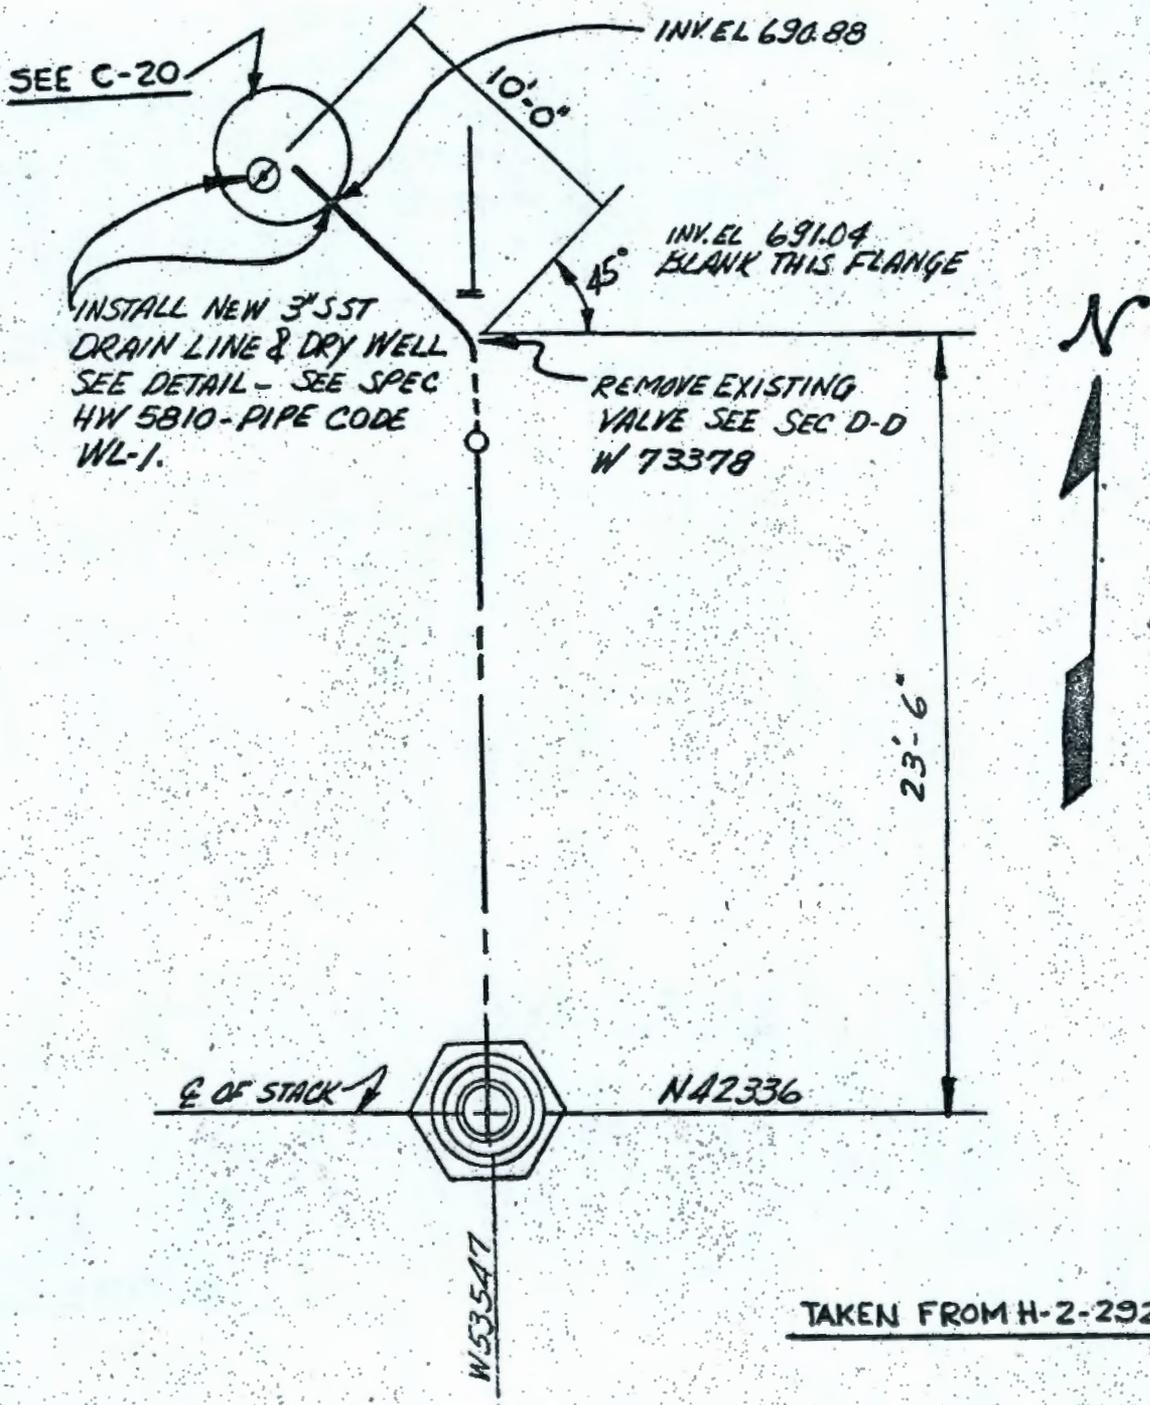

216-B-13


HW-55176 PART VI
APPENDIX C-22

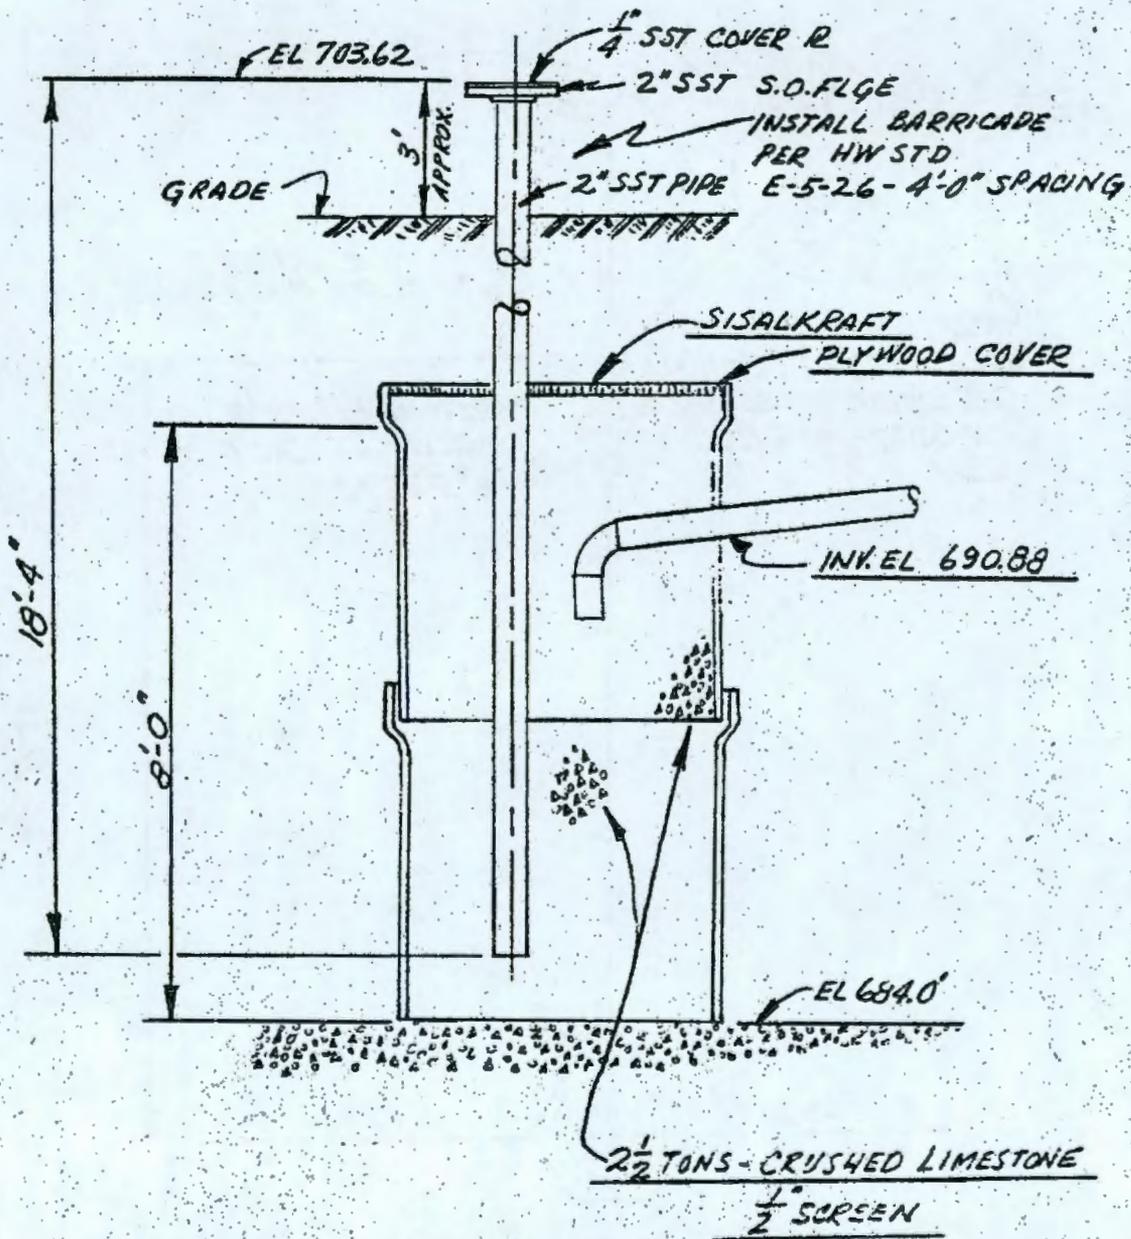

TAKEN FROM H-2-2926


216-B-13

HW-55176 PART VI
APPENDIX C-23

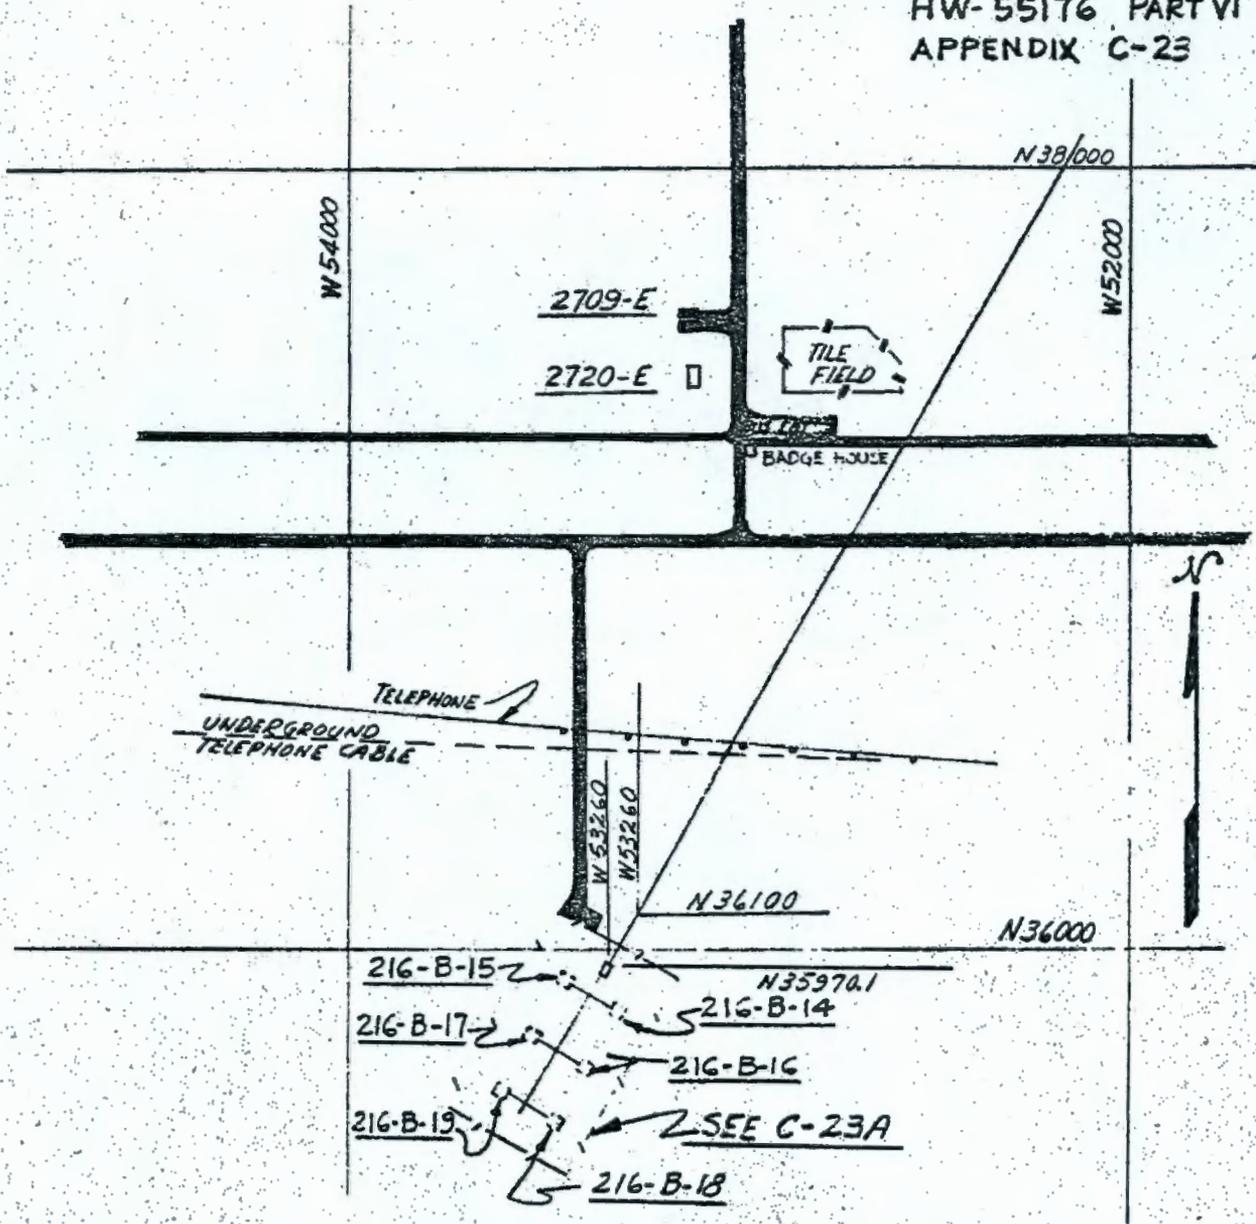


TAKEN FROM H-2-2900


216-B-14-15-16-17-18-19

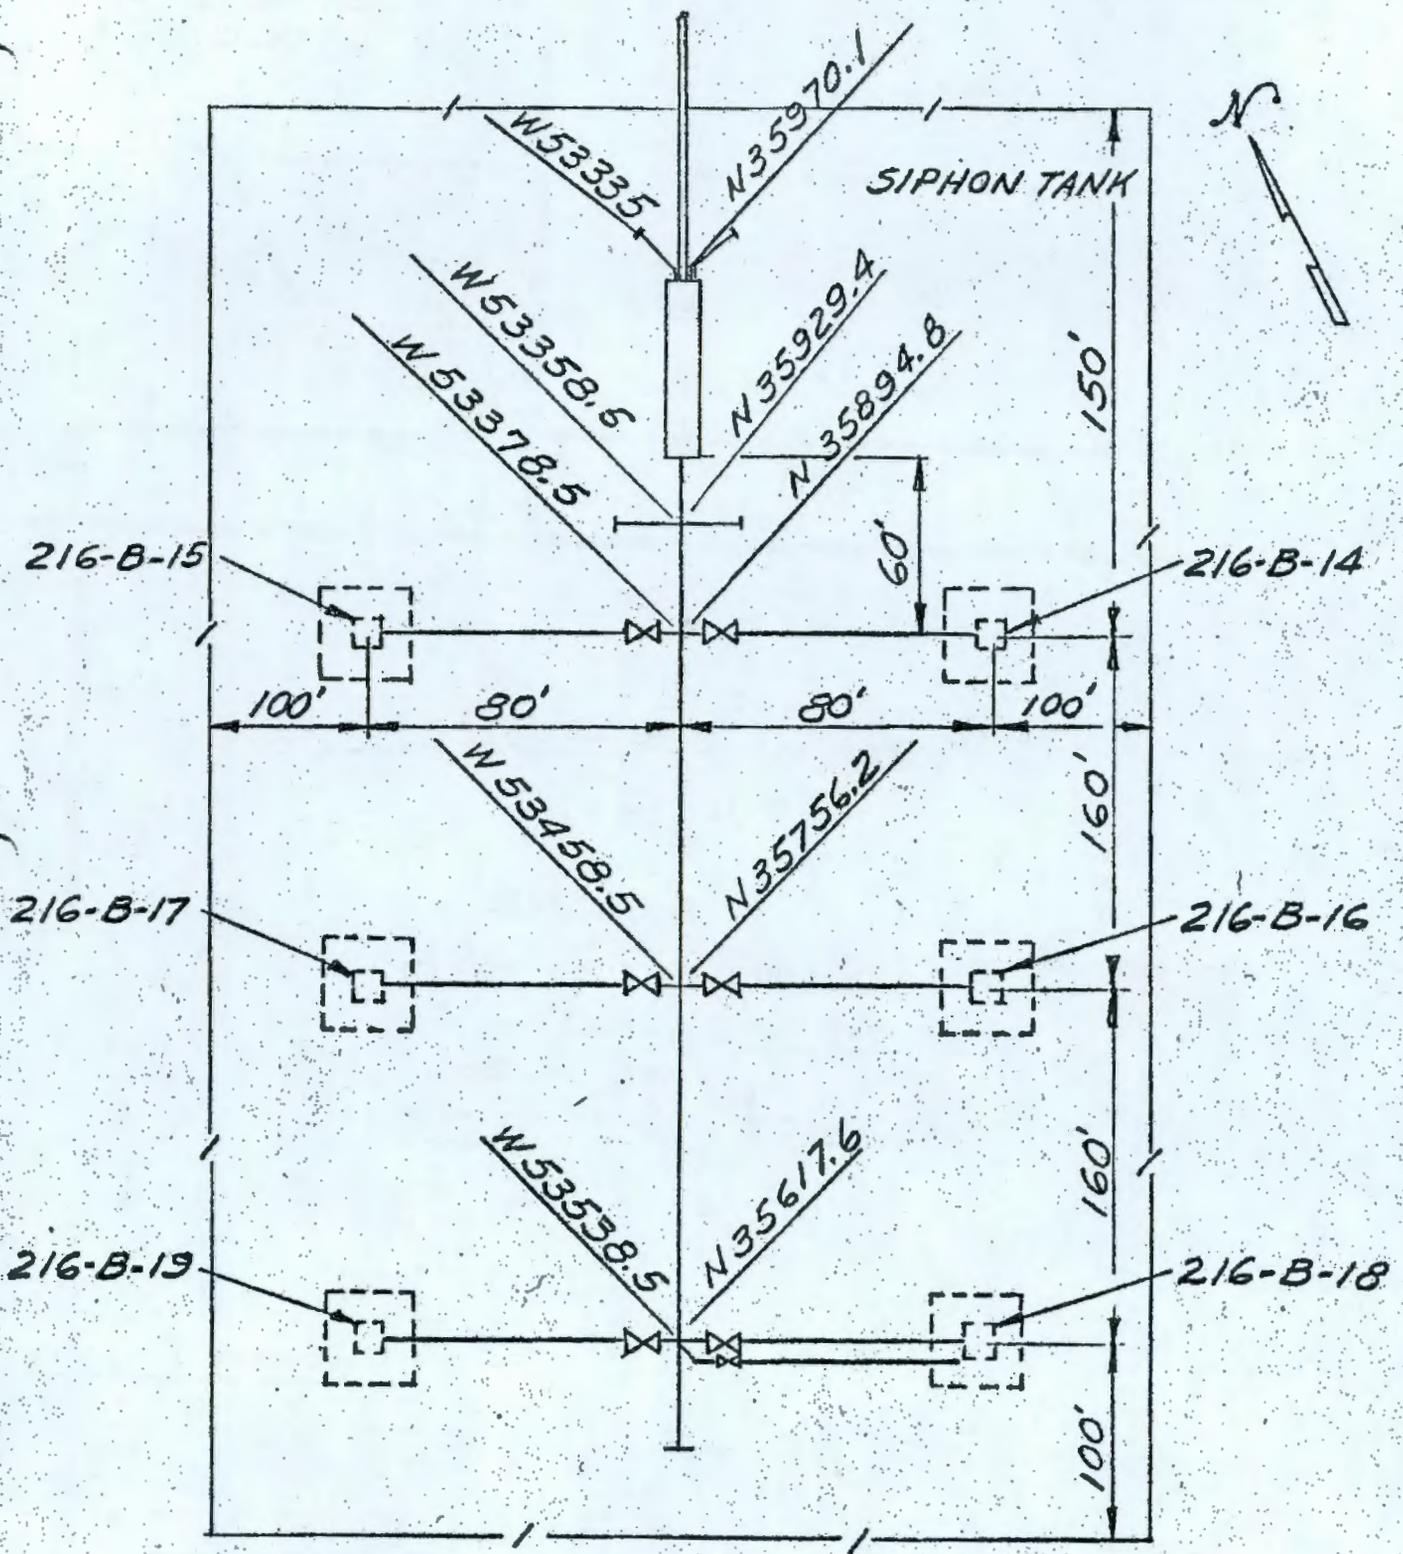


216-B-14-15-16-17-18-19

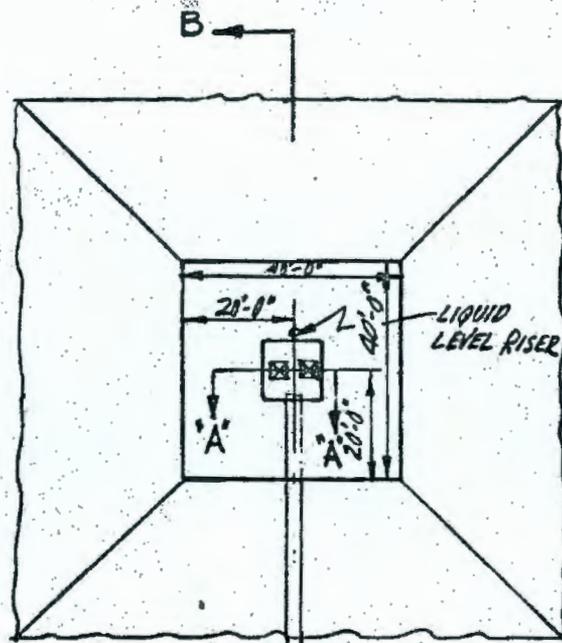

PLAN

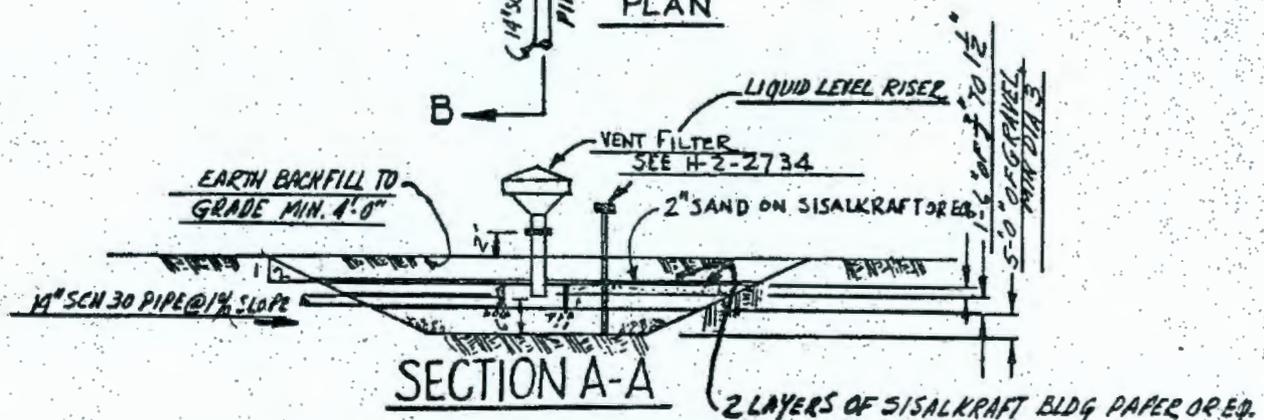


SECTION A-A

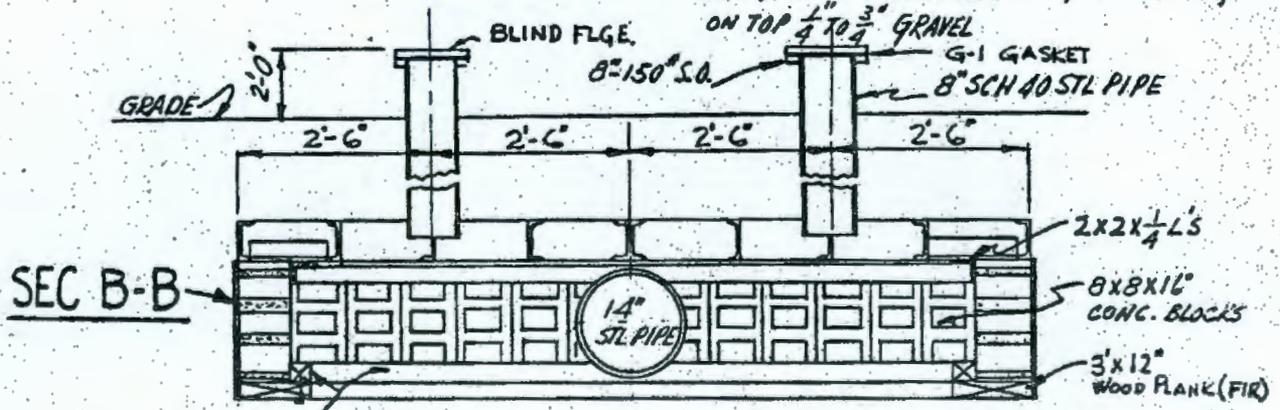


SEC B-B

216-B-14-15-16-17-18-19

216-B-20-21-22

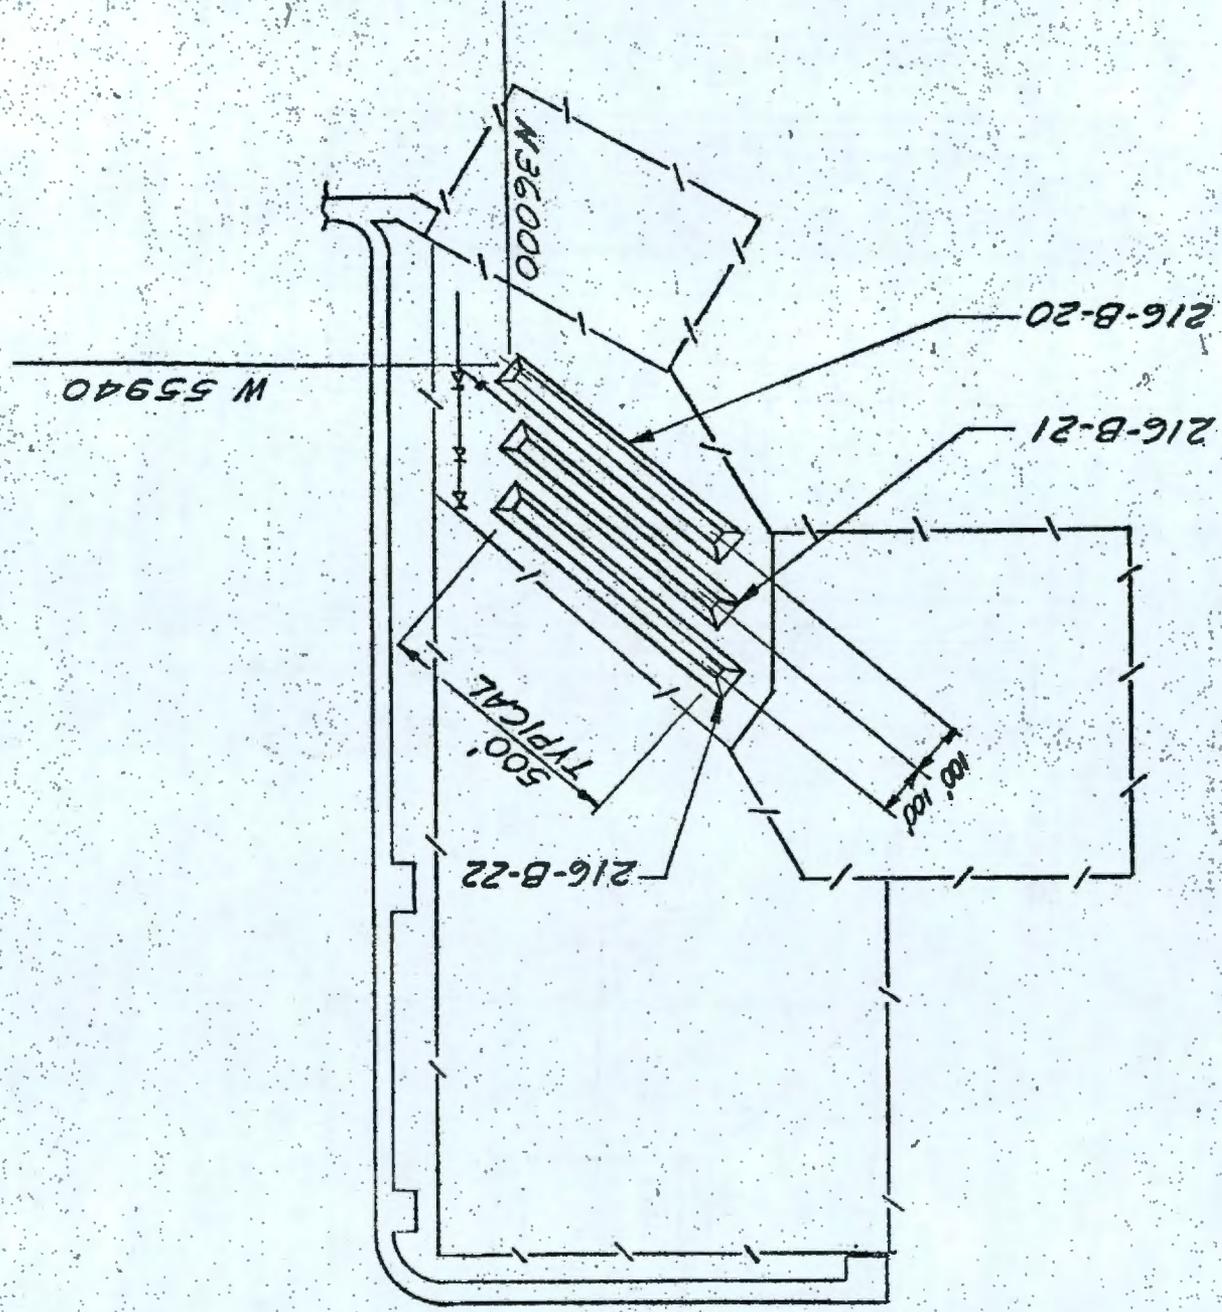


HW 55176-PART 6
 APPENDIX C-25
 DRAWN ULSIMER 12/18/59

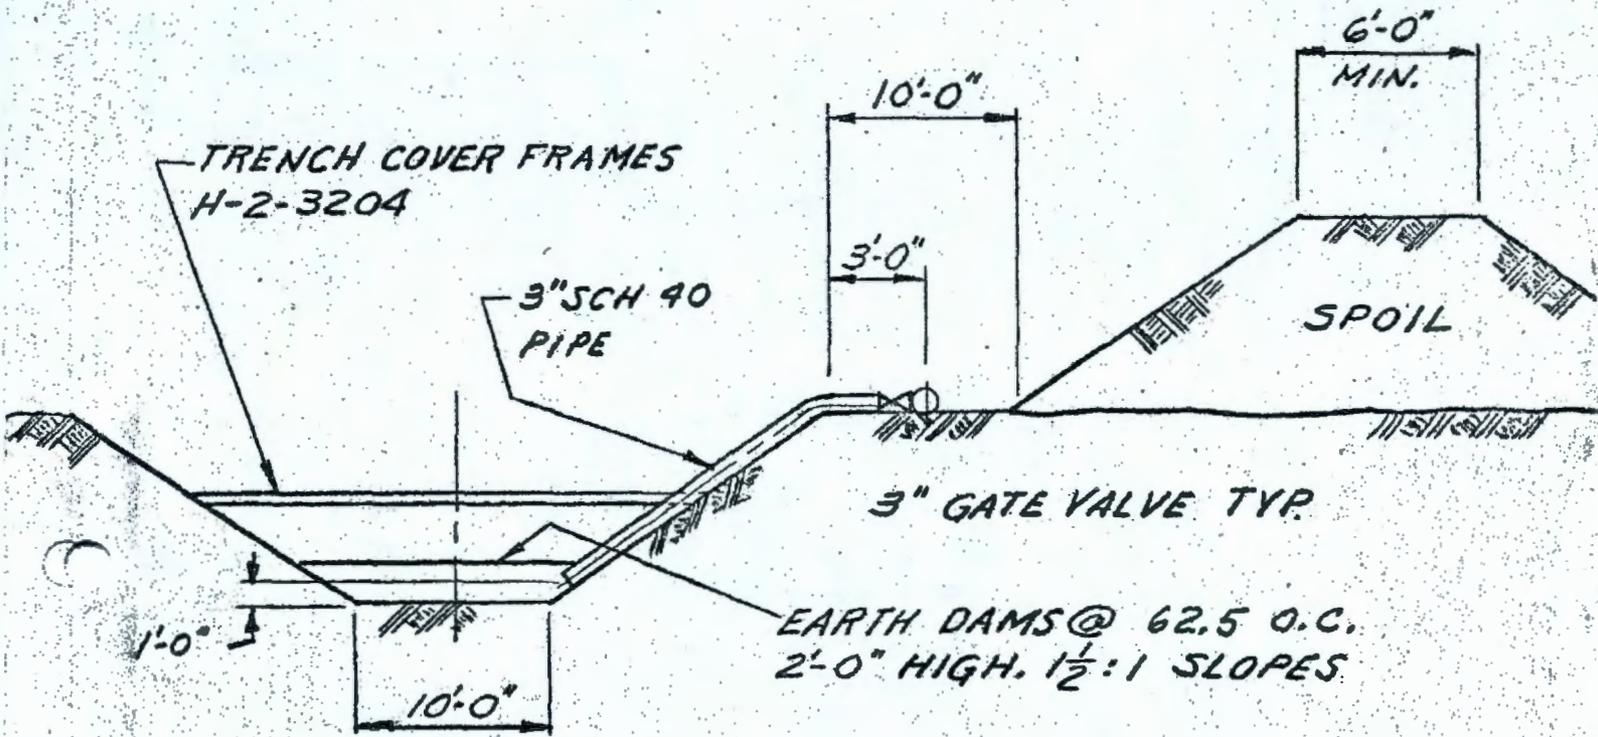




TYPICAL SECTION

216-B-20-21-22-23-24-25-26-27-28-52

HW-55176 PART VI
APPENDIX C-26A

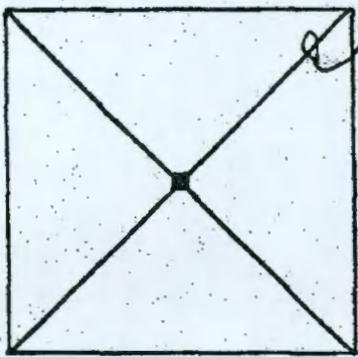


PLAN

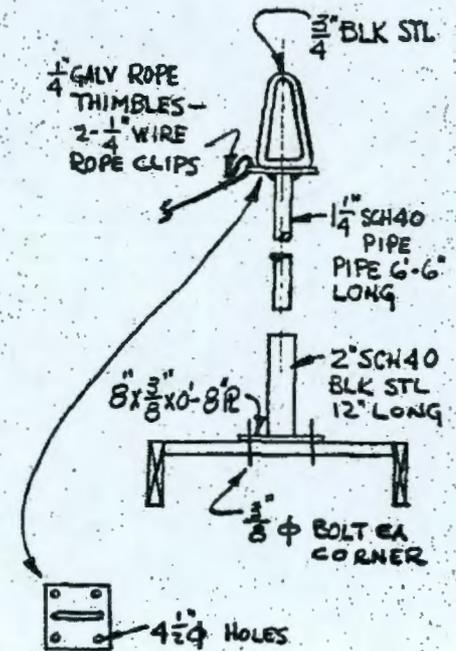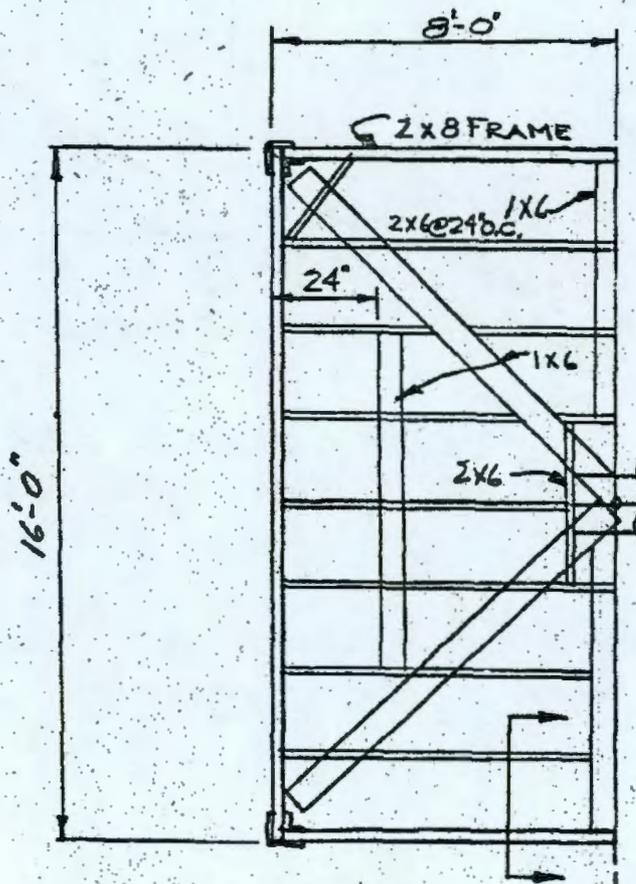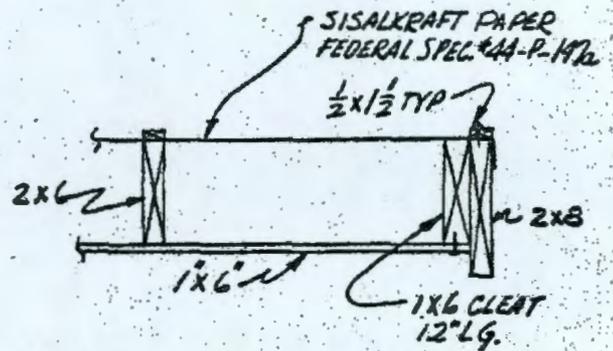

SYM ABOUT C



TAKEN FROM H-2-3204

216-B-20-21-22

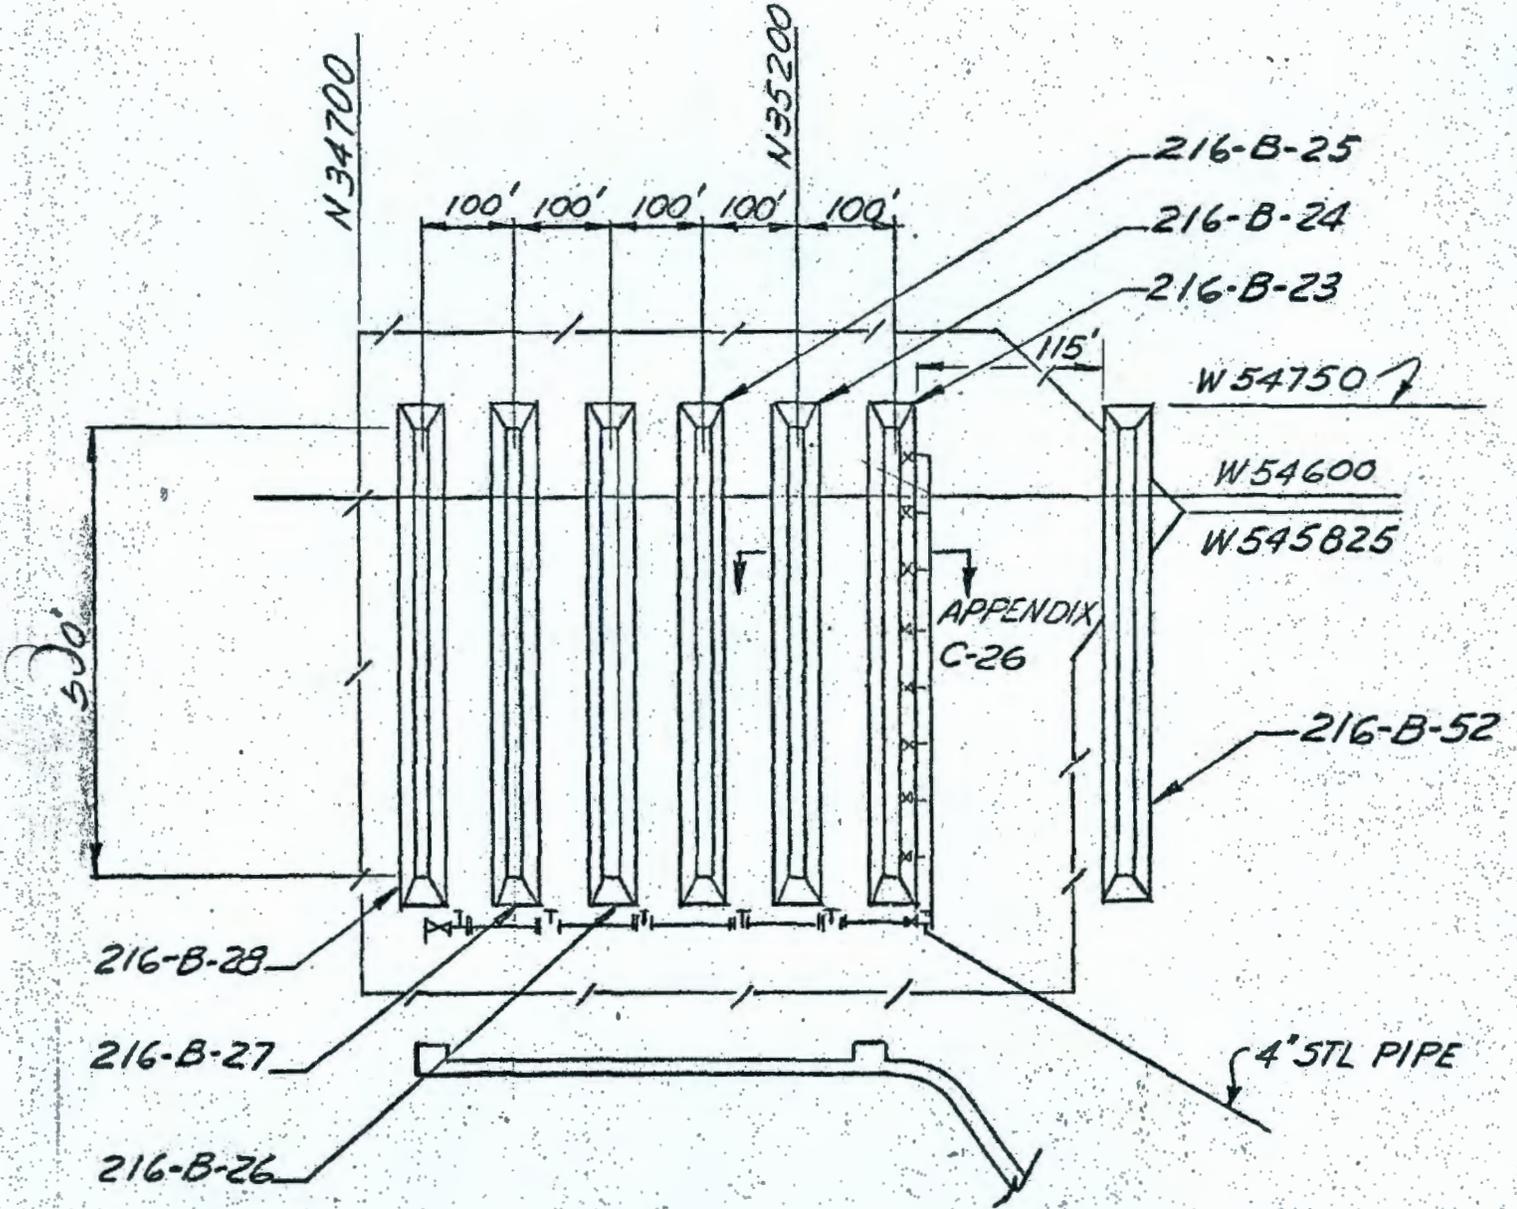


216-B-23-24-25-26-27-28-52

H-2-3232

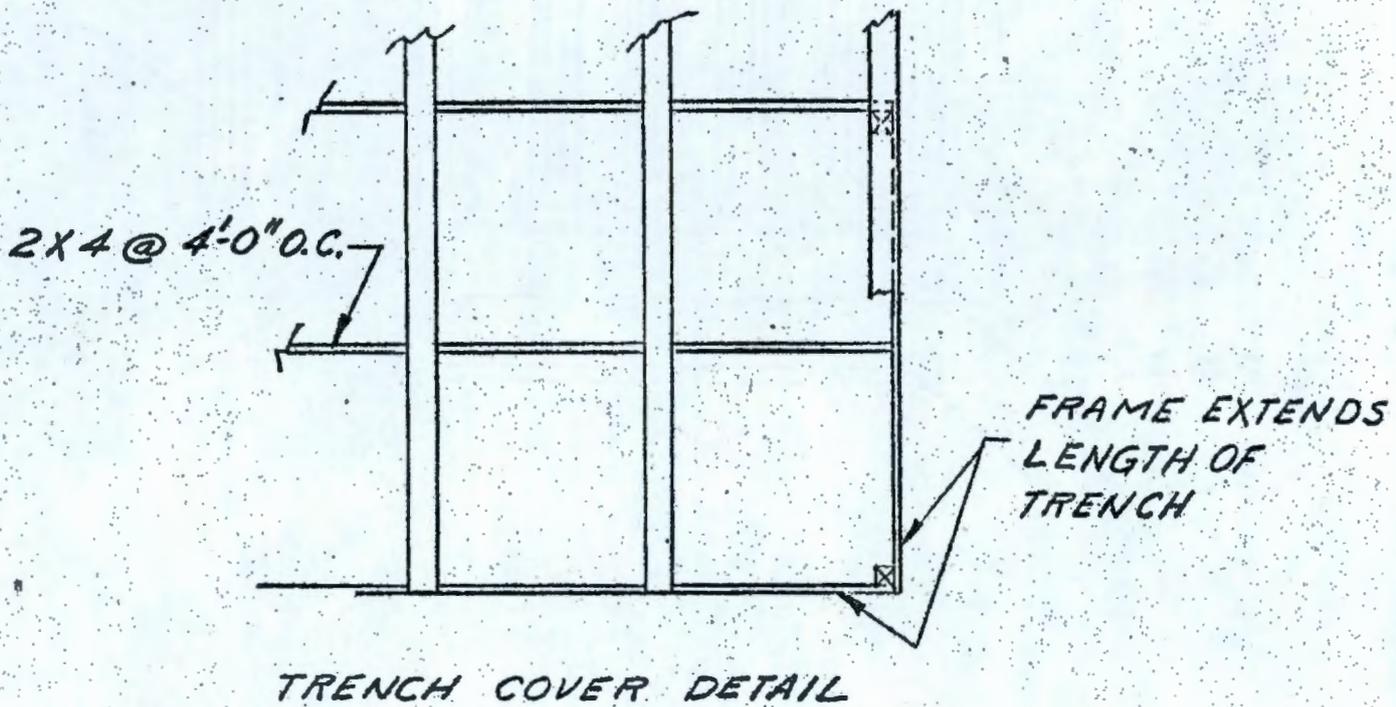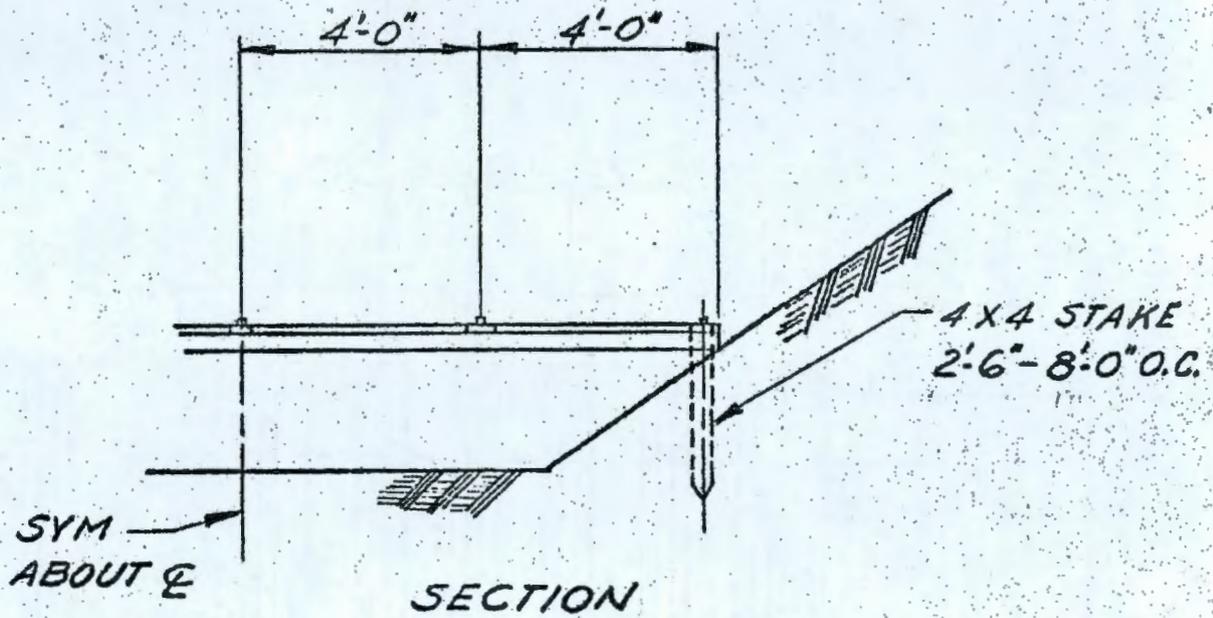


216-B-23-24-25-26-27-28-52

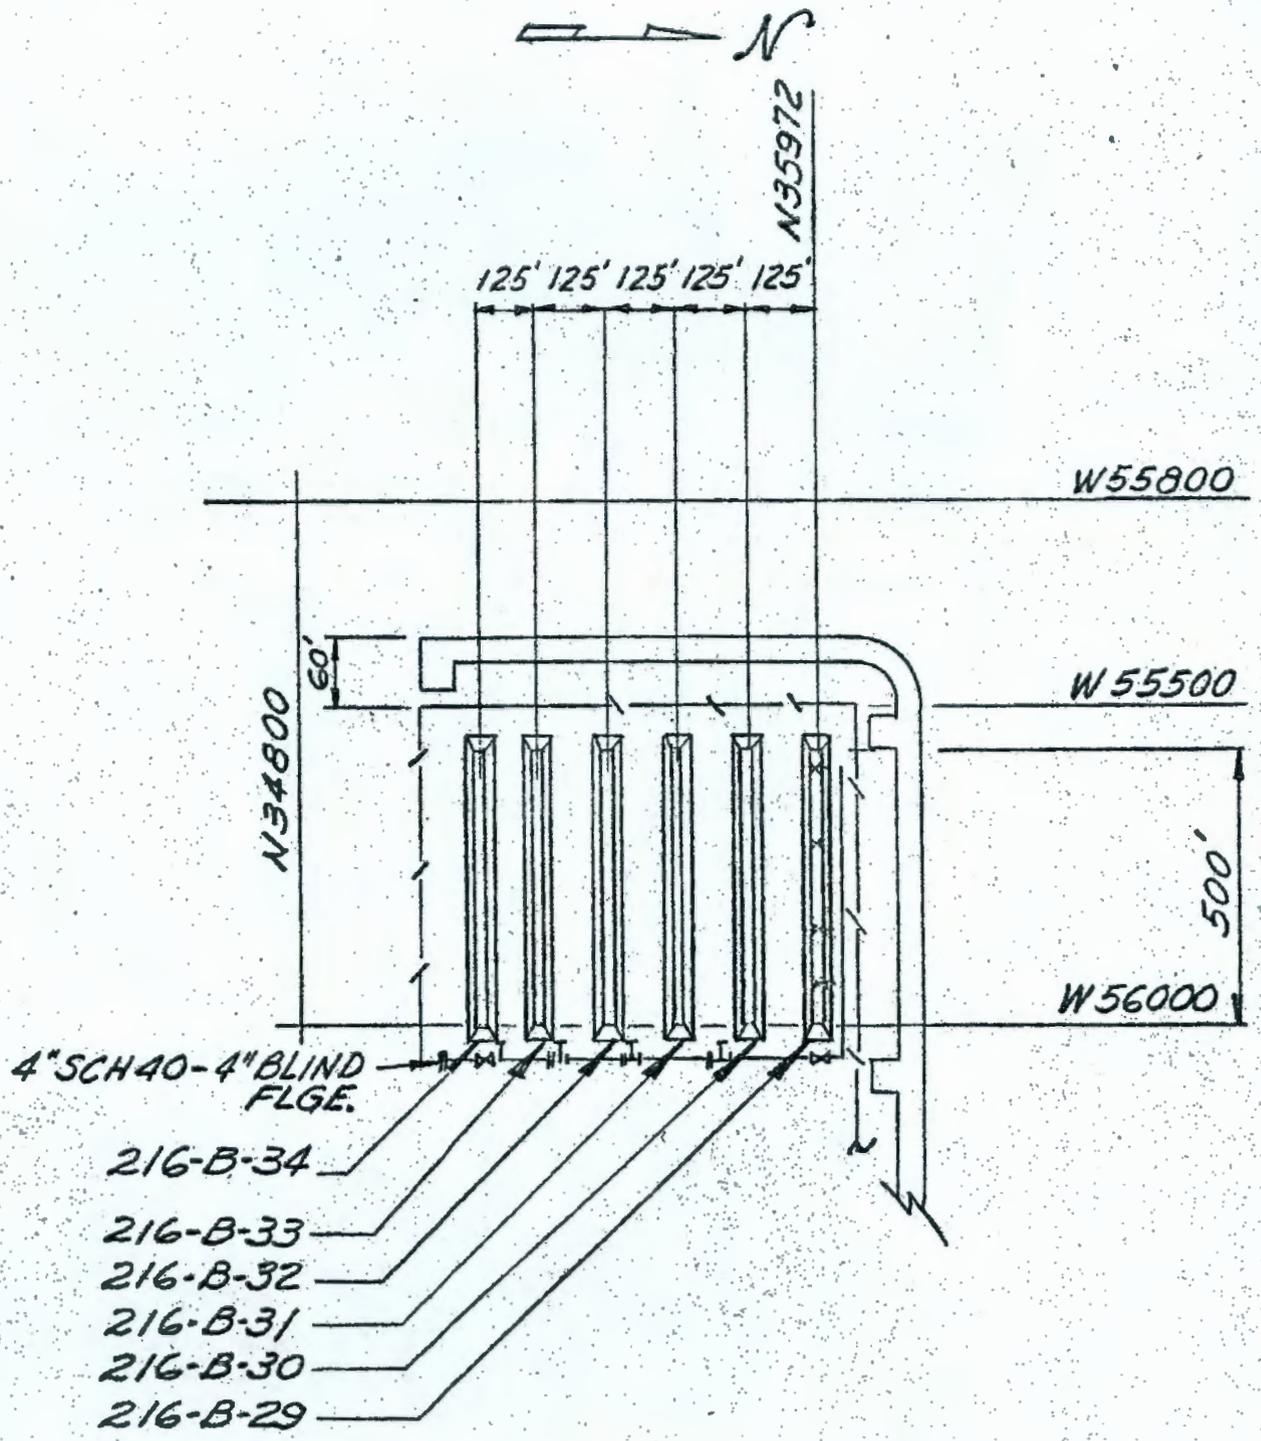


216-B-29-30-31-32-33-34
H-2-3336

32

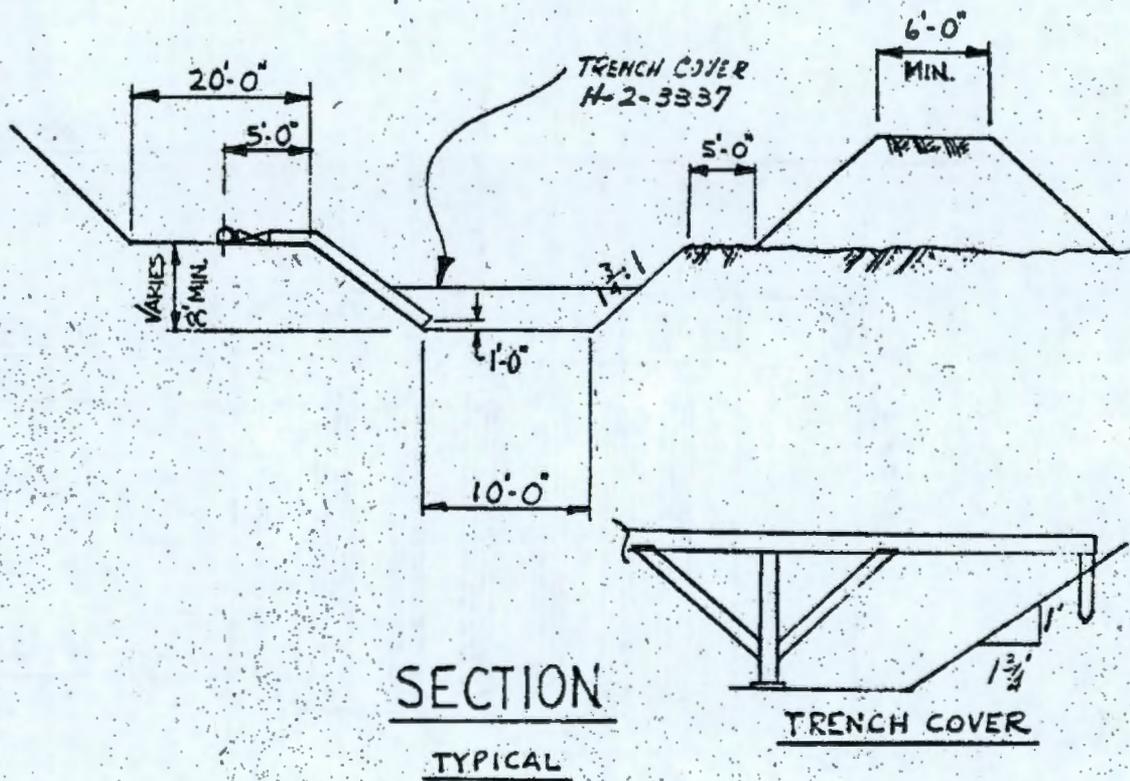


TAKEN FROM H-2-3337

216-B-29-30-31-32-33-34

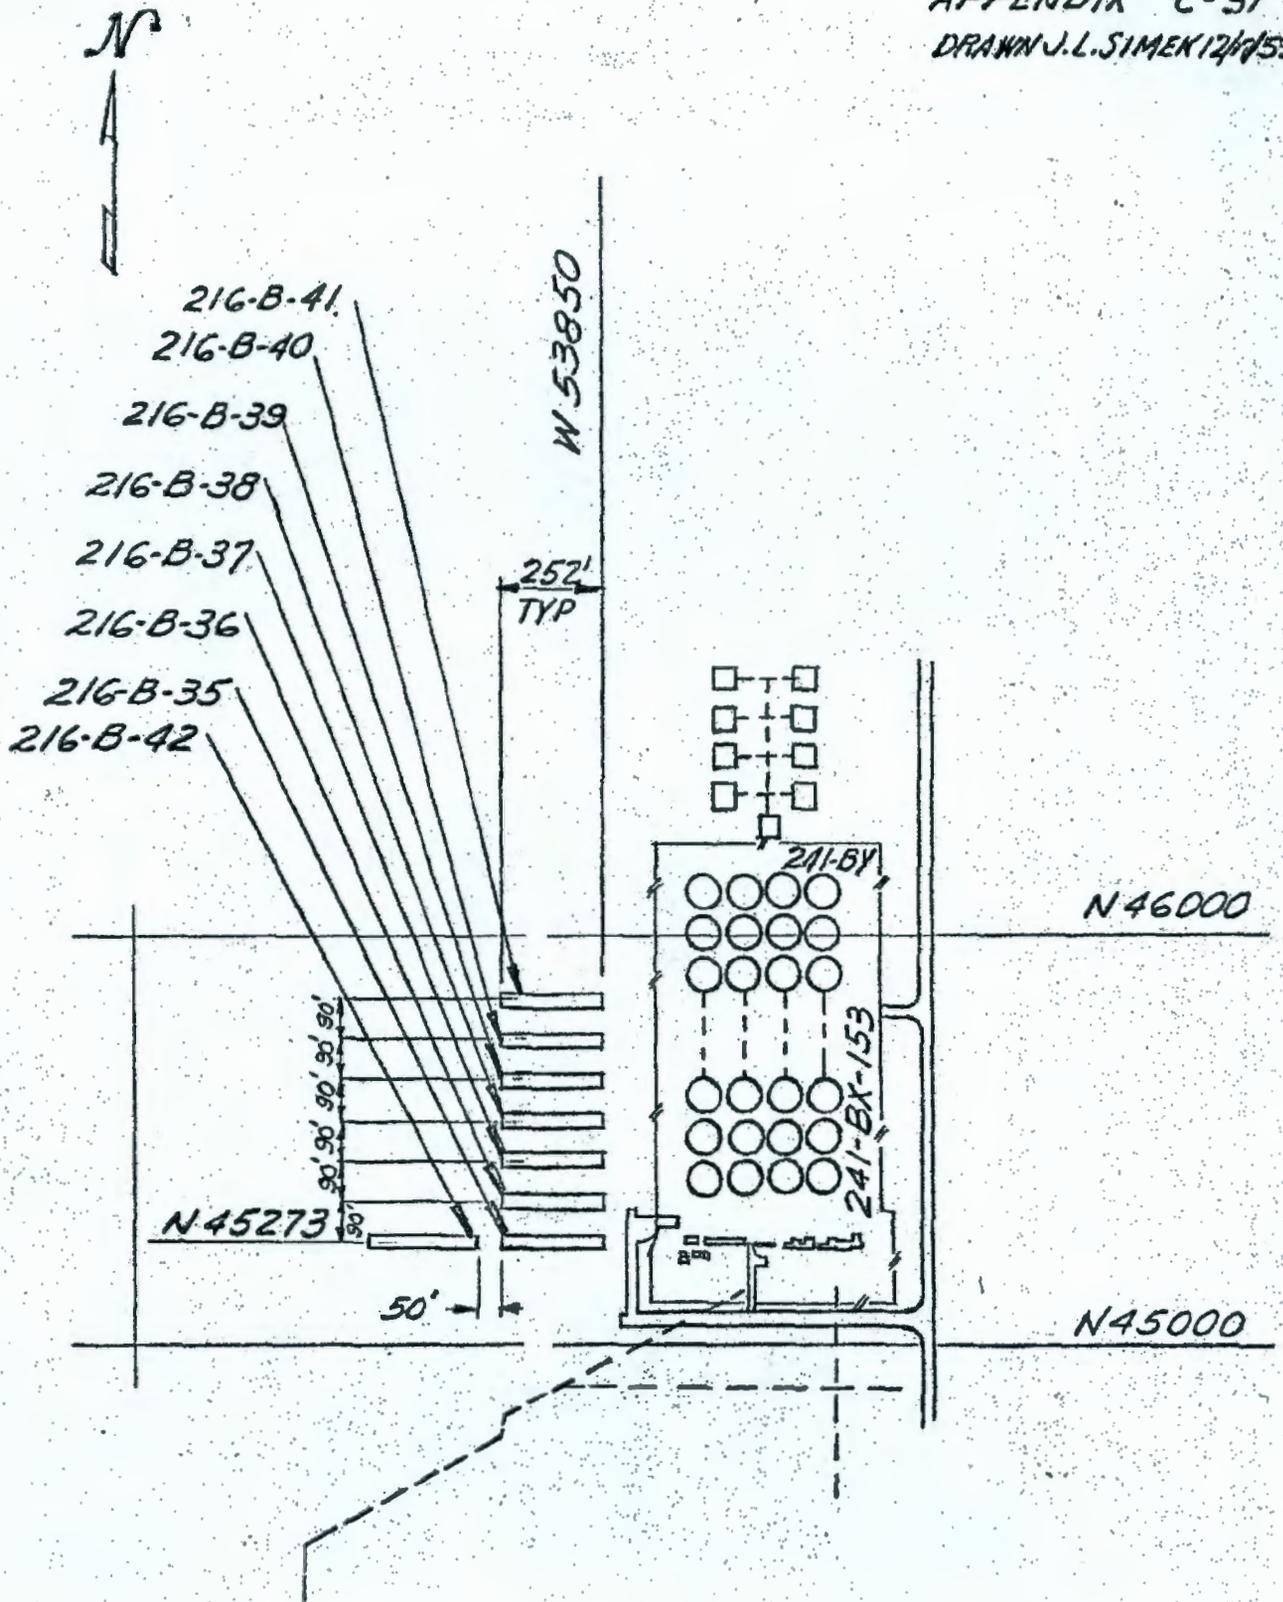



216 B-35-36-37-38-39-40-41-42

SK-2-2408

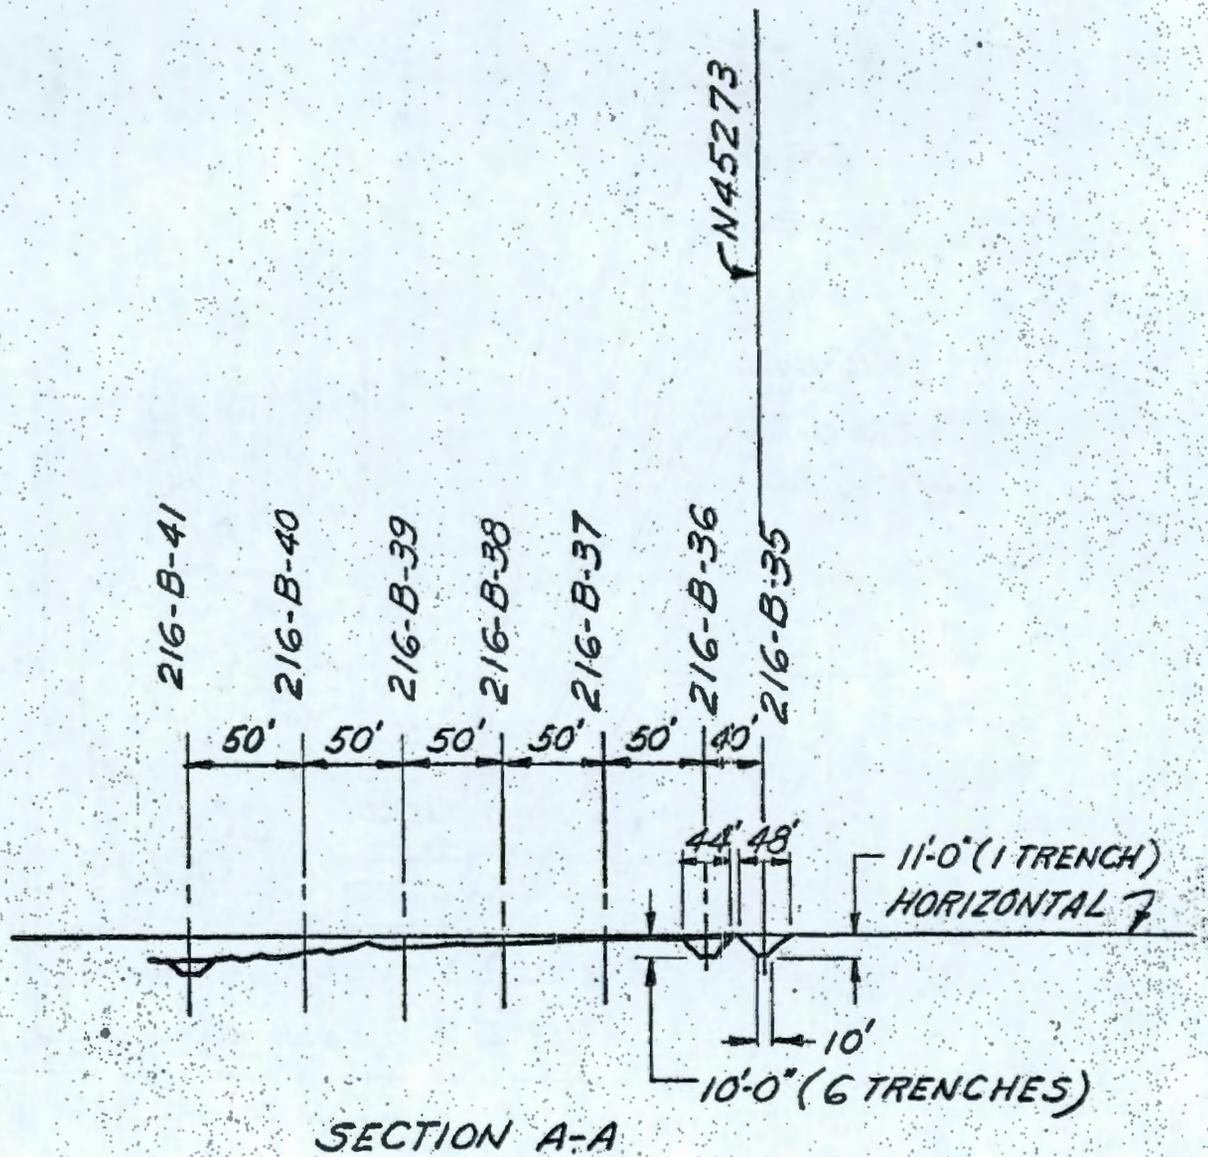



216 B-35-36-37-38-39-40-41-42

SK-2-2408

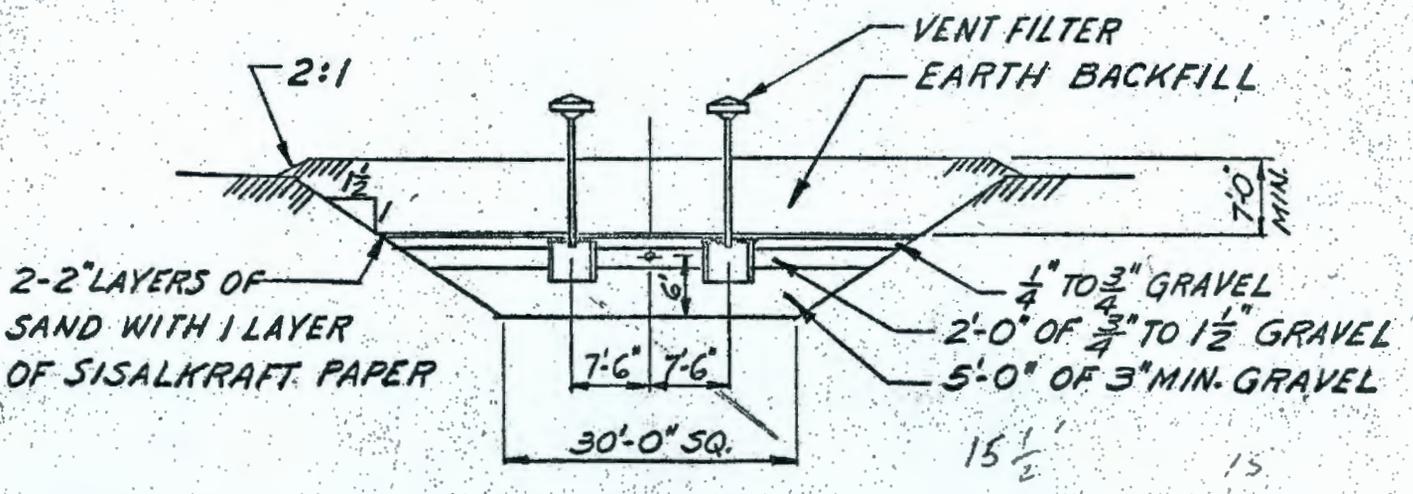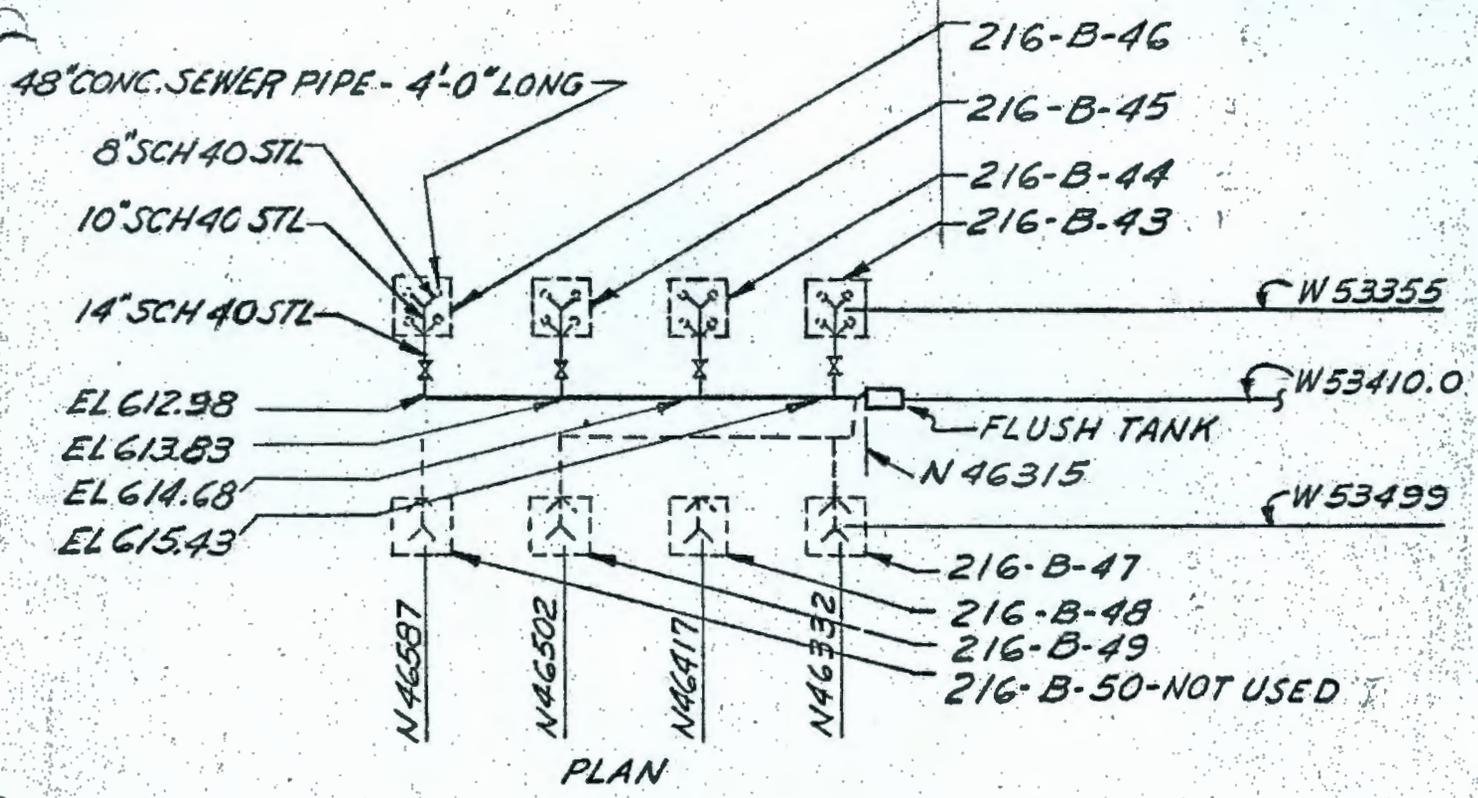

216-B-43-44-45-46-47-48-49-50

H-2-2603
 H-2-2605

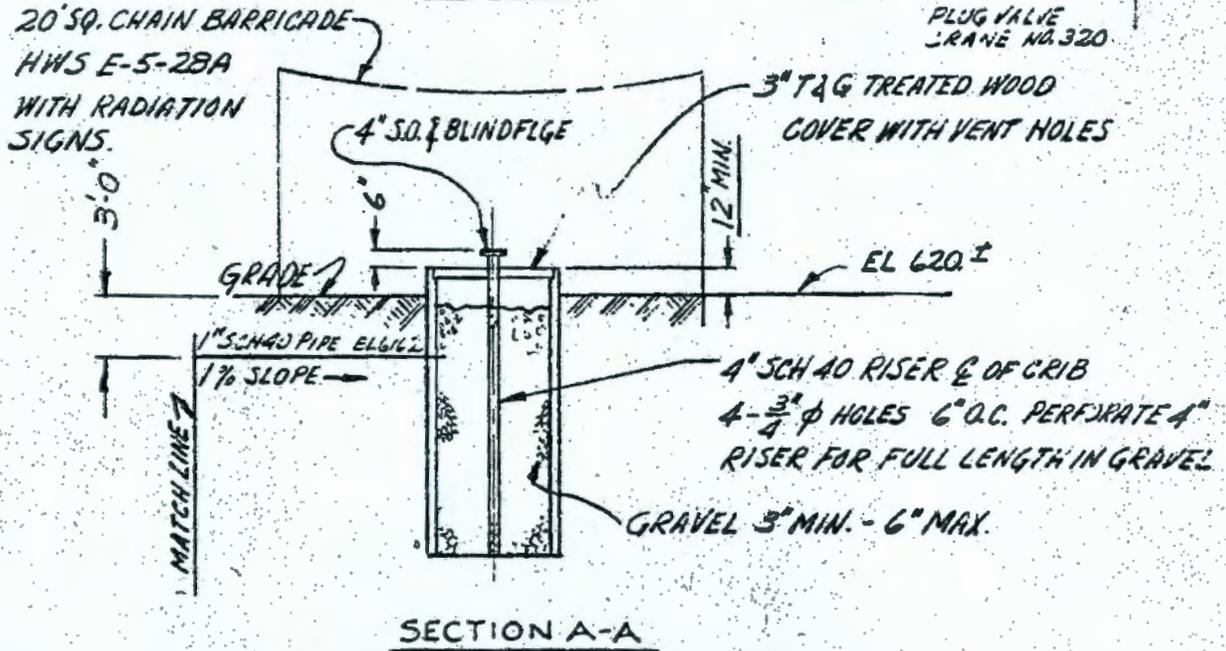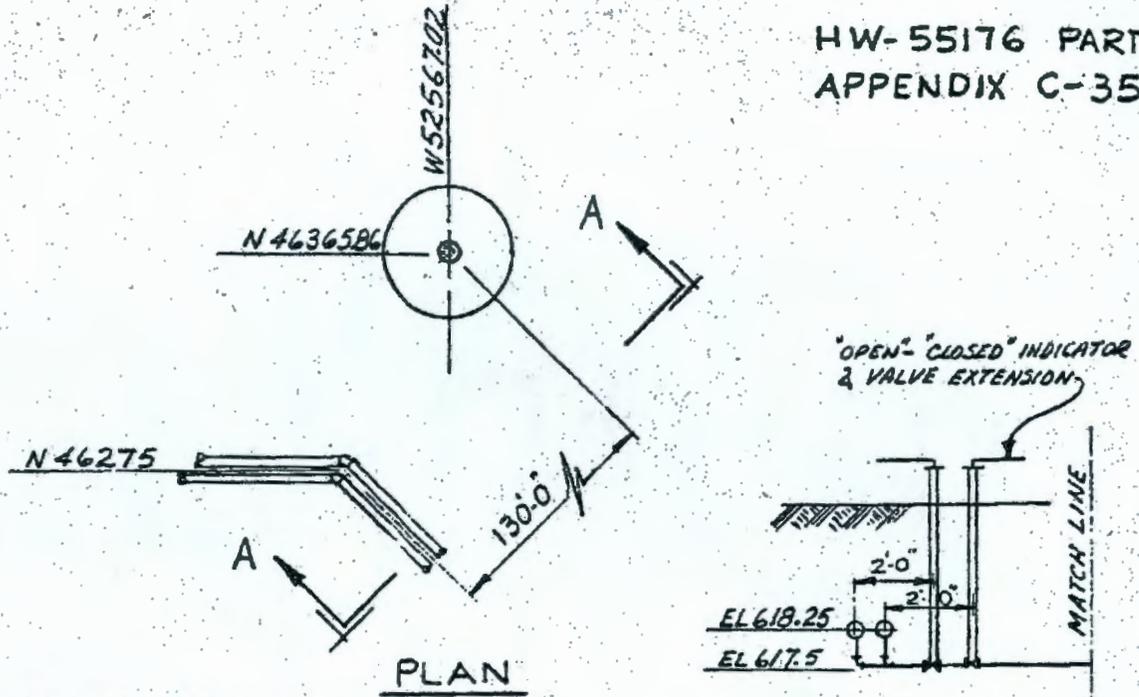

TAKEN FROM H-2-2908

216-E-51

THIS PAGE INTENTIONALLY
LEFT BLANK

THIS PAGE INTENTIONALLY
LEFT BLANK

UNCLASSIFIED

HW-55176 PT VII
Page 1

INDEX OF CPD CRIB BUILDING NUMBERS
DESIGNS OF CPD RADIOACTIVE LIQUID WASTE DISPOSAL SITES

Part VII of VII Parts
Process Technology - Study Report

by

E. Doud
Radiological Development
Facilities Engineering
Chemical Processing Department

October 22, 1959

D I S T R I B U T I O N

GR Bergdahl	TG LaFollette
JM Bernard	CE Linderoth
A Bradway	PR McMurray
WG Browne	WN Mobley
GK Carpenter	HE Parker
JR Cartmell	HF Peterson
E Doud	DW Pearce
J Durbin	OH Pilkey
JB Fecht	EL Reed
DR Gustavson	RE Roberts
CT Groswith	HP Shaw
WA Haney	ML Short
JF Honstead	RC Tabasinske
IM Jacques	W Tressler
EB Jackson	VW Wood
CE Kent	300 Files

UNCLASSIFIED

INDEX OF CPD CRIB BUILDING NUMBERS
DESIGNS OF CPD RADIOACTIVE LIQUID WASTE DISPOSAL SITES

Part VII of VII Parts
Process Technology - Study Report

INTRODUCTION

During the fourteen years or more which the separations areas have operated, many sites have been used for the disposal of radioactive liquid wastes. Various methods have been used in assigning building numbers to these sites and, in a number of cases, changes have been made which have brought about some confusion. One of the reasons being some currently used building numbers do not agree with the numbers existing on design prints for the facilities. Reference (2) was an effort to establish a listing of the liquid waste disposal sites. It required considerable time and research to locate information concerning these sites.

Many varied designs have been used for the disposal of radioactive liquid wastes. Reverse wells, trenches, cribs or caverns, etc., have been used. Specific information on these facilities is often difficult to obtain for in some instances they were constructed on work orders with no records being retained on the design. In general, the design on each facility has been different. This has made it extremely difficult for people to have a good working knowledge of the various waste disposal sites.

PURPOSE

The purpose of this report (Part VII) is to provide a ready reference of the "C" Area, "N" Area, and miscellaneous liquid waste disposal sites as well as a compilation of sketches showing the basic information on the design of each facility.

Another objective is to establish a simplified and uniform numbering system. Still another objective is to provide an up-to-date tabulation. Previous parts of this report have provided information on cribs for other areas.

SUMMARY AND CONCLUSIONS

All radioactive liquid waste disposal sites should have the 216 Building number designation. These should be further grouped by giving all such sites for Purex a prefix of 216-A. Other major series would be 216-S for Redox; 216-T for "T" Plant; 216-B for "B" Plant; 216-U for "U" Plant; 216-Z for "Z" Plant; 216-C for "C" Area; and 216-N for "N" Area.

The numbering list in "Official Hanford Works Building List - Specification HW-5000" by Engineering Files - Construction Engineering should be revised to more closely follow the above numbering system.

RECOMMENDATIONS

It is recommended that the following action be taken:

1. All groups and services referring to the "C" Area and "N" Area cribs or report data concerning them should use the index numbering system as presented in this report.
2. That all drawings concerning these disposal sites, including maps, be revised to show the proper locations and numbers for these cribs.
3. Any suggestions for improving the usefulness of this report should be referred to the author.

DISCUSSION

This Part VII completes the series of reports on CPD waste disposal sites. The seven parts give a listing of the site designations, the locations and a description of each structure. These listings provide a basis for future building number assignments. Revisions and additions for each part will be issued as necessary to keep it current.

While some sincere efforts have been made to try and keep a methodical system for recording waste disposal sites, a number of problems have developed, for example, HW-5000, Sheet 29 of 50, lists only eight cribs in the 216-S series. Also reference 2 has assigned numbers which do not agree with the crib numbers assigned on many drawings.

As indicated earlier, the use of the crib index, as presented in this report should be very easy. In addition, information is presented which is very difficult to locate in the records and in some cases it is not available in the records.

REFERENCES

1. HW-5000, "Official Hanford Works Building List - Specification HW-5000" by Engineering Files - Construction Engineering Operation.
2. HW-43121, "Tabulation of Radioactive Liquid Waste Disposal Facilities," by HV Clukey dated May 10, 1956.
3. HW-33305, "Tabulation of Radioactive Liquid Waste Disposal Facilities," by HV Clukey dated October 8, 1954.
4. HW-60807, "Unconfined Underground Radioactive Waste and Contamination in the 200 Areas," by KF Baldrige dated July 15, 1959.

CROSS REFERENCE"C" & "N" Area Radioactive Liquid Waste Disposal Sites

<u>Suggested Crib No.</u>	<u>Number Listed In HW-5000</u>	<u>Number Listed in HW-33305</u>	<u>Number Used on Drawings or Original #</u>	<u>Remarks</u>
216-C-1	216-C-1	216-C Crib	216-C	
216-C-2	216-C-2	291-C Dry Well	-	
216-C-3	216-C-3	201-C Leading Pit	-	
216-C-4	216-C-4	None	-	
216-C-5	216-C-5	None	-	
216-C-6	241-CX	None	241-CX	
216-C-7	None	None	-	
216-C-8	None	None	271-CR	
216-C-9	None	C Canyon Excavation	-	
216-N-1	None	212-N Swamp	-	
216-N-2	None	212-N #1 Trench	-	
216-N-3	None	212-N #2 Trench	-	
216-N-4	None	212-P Swamp	-	
216-N-5	None	212-P Trench	-	
216-N-6	None	212-R Swamp	-	
216-N-7	None	212-R Trench	-	

APPENDIX

A. Explanation of Parts to the Report

Part I will cover the Purex Radioactive Liquid Waste Disposal Sites.

Part II will cover the "Z" Plant Radioactive Liquid Waste Disposal Sites.

Part III will cover the Redox Plant Radioactive Liquid Waste Disposal Sites.

Part IV will cover the "U" Plant Radioactive Liquid Waste Disposal Sites.

Part V will cover the "T" Plant Radioactive Liquid Waste Disposal Sites.

Part VI will cover the "B" Plant Radioactive Liquid Waste Disposal Sites.

Part VII will cover the "C" Plant, Hot Semi-Works, the 200 North Areas and miscellaneous.

B. Index for C Plant and North Areas Radioactive Liquid Waste Disposal Sites.

C. Sketches of "C" Area Waste Disposal Facilities.

D. Map of C Area Crib Sites (SK-2-18149).

E. Map of N Area Crib Sites (SK-2-17842).

F. Map of Waste Burial Gardens 200-E Area (H-2-31269).

G. Map of Waste Burial Gardens 200-W Area (H-2-31268).

UNCLASSIFIED

HW-55176, PT VII
Page 6

APPENDIX B - Revised 10/19/59

CRIB INDEX - C AREA

<u>Number</u>	<u>Description Appendix Sheet No.</u>	<u>Service</u>	<u>Use Dates</u>		<u>Status</u>
			<u>From</u>	<u>To</u>	
216-C-1	C-1 1A	201-C Process Condensate	1/53		Inactive
216-C-2	C-2	291-C Stack & Filter Drum	1/53		Active
216-C-3	C-3	271-C Chemical Wastes	1/53	3/54	Abandoned
216-C-4	C-4	276-C Organic Wastes	7/55		Inactive
216-C-5	C-5	201-C High Salt Wastes	3/55		Inactive
216-C-6	C-6	241-CX Waste Storage Con.	9/55		Active
216-C-7	C-7	209-E Critical Lab Waste	Not Used		New
216-C-8	C-8	271-CR Ion Exchange Waste	Not Used		New
216-C-9	C-9	C Area Process Cooling Wtr	6/53		Active

CRIB INDEX - N AREA

216-N-1	None	212-N Basin Overflow	1944	6/52	Backfilled
216-N-2	None	212-N Basin Cleanout	-	1947	Abandoned
216-N-3	None	212-N Basin Cleanout	-	6/52	Inactive
216-N-4	None	212-P Basin Overflow	1944	6/52	Backfilled
216-N-5	None	212-P Basin Cleanout	-	6/52	Inactive
216-N-6	None	212-R Basin Overflow	1944	6/52	Backfilled
216-N-7	None	212-R Basin Cleanout	-	6/52	Inactive


UNCLASSIFIED

APPENDIX B - Revised 10/19/59

Index of Burial Grounds and Gardens

<u>Designation</u>	<u>Service</u>	<u>Use Dates</u>		<u>Status</u>
		<u>From</u>	<u>To</u>	
<u>200 East Area (H-2-31269)</u>				
A. Dry Waste Burial Ground				
#1	Boxed solid wastes	1945	1953	Depleted
#12	Boxed solid wastes	1956	-	Active
B. Industrial Burial Ground				
#2	Process equipment	1947	-	9 of 11 Trenches Used
#5	Process equipment	1954	1957	Depleted
#5A	Purex L Cell & Misc. Equip.	1958		Depleted
#10	Process equipment	1955	-	Active
C. Construction Burial Ground				
#4	221-B Plant Modif. Wastes	1955		Depleted
No number	293-A and Purex Crane Construction Wastes		1958	Included in Burning Ground
D. Miscellaneous Over Ground Storage				
#9	Metal Recovery Equipment	1953		Active
	(adjacent to east side of Industrial Burial Garden #2)			
<u>200 West Area (H-2-31268)</u>				
A. Dry Waste Burial Garden				
#1	Boxed solid wastes	1944	-	Depleted
#2	Boxed solid wastes	-	1954	Depleted
#3	Boxed waste & process equipment	1954	-	Active
#4	Boxed solid wastes	Not used		Reserved
B. Industrial Burial Garden				
#1	Process equipment	1947	1954	Depleted
#2	Process equipment	Not Used		Reserved
C. Regulated Storage Area				
No Number	Contaminated Equipment	1954	-	Active

H.V. - 55176-PT VII
APPENDIX C-1
SHT NO. 1
J.P. 10-9-59

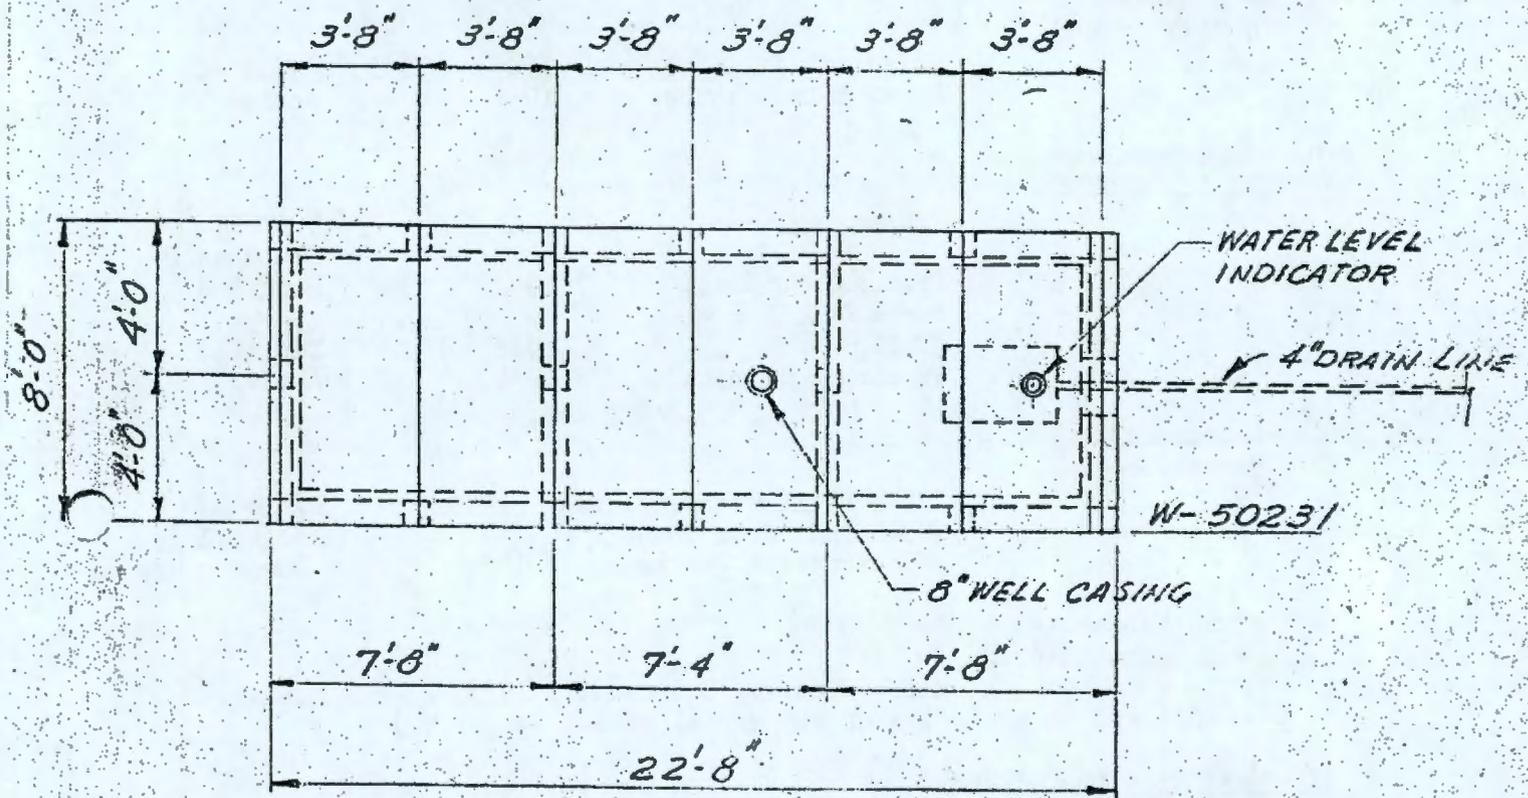


PLAN

N-42080


216-C-1

H-2-4037

... 1/6 1/4
 APPENDIX
 SHT. NO. 2
 JH 10-9-59

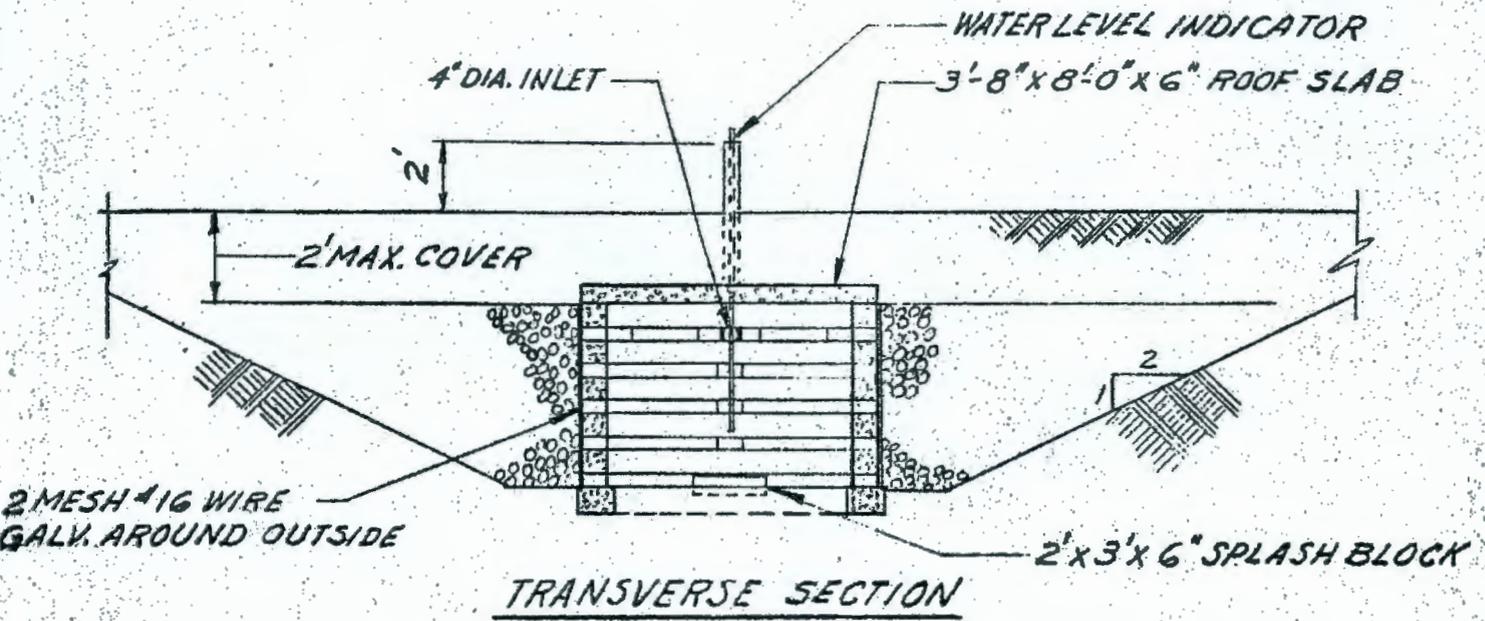

TRANSVERSE SECTION

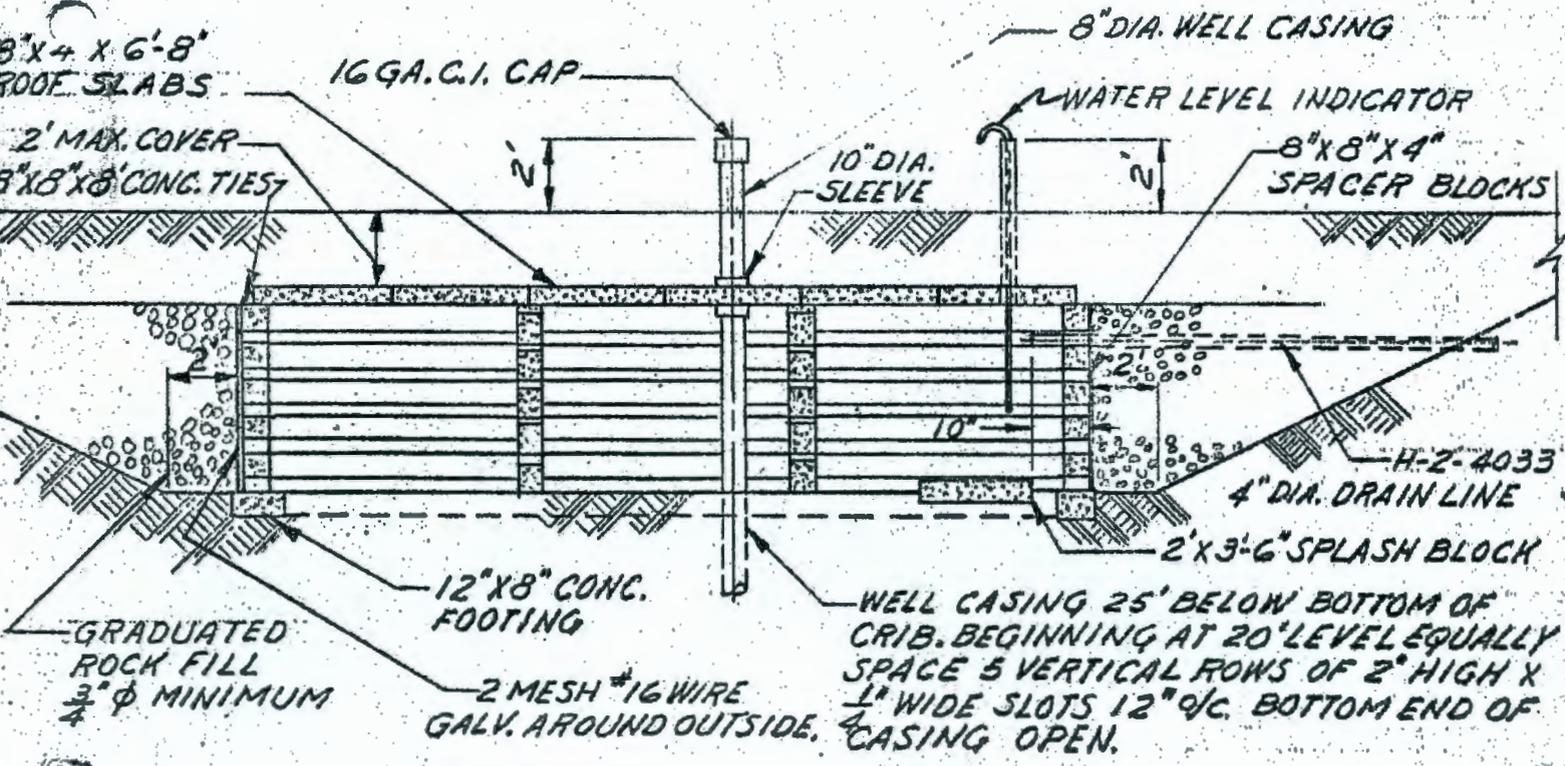


LONGITUDINAL SECTION

216-C-1


H-2-4037

HW-55176-PT III
APPENDIX C-2
JL 10-8-59

W 50000

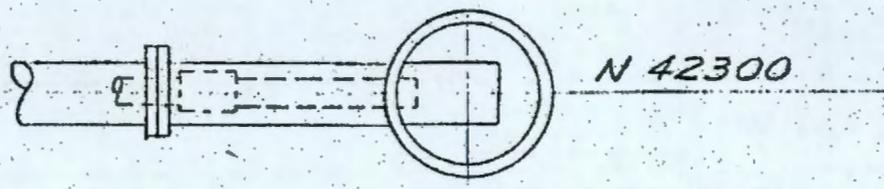


PLAN

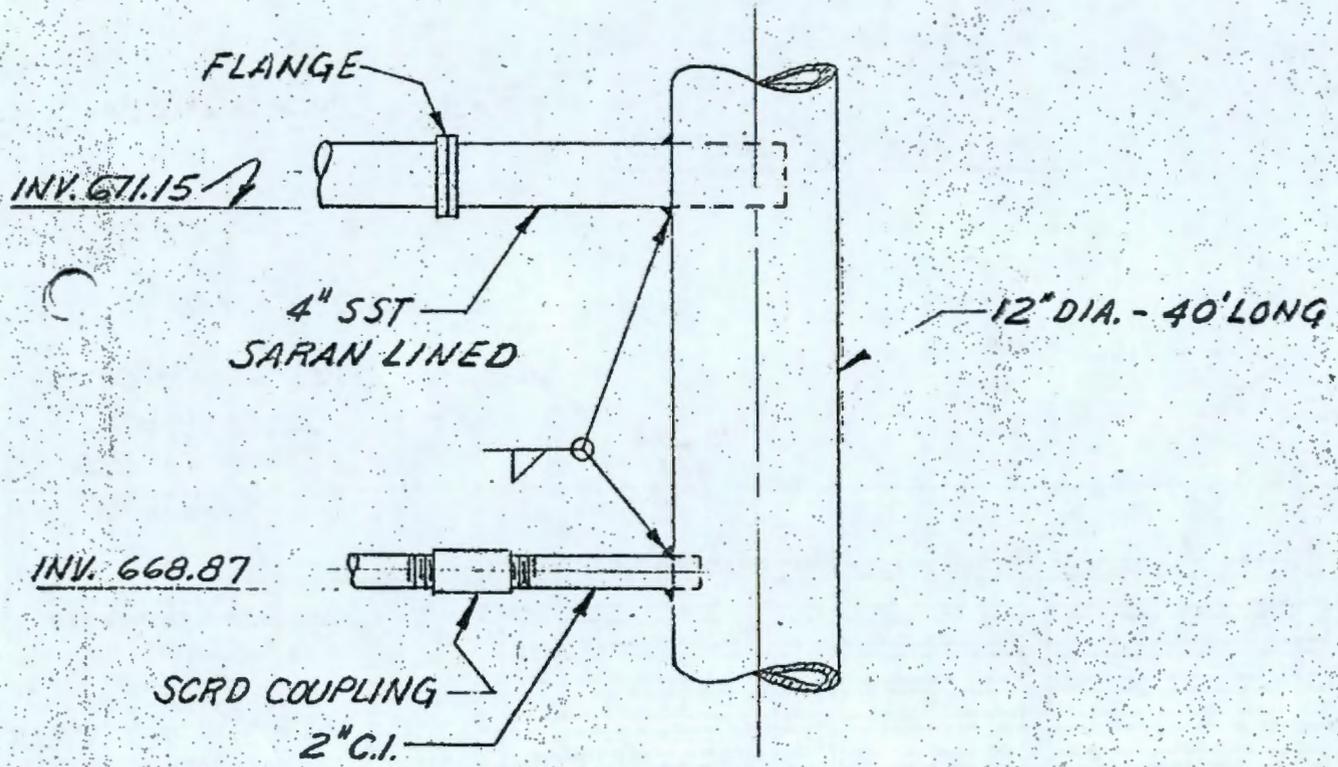

ELEVATION

216-C-2


H-2-4033

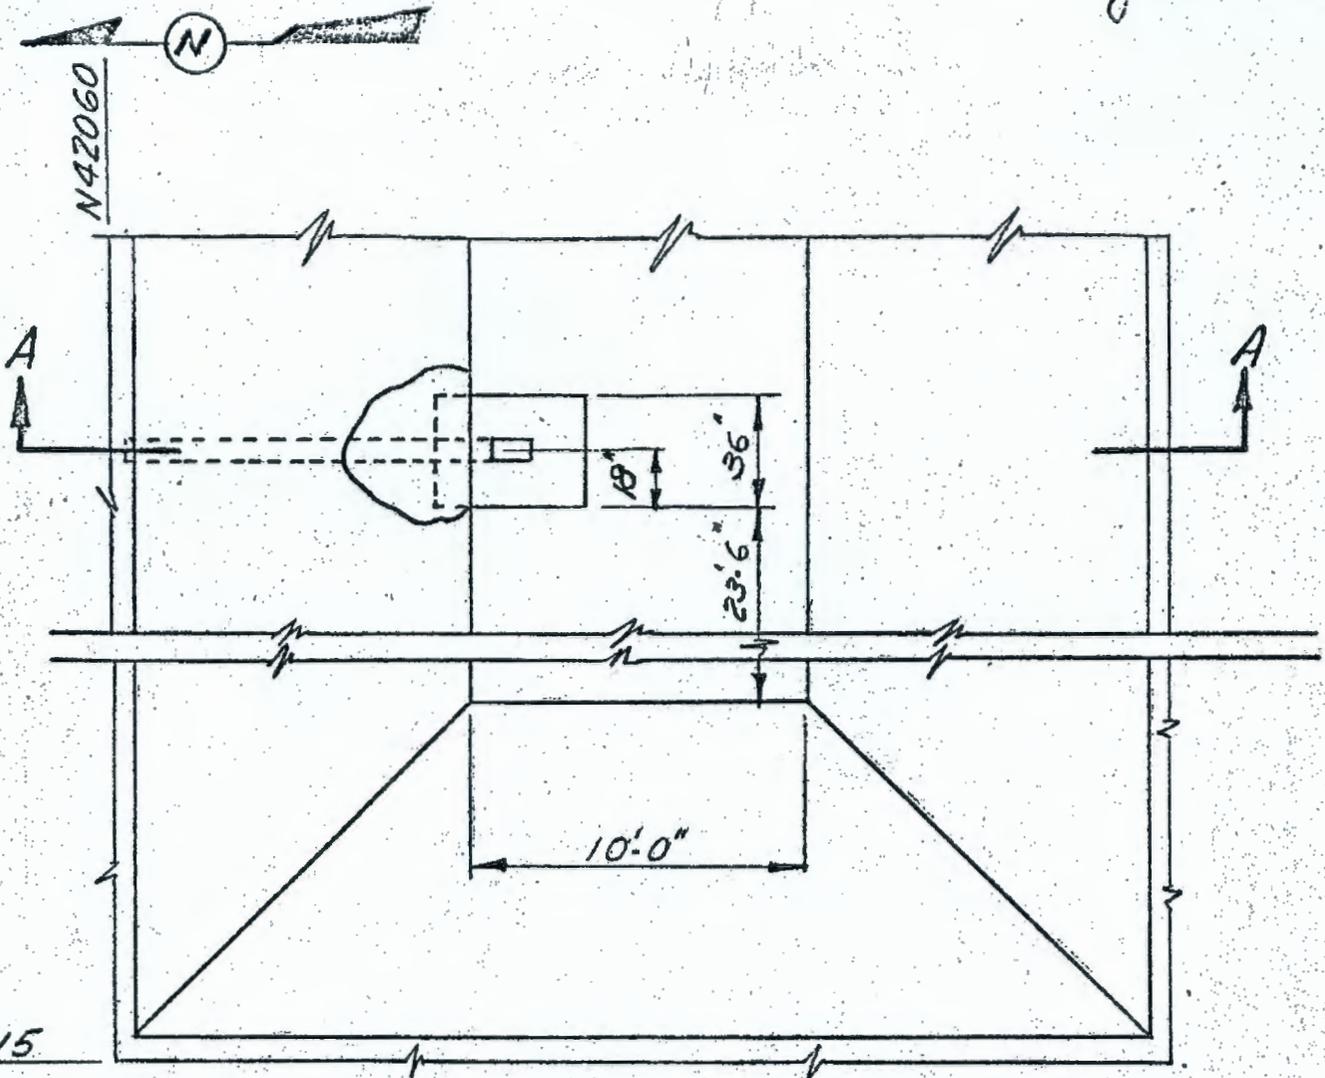

W50415

PLAN

GRADE 682.67

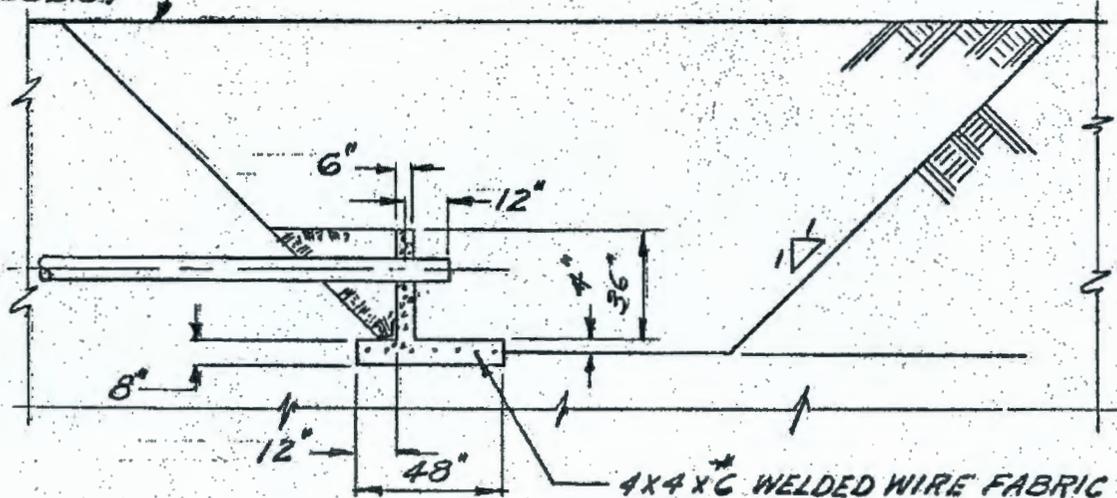



SECTION A-A

H-2-4034

216-C-3

4

JR 10-8-59

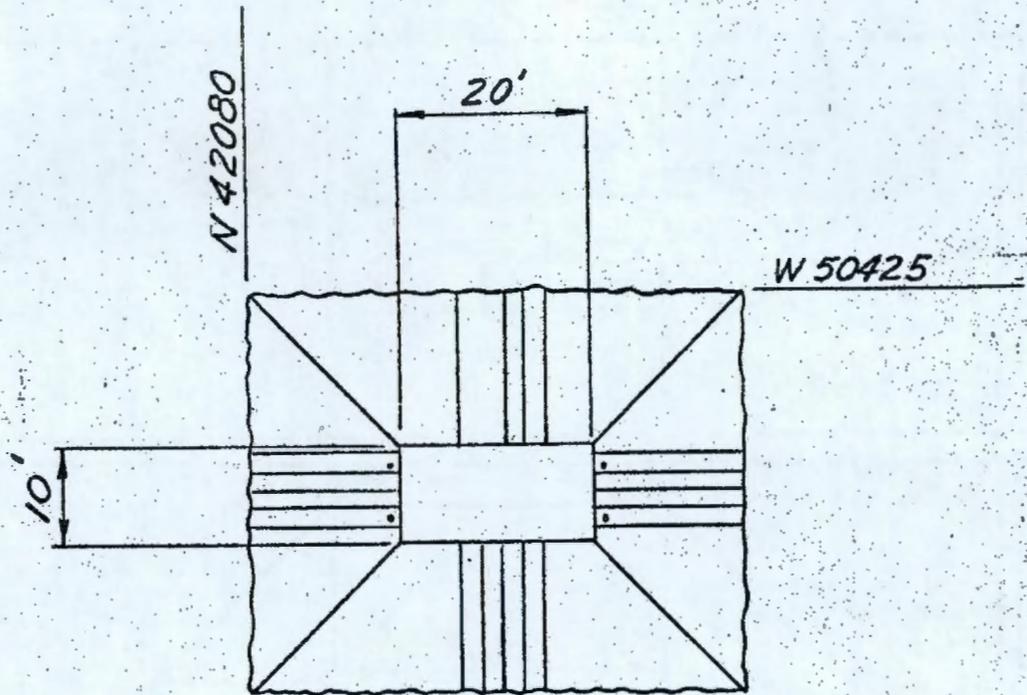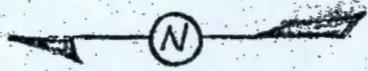


PLAN

FOR LONGITUDINAL & TRANSVERSE
SECTION - SEE 216-C-6 CRIB

216-C-4

H-2-4010



5

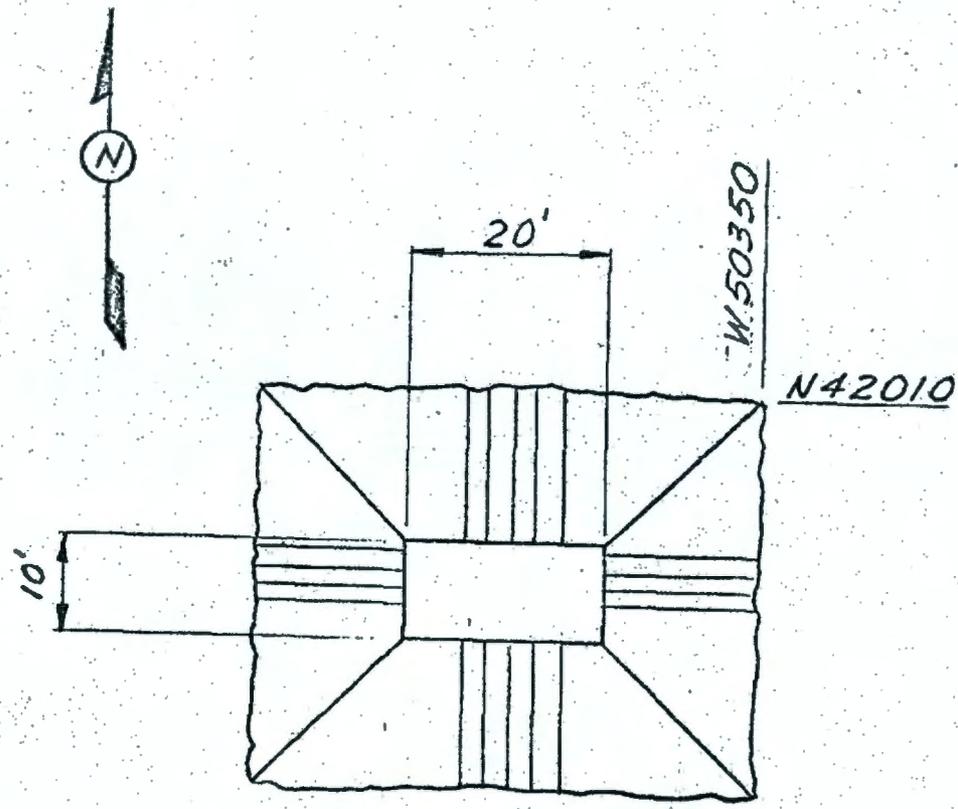


PLAN

FOR LONGITUDINAL & TRANSVERSE
SECTION - SEE 216-C-6 CRIB

216-C-5
H-2-4010

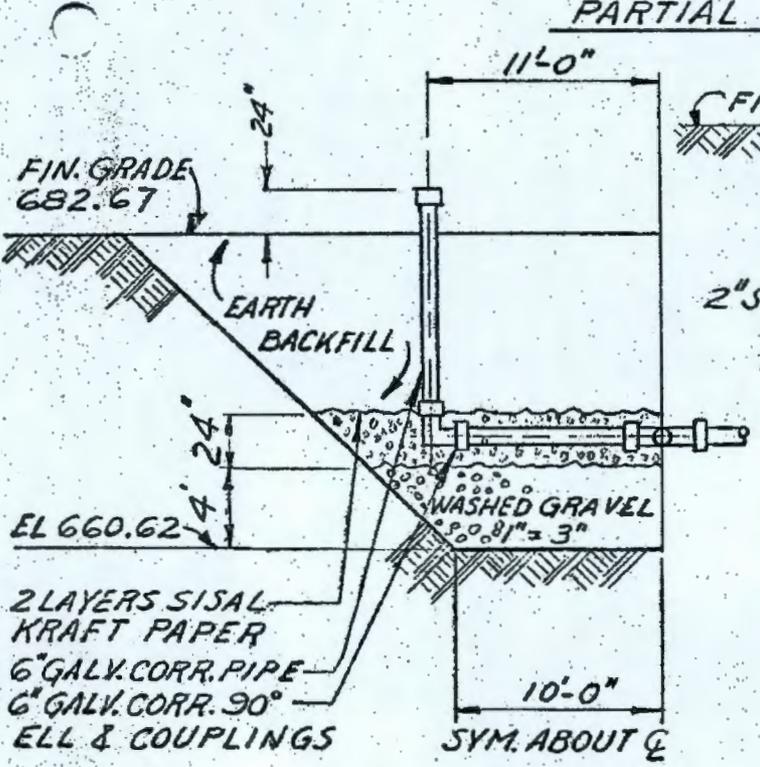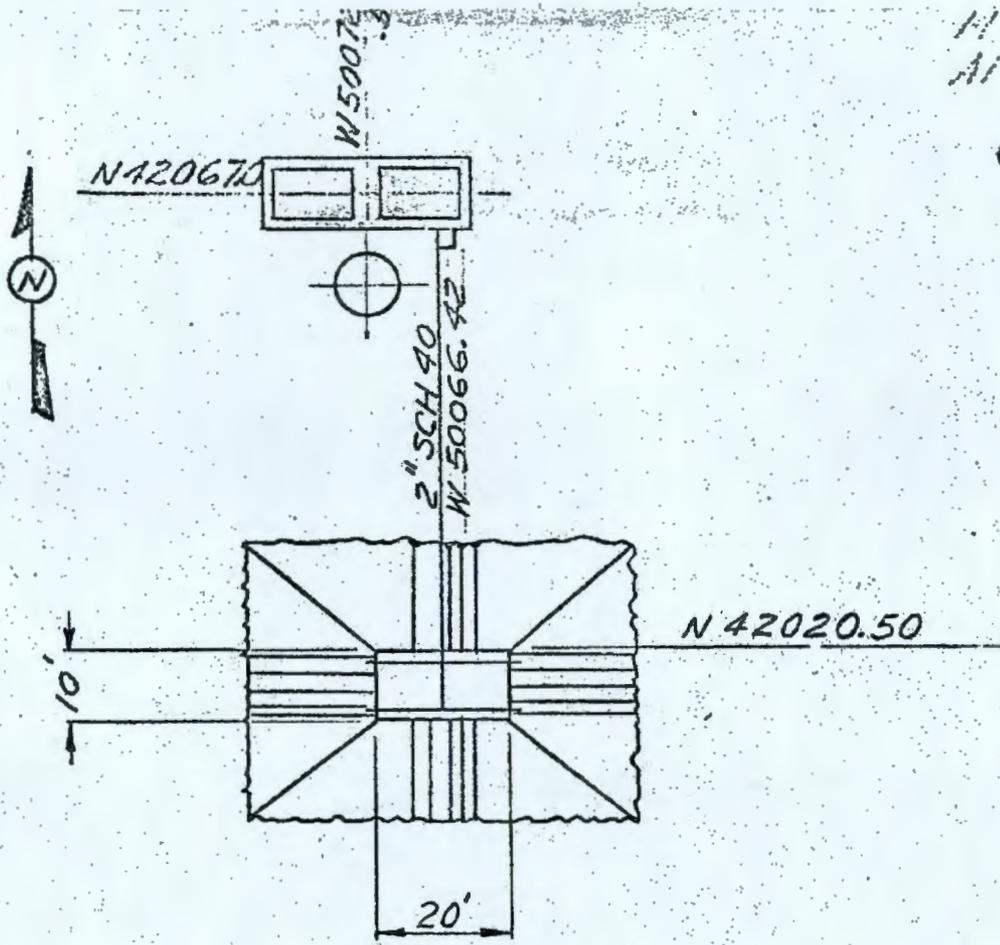

LONGITUDINAL SECTION



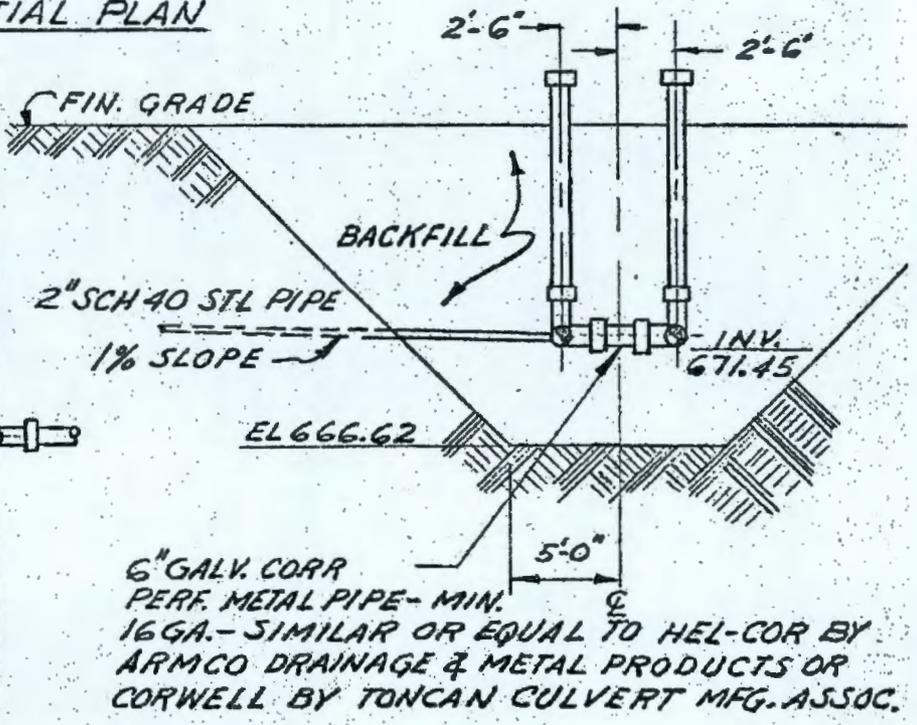


TRANSVERSE SECTION

6" GALV. CORR
 PERF. METAL PIPE - MIN.
 16 GA. - SIMILAR OR EQUAL TO HEL-COR BY
 ARMCO DRAINAGE & METAL PRODUCTS OR
 CORWELL BY TONCAN CULVERT MFG. ASSOC.


216-C-6
 H-2-4425

HW-55116-PTVRL
 APPENDIX C-7
 JLL 10-8-59

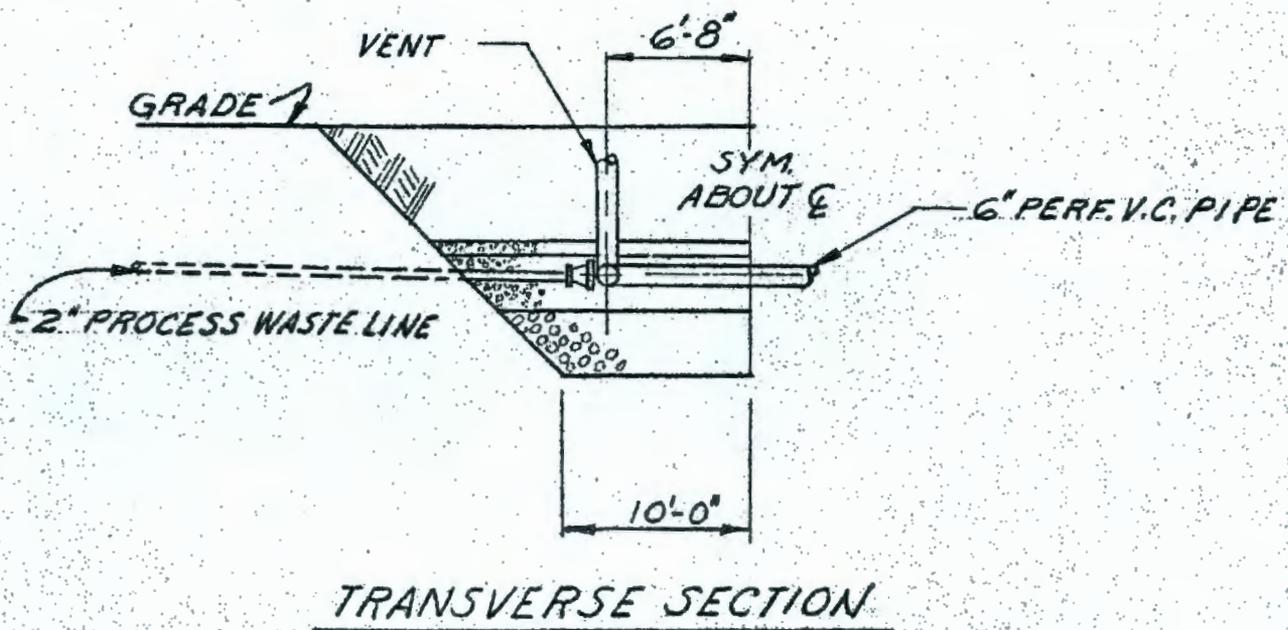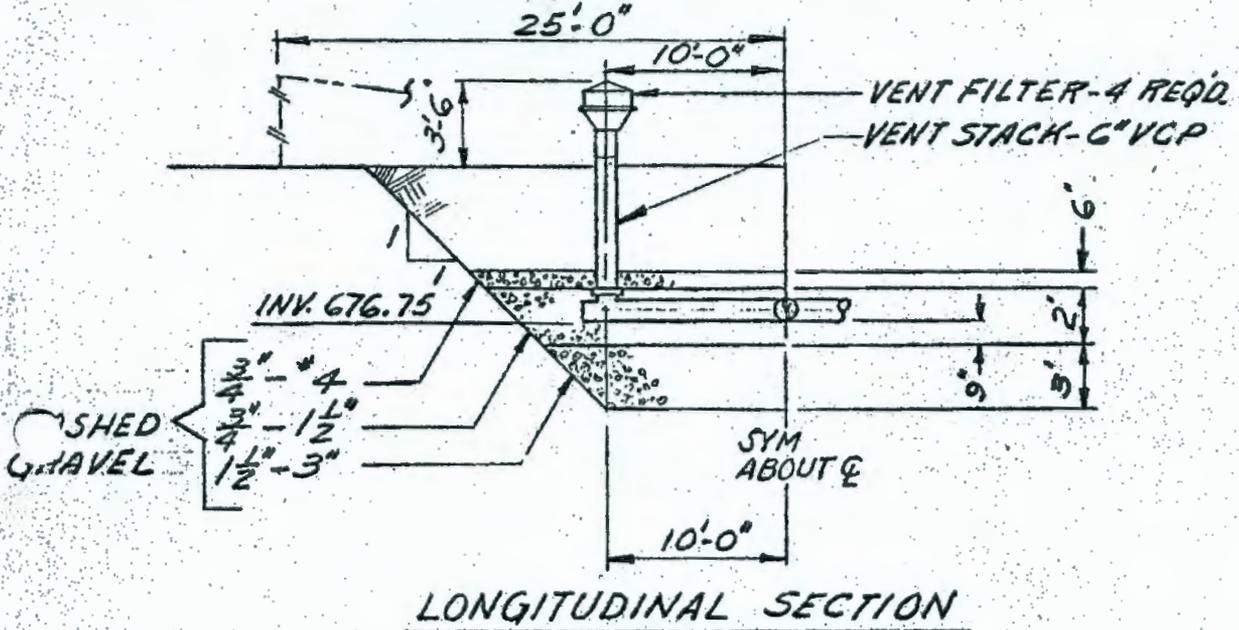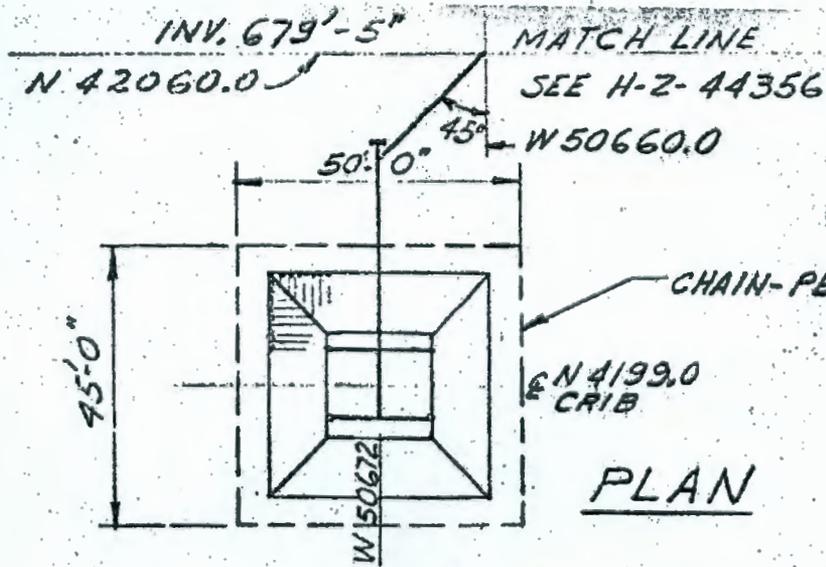


216-C-7
 H-2-44356

HW-55176-PTVII
 APPENDIX C-8
 JIL 10-9-59

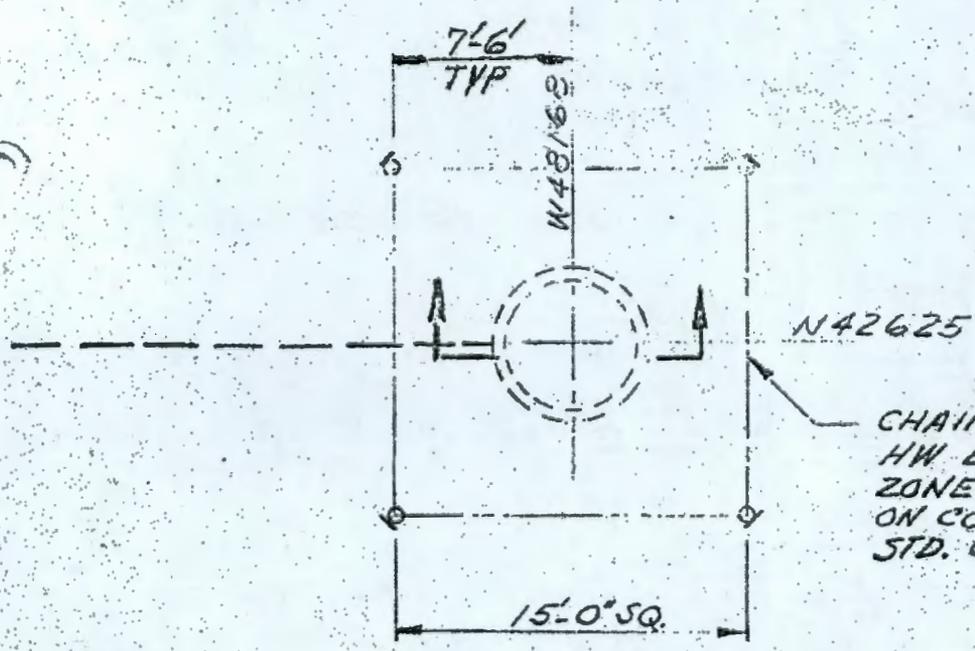

CHAIN BARRICADE PER
 HW E-5-28a WITH RADIATION
 ZONE. SIGN SIZE I MOUNTED
 ON CORNER POSTS PER HANFORD
 STD. C-5-21.

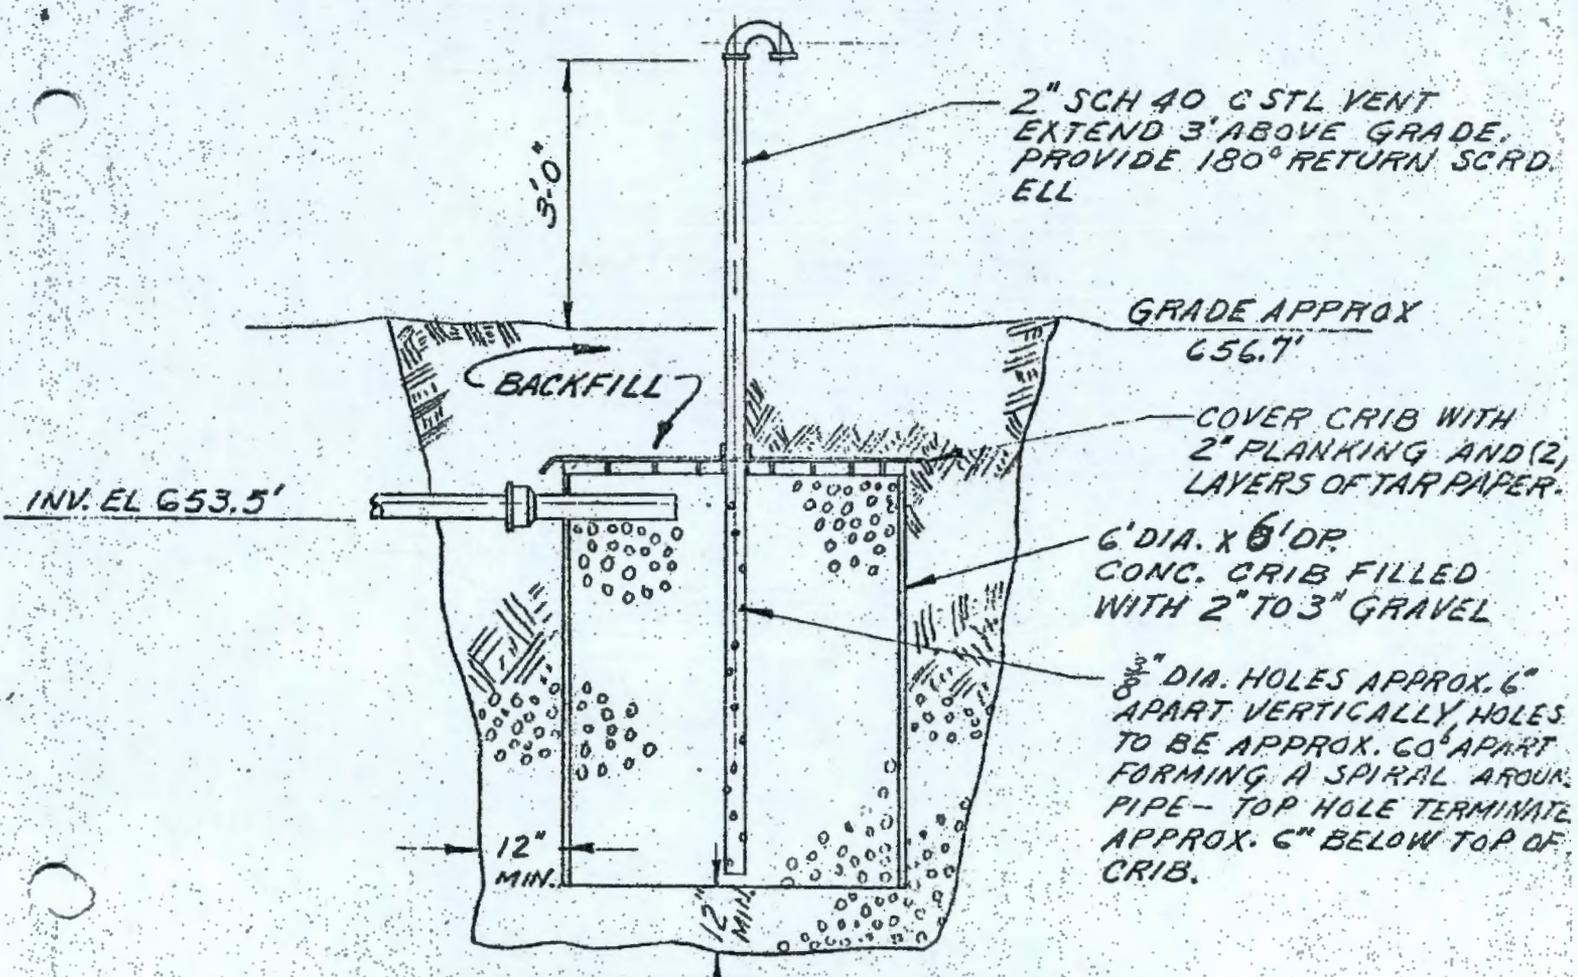

2" SCH 40 C STL VENT
 EXTEND 3' ABOVE GRADE.
 PROVIDE 180° RETURN SCRD
 ELL

GRADE APPROX
 656.7'


COVER CRIB WITH
 2" PLANKING AND (2)
 LAYERS OF TAR PAPER.

6' DIA. X 6' DP.
 CONC. CRIB FILLED
 WITH 2" TO 3" GRAVEL

3/8" DIA. HOLES APPROX. 6"
 APART VERTICALLY, HOLES
 TO BE APPROX. 60" APART
 FORMING A SPIRAL AROUND
 PIPE - TOP HOLE TERMINATE
 APPROX. 6" BELOW TOP OF
 CRIB.

INV. EL 653.5'


216-C-8

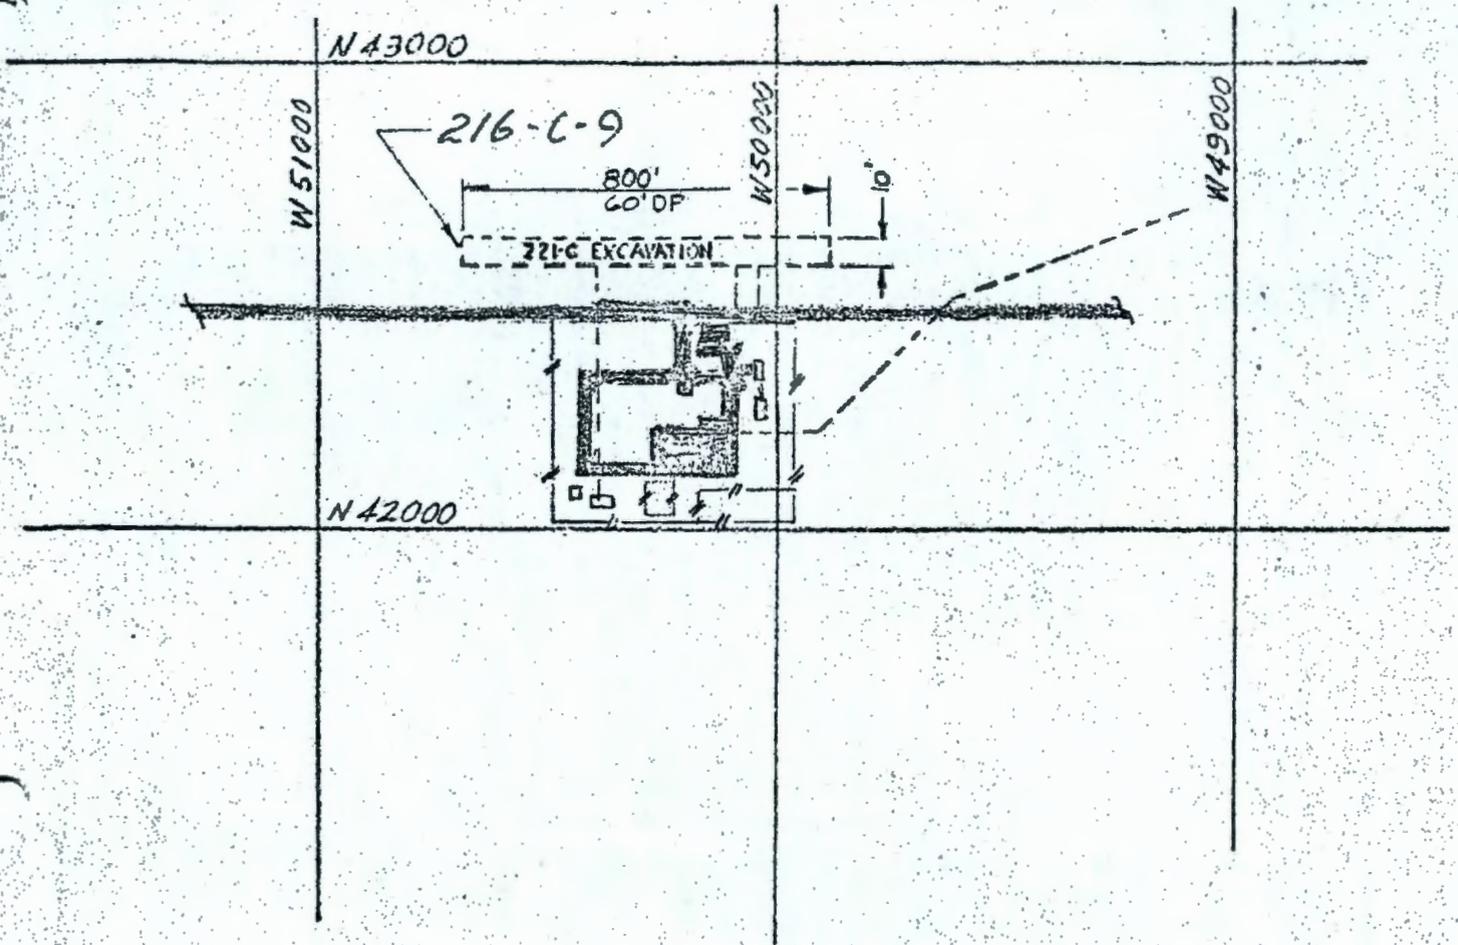

H-2-4010

216-C-9


HW-55176-PL/PL
APPENDIX-D

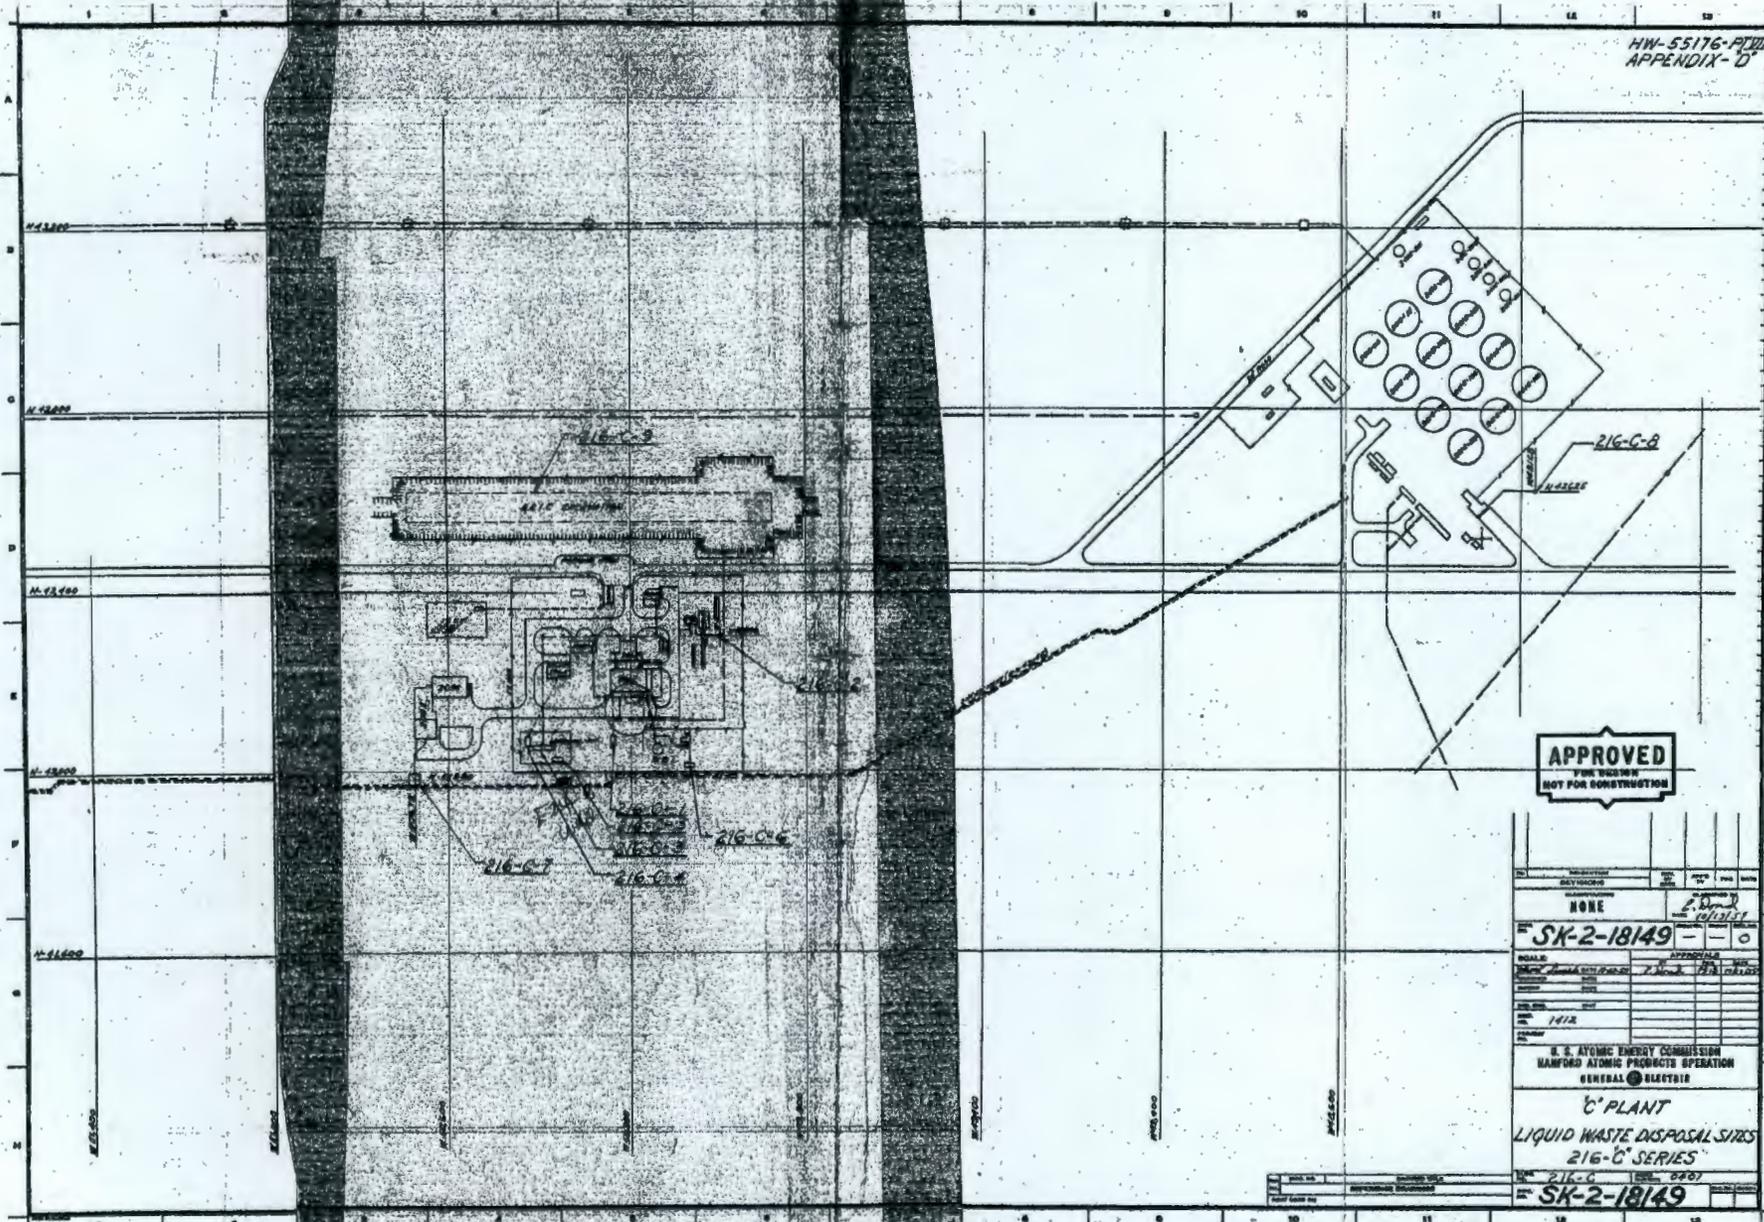

APPROVED
FOR USE
NOT FOR CONSTRUCTION


NO.	REVISION	DATE	BY	CHKD.	APP'D.
DESCRIPTION					
NONE					
PROJECT NO. SK-2-18149					
DRAWN BY <i>[Signature]</i>					
CHECKED BY <i>[Signature]</i>					
DATE 1978					
U. S. ATOMIC ENERGY COMMISSION					
HANFORD ATOMIC PRODUCTS OPERATION					
GENERAL ELECTRIC					
'C' PLANT					
LIQUID WASTE DISPOSAL SITES					
216-C SERIES					
SHEET NO. 216-C					
OF 216-C					
PROJECT NO. SK-2-18149					

HW-55176 PL/D
APPENDIX E

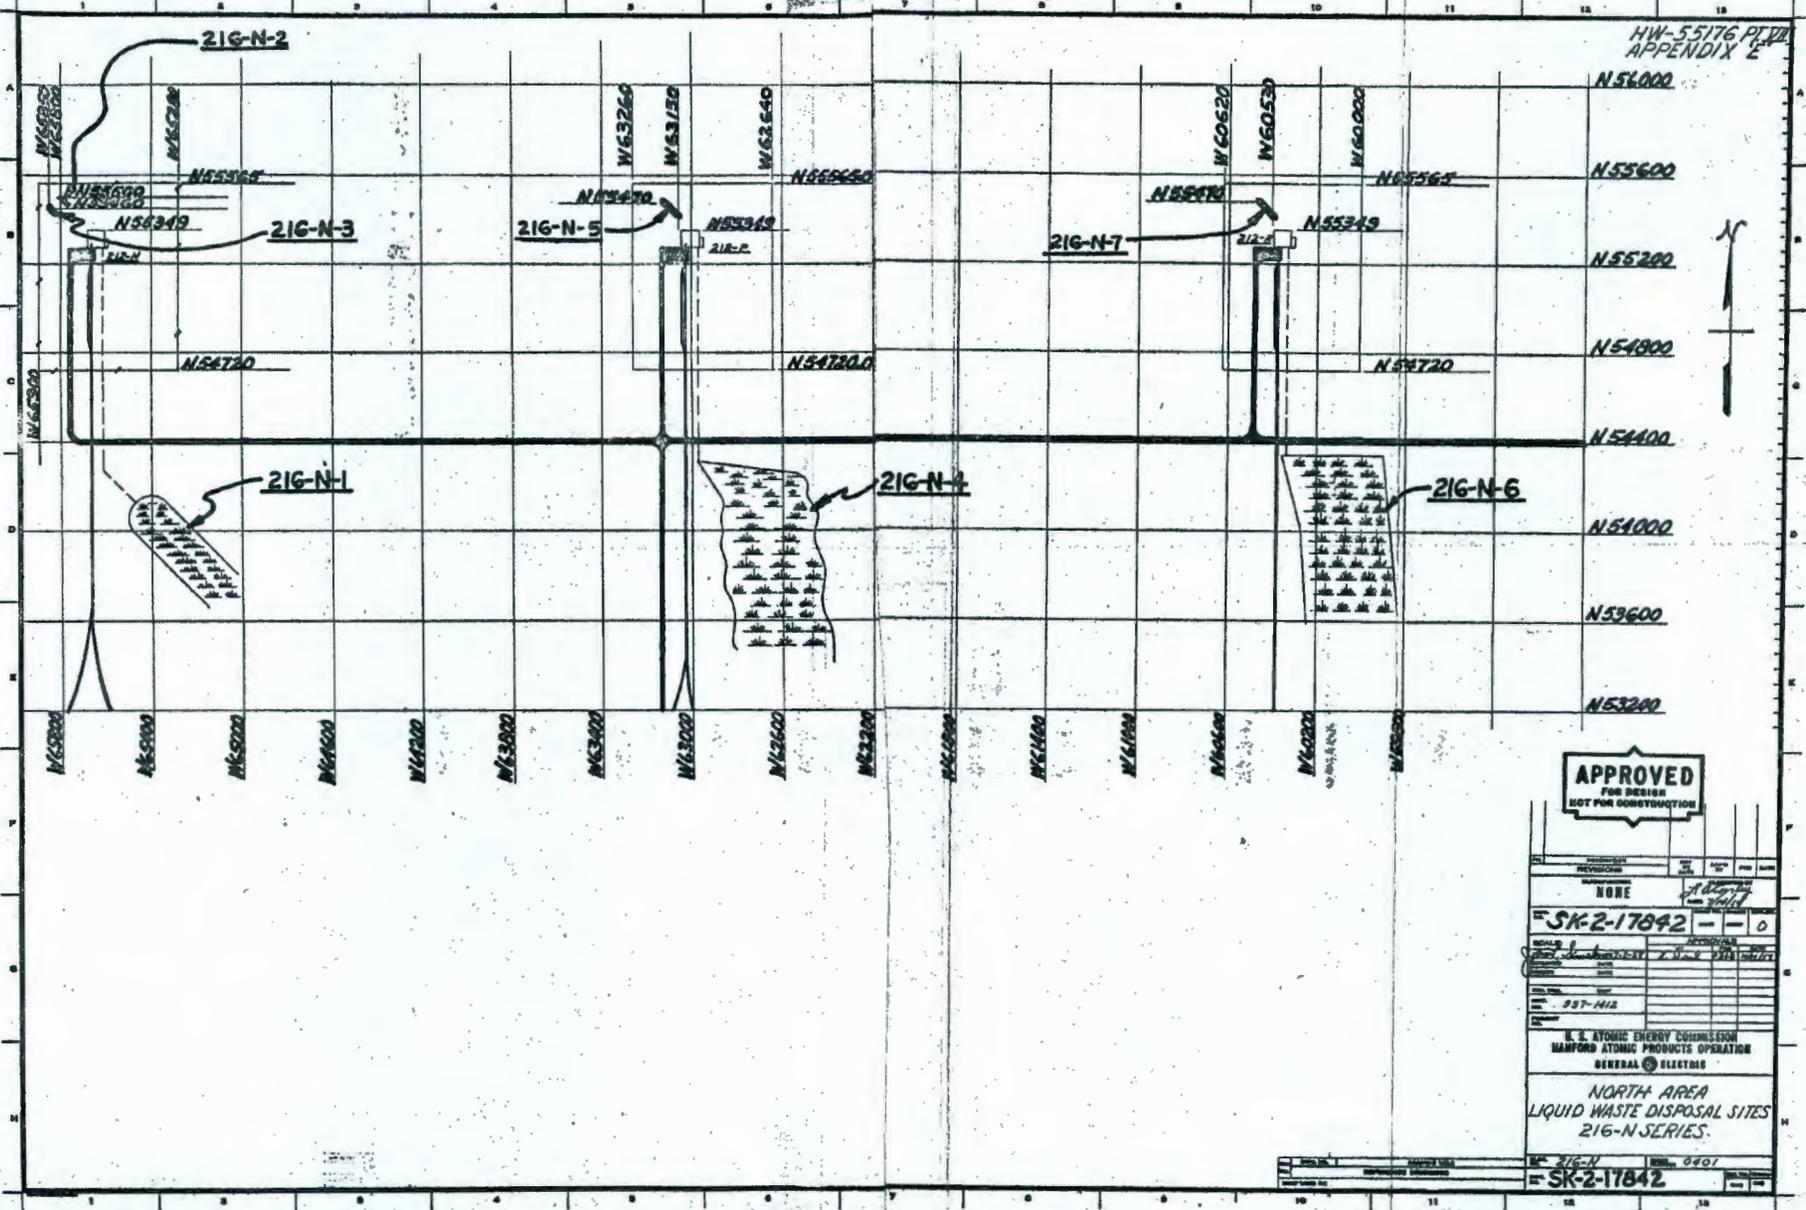

APPROVED
FOR DESIGN
NOT FOR CONSTRUCTION

DATE	BY	CHK'D	APP'D
REVISIONS			
NONE			
JOB NO. SK-2-17842 - - 0			
DRAWN BY: J. J. [Signature]			
CHECKED BY: [Signature]			
SCALE: 30'-1" = 1"			
SHEET NO. 0401			
U. S. ATOMIC ENERGY COMMISSION SANDHURST ATOMIC PRODUCTS OPERATION GENERAL ELECTRIC			
NORTH AREA LIQUID WASTE DISPOSAL SITES 21G-N-SERIES			
JOB NO. SK-2-17842		SHEET NO. 0401	

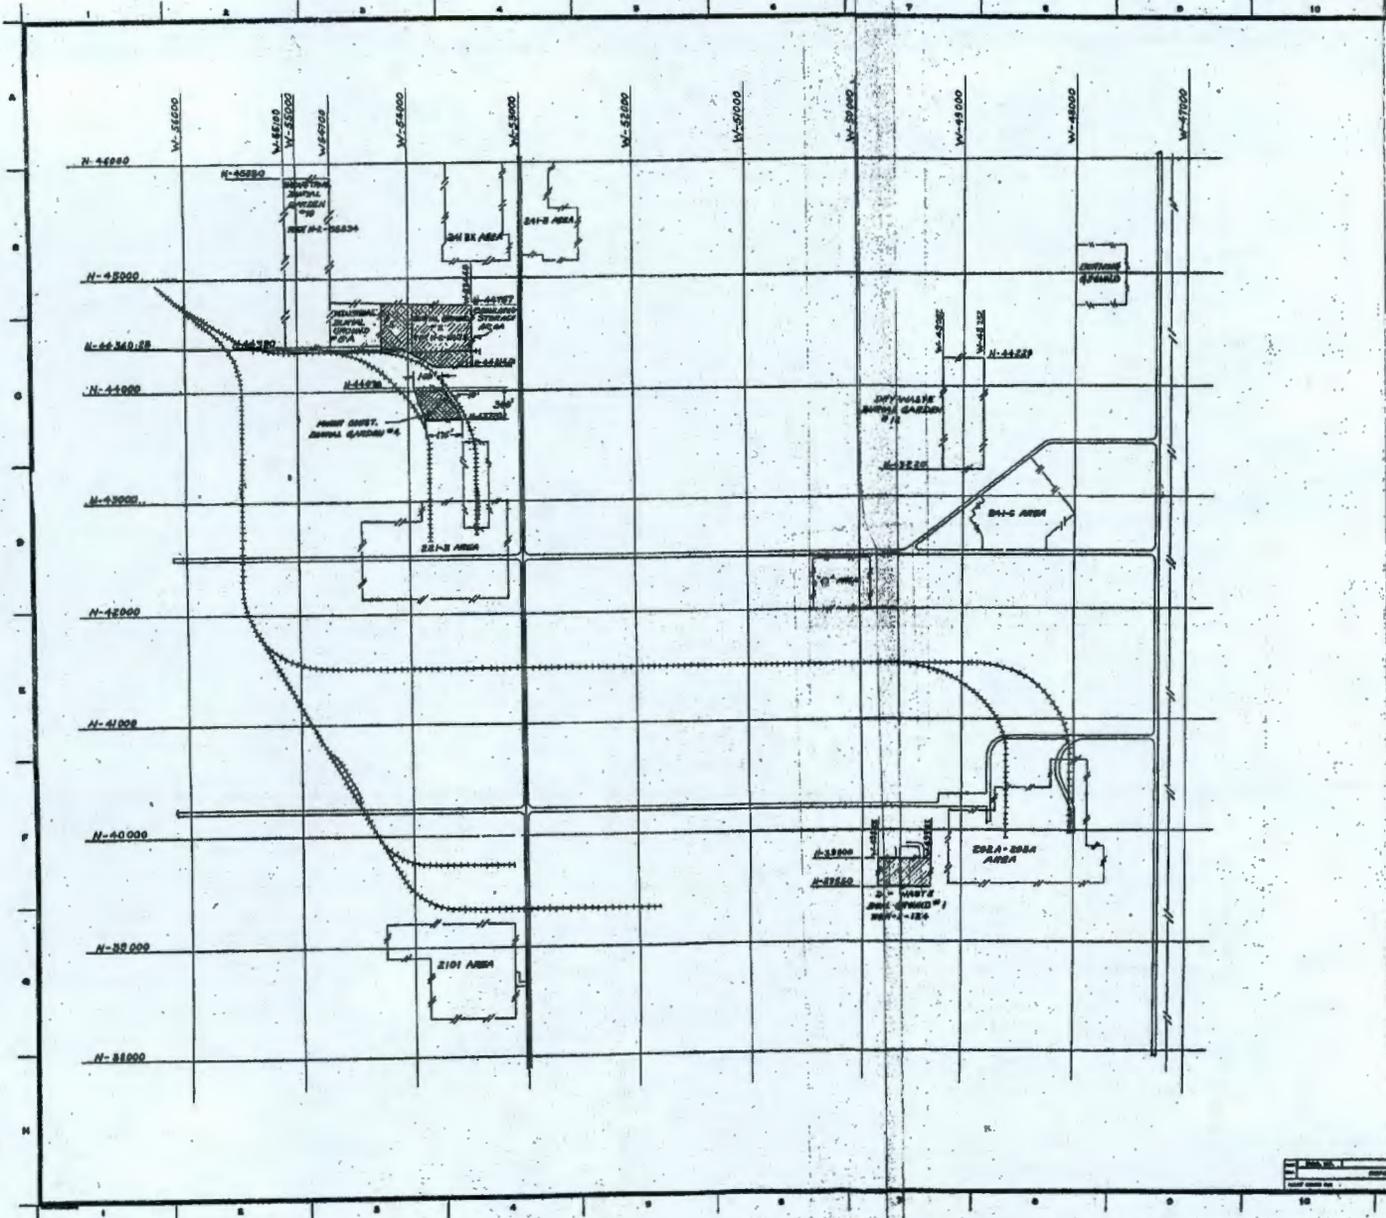

LEGEND:
DEPLETED SITES.

APPROVED

NO.	DATE	BY	FOR
1	12-1-57	W. J.
CLASSIFICATION			
NONE			
PROJECT NO. H-2-31269			
SCALE: NONE			
DRAWN BY: ...			
CHECKED BY: ...			
DATE: 12-1-57			
NO. 1392			
U. S. ATOMIC ENERGY COMMISSION MARFORD ATOMIC PRODUCTS OPERATION GENERAL ELECTRIC			
WASTE BURIAL GARDENS			
SHEET NO. 1		SHEET 0401	
PROJECT NO. H-2-31269		SHEET NO. 0401	

15

16

