0028033

CORPS OF ENGINEERS

U. S. ARMY

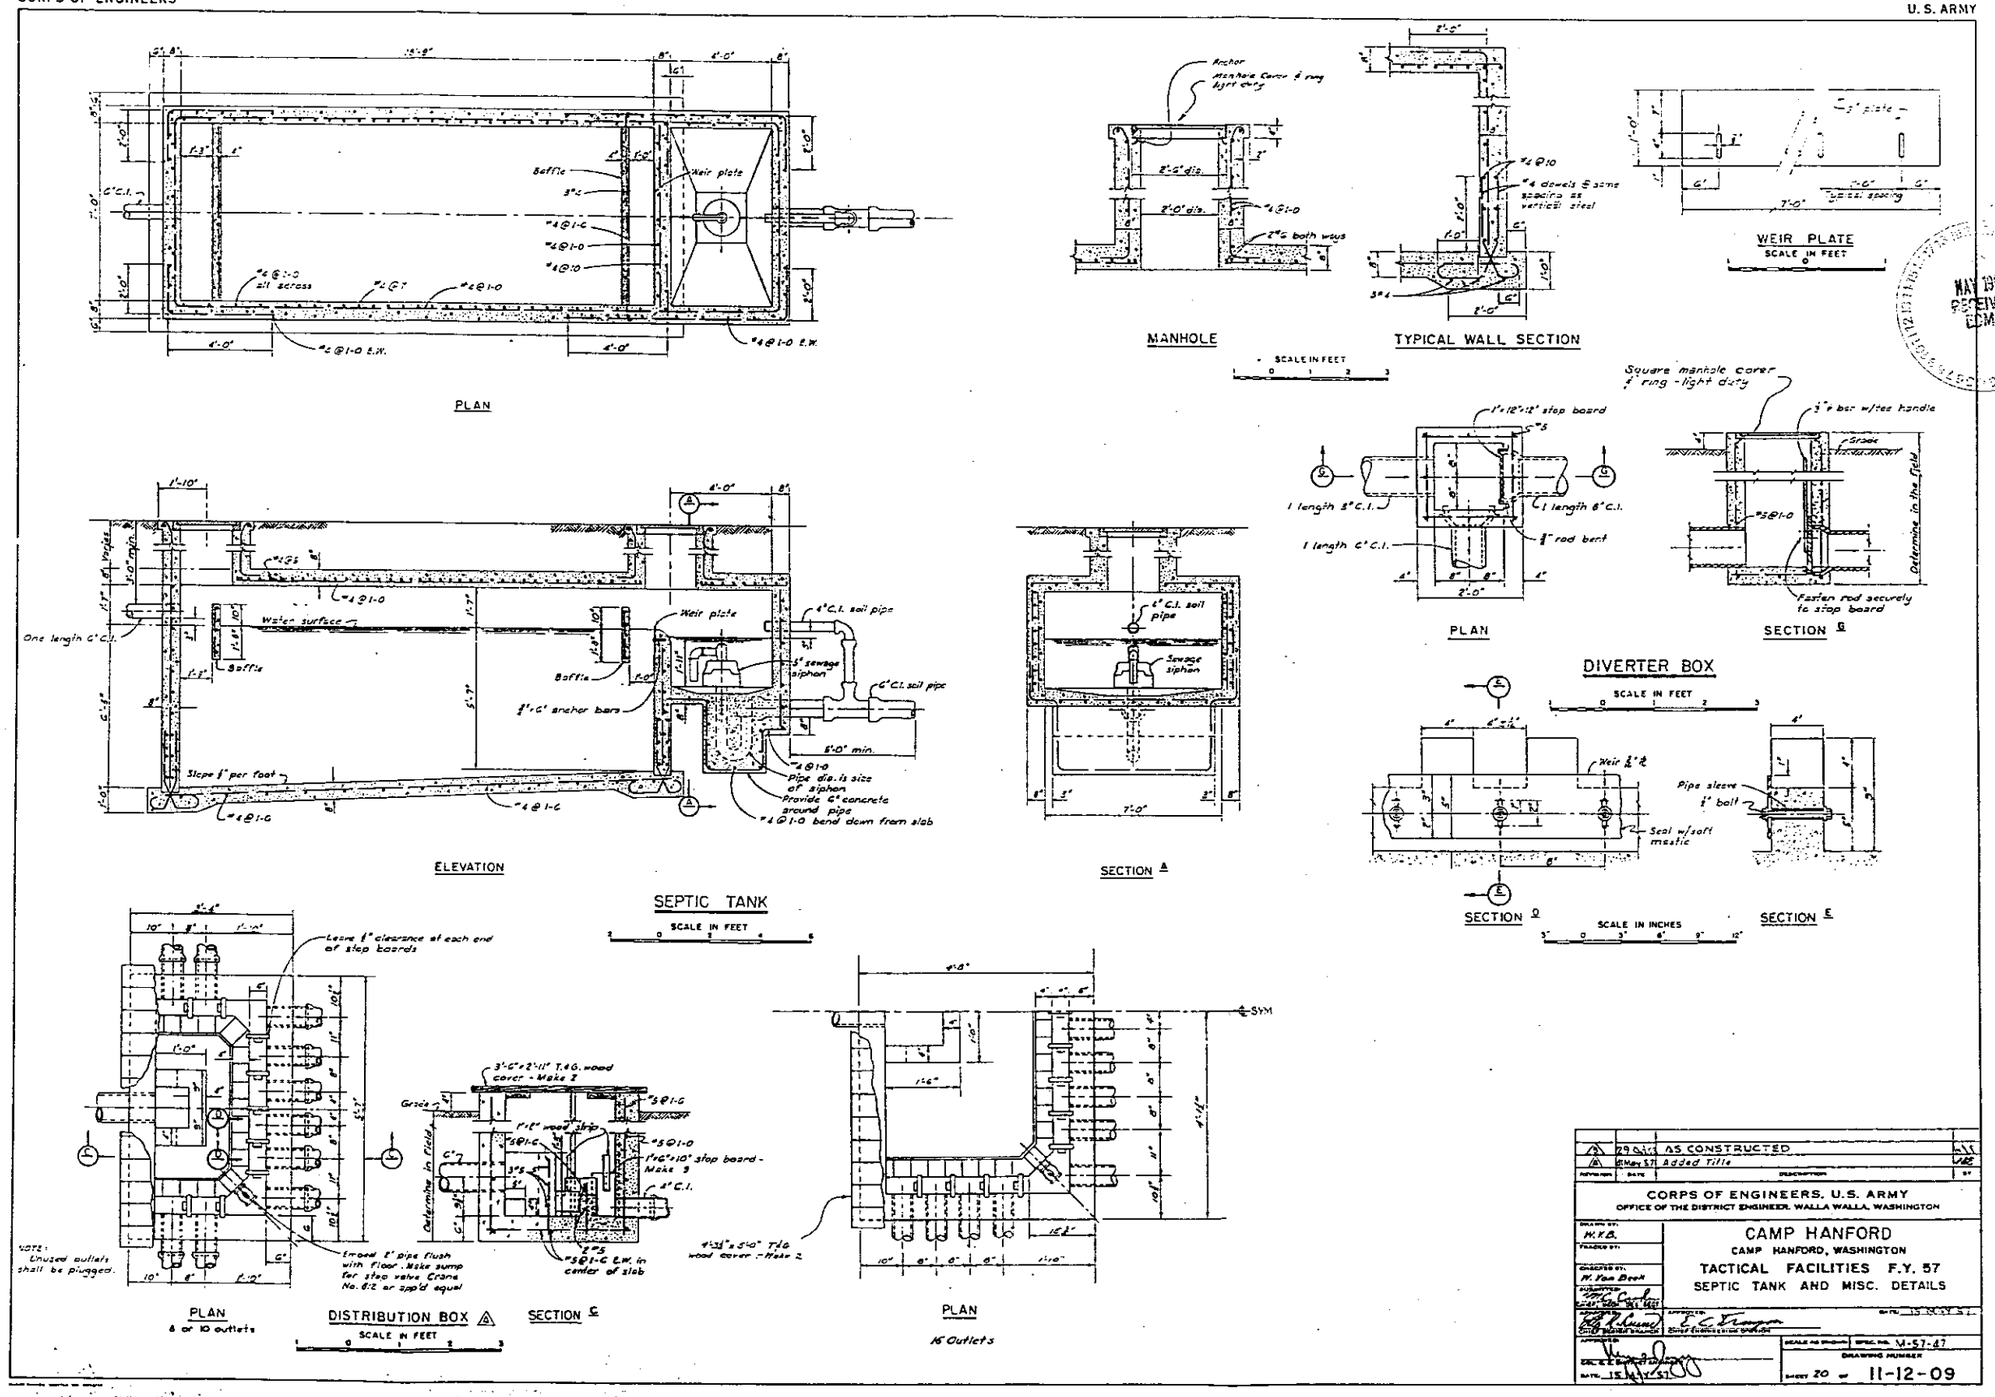

REVISION	DATE	DESCRIPTION	BY
3	29 Oct 57	AS CONSTRUCTED	
2	8 May 57	Added Title	

CORPS OF ENGINEERS, U.S. ARMY
OFFICE OF THE DISTRICT ENGINEER, WALLA WALLA, WASHINGTON

DRAWN BY: W.K.B.
TRACED BY:
CHECKED BY: W. Van Beek
SUBMITTED:
APPROVED:
APPROVED:
APPROVED:
DATE: 15 MAY 57

CAMP HANFORD
CAMP HANFORD, WASHINGTON
TACTICAL FACILITIES F.Y. 57
SEPTIC TANK AND MISC. DETAILS

SCALE AS SHOWN
SPEC. NO. M-57-47
DRAWING NUMBER
SHEET 20 OF 11-12-09