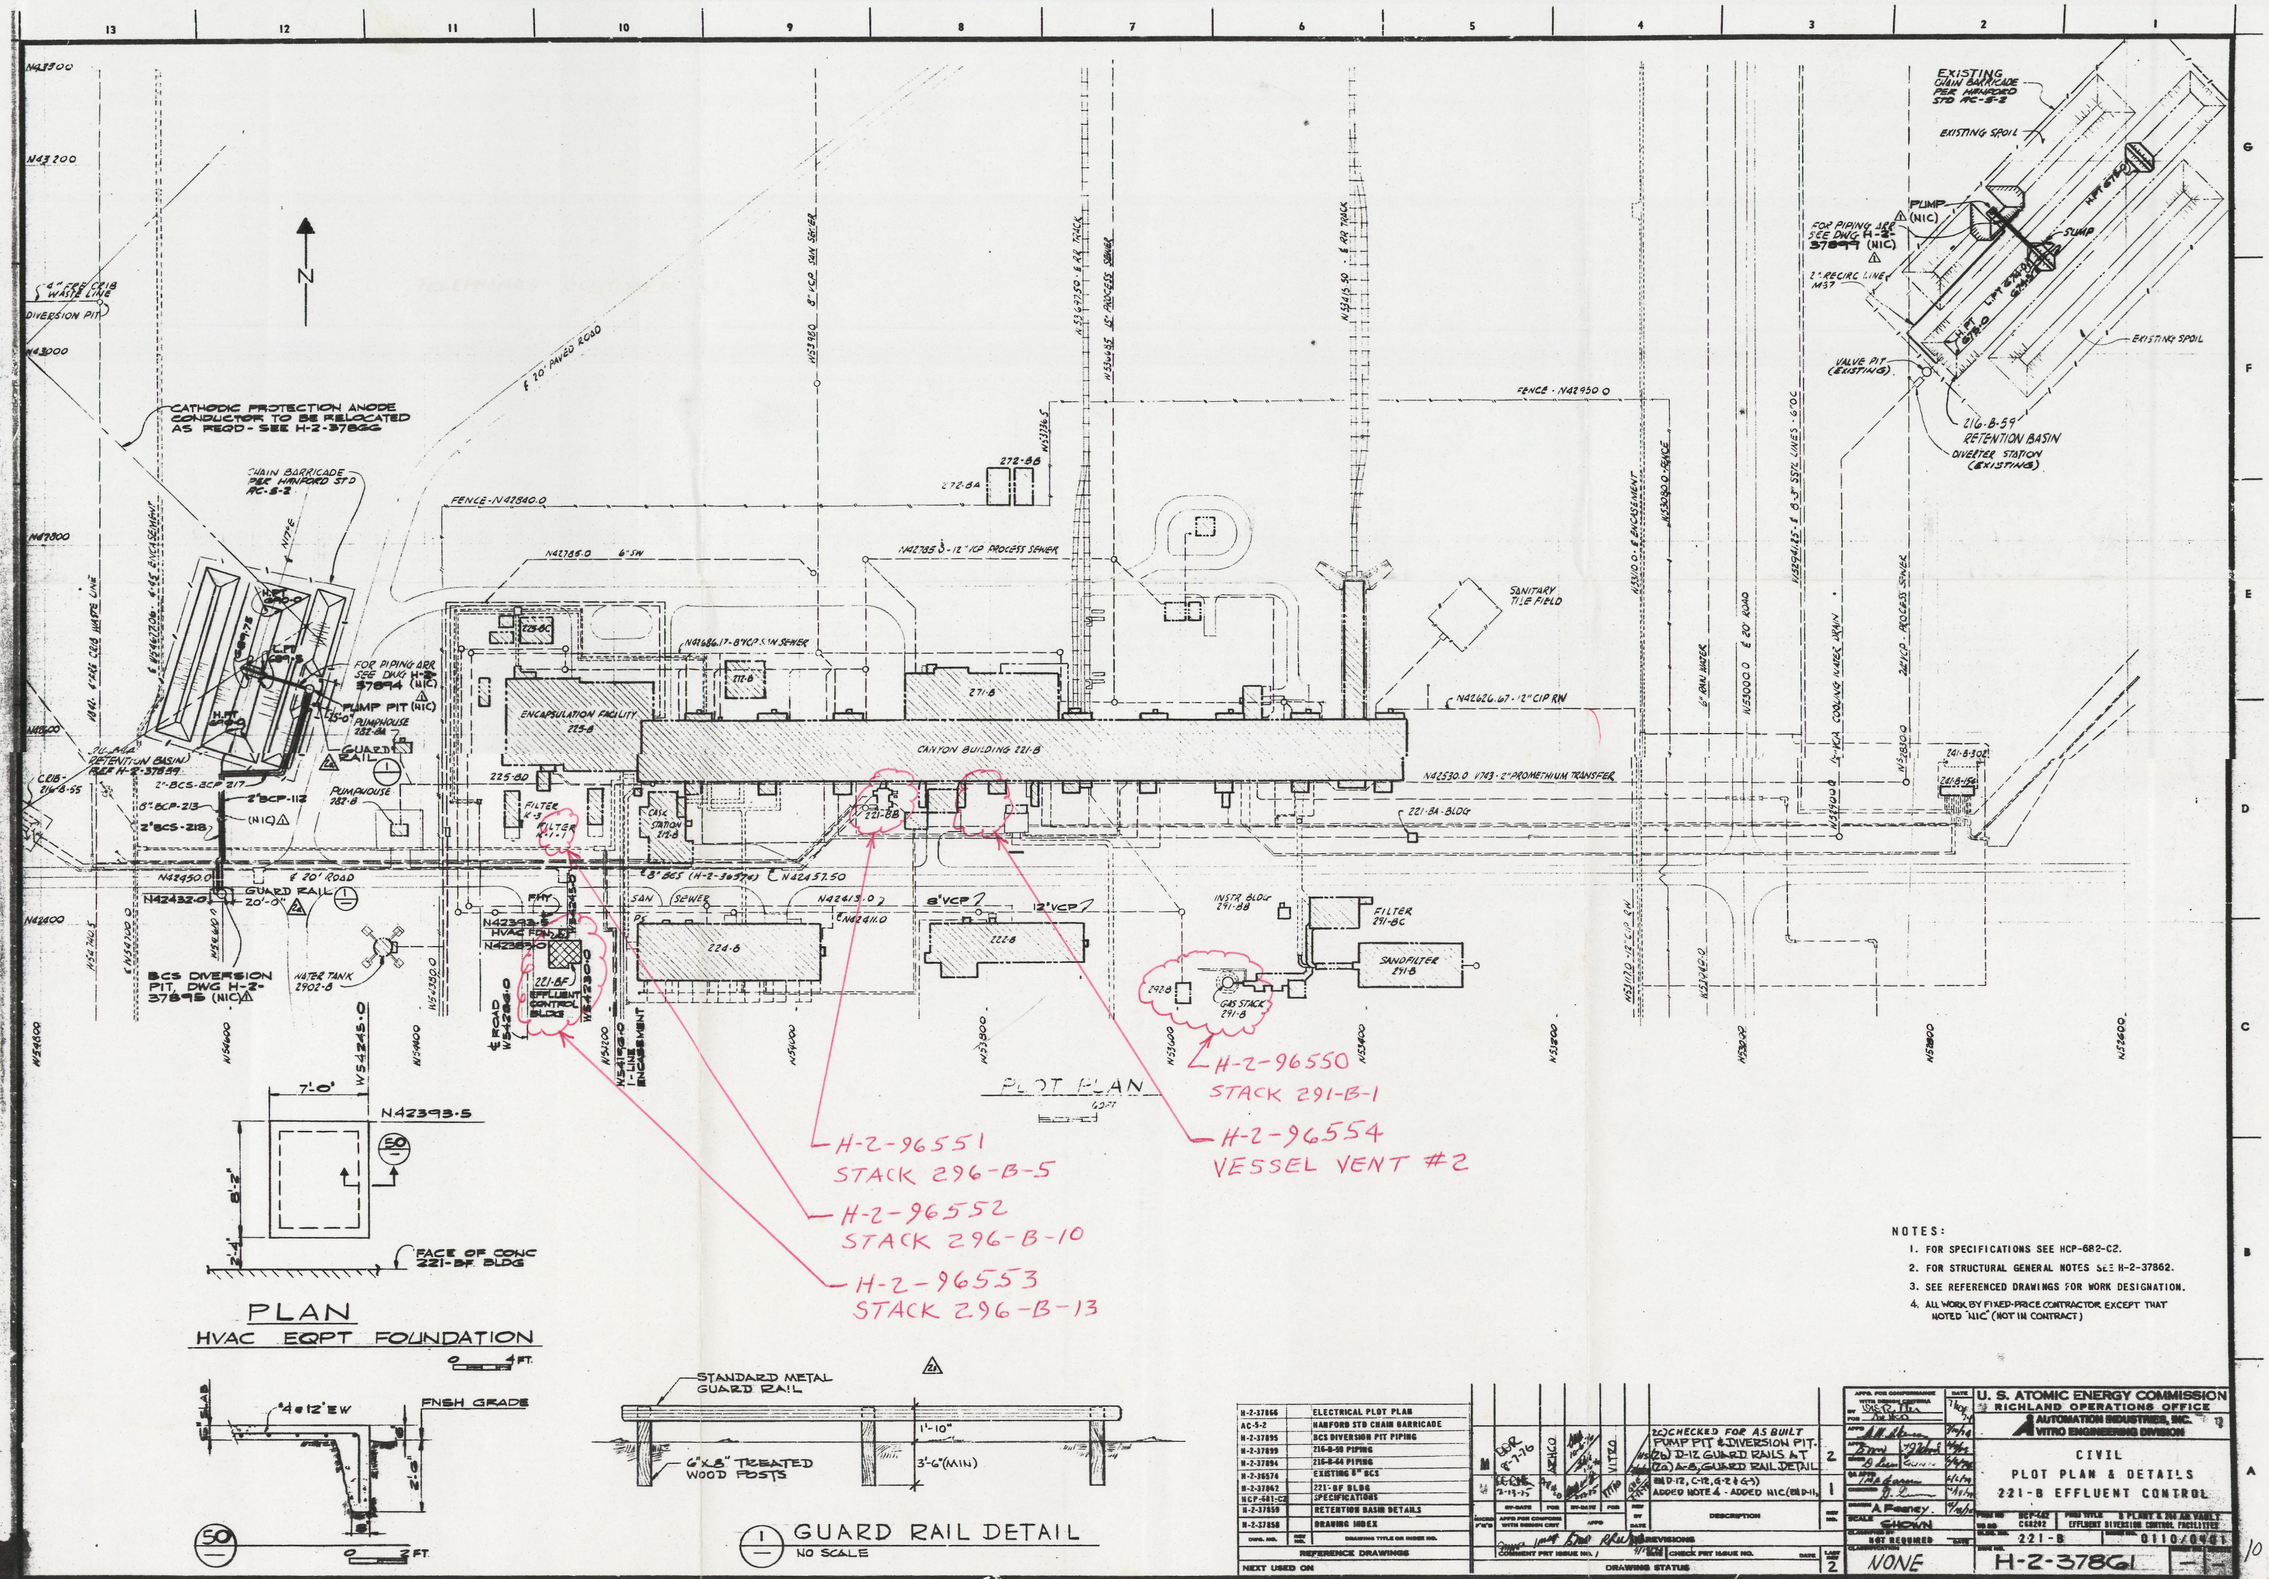
CATHODIC PROTECTION ANODE CONDUCTOR TO BE RELOCATED AS REQ'D - SEE H-2-37822
CHAIN BARRICADE PER HANFORD STD AC-5-2
4" FIRE CRIB WASTE LINE
DIVERSION PIT
FENCE - N42840.0
N42785.0 6"SW
N42785.0 8-12" ICP PROCESS SEWER
N42686.17-8"VCP S.W. SEWER
ENCAPSULATION FACILITY 213-B
CANYON BUILDING 221-B
SANITARY TILE FIELD
N42626.67-12" CIP RW
N42530.0 W743-2" PROMETHIUM TRANSFER
221-B-BLDG
FOR PIPING ARR SEE DWG H-2-37844 (NIC)
PUMP PIT (NIC)
15'-0" PUMPHOUSE 282-BA
PUMPHOUSE 282-B
GUARD RAIL
2"BCP-112 (NIC)
2"BCS-218
6"BCP-213
2"BCS-217
CRIB 216-B-55
FILTER
CANYON 272-B
225-BD
8"BCS (H-2-36976) N42457.50
N42450.0
N42432.0
20'-0"
6" ROAD
N42413.0
N42411.0
8"VCP
12"VCP
224-B
222-B
INSTR. BLDG 291-BB
FILTER 291-BC
SANDFILTER 291-B
GAS STACK 291-B
N42393.5 HVAC EQPT FDN
221-BF EFFLUENT CONTROL BLDG
BCS DIVERSION PIT, DWG H-2-37895 (NIC)
WATER TANK 2902-B
N42800
N42600
N42400
N42200
N42000
W53980 8"VCP SAN SEWER
W53745 8"VCP PROCESS SEWER

START

0031005

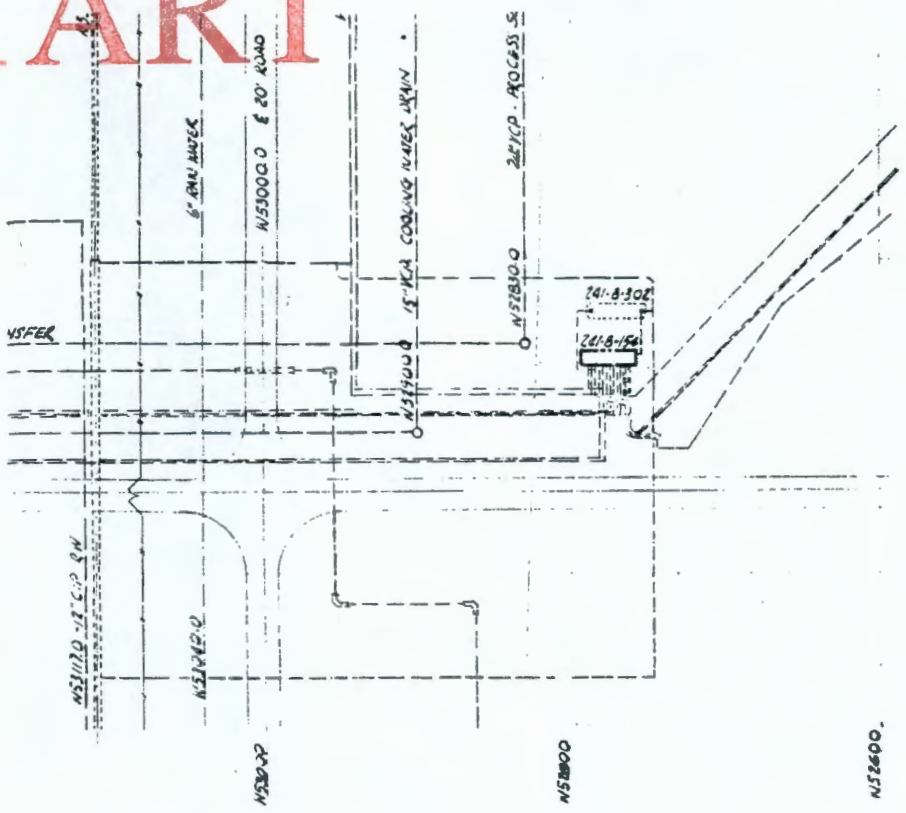

NOTES:

1. FOR SPECIFICATIONS SEE HCP-682-C2.
2. FOR STRUCTURAL GENERAL NOTES SEE H-2-37862.
3. SEE REFERENCED DRAWINGS FOR WORK DESIGNATION.
4. ALL WORK BY FIXED-PRICE CONTRACTOR EXCEPT THAT NOTED "NIC" (NOT IN CONTRACT)

DESCRIPTION	REVISIONS
2(c) CHECKED FOR AS BUILT PUMP PIT & DIVERSION PIT. 2(b) D-12 GUARD RAILS AT 2(a) A-8, GUARD RAIL DETAIL	2
ADDED NOTE 4 - ADDED NIC(BID-11, B-D-12, C-12, G-2 & G-3)	1

DRAWING STATUS: CHECK PRT ISSUE NO. — SHEET 2

APPD FOR CONSTRUCTION	1 Nov 74
DRAWN	11/1/74
CHECKED	11/1/74
APPD	11/1/74
DESIGNED	11/1/74
SCALE	SHOWN
ENGINEERING	NOT REQUIRED
CONSTRUCTION	NONE

U. S. ATOMIC ENERGY COMMISSION
RICHLAND OPERATIONS OFFICE
AUTOMATION INDUSTRIES, INC.
VITRO ENGINEERING DIVISION

CIVIL
PLOT PLAN & DETAILS
221-B EFFLUENT CONTROL

DRAWING NO.	CS8292	PROJECT	200 E PLANT & 200 AR VAULT EFFLUENT DIVERSION CONTROL FACILITIES
BLDG. NO.	221-B	SPECIFICATION	0110-0-0-1
ISSUE NO.	H-2-37861		

RECEIVED
SEP 1983
EDMC

9413096.0562