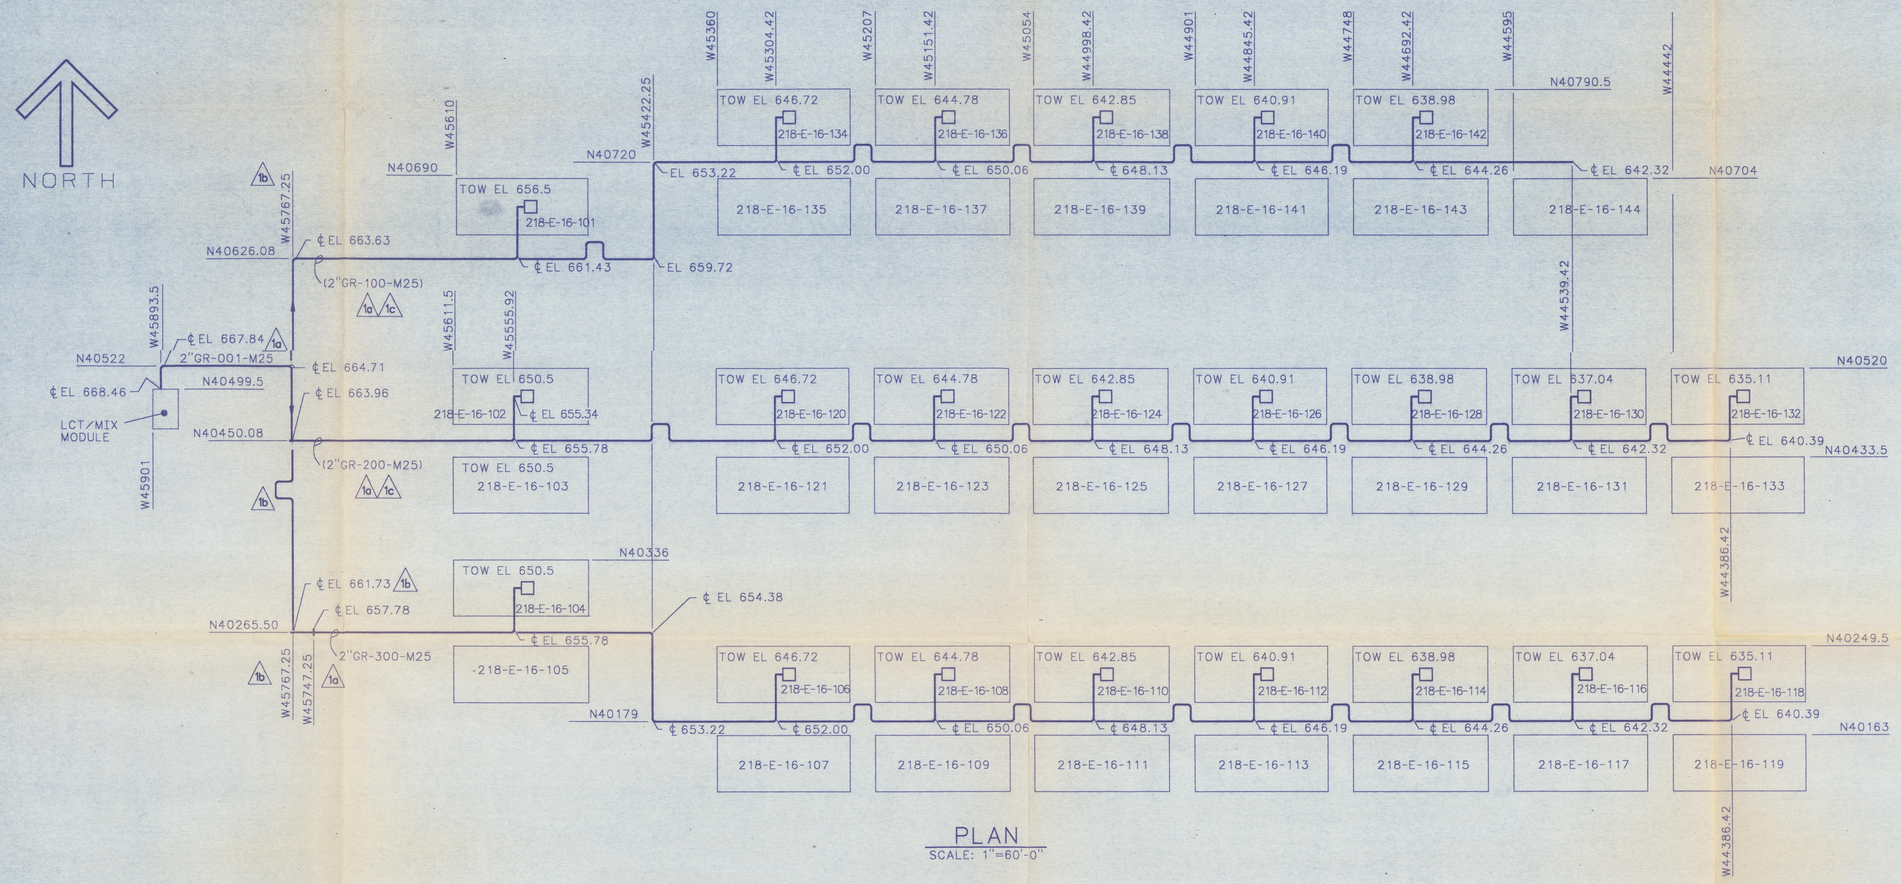

PLAN

SCALE: 1"=60'-0"

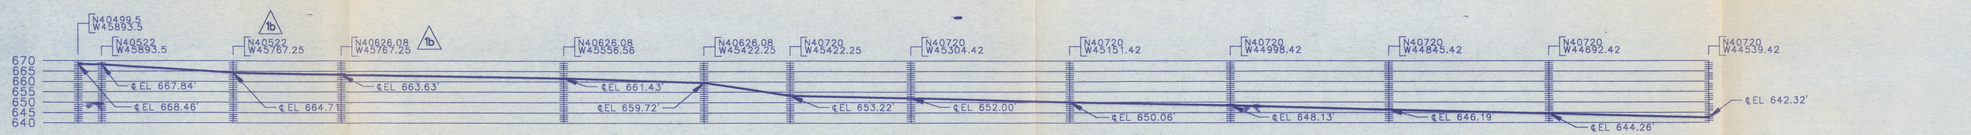

GROUT LINE 2"GR-100-M25 1a 1c

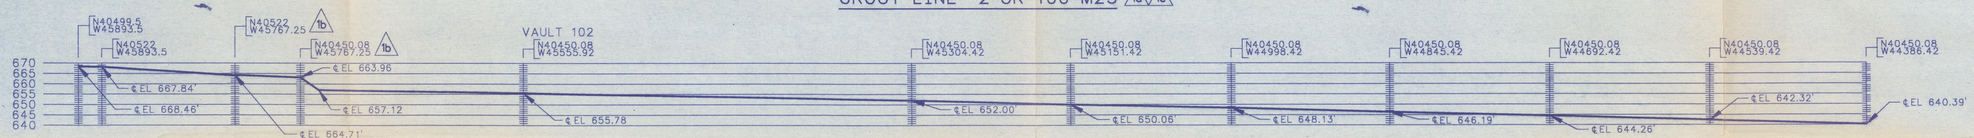

GROUT LINE 2"GR-200-M25 1a 1c

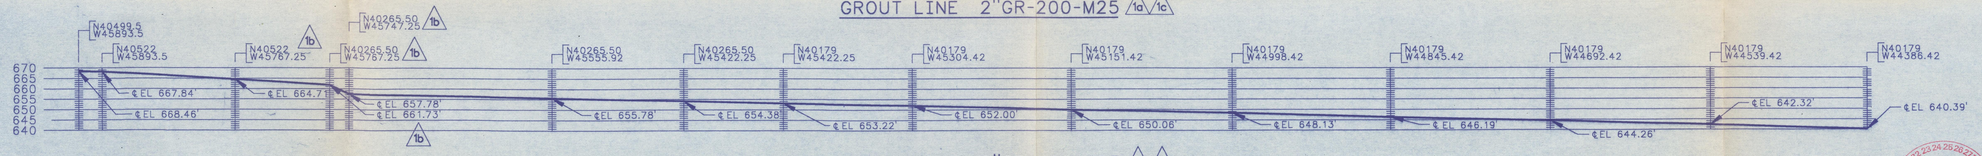

GROUT LINE 2"GR-300-M25 1a 1c

1c GROUT LINE PROFILES

SCALE: HORIZ 1"=60'
VERT 1"=30'

NOTES:

1. TOW = TOP OF WALL
2. VAULT 101 WAS INSTALLED ON PROJECT B-566.
3. VAULTS 102 & 103 ARE TO BE INSTALLED ON PROJECT B-714.

DOES NOT CONTAIN CLASSIFIED OR UNCLASSIFIED CONTROLLED NUCLEAR INFORMATION
Reviewing Official/ADC
Kaiser Engineers Hanford Company
11-28-90
Date

IMPACT LEVEL 2 EDT #101089

WHC APPROVAL BY SR BRIGGS	DATE 12-28-88	U.S. DEPARTMENT OF ENERGY RICHLAND OPERATIONS OFFICE
		KAISER ENGINEERS HANFORD COMPANY
PROJ ENGR JD CLOUD	12-28-1988	M PIPING HYDRAULIC DIAG
QA HWH 1-10-89 J.E. BREED	7-26-88	
APPROVED BY ROBERT M. ITEN	7-25-88	
SAFETY A.G. MINISTER	7-22-88	
APPROVED CRZ 1-8-89 BY CRZ F. PORTER	7-22-88	PROJECT TITLE GROUT VAULT PAIR 218-E-16-102 & 103
CHECKED BY L. HALL	7-22-88	PROJ B-714 WO ER1060 JOB 242500
DRAWN RH BANKEMPER BY SA GREGG	6-21-1988	SCALE SHOWN BLDG 218-E-16 INDEX 0401
DESIGNED BY RH BANKEMPER	6-21-1988	DRAWING NUMBER H-2-77615 SHEET 1 OF 1 REV 1

MICROFILMED	BY-DATE	REV BY DATE	DESCRIPTION	REV
M		TKE 7-11-90	c) B-714-55; ZE7, B-C5 b) B-714-22; ZF7, E7, D7, G7, B7 a) B-714-14; ZE7, D7, C5, B5 THRU B-714-61 GENL REV: INCORP. ALL ECNs	RS 1
WHC APPROVAL	KEH APPROVAL		REVISIONS	
COMMENT REVIEW				

NUMBER	TITLE
DRAWING TRACEABILITY LIST	

H-2-77573 DRAWING LIST	
NUMBER	TITLE
REFERENCES	
NEXT USED ON	

KEHCAD H277615B1 C 11/20/90

0012499