MAY 1993 RECEIVED CDMC

CORPS OF ENGINEERS

U. S. ARMY

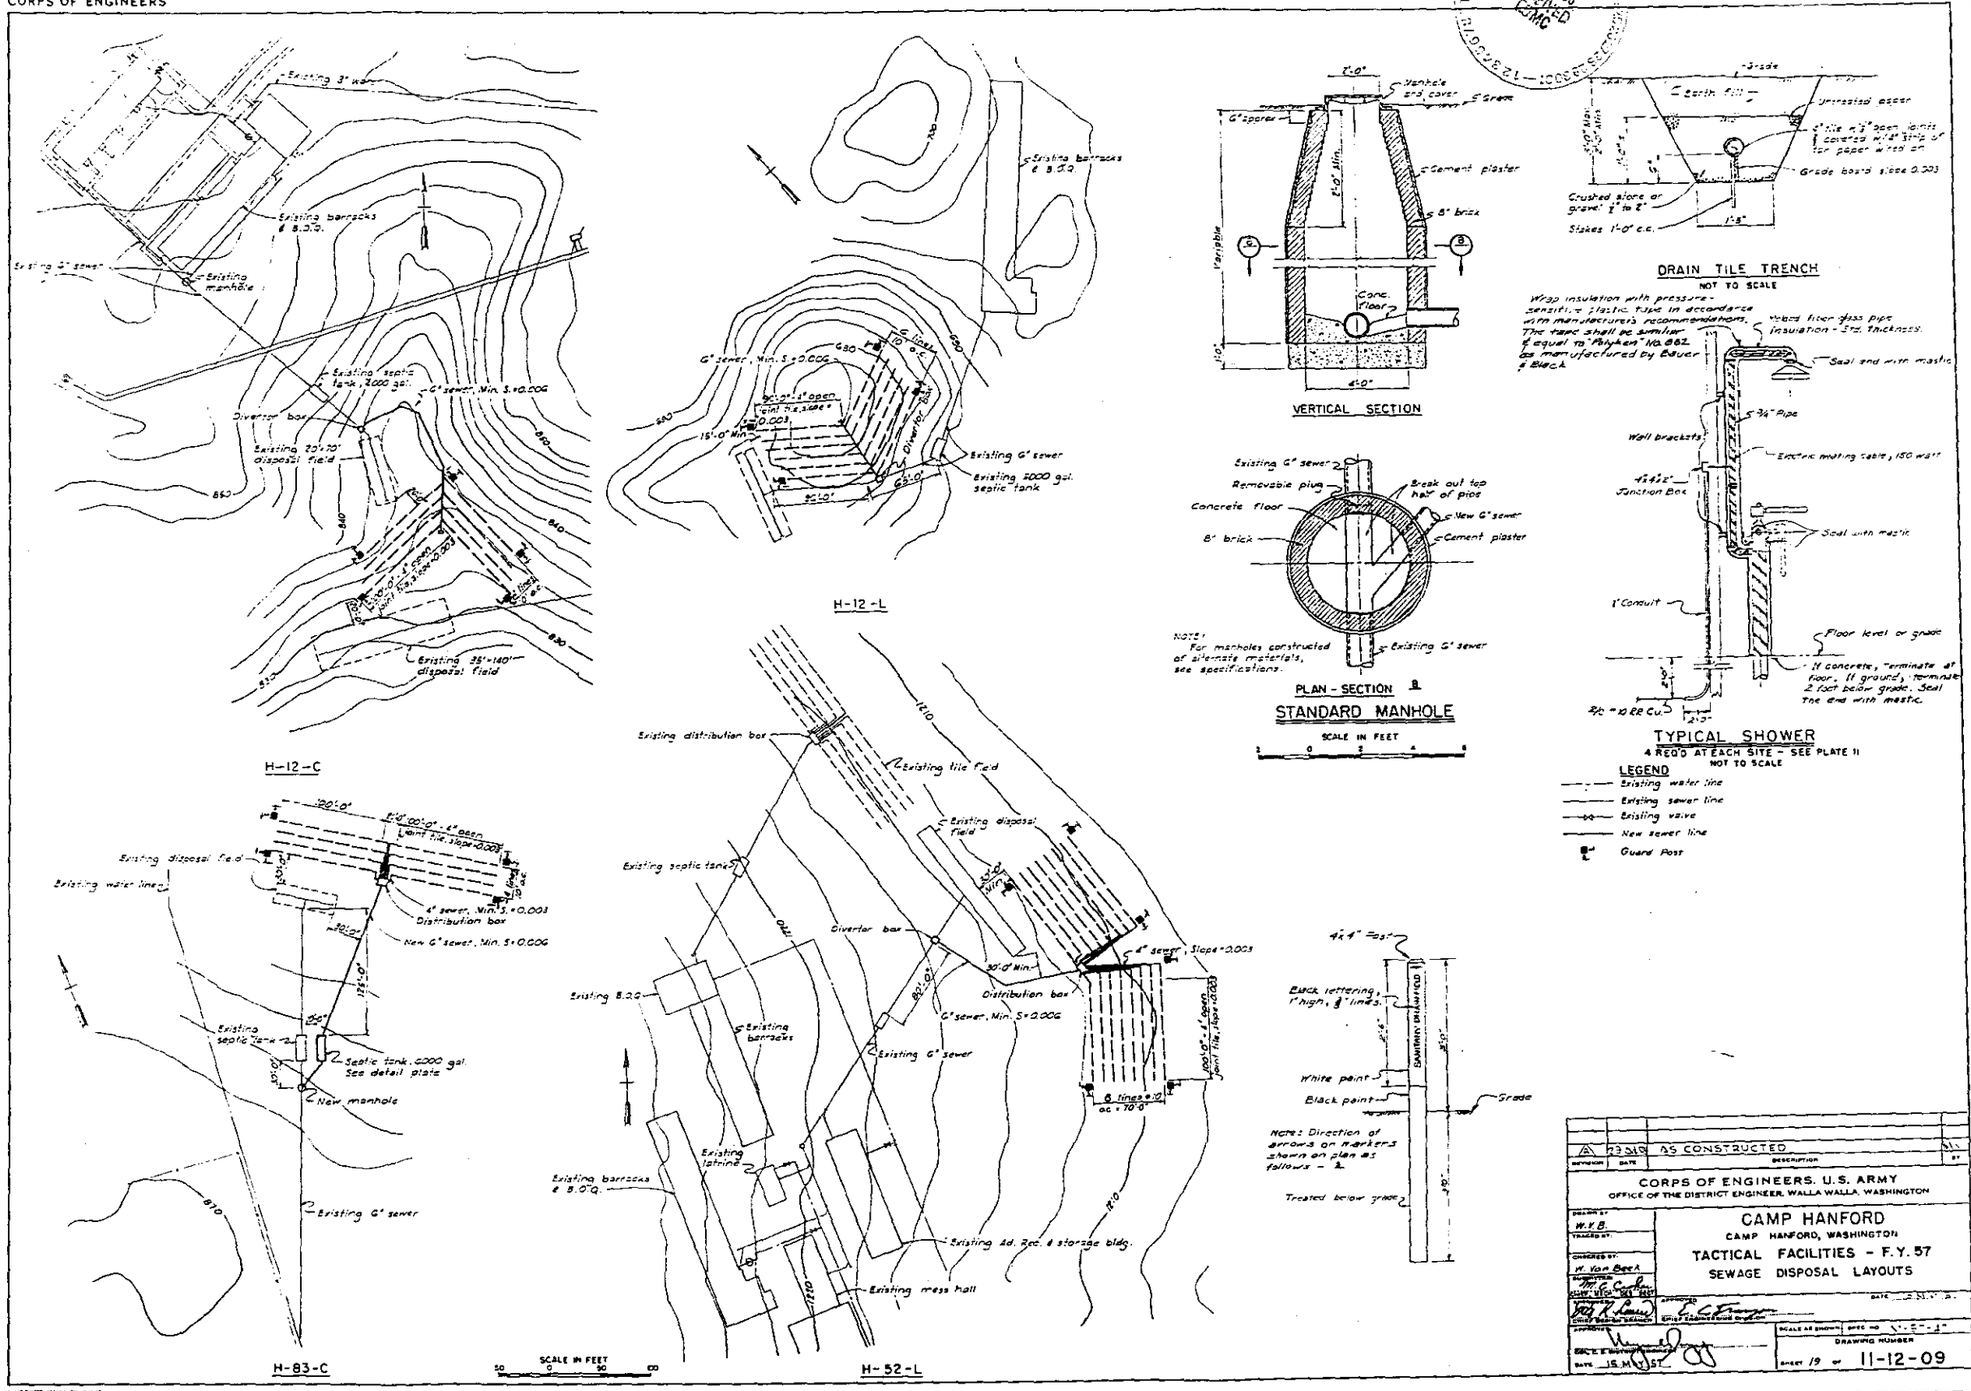

REVISION	DATE	DESCRIPTION	BY
A	23 Jul 93	AS CONSTRUCTED	

CORPS OF ENGINEERS, U.S. ARMY
OFFICE OF THE DISTRICT ENGINEER, WALLA WALLA, WASHINGTON

DRAWN BY: W.V.B.
TRACED BY:
CHECKED BY: W. Van Beek
SUBMITTED: M. C. Cooke
CHIEF, DESIGN BRANCH
APPROVED: E. C. Frangen
CHIEF, ENGINEERING DIVISION
APPROVED:
COL. C. E. DISTRICT ENGINEER
DATE 15 MAY 57

CAMP HANFORD

CAMP HANFORD, WASHINGTON

TACTICAL FACILITIES - F.Y. 57

SEWAGE DISPOSAL LAYOUTS

SCALE AS SHOWN
SPEC NO
DRAWING NUMBER
SHEET 19 OF 11-12-09