0028030

CORPS OF ENGINEERS

U. S. ARMY

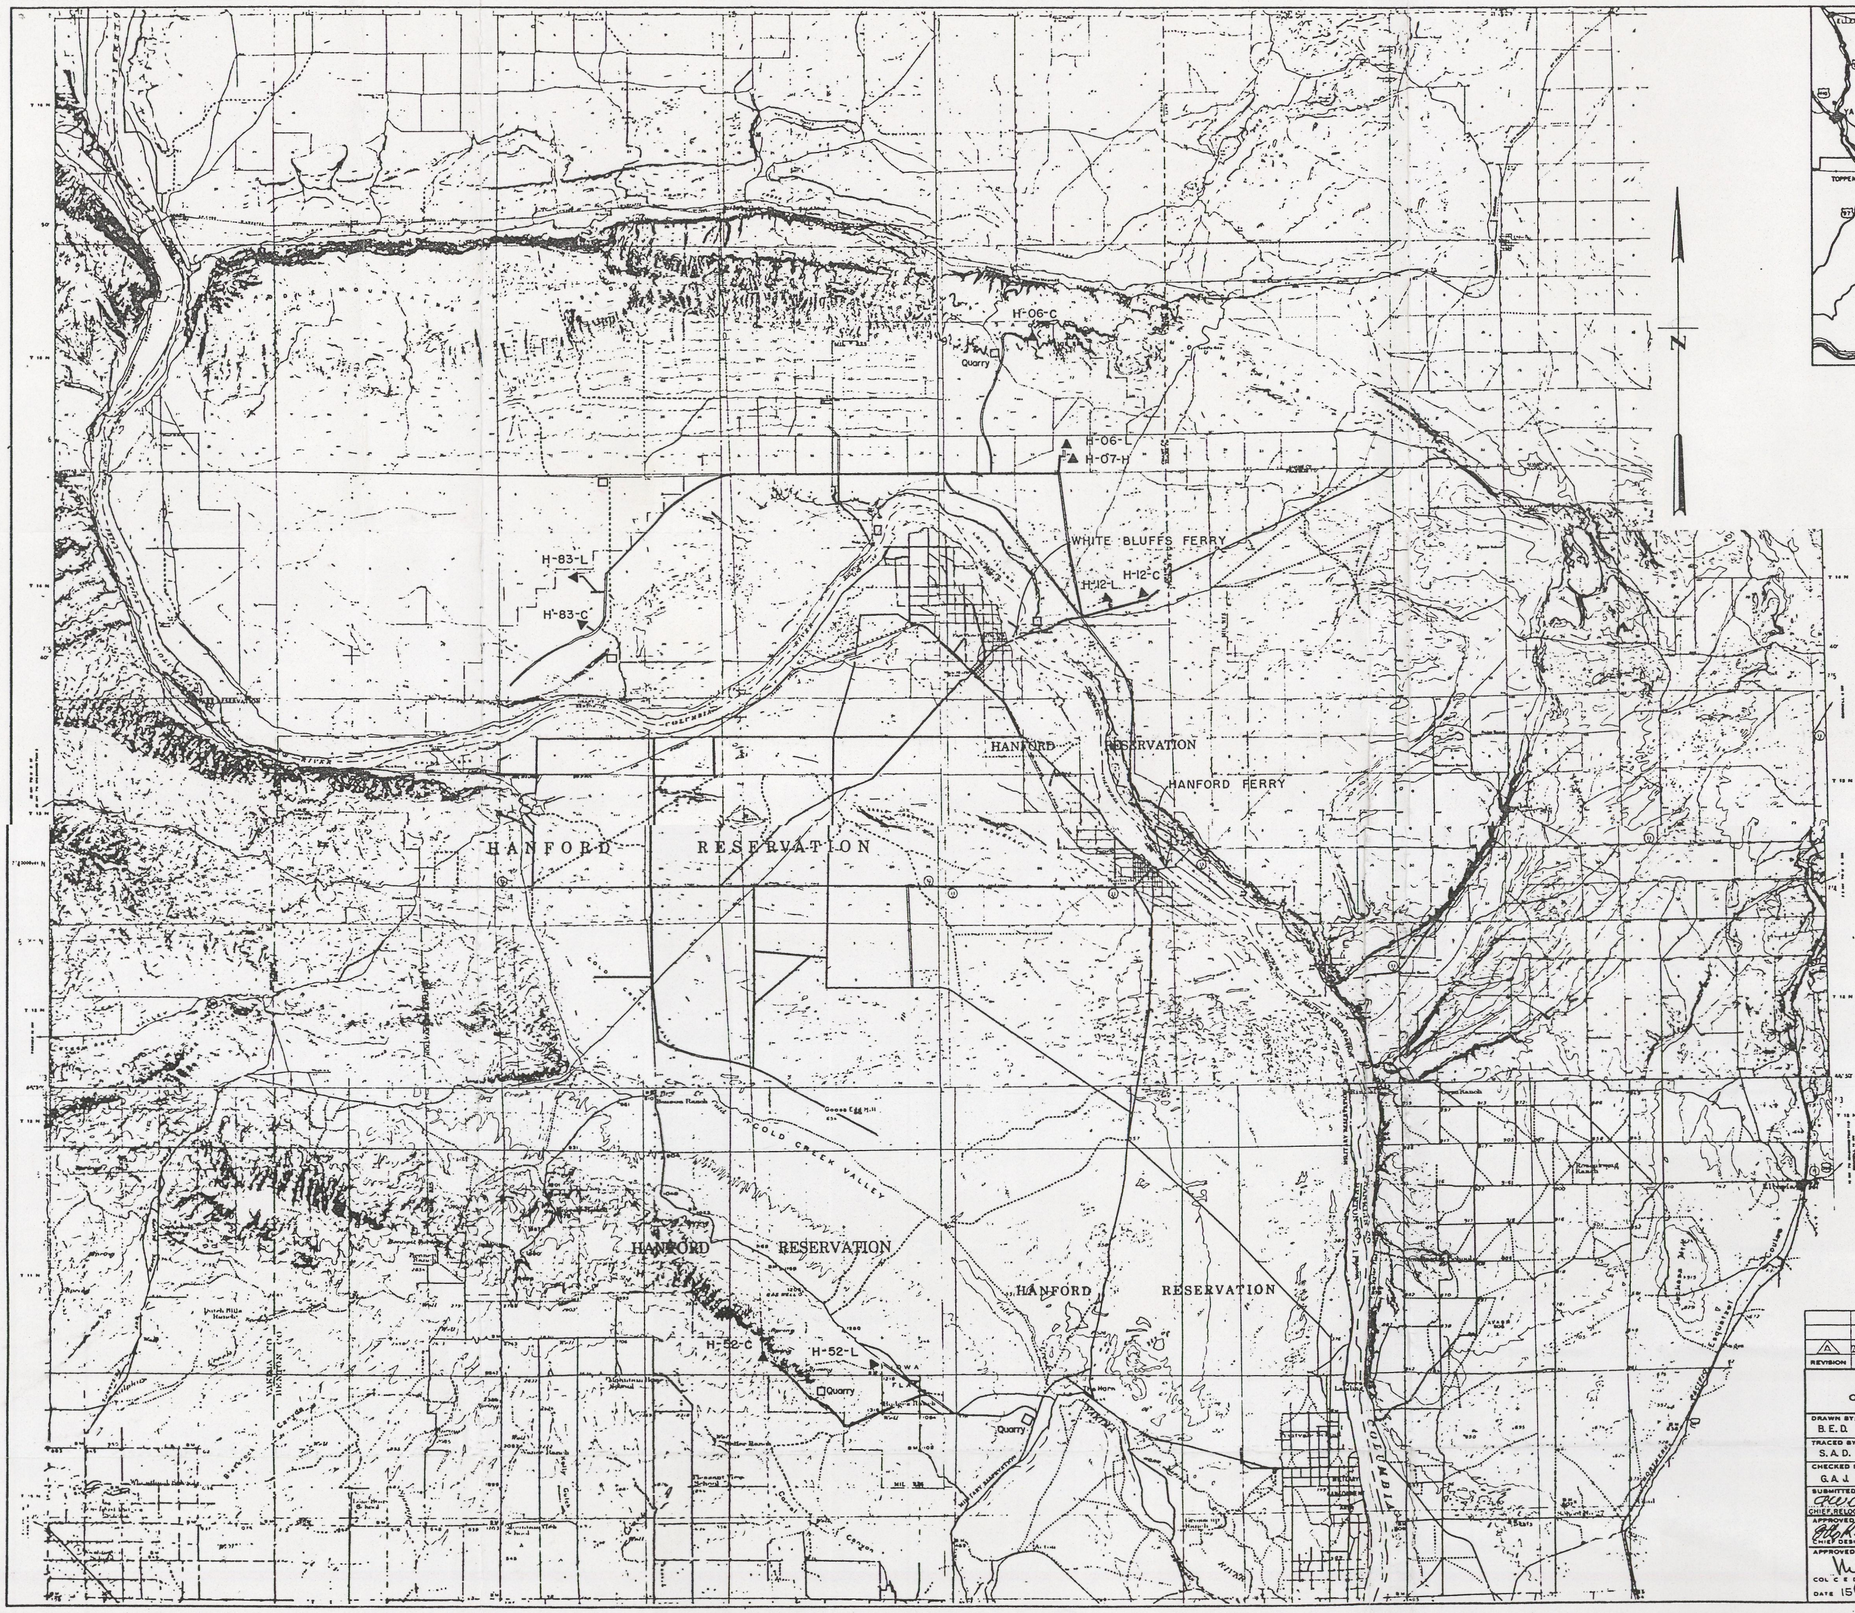

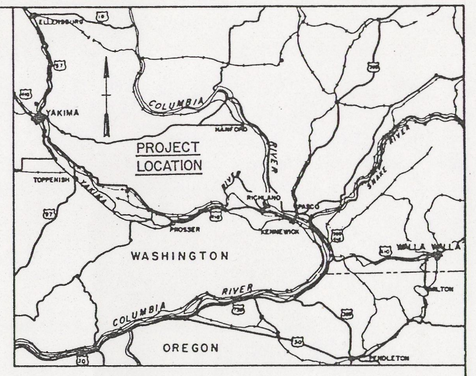

VICINITY MAP

SCALE IN MILES

10 0 10 20 30 40

MAY 1993
RECEIVED
EDMC

INDEX

DWG. NO.	SHEET	TITLE
11 - 12 - 09	1	Site Plan and Vicinity Map
11 - 12 - 09	2	Paving Plan H - 06 - C
11 - 12 - 09	3	Paving Plan H - 06 - L
11 - 12 - 09	4	Paving Plan H - 07 - H
11 - 12 - 09	5	Paving Plan H - 12 - C
11 - 12 - 09	6	Paving Plan H - 12 - L
11 - 12 - 09	7	Paving Plan H - 52 - C
11 - 12 - 09	8	Paving Plan H - 52 - L
11 - 12 - 09	9	Paving Plan H - 83 - C
11 - 12 - 09	10	Paving Plan H - 83 - L
11 - 12 - 09	11	Grading Plan
11 - 12 - 09	12	Grading Plan
11 - 12 - 09	13	Access Road H-06-C - Paving Plan and Typical Sections
11 - 12 - 09	14	H-06-C Culvert Protection - Plan & Details
11 - 12 - 09	15	Access Road H-12-C & H-12-L - Paving Plan
11 - 12 - 09	16	Access Road H-06-L, H-52-C, H-52-L & H-83-C - Paving Plan
11 - 12 - 09	17	Access Road H-52-L - Paving Plan
11 - 12 - 09	18	Typical Paving Plan - Launcher Sites
11 - 12 - 09	19	Sewage Disposal Layouts
11 - 12 - 09	20	Septic Tank and Misc. Details

LEGEND

▲ Construction Area

□ Possible source of gravel or stone

REVISION	DATE	DESCRIPTION	BY
A	23 [illegible]	AS CONSTRUCTED (CONT. 3129)	

CORPS OF ENGINEERS U. S. ARMY
OFFICE OF THE DISTRICT ENGINEER, WALLA WALLA, WASHINGTON

DRAWN BY: B.E.D.
TRACED BY: S.A.D.
CHECKED BY: G.A.J.
SUBMITTED: CHIEF, RELOC. & LEVEE SEC.
APPROVED: CHIEF DESIGN BRANCH
APPROVED: COL. C.E. DISTRICT ENGINEER
DATE 15 May 57

CAMP HANFORD

CAMP HANFORD, WASHINGTON

F.Y. '57 M.C.A. TACTICAL FACILITIES

SITE PLAN AND VICINITY MAP

APPROVED: CHIEF ENGINEERING DIVISION
DATE 15 [illegible] 57

SCALE AS SHOWN | SPEC NO. [illegible]

DRAWING NUMBER

SHEET 1 — 11-12-09