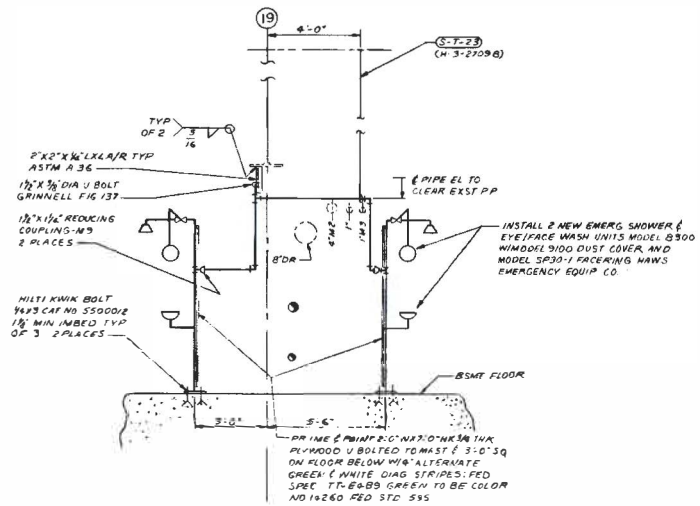

SECTION S-S FROM SH 1

SCALE: NONE

NOTE: ~~SHOWER~~ PIPING SHALL BE FABRICATED AND INSTALLED PER ANSI B31.3. PERFORM IN SERVICE LEAK TEST.

NEW SHT ADDED TO REFLECT AS-BUILT CONDITIONS PER DFC CK0081-10 & 9

Approved for Public Release
Further Dissemination Unlimited
5/31/2017

RHO APPROVAL		U. S. DEPARTMENT OF ENERGY Richland Operations Office	
BY P.K. Wang	4/4/97	KAISER ENGINEERS HANFORD COMPANY	
PROJ ENGR BY E.E. Lee	4/4/97	PIPING AMU UPGRADES SECTIONS AND DETAILS	
EIA N/A			
APPROVED BY N/A			
SAFETY N/A			
APPROVED BY Scott Stanley	4/4/97	PROJECT TITLE AMU CHEMICAL MANAGEMENT UPGRADES	
CHECKED BY R.A. Kupinski	4/4/97	PROJ —	NO CK0081	SYS R930A2
DESIGNED BY M.J. WILLIAMS	4/4/97	SCALE NONE	BLDG 202-A	SHEET 8309,8509
DRAWN BY N/A		DRAWING NUMBER H-2-46932	SHT 4	OF 4	REV 0
CLASSIFICATION BY				

NUMBER	DRAWING LIST / TITLE	REFERENCES
H-2-46931		
NEXT USED ON H-2-46932 SH1		

NON-PLANS	BY-DATE	BY-DATE	REV BY DATE	DESCRIPTION	NEW
APPROVAL		ESN APPROVAL			
COMMENT REVIEW			REVISIONS		

RECEIVED
MAY 16 2017
EDMC

200-EA-1

1244025
00713311