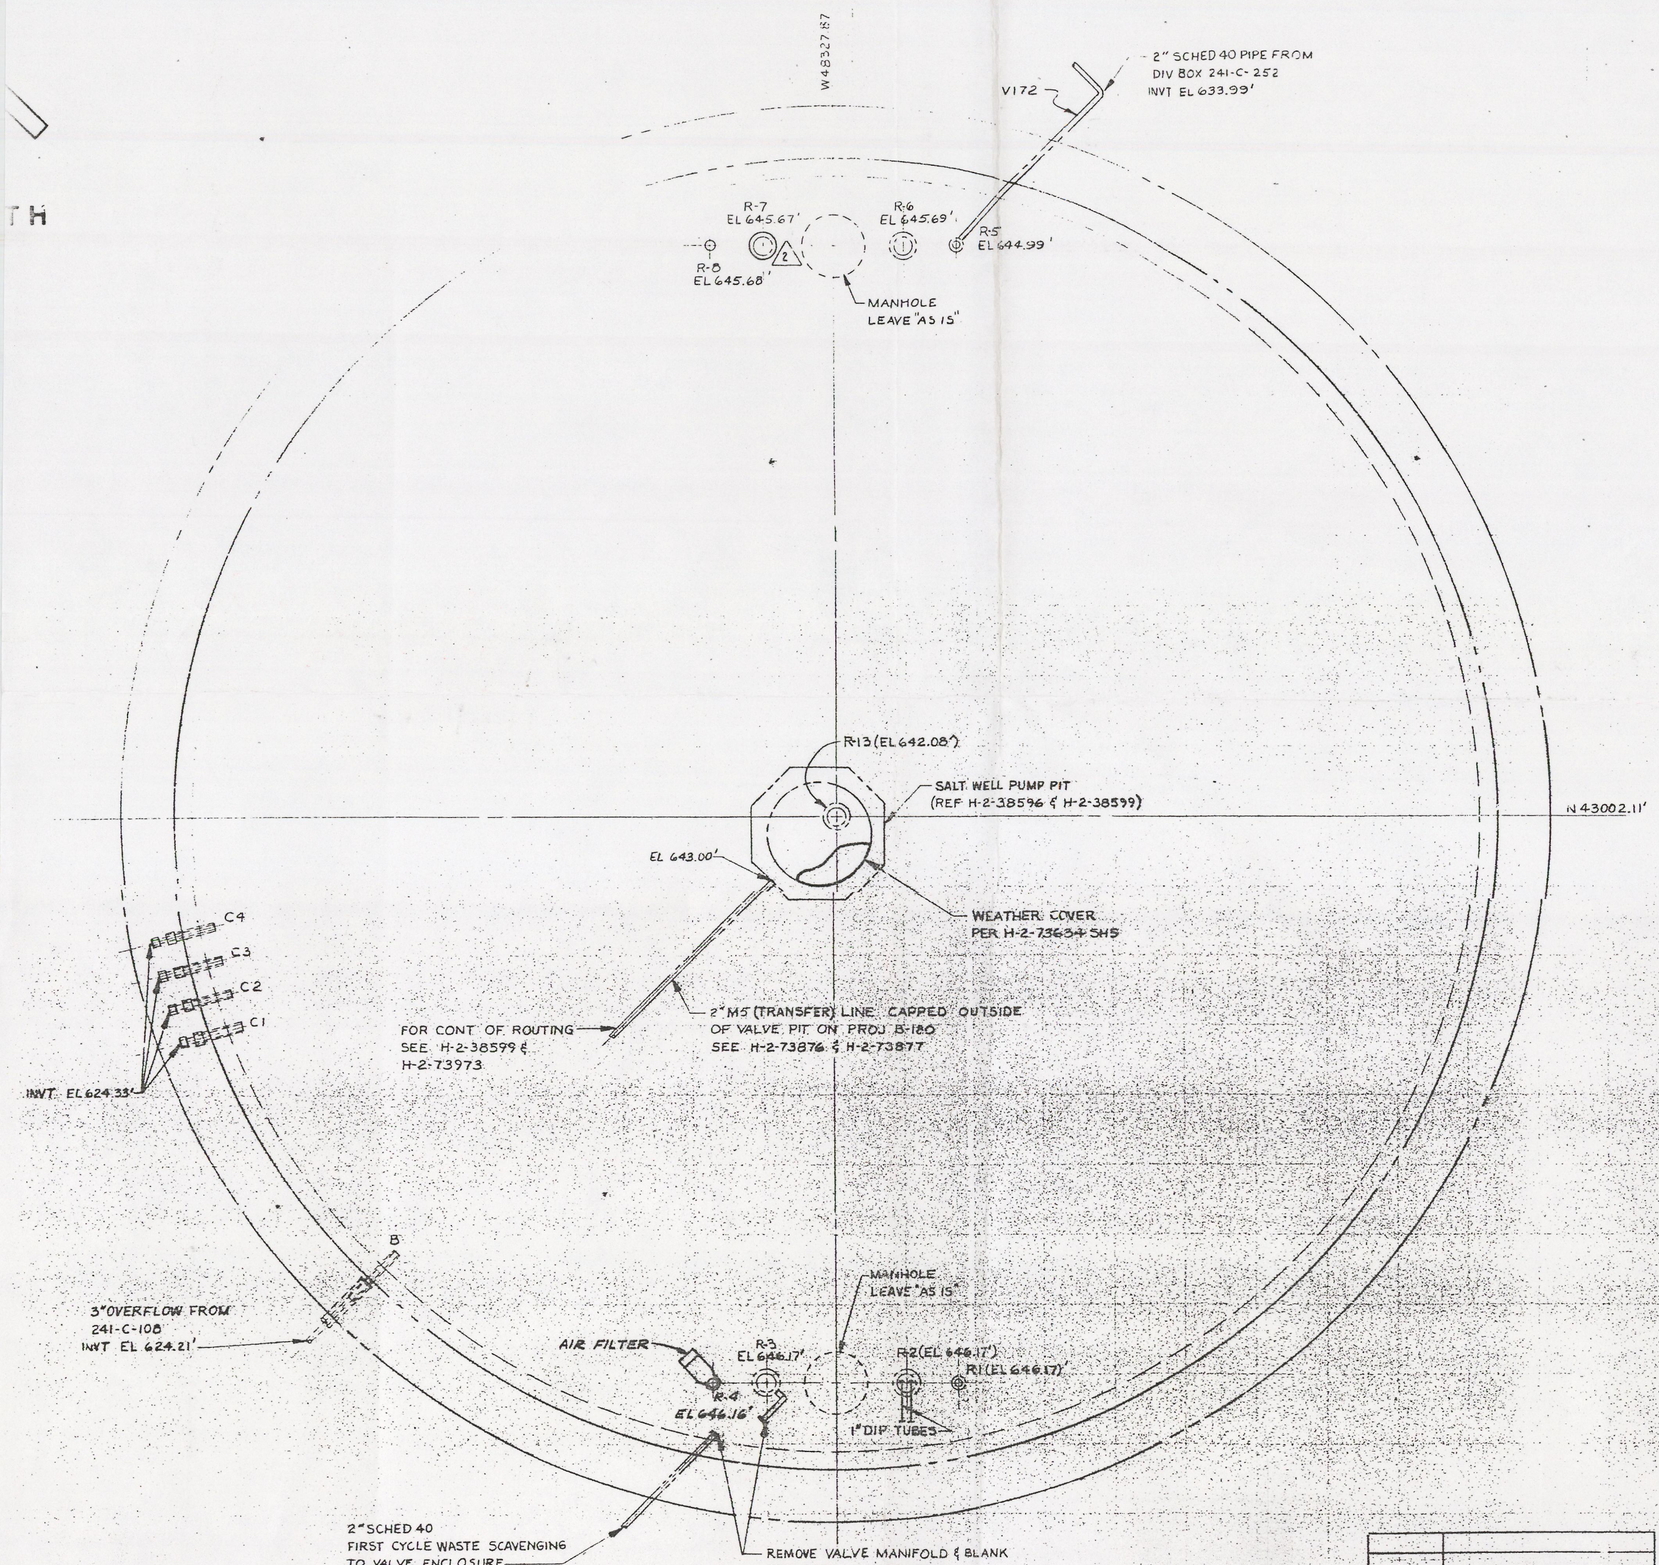

PLAN

0 10 FT

SCALE: 1/4" = 1'-0"

NOZZLE NO RISER SCHEDULE

RISER NO	SIZE	IDENTIFICATION	REFERENCE AND COMMENTS
1 24-C-1098-1	4"	LLR	[illegible]
R-2	12"	DIP TUBES	REMOVE [illegible] BLANK PER DET 1, H-2-73450
R-3	2"	PUMP OUT	REMOVE PUMP & BLANK PER DET 1, H-2-73450
R-4	4"	SPARE	INSTALL AIR FILTER PER H-2-69743
4 R-5	4"	[illegible]	[illegible]
R-6	12"	SPARE	[illegible]
2 R-7	12"	OBSERVATION PORT	SEE DWG H-2-93726 (PROJ B-222)
R-8	4"	TEMP CONT	LEAVE "AS-IS" SEE GEN NOTE #2 H-2-73051 SH #3
R-13	12"	SALT WELL PUMP	LEAVE "AS IS"
NOZZLE NO.			
B	3"	OVERFLOW INLET	LEAVE "AS IS"
C1	3"	SPARE	LEAVE "AS IS", CAPPED PER HW-72743
C2	3"	SPARE	
C3	3"	SPARE	
C4	3"	SPARE	

NOTES:

1. FOR GENERAL NOTES AND LEGEND SEE DWG H-2-73051 SH3.
2. APPROX GRADE ELEVATION AT CENTER OF TANK IS 645.00'.
3. SEE DWG INDEX (H-2-73051) FOR DWG NUMBERS NOT LISTED IN REFERENCE COLUMN.
4. * DENOTES REFERENCES NOT PERTINENT TO NEW CONSTRUCTION (AS-BUILT TANK INFORMATION).

0031266

START

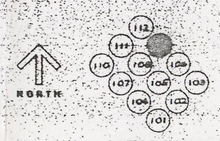

KEY PLAN

241-C TANK FARM

SCALE: NONE

OCT 1993 RECEIVED EDMC

RELEASED FOR CONSTRUCTION
BY K K Lane DATE 2/25/00
DOE

NUMBER	TITLE
H-2-61062	PLOT PLAN 241-C TK FARM
H-2-38596	NEW 12" RISER #13
H-2-37912	RISER ELEVATIONS
H-2-2909	FIRST CYCLE WASTE SCAVENGING
H-2-1744	TK FARM RISERS NOZZLE EL
H-2-37009	241-C-109 TK ARR AS BU'LT
H-2-38599	SALT WELL PUMP PIT
HW 72743	241-C STORAGE TANK ARR
H-2-73338	PIPING WASTE TK ISOLATION
H-2-73051	DRAWING LIST

REFERENCES

NEXT USED ON

* SEE NOTE #4

BY-DATE	FOR	BY-DATE	FOR	REV BY DATE	DESCRIPTION	REV NO.
M 8-5-80	RHO	[illegible]	FEH	DCM 1-29-96 1-21-96	AS-BUILT FOR PROJ B-222 DFC B-222-79 Z G1,2,3 & F9	2
M [illegible]	RHO	[illegible]	FEH	ASP 2-9-98 2-20-98	AS-BUILT PER 61451/81 PROJECT D/PER DFC B-181-81 Z1, G1-2 A/PER DFC B-181-92 Z1 N G1-2	1

MICRO FILMED — CLIENT APPROVAL — APPROVED

REVISIONS — LAST REV 2

COMMENT REVIEW: JET 93

		DATE
CLIENT APPROVAL BY KB Fenlan FOR ROCKWELL		2/21/80
PROJ ENGR	RKLane	2/21/80
DESIGN	[illegible]	2/21/80
SAFETY	LA Shepherd	2/21/80
QA	MM Cohen	2/21/80
GROUP MGR	[illegible]	2/21/80
DESIGN ENGR	[illegible]	2/21/80
WELDING		
CHECKED	J. DOVEY	8/24/79
DRAWN	JO REID	8/22/79
CLASSIFICATION	NONE	BY NOT REQ'D

VITRO JOB No. R131A2

M U.S. Department of Energy
Richland Operations Office

VITRO ENGINEERING CORPORATION

PIPING
WASTE TANK ISOLATION
TK 241-C-109

PROJ NO B-181	PROJECT TITLE ISOLATION OF SINGLE SHELL TANKS
NO NO X18102	
SCALE SHOWN	BLDG NO 241-C
INDEX NO 01113 & 04	
DRAWING NUMBER H-2-73349	SHEET —

IN REFERENCE COLUMN.

4. * DENOTES REFERENCES NOT PERTINENT TO NEW CONSTRUCTION (AS-BUILT TANK INFORMATION).

0031266

START

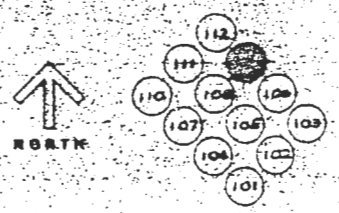

KEY PLAN

241-C TANK FARM

SCALE: NONE

3" OVERFLOW
241-C-108
INVT EL 624.21

OCT 1993
RECEIVED
EDMC

RELEASED FOR CONSTRUCTION
BY K. Kolan DATE 2/25/90
DOE

REV. NO.	DESCRIPTION	REV BY DATE
2	AS-BUILT FOR PROJ B-222 DFC B-222-79 Z G1,2,3 & F9	F E H DCW 1-29-86 DM 11-21-86
1	AS-BUILT PER B145/181 PROJECT DIPER DFC B-181-81 Z1-G1-2 DIPER DFC B-181-91 Z1N G1-2	E H KSP 2-4-86 X 2-25-92

APPROVED — BY-DATE — FOR

REVISIONS — LAST REV 2

CLIENT APPROVAL BY K B Fenlon FOR ROCKWELL — DATE 2/21/90
PROJ ENGR I R Kan — 3/1/90
DESIGN — 2/12/90
SAFETY A Shepherd — 2/14/90
QA I M A Cohen — 2/12/90
GROUP MGR — 2/12/90
DESIGN ENGR — 2/12/90
WELDING
CHECKED J. DOVEY — 8/26/91
DRAWN JO REID — 5/22/79

CLASSIFICATION NONE — BY NOT REQ'D

VITRO JOB No. R131A2

U. S. Department of Energy
Richland Operations Office

VITRO ENGINEERING CORPORATIO

PIPING
WASTE TANK ISOLATIO
TK 241-C-109

PROJ NO. B-181 — PROJECT TITLE ISOLATION OF SINGLE SHELL TANKS
WO NO. X18102
SCALE SHOWN — BLDG NO. 241-C — INDEX NO. 0110 & 04
DRAWING NUMBER H-2-73349 — SHEET —