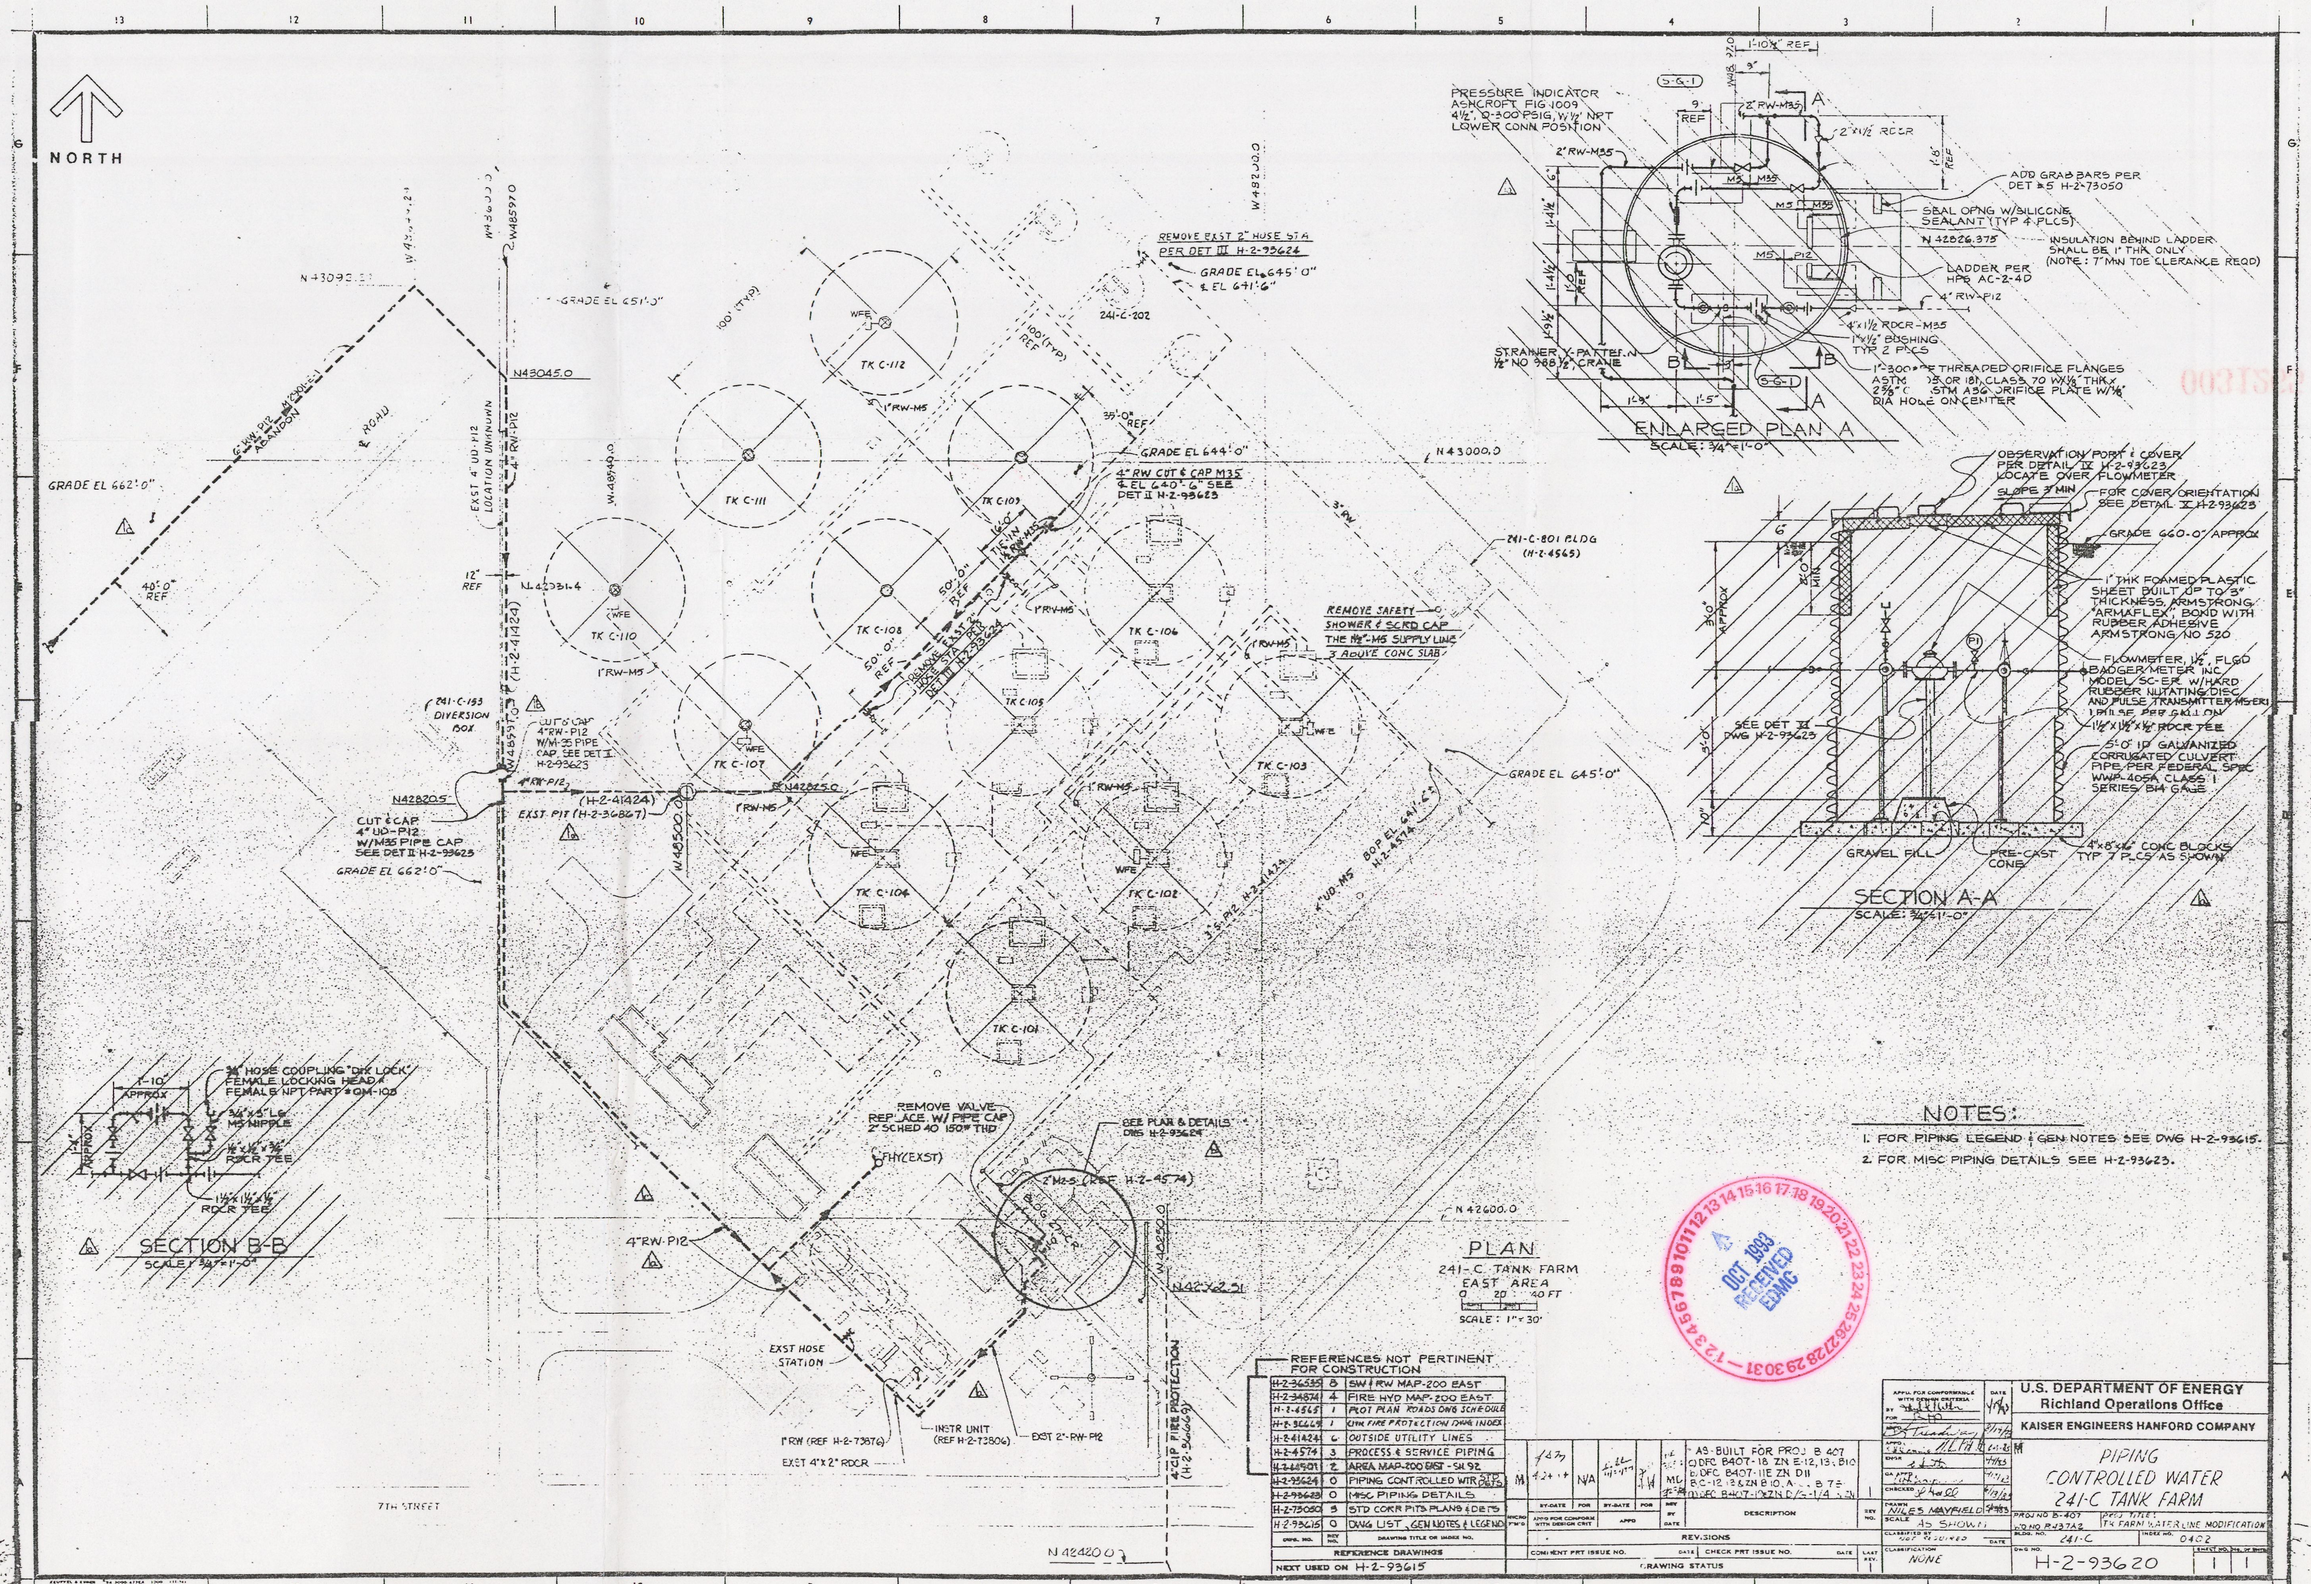

NOTES:

1. FOR PIPING LEGEND & GEN NOTES SEE DWG H-2-93615.
2. FOR MISC PIPING DETAILS SEE H-2-93623.

REFERENCES NOT PERTINENT FOR CONSTRUCTION

DWG. NO.	REV NO.	DRAWING TITLE OR INDEX NO.
H-2-36535	8	SW & RW MAP-200 EAST
H-2-34874	4	FIRE HYD MAP-200 EAST
H-2-4565	1	PLOT PLAN ROADS DWG SCHEDULE
H-2-36669	1	CIVIL FIRE PROTECTION DWG INDEX
H-2-41424	6	OUTSIDE UTILITY LINES
H-2-4574	3	PROCESS & SERVICE PIPING
H-2-44501	2	AREA MAP-200 EAST - SH 92
H-2-93624	0	PIPING CONTROLLED WTR STD DETS
H-2-93623	0	MISC PIPING DETAILS
H-2-73050	3	STD CORR PITS PLANS & DETS
H-2-93615	0	DWG LIST, GEN NOTES & LEGEND

REFERENCE DRAWINGS

NEXT USED ON H-2-93615

REV NO.	DESCRIPTION
1	AS-BUILT FOR PROJ B 407
2	DFC B407-18 ZN E-12, 13, B10
3	DFC B407-11E ZN D11
4	BC-12, 13 & ZN B10, A... B 7...
5	DFC B407-10E ZN D/S-1/4 ...

REVISIONS

COMMENT PRT ISSUE NO. | CHECK PRT ISSUE NO.

DRAWING STATUS

APPD. FOR CONFORMANCE WITH DESIGN CRITERIA

	DATE
BY	4/8/93
FOR	
APPD	2/17/93
APPD	2-1-93
ENGR	4/8/93
CHECKED	4/13/93
DRAWN	NILES MAYFIELD 4/8/93
SCALE	AS SHOWN
CLASSIFIED BY	NOT REQUIRED
CLASSIFICATION	NONE

U.S. DEPARTMENT OF ENERGY
Richland Operations Office
KAISER ENGINEERS HANFORD COMPANY

PIPING CONTROLLED WATER 241-C TANK FARM

PROJ NO B-407 | DWG TITLE: TK FARM WATER LINE MODIFICATION
DWG NO. H-2-93620 | SHEET NO. 1 | NO. OF SHTS 1